

121-127 LITTLE COLLINS STREET

**WALL LEGEND**

- EXISTING (solid grey line)
- DEMOLISHED (red hatched area)
- PROPOSED (red dashed line)

BIMcloud: FK BIMCLOUD - BIMcloud\18155 90 Collins Street Melbourne\00 MODEL\00-CD\BIM MODEL\18155 General

REVISION	DESCRIPTION	DATE	BY
01	TOWN PLANNING ISSUE 01	16.12.2021	WTK
02	TOWN PLANNING SUBMISSION 02	10.06.2022	WTK
03	TOWN PLANNING SUBMISSION 03	15.07.2022	WTK

REVISION	DESCRIPTION	DATE	BY
01	TOWN PLANNING ISSUE 01	16.12.2021	WTK
02	TOWN PLANNING SUBMISSION 02	10.06.2022	WTK
03	TOWN PLANNING SUBMISSION 03	15.07.2022	WTK

**QUALITY ASSURANCE** (FK IS A CERTIFIED COMPANY TO ISO 9001:2015)

THIS PROJECT IS SUBJECT TO THE FK QUALITY ASSURANCE SYSTEM

- SCHEMATIC DESIGN REVIEW FOR THIS PROJECT IS YET TO BE COMPLETED.
- DESIGN DEVELOPMENT REVIEW FOR THIS PROJECT IS YET TO BE COMPLETED.
- TENDER DOCUMENTATION REVIEW FOR THIS PROJECT IS YET TO BE COMPLETED.
- CONSTRUCTION DOCUMENTATION REVIEW FOR THIS PROJECT IS YET TO BE COMPLETED.

IF THIS DRAWING IS STAMPED UNCONTROLLED COPY THEN IT IS TO BE CONSIDERED A DRAFT. SUBJECT TO REVISION WITHOUT NOTICE

**NOTES**

THIS DRAWING IS COPYRIGHT AND SHALL REMAIN THE PROPERTY OF FENDER KATSALIDIS (AUST) PTY LTD. CHECK AND VERIFY ALL DIMENSIONS ON SITE PRIOR TO COMMENCING WORK. DRAWING TO BE READ IN CONJUNCTION WITH ALL OTHER CONTRACT DOCUMENTS. DO NOT SCALE DRAWINGS. USE FIGURED DIMENSIONS ONLY. SEEK CLARIFICATION OF INCONSISTENCIES / CONFLICTS.

DRAWN	DATE	CHECKED	PLOT DATE	JOB NO.	SCALE
WTK	15.07.2022	JV	21.07.2022	18155	1:100@A1


**PROJECT**

90 COLLINS REDEVELOPMENT  
90 COLLINS STREET  
MELBOURNE VIC 3000



**FENDER KATSALIDIS**

WWW.FKAUSTRALIA.COM  
2 RIVERSIDE QUAY, SOUTH BANK  
VICTORIA 3006 AUSTRALIA  
TELEPHONE: +61 3 8696 3888  
FENDER KATSALIDIS (AUST) PTY LTD ACN 092 943 032

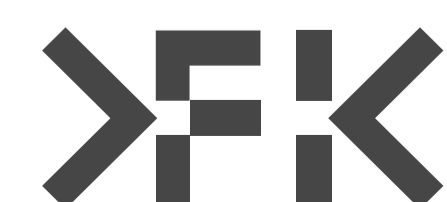


**DRAWING TITLE**

DEMOLITION LEVEL 10 FLOOR PLAN

**ISSUE PURPOSE**

TOWN PLANNING

**REV.** 02 **DRAWING NO.** TP210

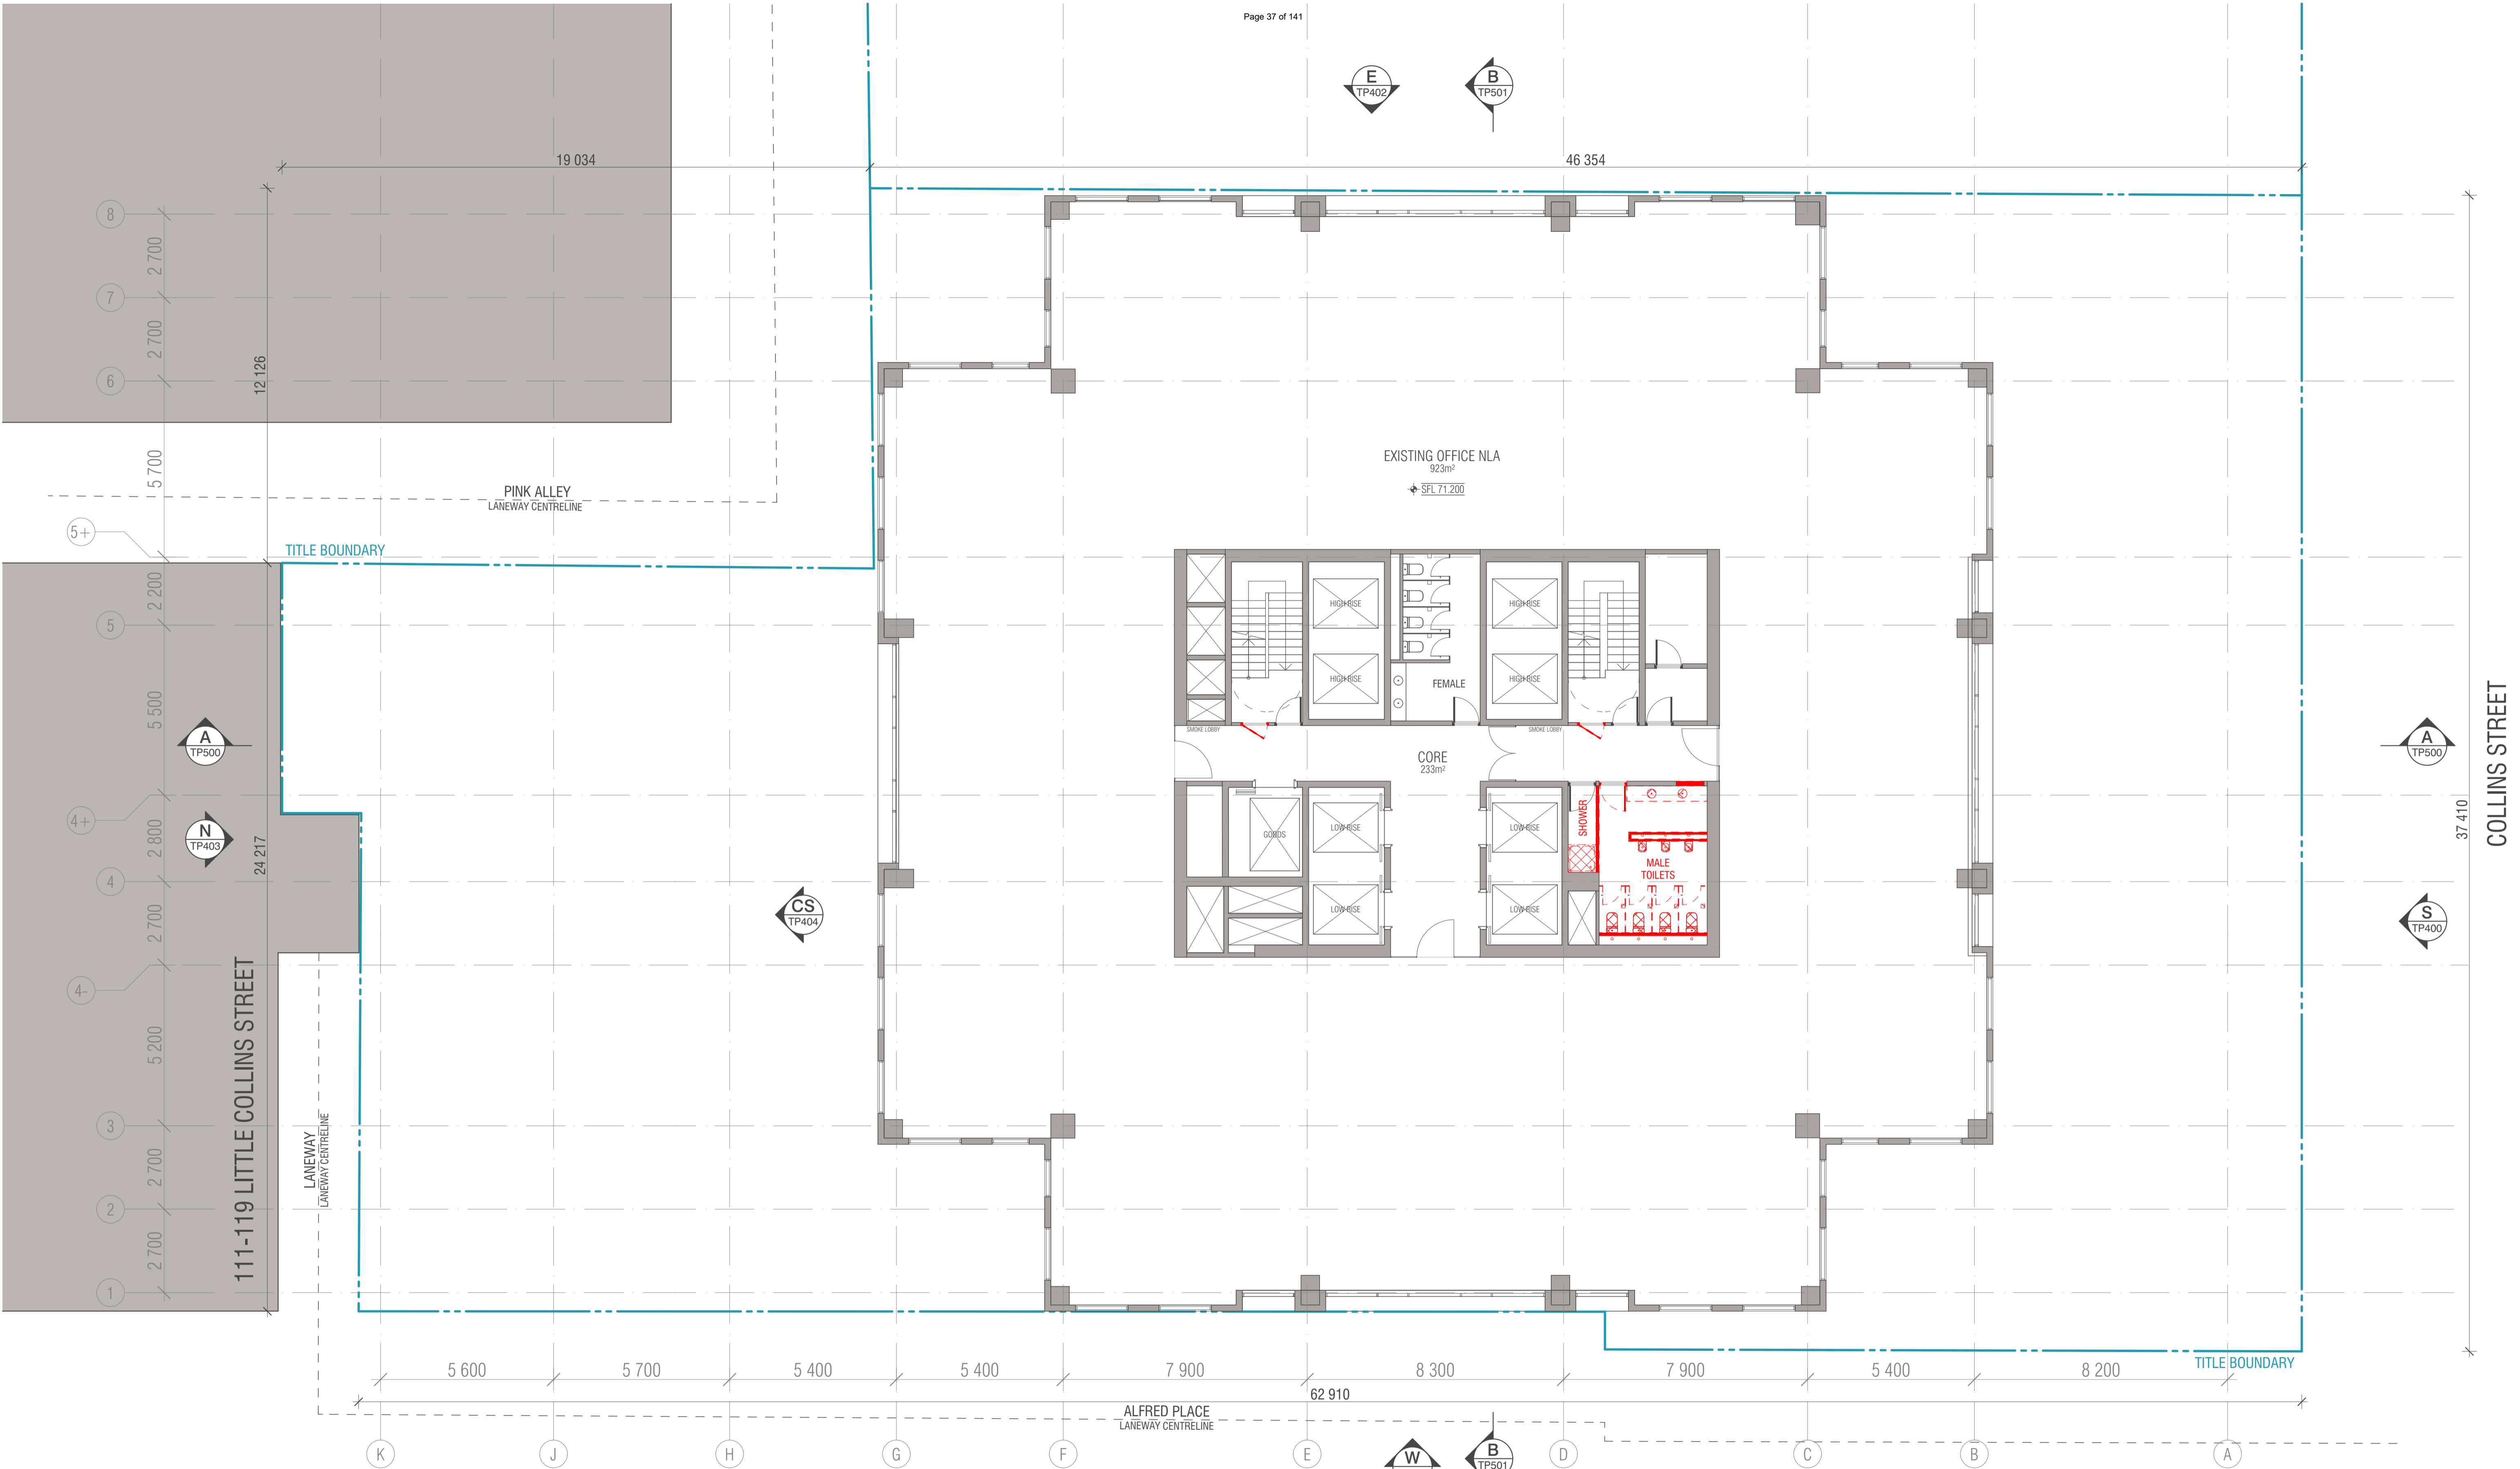

121-127 LITTLE COLLINS STREET

**WALL LEGEND**

- EXISTING
- DEMOLISHED
- PROPOSED

BIMcloud: FK BIMCLOUD - BIMcloud\18155 90 Collins Street Melbourne\00 MODEL\00-CD\BIM MODEL\18155 General

REVISION	DATE	BY	REVISION
-	TOWN PLANNING ISSUE 01	WTK	16.12.2021
> 01	TOWN PLANNING SUBMISSION 02	WTK	10.06.2022

**QUALITY ASSURANCE** (FK IS A CERTIFIED COMPANY TO ISO 9001:2015)

THIS PROJECT IS SUBJECT TO THE FK QUALITY ASSURANCE SYSTEM

- SCHEMATIC DESIGN REVIEW FOR THIS PROJECT IS YET TO BE COMPLETED.
- DESIGN DEVELOPMENT REVIEW FOR THIS PROJECT IS YET TO BE COMPLETED.
- TENDER DOCUMENTATION REVIEW FOR THIS PROJECT IS YET TO BE COMPLETED.
- CONSTRUCTION DOCUMENTATION REVIEW FOR THIS DRAWING IS YET TO BE COMPLETED.

IF THIS DRAWING IS STAMPED UNCONTROLLED COPY THEN IT IS TO BE CONSIDERED A DRAFT. SUBJECT TO REVISION WITHOUT NOTICE

**NOTES**

THIS DRAWING IS COPYRIGHT AND SHALL REMAIN THE PROPERTY OF FENDER KATSALIDIS (AUST) PTY LTD. CHECK AND VERIFY ALL DIMENSIONS ON SITE PRIOR TO COMMENCING WORK. DRAWING TO BE READ IN CONJUNCTION WITH ALL OTHER CONTRACT DOCUMENTS. DO NOT SCALE DRAWINGS. USE FIGURED DIMENSIONS ONLY. SEEK CLARIFICATION OF INCONSISTENCIES / CONFLICTS.


DRAWN	DATE	CHECKED	PLOT DATE	JOB NO.	SCALE
WTK	10.06.2022	JV	21.07.2022	18155	1:100@A1

**PROJECT**


90 COLLINS REDEVELOPMENT  
90 COLLINS STREET  
MELBOURNE VIC 3000

**FENDER KATSALIDIS**

WWW.FKAUSTRALIA.COM  
2 RIVERSIDE QUAY, SOUTHBANK  
VICTORIA 3006 AUSTRALIA  
TELEPHONE: +61 3 8696 3888  
FENDER KATSALIDIS (AUST) PTY LTD ACN 092 943 032

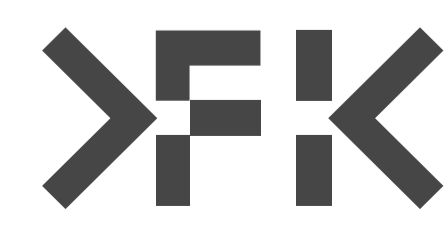

DRAWING TITLE	ISSUE PURPOSE	REV.	DRAWING NO.
DEMOLITION LEVEL 11-13 FLOOR PLAN	TOWN PLANNING	01	TP211

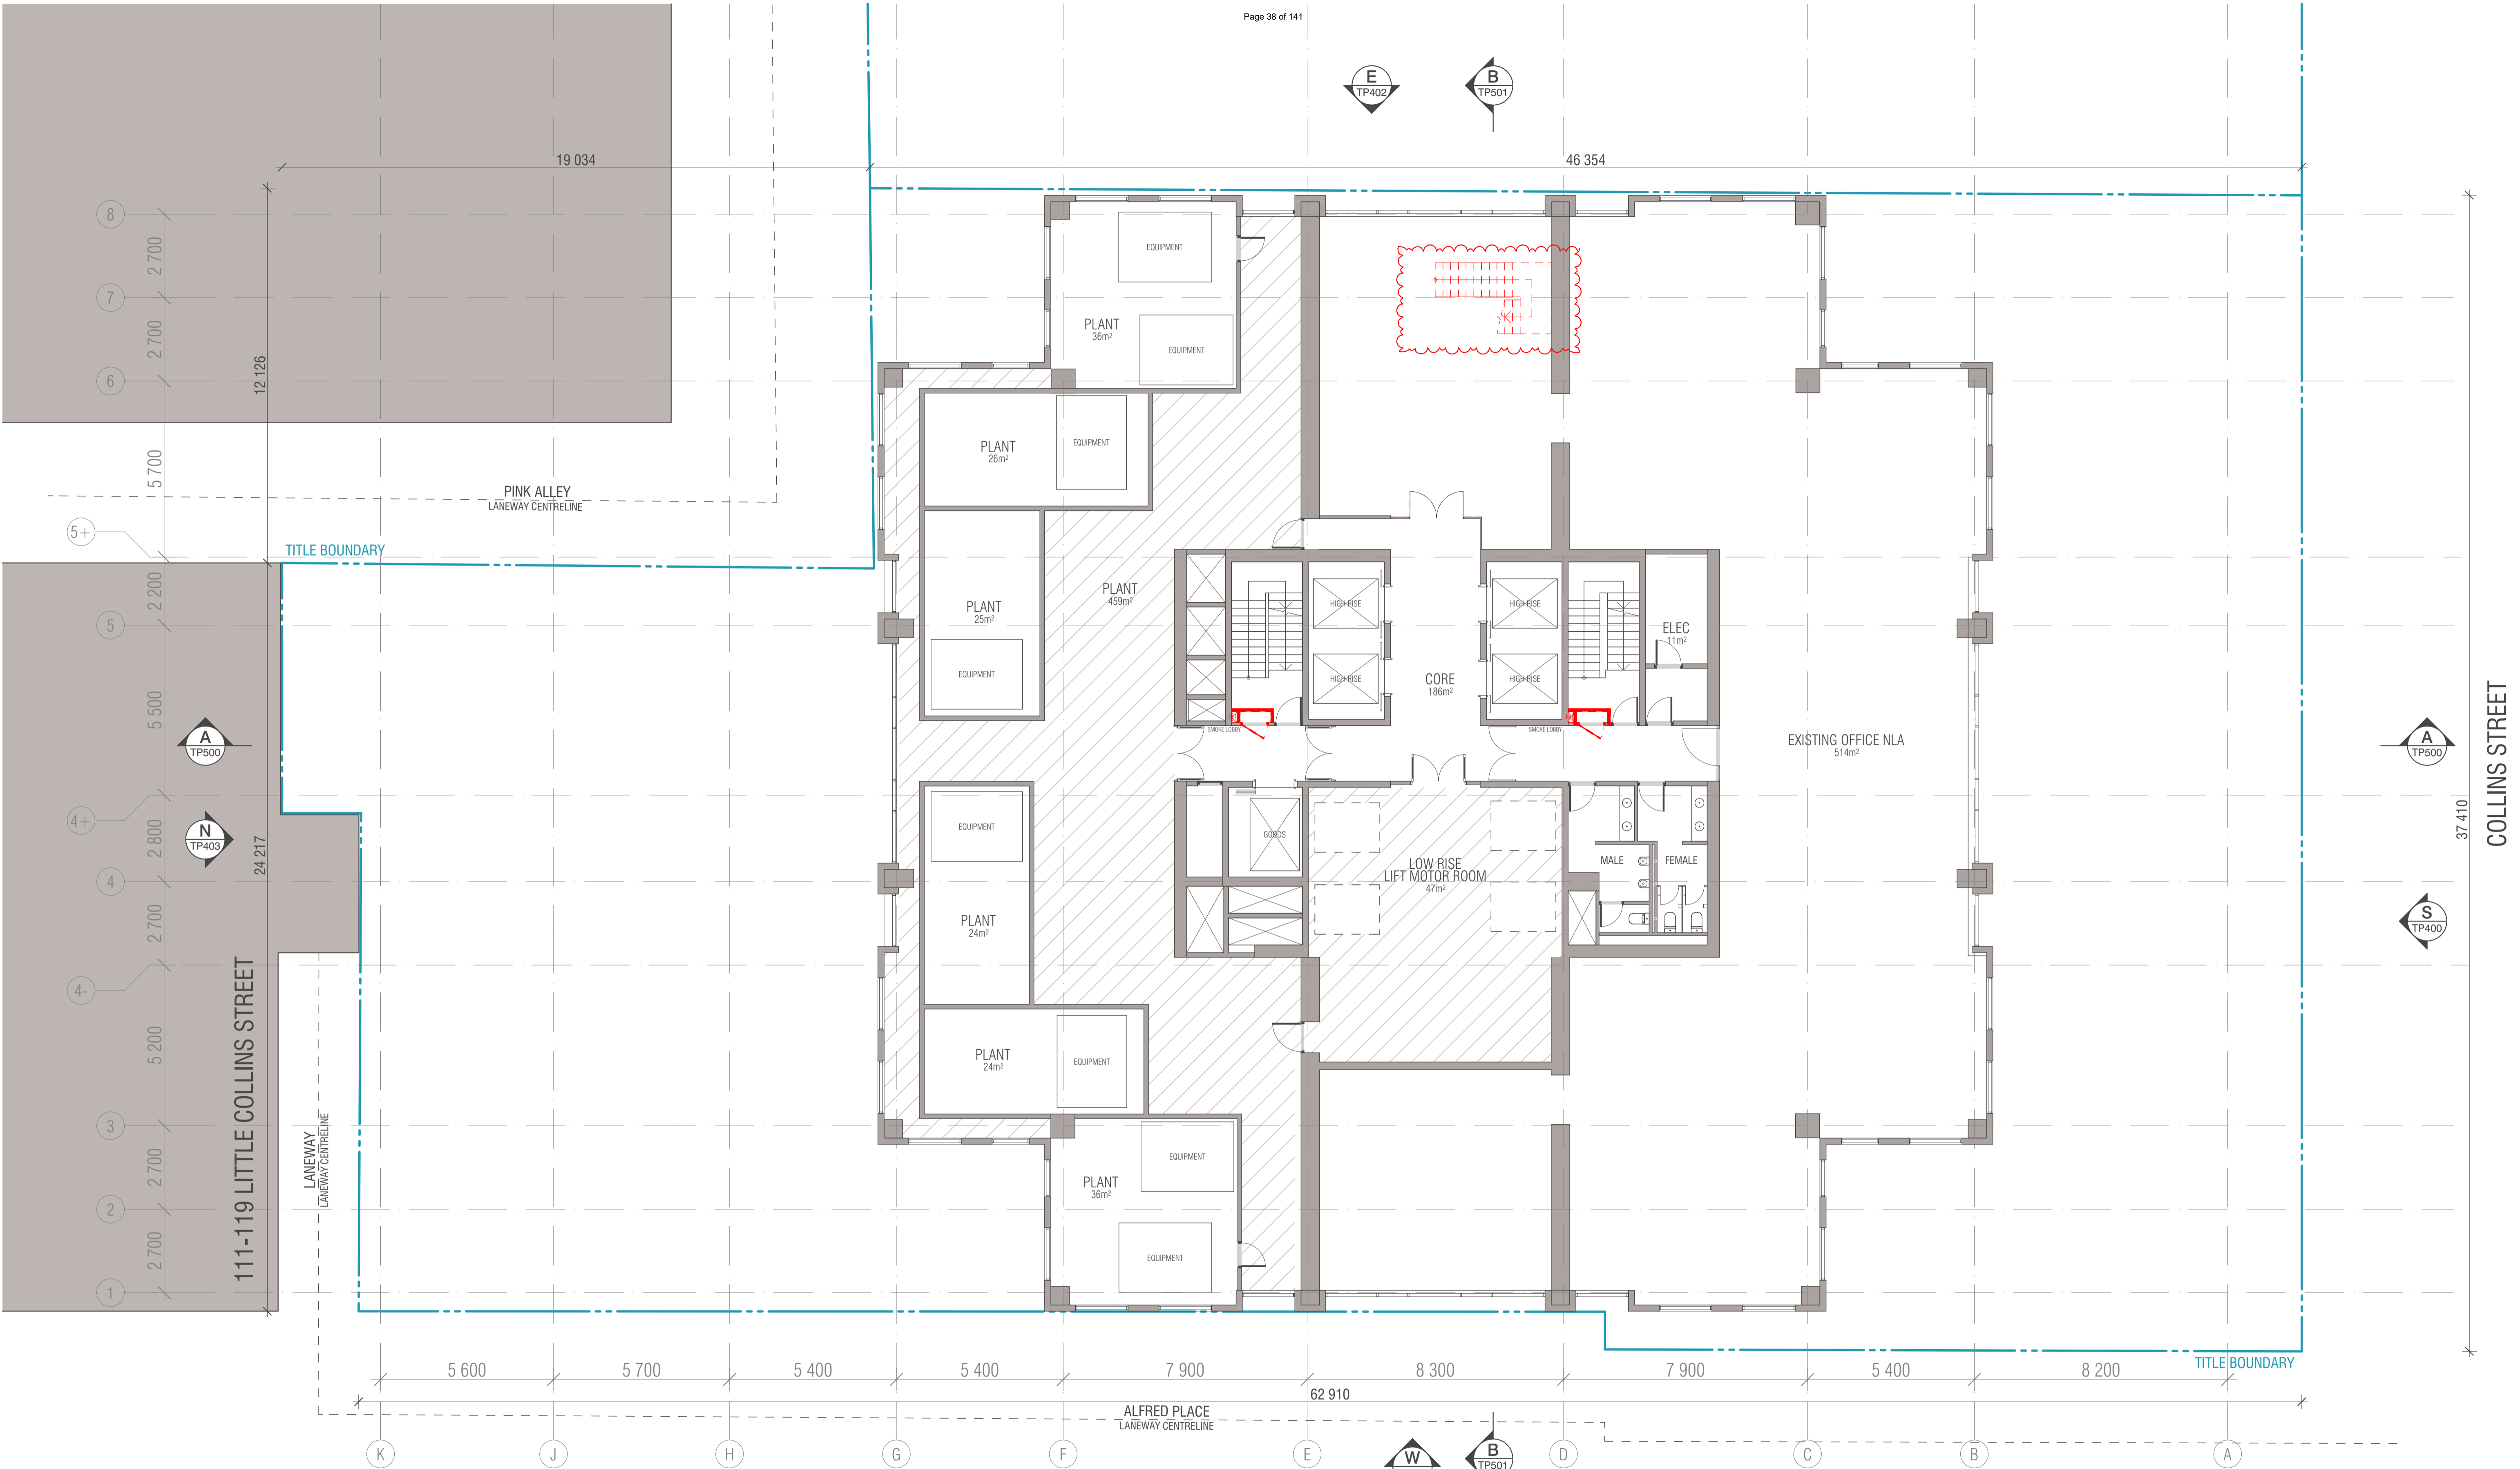

**WALL LEGEND**

- EXISTING
- DEMOLISHED
- PROPOSED

BIMcloud: FK BIMCLOUD - BIMcloud\18155 90 Collins Street Melbourne\00 MODEL\00-CD\BIM MODEL\18155 General

REVISION		REVISION	
-	TOWN PLANNING ISSUE 01	WTK	16.12.2021
01	TOWN PLANNING SUBMISSION 02	WTK	10.06.2022
> 02	TOWN PLANNING SUBMISSION 03	WTK	15.07.2022

**QUALITY ASSURANCE** (FK IS A CERTIFIED COMPANY TO ISO 9001:2015)

THIS PROJECT IS SUBJECT TO THE FK QUALITY ASSURANCE SYSTEM

- SCHEMATIC DESIGN REVIEW FOR THIS PROJECT IS YET TO BE COMPLETED.
- DESIGN DEVELOPMENT REVIEW FOR THIS PROJECT IS YET TO BE COMPLETED.
- TENDER DOCUMENTATION REVIEW FOR THIS PROJECT IS YET TO BE COMPLETED.
- CONSTRUCTION DOCUMENTATION REVIEW FOR THIS DRAWING IS YET TO BE COMPLETED.

IF THIS DRAWING IS STAMPED UNCONTROLLED COPY THEN IT IS TO BE CONSIDERED A DRAFT. SUBJECT TO REVISION WITHOUT NOTICE

**NOTES**


THIS DRAWING IS COPYRIGHT AND SHALL REMAIN THE PROPERTY OF FENDER KATSALIDIS (AUST) PTY LTD. CHECK AND VERIFY ALL DIMENSIONS ON SITE PRIOR TO COMMENCING WORK. DRAWING TO BE READ IN CONJUNCTION WITH ALL OTHER CONTRACT DOCUMENTS. DO NOT SCALE DRAWINGS. USE FIGURED DIMENSIONS ONLY. SEEK CLARIFICATION OF INCONSISTENCIES / CONFLICTS.

DRAWN	DATE	CHECKED	PLOT DATE	JOB NO.	SCALE
WTK	15.07.2022	JV	21.07.2022	18155	1:100@A1

**PROJECT**  
 90 COLLINS REDEVELOPMENT  
 90 COLLINS STREET  
 MELBOURNE VIC 3000



**FENDER KATSALIDIS**  
 WWW.FKAUSTRALIA.COM  
 2 RIVERSIDE QUAY, SOUTHBANK  
 VICTORIA 3006 AUSTRALIA  
 TELEPHONE: +61 3 8696 3888  
 FENDER KATSALIDIS (AUST) PTY LTD ACN 092 943 032

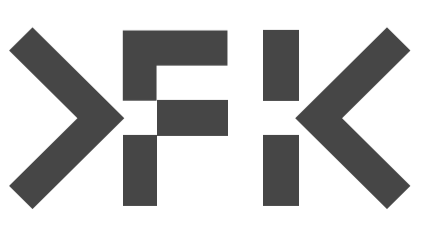


**DRAWING TITLE**  
 DEMOLITION LEVEL 14 FLOOR PLAN

**ISSUE PURPOSE**  
 TOWN PLANNING

**REV.** 02 **DRAWING NO.** TP214



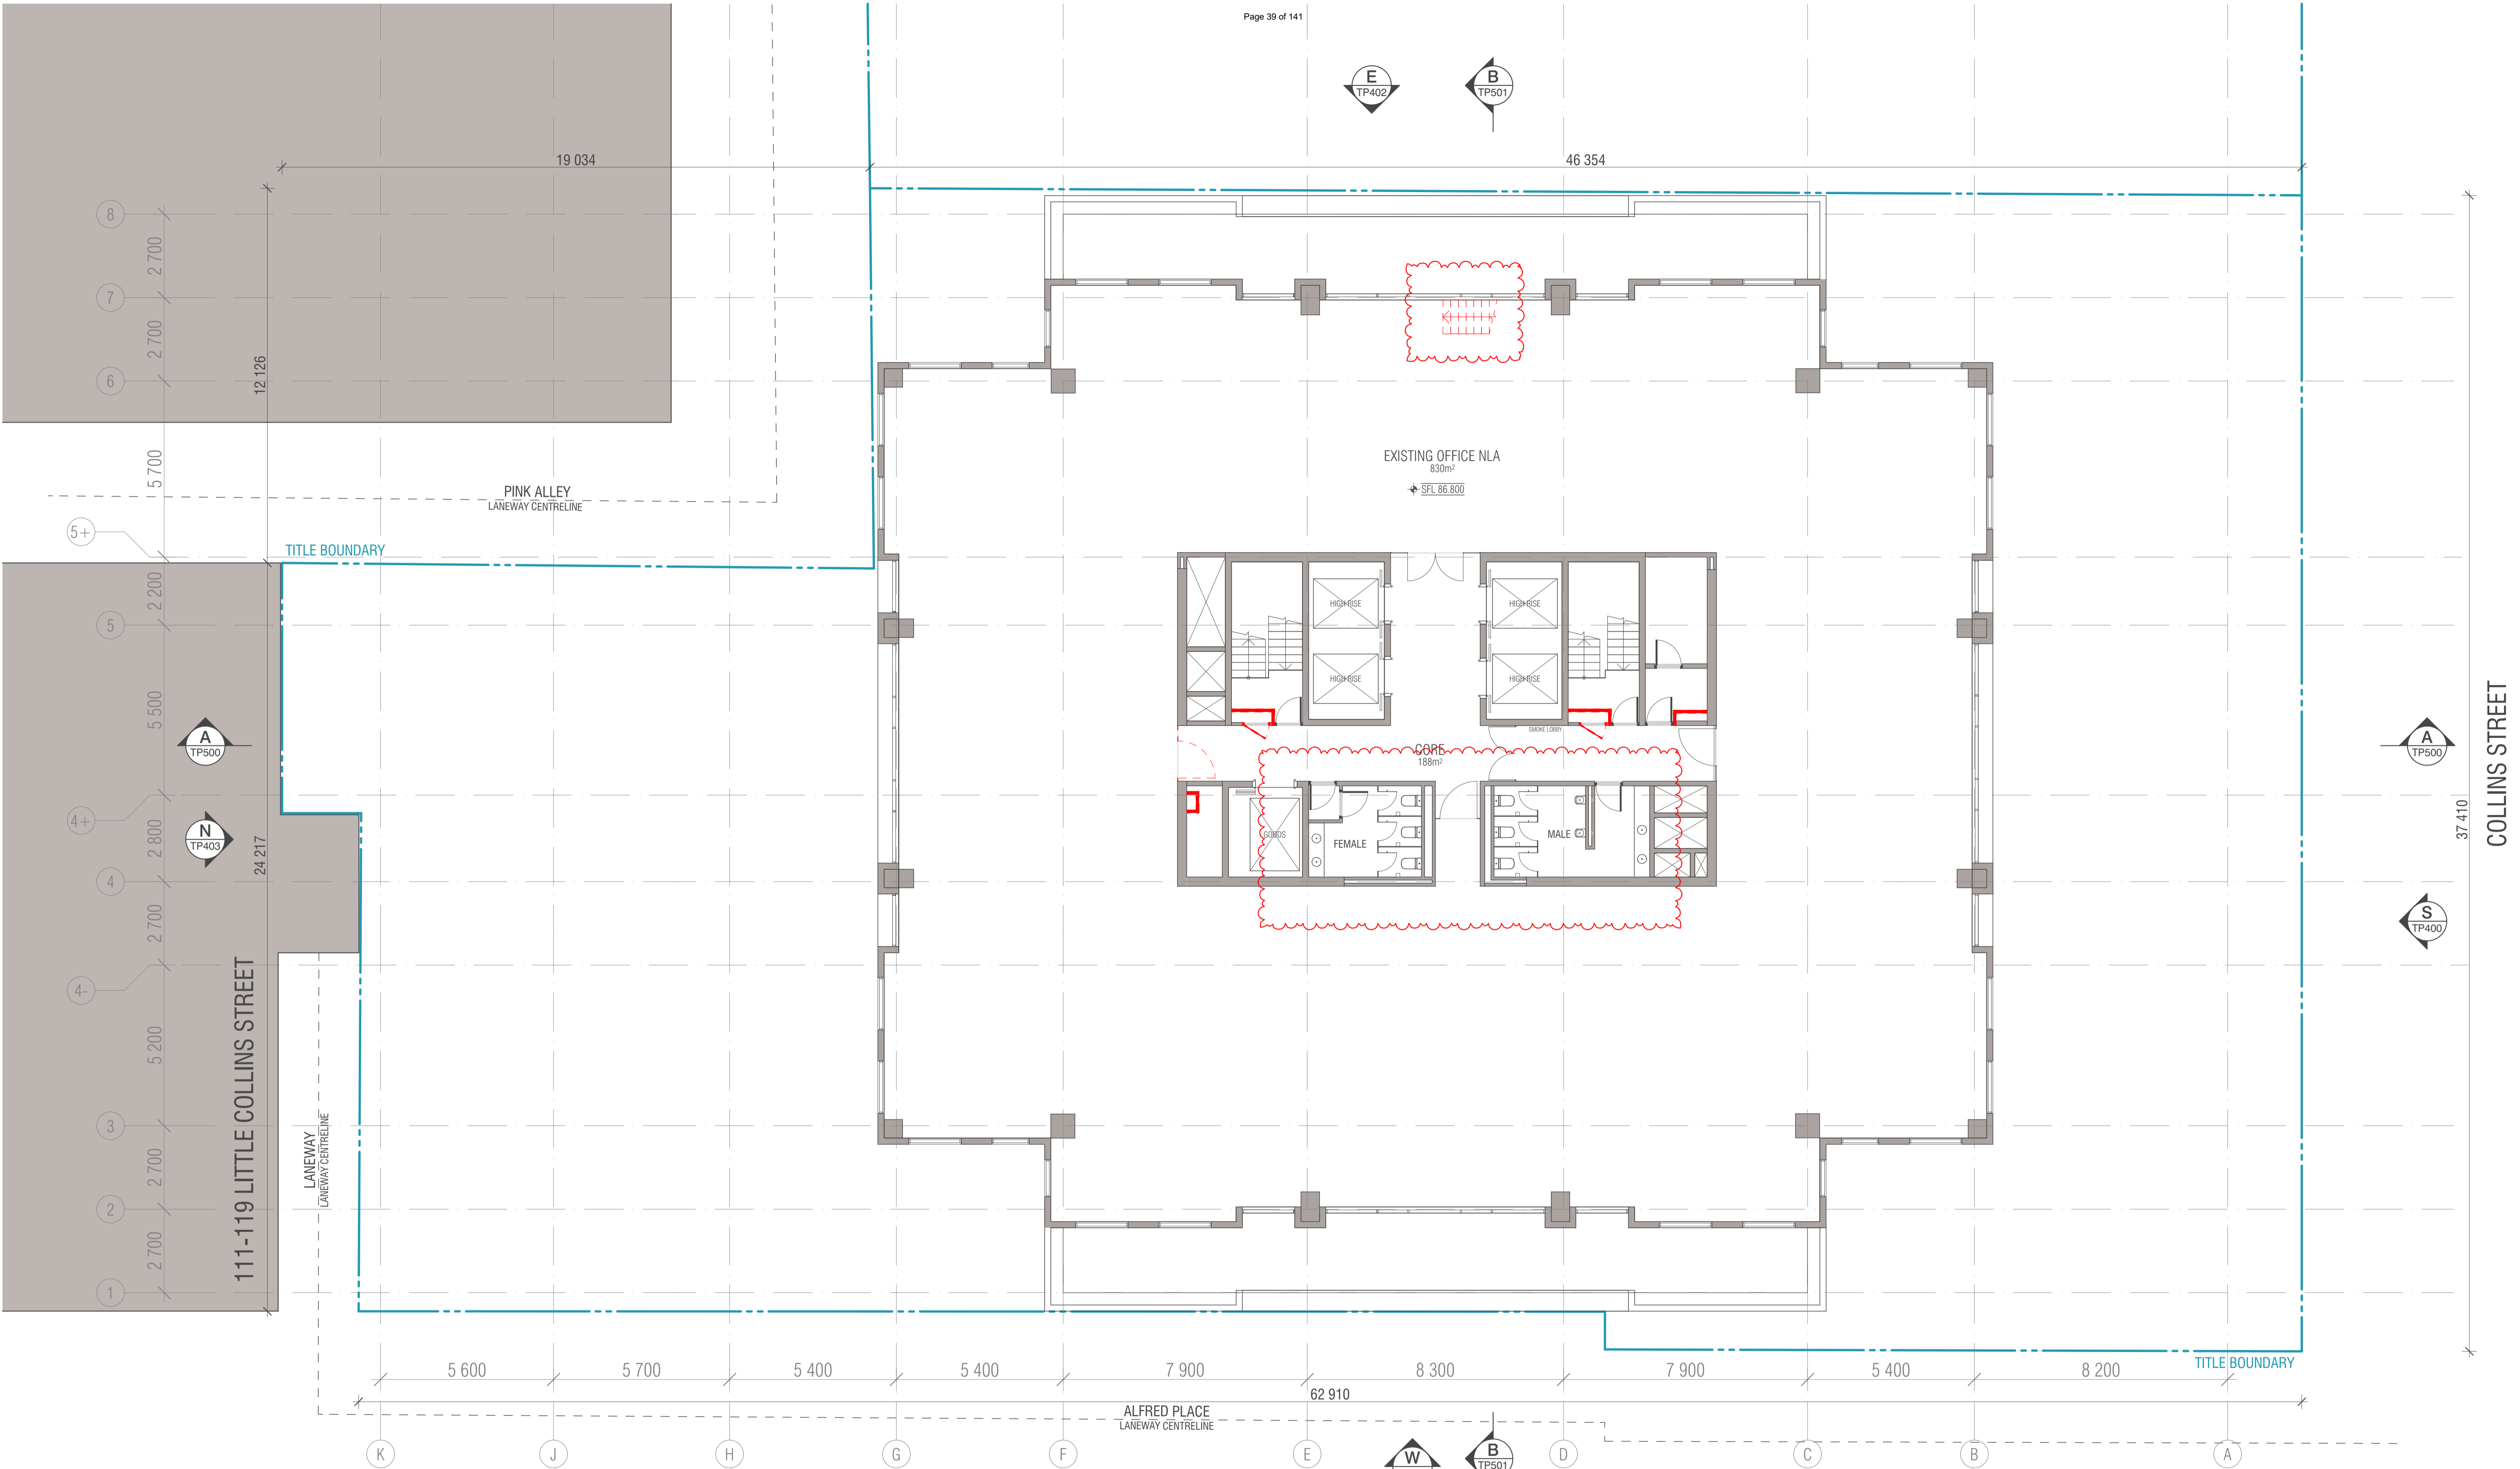

BIMcloud: FK BIMCLOUD - BIMcloud\18155 90 Collins Street Melbourne\00 MODEL\00-CD\BIM MODEL\18155 General

REVISION	REVISION
01 TOWN PLANNING ISSUE 01	WTK 16.12.2021
02 TOWN PLANNING SUBMISSION 02	WTK 10.06.2022
03 TOWN PLANNING SUBMISSION 03	WTK 15.07.2022

**QUALITY ASSURANCE** (FK IS A CERTIFIED COMPANY TO ISO 9001:2015)

THIS PROJECT IS SUBJECT TO THE FK QUALITY ASSURANCE SYSTEM

- SCHEMATIC DESIGN REVIEW FOR THIS PROJECT IS YET TO BE COMPLETED.
- DESIGN DEVELOPMENT REVIEW FOR THIS PROJECT IS YET TO BE COMPLETED.
- TENDER DOCUMENTATION REVIEW FOR THIS PROJECT IS YET TO BE COMPLETED.
- CONSTRUCTION DOCUMENTATION REVIEW FOR THIS DRAWING IS YET TO BE COMPLETED.

IF THIS DRAWING IS STAMPED UNCONTROLLED COPY THEN IT IS TO BE CONSIDERED A DRAFT. SUBJECT TO REVISION WITHOUT NOTICE

**NOTES**

THIS DRAWING IS COPYRIGHT AND SHALL REMAIN THE PROPERTY OF FENDER KATSALIDIS (AUST) PTY LTD. CHECK AND VERIFY ALL DIMENSIONS ON SITE PRIOR TO COMMENCING WORK. DRAWING TO BE READ IN CONJUNCTION WITH ALL OTHER CONTRACT DOCUMENTS. DO NOT SCALE DRAWINGS. USE FIGURED DIMENSIONS ONLY. SEEK CLARIFICATION OF INCONSISTENCIES / CONFLICTS.


DRAWN	DATE	CHECKED	PLOT DATE	JOB NO.	SCALE
WTK	15.07.2022	JV	21.07.2022	18155	1:100@A1

**PROJECT**

90 COLLINS REDEVELOPMENT  
90 COLLINS STREET  
MELBOURNE VIC 3000



**FENDER KATSALIDIS**  
WWW.FKAUSTRALIA.COM  
2 RIVERSIDE QUAY, SOUTHBANK  
VICTORIA 3006 AUSTRALIA  
TELEPHONE: +61 3 8696 3888  
FENDER KATSALIDIS (AUST) PTY LTD ACN 092 943 032

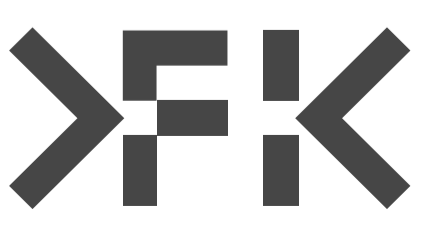

**DRAWING TITLE**


DEMOLITION LEVEL 15 FLOOR PLAN

**ISSUE PURPOSE**

TOWN PLANNING

**REV.** 02  
**DRAWING NO.** TP215



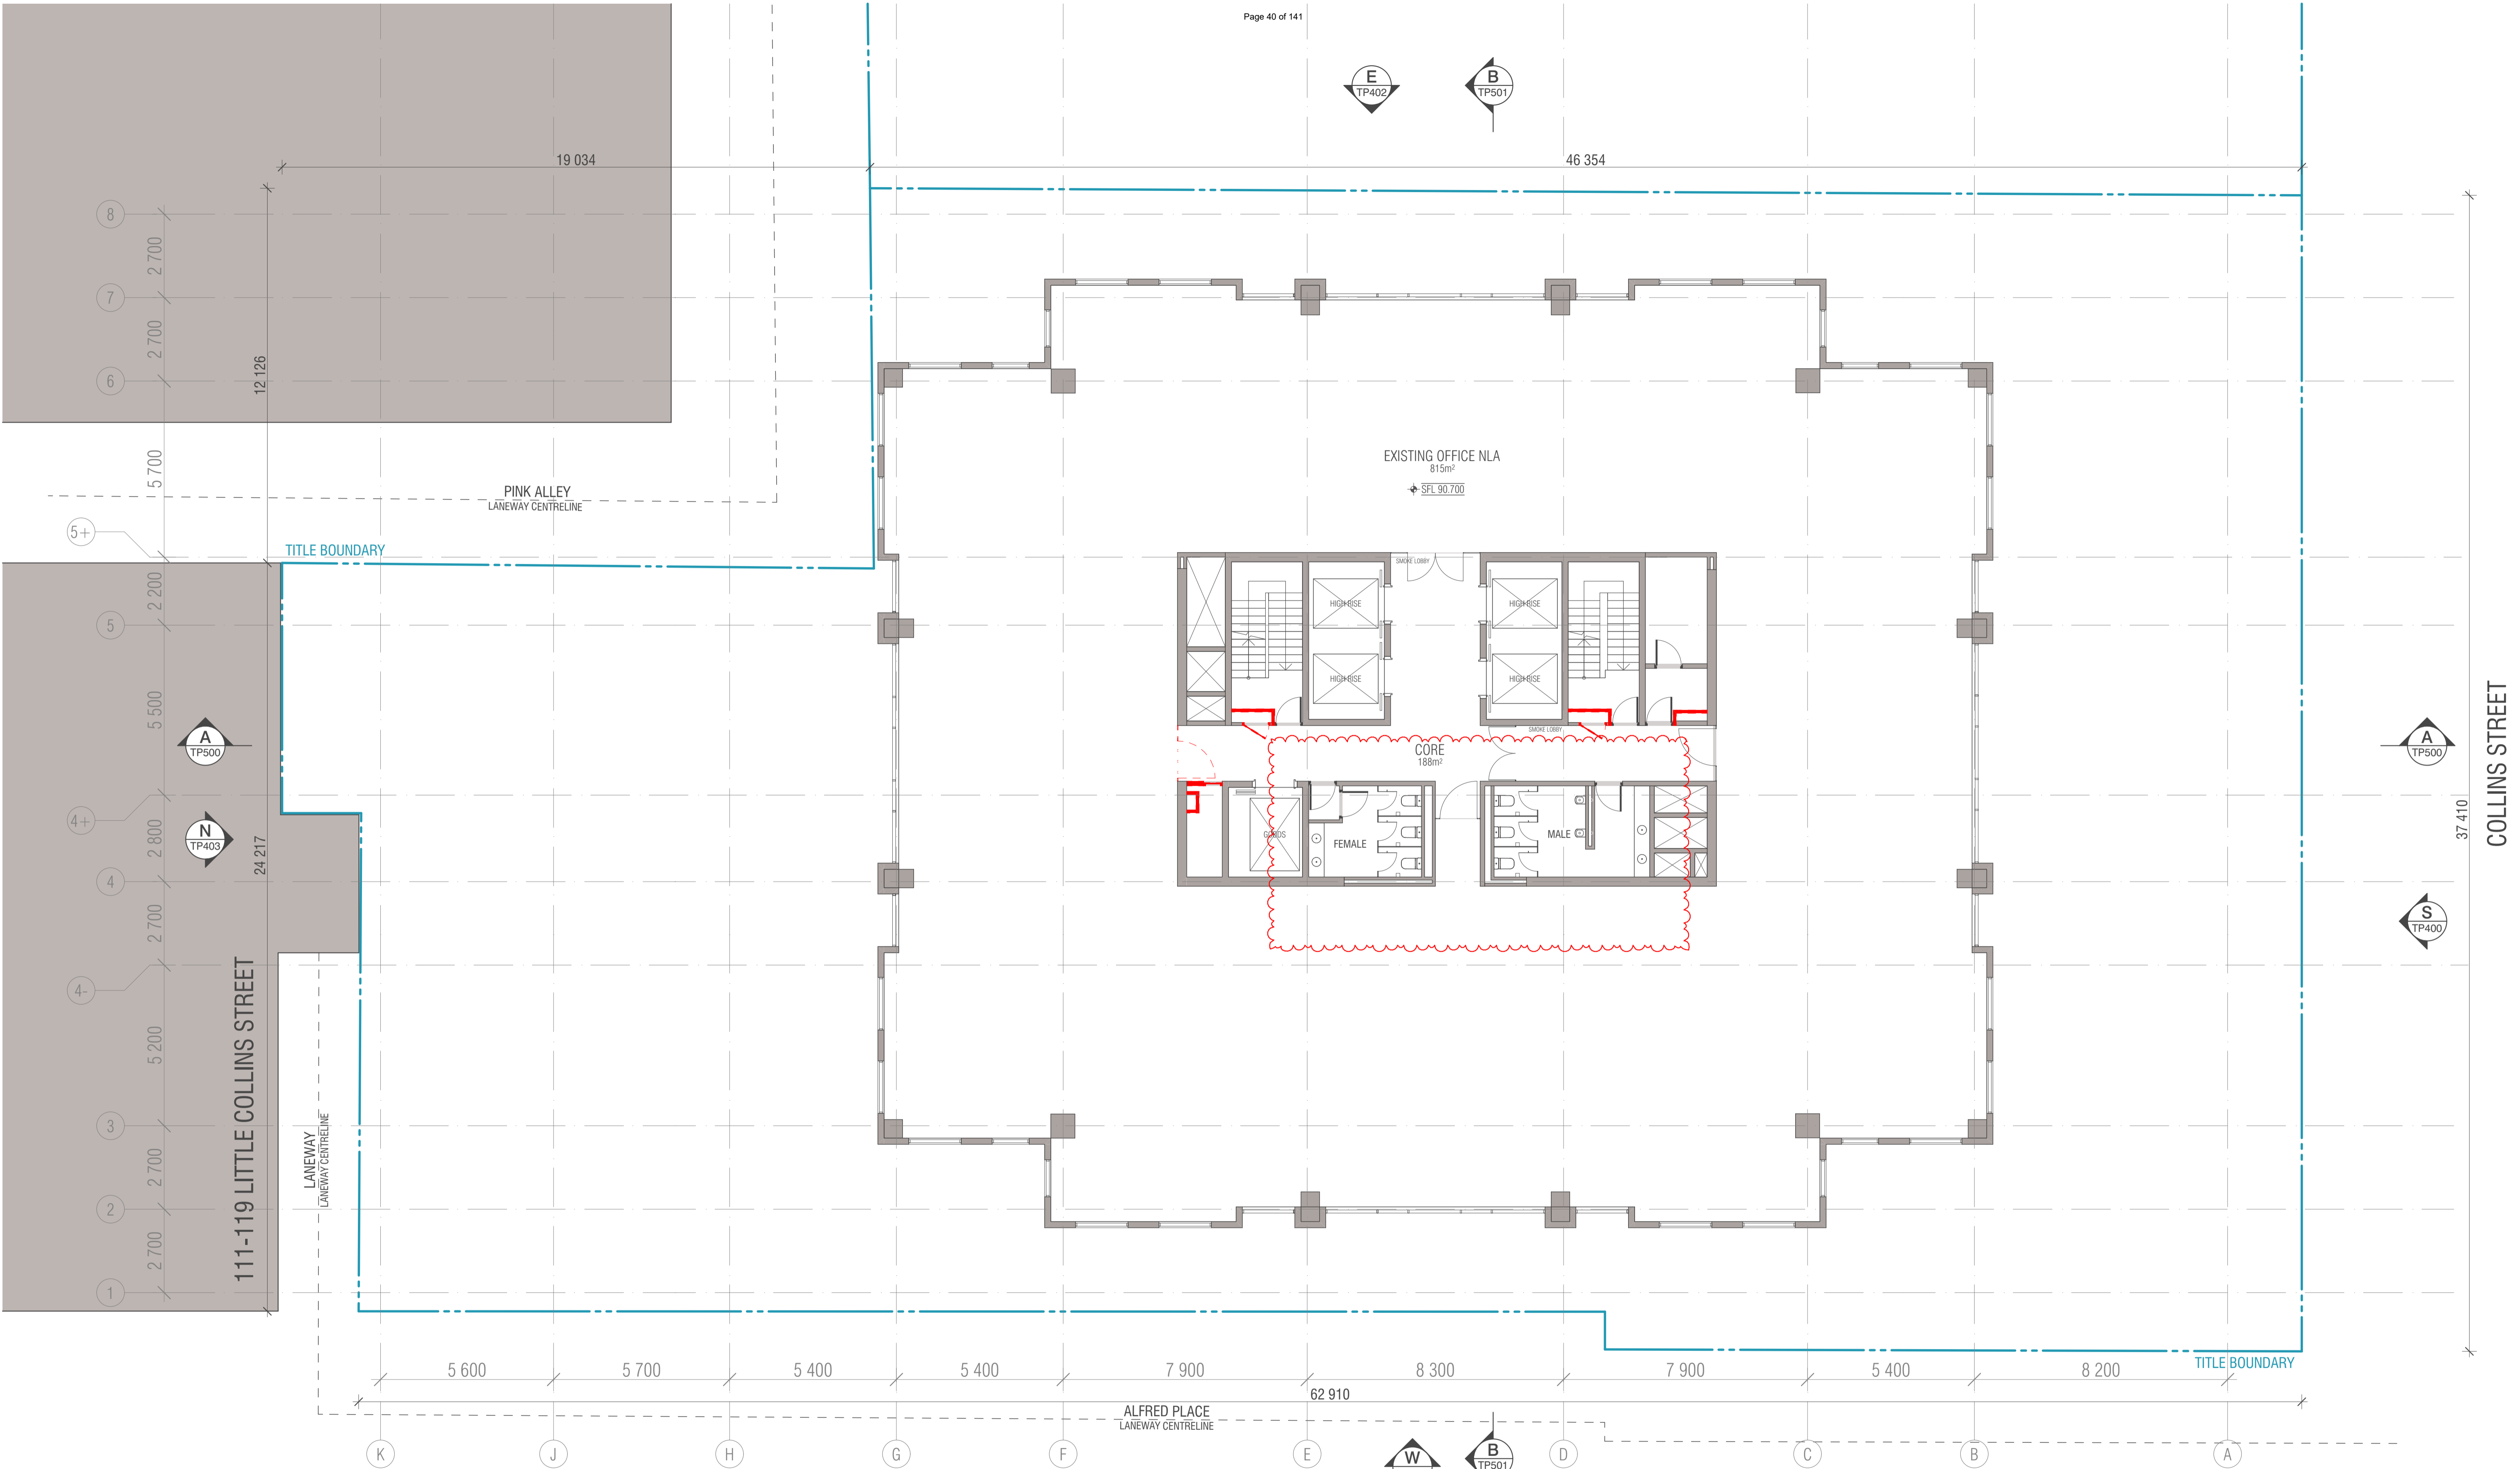

BIMcloud: FK BIMCLOUD - BIMcloud\18155 90 Collins Street Melbourne\00 MODEL\00-CD\BIM MODEL\18155 General

REVISION	REVISION
01 TOWN PLANNING ISSUE 01	WTK 16.12.2021
02 TOWN PLANNING SUBMISSION 02	WTK 10.06.2022
03 TOWN PLANNING SUBMISSION 03	WTK 15.07.2022

**QUALITY ASSURANCE** (FK IS A CERTIFIED COMPANY TO ISO 9001:2015)

THIS PROJECT IS SUBJECT TO THE FK QUALITY ASSURANCE SYSTEM

- SCHEMATIC DESIGN REVIEW FOR THIS PROJECT IS YET TO BE COMPLETED.
- DESIGN DEVELOPMENT REVIEW FOR THIS PROJECT IS YET TO BE COMPLETED.
- TENDER DOCUMENTATION REVIEW FOR THIS PROJECT IS YET TO BE COMPLETED.
- CONSTRUCTION DOCUMENTATION REVIEW FOR THIS DRAWING IS YET TO BE COMPLETED.

IF THIS DRAWING IS STAMPED UNCONTROLLED COPY THEN IT IS TO BE CONSIDERED A DRAFT. SUBJECT TO REVISION WITHOUT NOTICE

**NOTES**

THIS DRAWING IS COPYRIGHT AND SHALL REMAIN THE PROPERTY OF FENDER KATSALIDIS (AUST) PTY LTD. CHECK AND VERIFY ALL DIMENSIONS ON SITE PRIOR TO COMMENCING WORK. DRAWING TO BE READ IN CONJUNCTION WITH ALL OTHER CONTRACT DOCUMENTS. DO NOT SCALE DRAWINGS. USE FIGURED DIMENSIONS ONLY. SEEK CLARIFICATION OF INCONSISTENCIES / CONFLICTS.

DRAWN	DATE	CHECKED	PLOT DATE	JOB NO.	SCALE
WTK	15.07.2022	JV	21.07.2022	18155	1:100@A1

**PROJECT**

90 COLLINS REDEVELOPMENT  
90 COLLINS STREET  
MELBOURNE VIC 3000

**mirvac**

**FENDER KATSALIDIS**

WWW.FKAUSTRALIA.COM  
2 RIVERSIDE QUAY, SOUTHBANK  
VICTORIA 3006 AUSTRALIA  
TELEPHONE: +61 3 8696 3888  
FENDER KATSALIDIS (AUST) PTY LTD ACN 092 943 032

**ISSUE PURPOSE**


TOWN PLANNING

**REV.**

02

**DRAWING NO.**

TP216

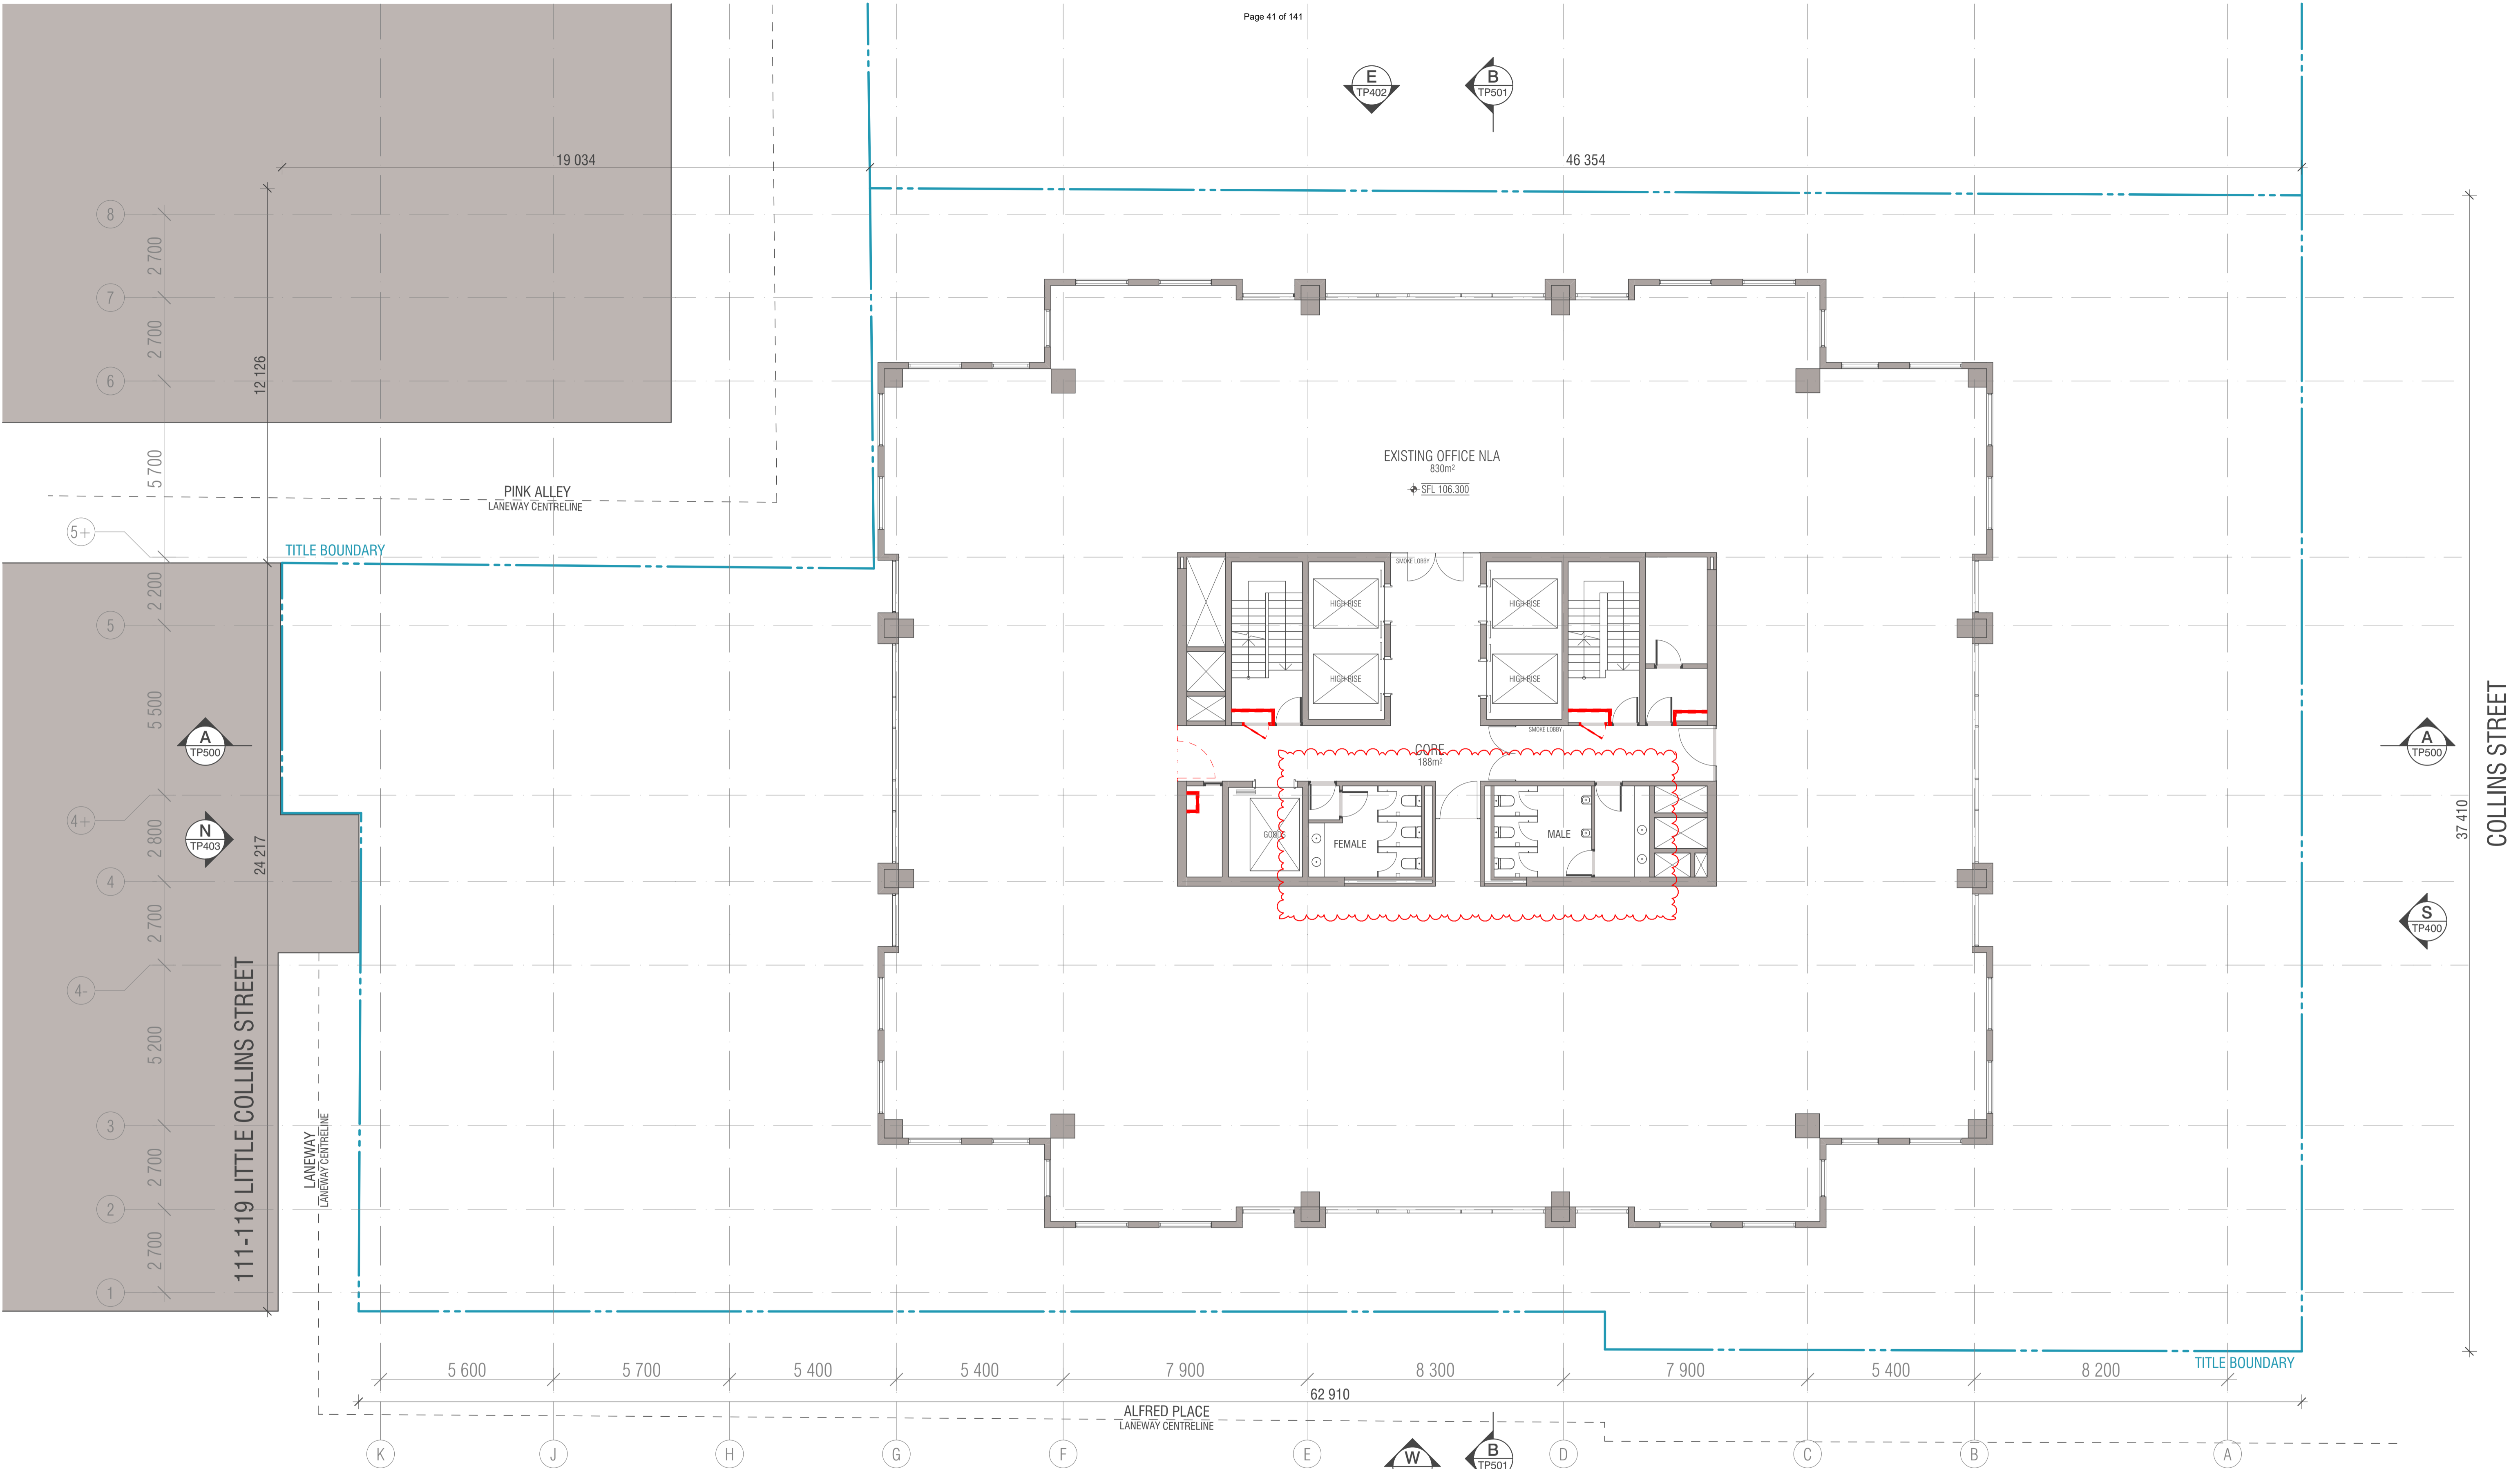

**WALL LEGEND**

- EXISTING (solid grey line)
- DEMOLISHED (red line)
- PROPOSED (black line)

BIMcloud: FK BIMCLOUD - BIMcloud\18155 90 Collins Street Melbourne\00 MODEL\00 - CD\BIM MODEL\18155 General

REVISION		REVISION	
-	TOWN PLANNING ISSUE 01	WTK	16.12.2021
01	TOWN PLANNING SUBMISSION 02	WTK	10.06.2022
> 02	TOWN PLANNING SUBMISSION 03	WTK	15.07.2022

**QUALITY ASSURANCE** (FK IS A CERTIFIED COMPANY TO ISO 9001:2015)

THIS PROJECT IS SUBJECT TO THE FK QUALITY ASSURANCE SYSTEM

- SCHEMATIC DESIGN REVIEW FOR THIS PROJECT IS YET TO BE COMPLETED.
- DESIGN DEVELOPMENT REVIEW FOR THIS PROJECT IS YET TO BE COMPLETED.
- TENDER DOCUMENTATION REVIEW FOR THIS PROJECT IS YET TO BE COMPLETED.
- CONSTRUCTION DOCUMENTATION REVIEW FOR THIS PROJECT IS YET TO BE COMPLETED.

IF THIS DRAWING IS STAMPED UNCONTROLLED COPY THEN IT IS TO BE CONSIDERED A DRAFT. SUBJECT TO REVISION WITHOUT NOTICE

**NOTES**

THIS DRAWING IS COPYRIGHT AND SHALL REMAIN THE PROPERTY OF FENDER KATSALIDIS (AUST) PTY LTD. CHECK AND VERIFY ALL DIMENSIONS ON SITE PRIOR TO COMMENCING WORK. DRAWING TO BE READ IN CONJUNCTION WITH ALL OTHER CONTRACT DOCUMENTS. DO NOT SCALE DRAWINGS. USE FIGURED DIMENSIONS ONLY. SEEK CLARIFICATION OF INCONSISTENCIES / CONFLICTS.


DRAWN	DATE	CHECKED	PLOT DATE	JOB NO.	SCALE
WTK	15.07.2022	JV	21.07.2022	18155	1:100@A1

**PROJECT**

90 COLLINS REDEVELOPMENT  
90 COLLINS STREET  
MELBOURNE VIC 3000



**FENDER KATSALIDIS**  
WWW.FKAUSTRALIA.COM  
2 RIVERSIDE QUAY, SOUTH BANK  
VICTORIA 3006 AUSTRALIA  
TELEPHONE: +61 3 8696 3888  
FENDER KATSALIDIS (AUST) PTY LTD ACN 092 943 032

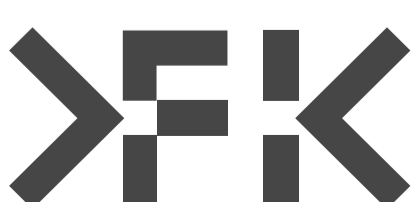


**DRAWING TITLE**

DEMOLITION LEVEL 20 FLOOR PLAN

**ISSUE PURPOSE**

TOWN PLANNING

REV. 02 DRAWING NO. TP220

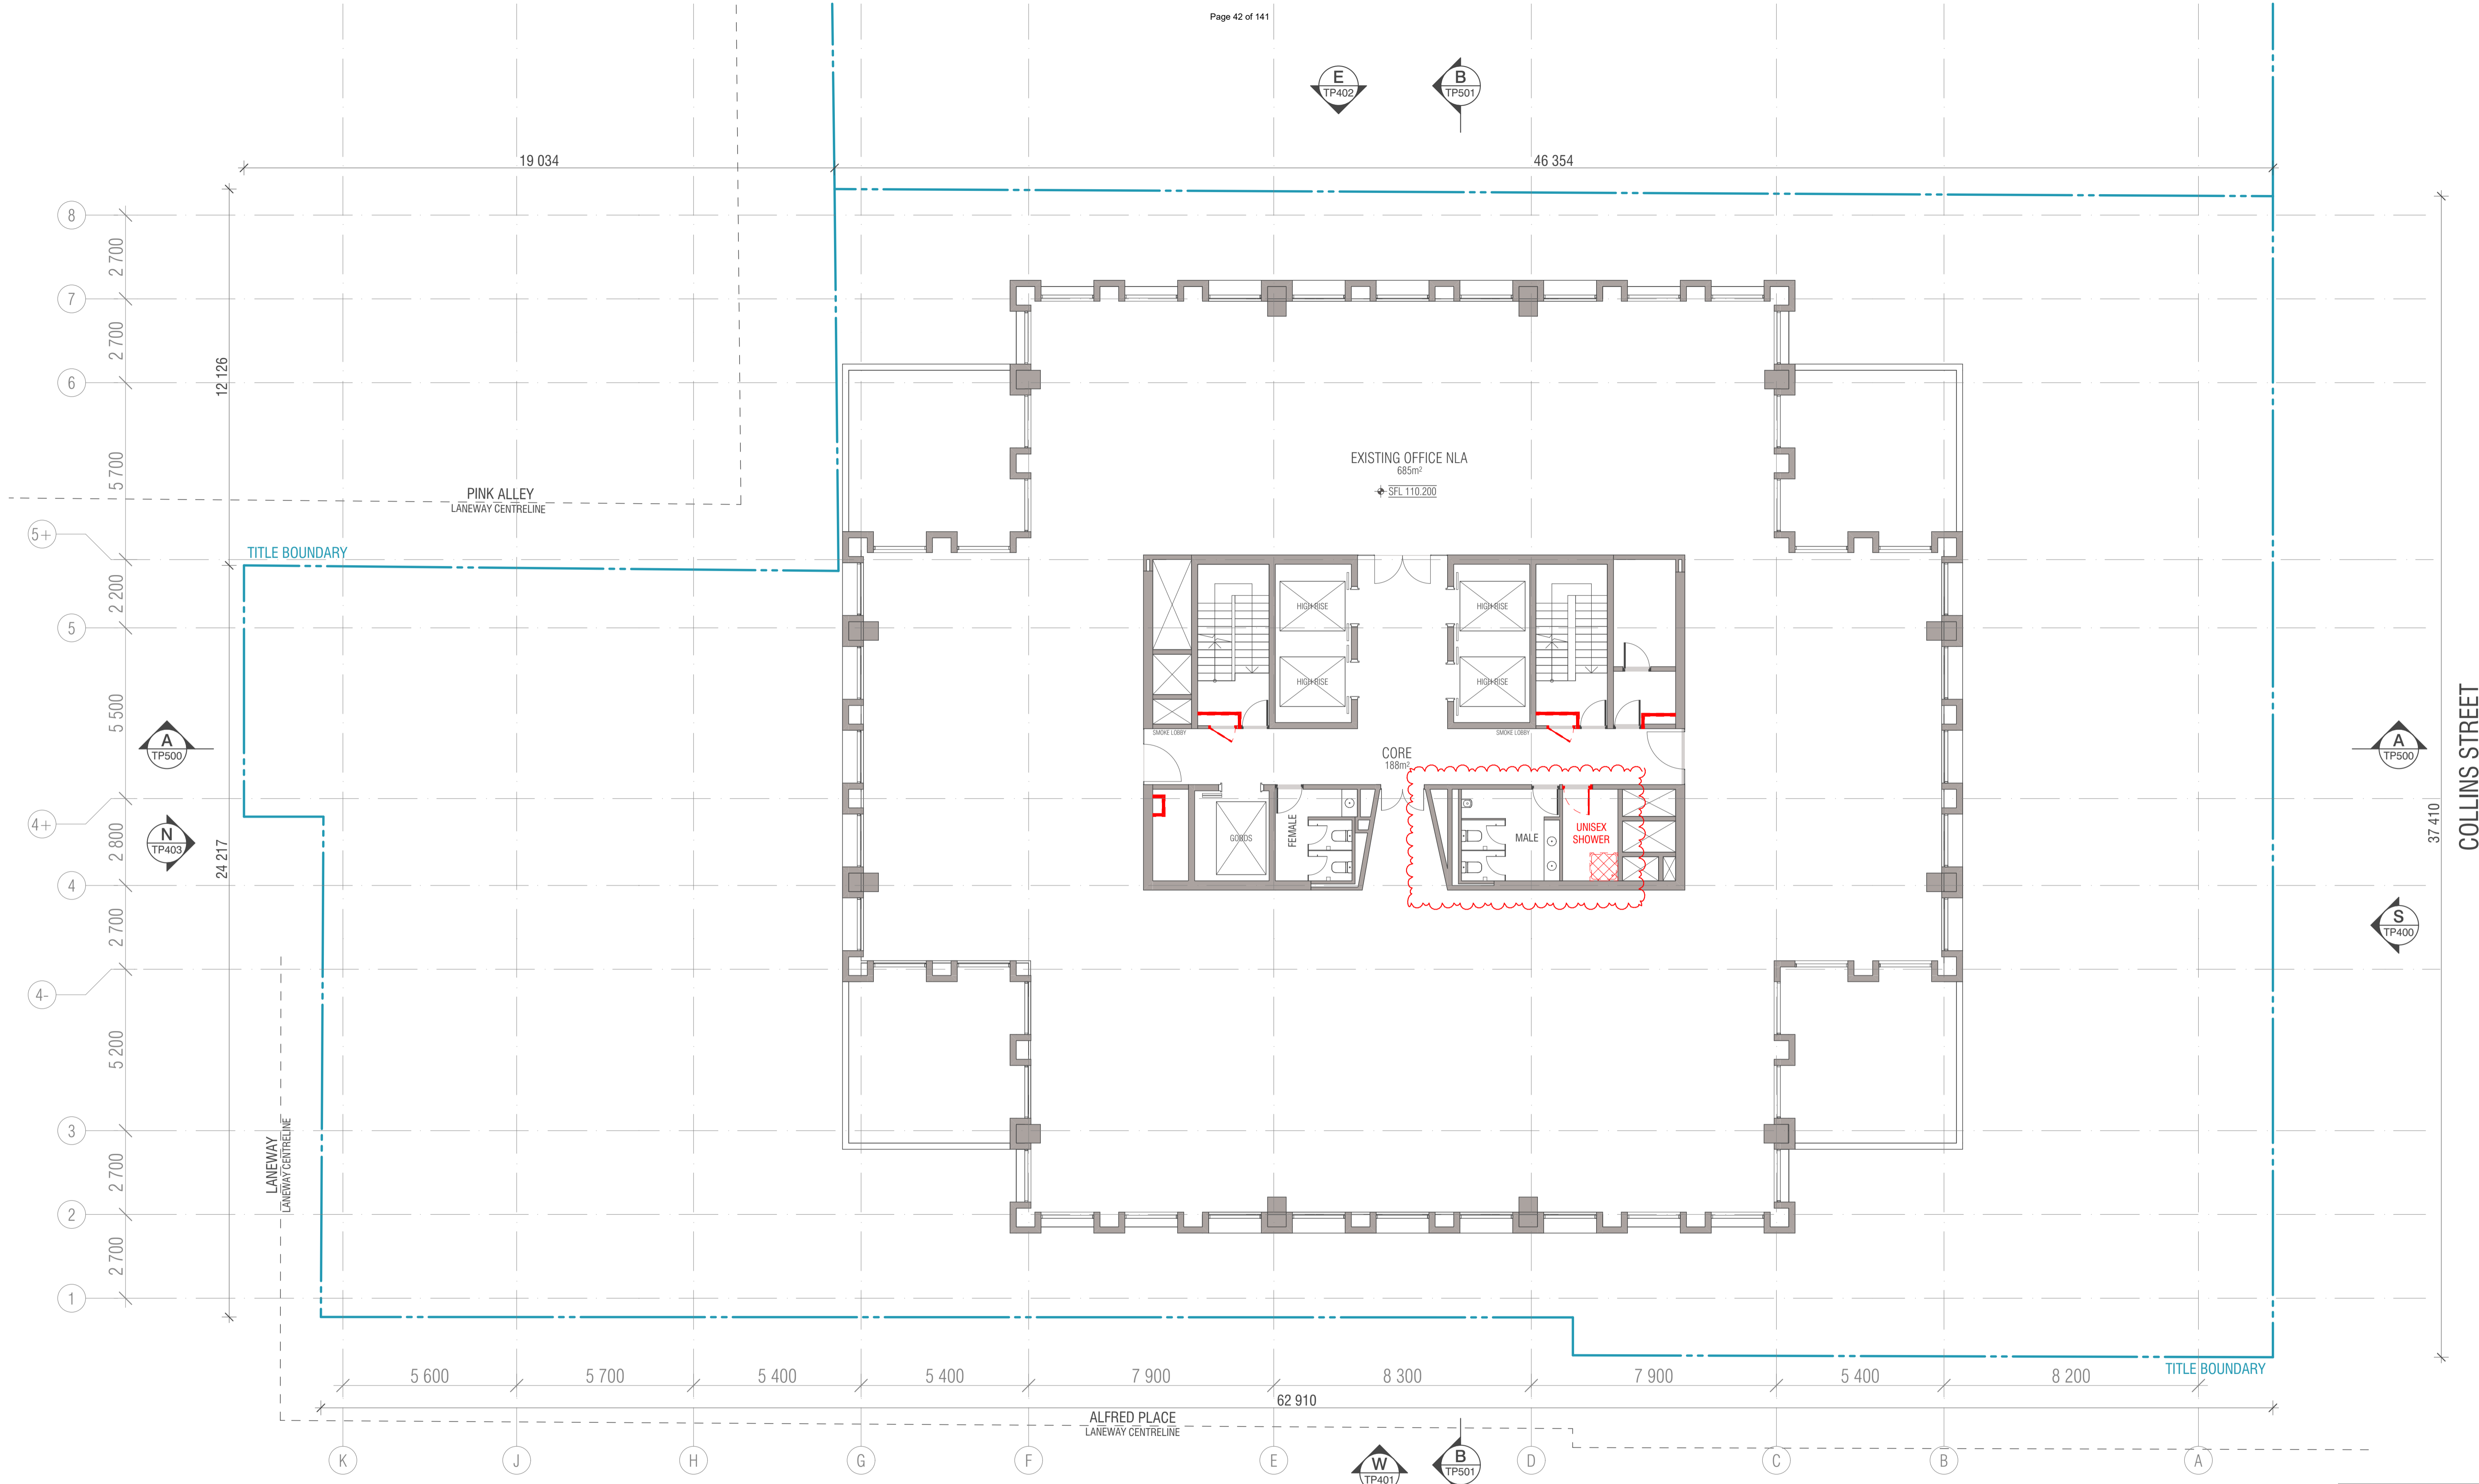

**WALL LEGEND**

- EXISTING (grey line)
- DEMOLISHED (red line)
- PROPOSED (black line)

BIMcloud: FK BIMCLOUD - BIMcloud\18155 90 Collins Street Melbourne\00 MODEL\00-CD\BIM MODEL\18155 General

REVISION	REVISION
01 TOWN PLANNING ISSUE 01	WTK 16.12.2021
02 TOWN PLANNING SUBMISSION 02	WTK 10.06.2022
03 TOWN PLANNING SUBMISSION 03	WTK 15.07.2022

**QUALITY ASSURANCE** (FK IS A CERTIFIED COMPANY TO ISO 9001:2015)

THIS PROJECT IS SUBJECT TO THE FK QUALITY ASSURANCE SYSTEM

- SCHEMATIC DESIGN REVIEW FOR THIS PROJECT IS YET TO BE COMPLETED.
- DESIGN DEVELOPMENT REVIEW FOR THIS PROJECT IS YET TO BE COMPLETED.
- TENDER DOCUMENTATION REVIEW FOR THIS PROJECT IS YET TO BE COMPLETED.
- CONSTRUCTION DOCUMENTATION REVIEW FOR THIS PROJECT IS YET TO BE COMPLETED.

IF THIS DRAWING IS STAMPED UNCONTROLLED COPY THEN IT IS TO BE CONSIDERED A DRAFT. SUBJECT TO REVISION WITHOUT NOTICE

**NOTES**

THIS DRAWING IS COPYRIGHT AND SHALL REMAIN THE PROPERTY OF FENDER KATSALIDIS (AUST) PTY LTD. CHECK AND VERIFY ALL DIMENSIONS ON SITE PRIOR TO COMMENCING WORK. DRAWING TO BE READ IN CONJUNCTION WITH ALL OTHER CONTRACT DOCUMENTS. DO NOT SCALE DRAWINGS. USE FIGURED DIMENSIONS ONLY. SEEK CLARIFICATION OF INCONSISTENCIES / CONFLICTS.

DRAWN	DATE	CHECKED	PLOT DATE	JOB NO.	SCALE
WTK	15.07.2022	JV	21.07.2022	18155	1:100@A1

**PROJECT**

90 COLLINS REDEVELOPMENT  
90 COLLINS STREET  
MELBOURNE VIC 3000



**FENDER KATSALIDIS**  
WWW.FKAUSTRALIA.COM  
2 RIVERSIDE QUAY, SOUTHBANK  
VICTORIA 3006 AUSTRALIA  
TELEPHONE: +61 3 8696 3888  
FENDER KATSALIDIS (AUST) PTY LTD ACN 092 943 032



**DRAWING TITLE**



DEMOLITION LEVEL 21 FLOOR PLAN

**ISSUE PURPOSE**

TOWN PLANNING

**REV.** 02 **DRAWING NO.** TP221



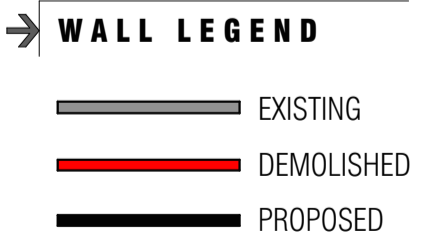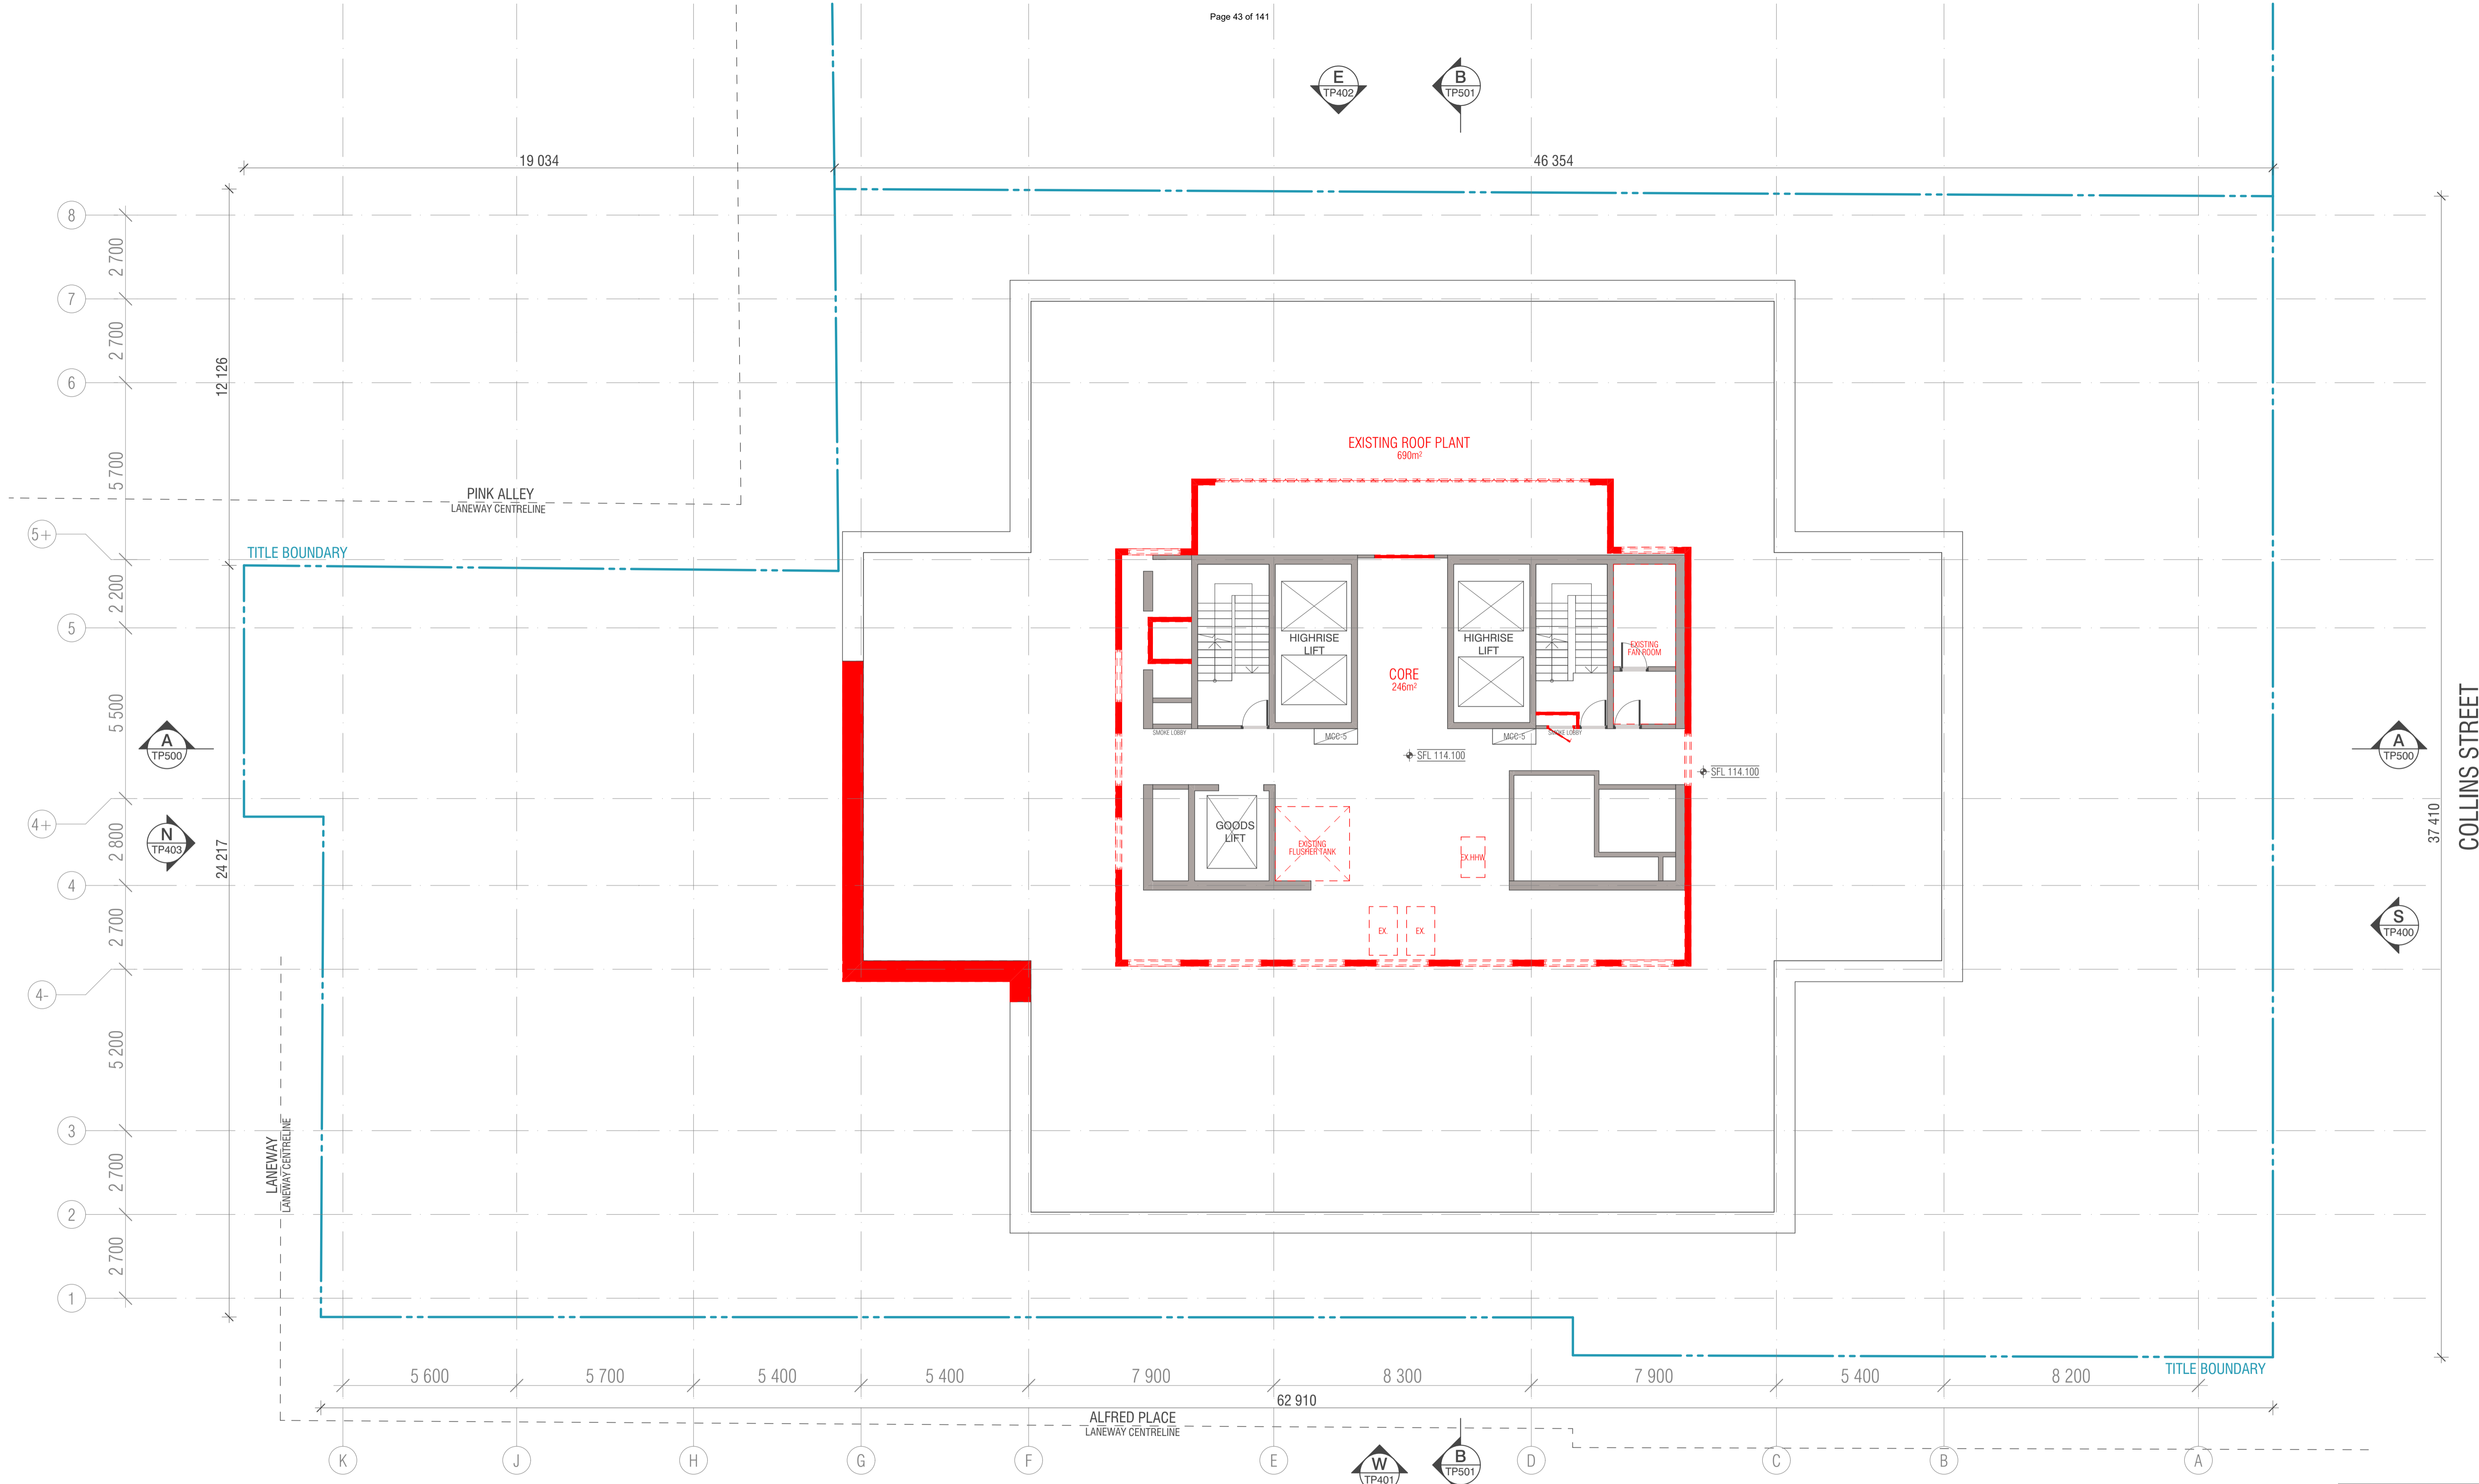

BIMcloud: FBIMCLOUD - BIMcloud\18155 90 Collins Street Melbourne\00 MODEL\00-CD\BIM MODEL\18155 General

REVISION	DATE	BY	REVISION
> 01	TOWN PLANNING SUBMISSION 02	WTK	10.06.2022
-	TOWN PLANNING ISSUE 01	WTK	16.12.2021

**QUALITY ASSURANCE** (FK IS A CERTIFIED COMPANY TO ISO 9001:2015)

THIS PROJECT IS SUBJECT TO THE FK QUALITY ASSURANCE SYSTEM

- SCHEMATIC DESIGN REVIEW FOR THIS PROJECT IS YET TO BE COMPLETED.
- DESIGN DEVELOPMENT REVIEW FOR THIS PROJECT IS YET TO BE COMPLETED.
- TENDER DOCUMENTATION REVIEW FOR THIS PROJECT IS YET TO BE COMPLETED.
- CONSTRUCTION DOCUMENTATION REVIEW FOR THIS DRAWING IS YET TO BE COMPLETED.

IF THIS DRAWING IS STAMPED UNCONTROLLED COPY THEN IT IS TO BE CONSIDERED A DRAFT. SUBJECT TO REVISION WITHOUT NOTICE

**NOTES**

THIS DRAWING IS COPYRIGHT AND SHALL REMAIN THE PROPERTY OF FENDER KATSALIDIS (AUST) PTY LTD. CHECK AND VERIFY ALL DIMENSIONS ON SITE PRIOR TO COMMENCING WORK. DRAWING TO BE READ IN CONJUNCTION WITH ALL OTHER CONTRACT DOCUMENTS. DO NOT SCALE DRAWINGS. USE FIGURED DIMENSIONS ONLY. SEEK CLARIFICATION OF INCONSISTENCIES / CONFLICTS.

DRAWN	DATE	CHECKED	PLOT DATE	JOB NO.	SCALE
WTK	10.06.2022	JV	21.07.2022	18155	1:100@A1

**PROJECT**

90 COLLINS REDEVELOPMENT  
90 COLLINS STREET  
MELBOURNE VIC 3000



**FENDER KATSALIDIS**  
WWW.FKAUSTRALIA.COM  
2 RIVERSIDE QUAY, SOUTHBANK  
VICTORIA 3006 AUSTRALIA  
TELEPHONE: +61 3 8696 3888  
FENDER KATSALIDIS (AUST) PTY LTD ACN 092 943 032




**DRAWING TITLE**

DEMOLITION LEVEL 22 FLOOR PLAN

**ISSUE PURPOSE**

TOWN PLANNING

**REV.** 01 **DRAWING NO.** TP222

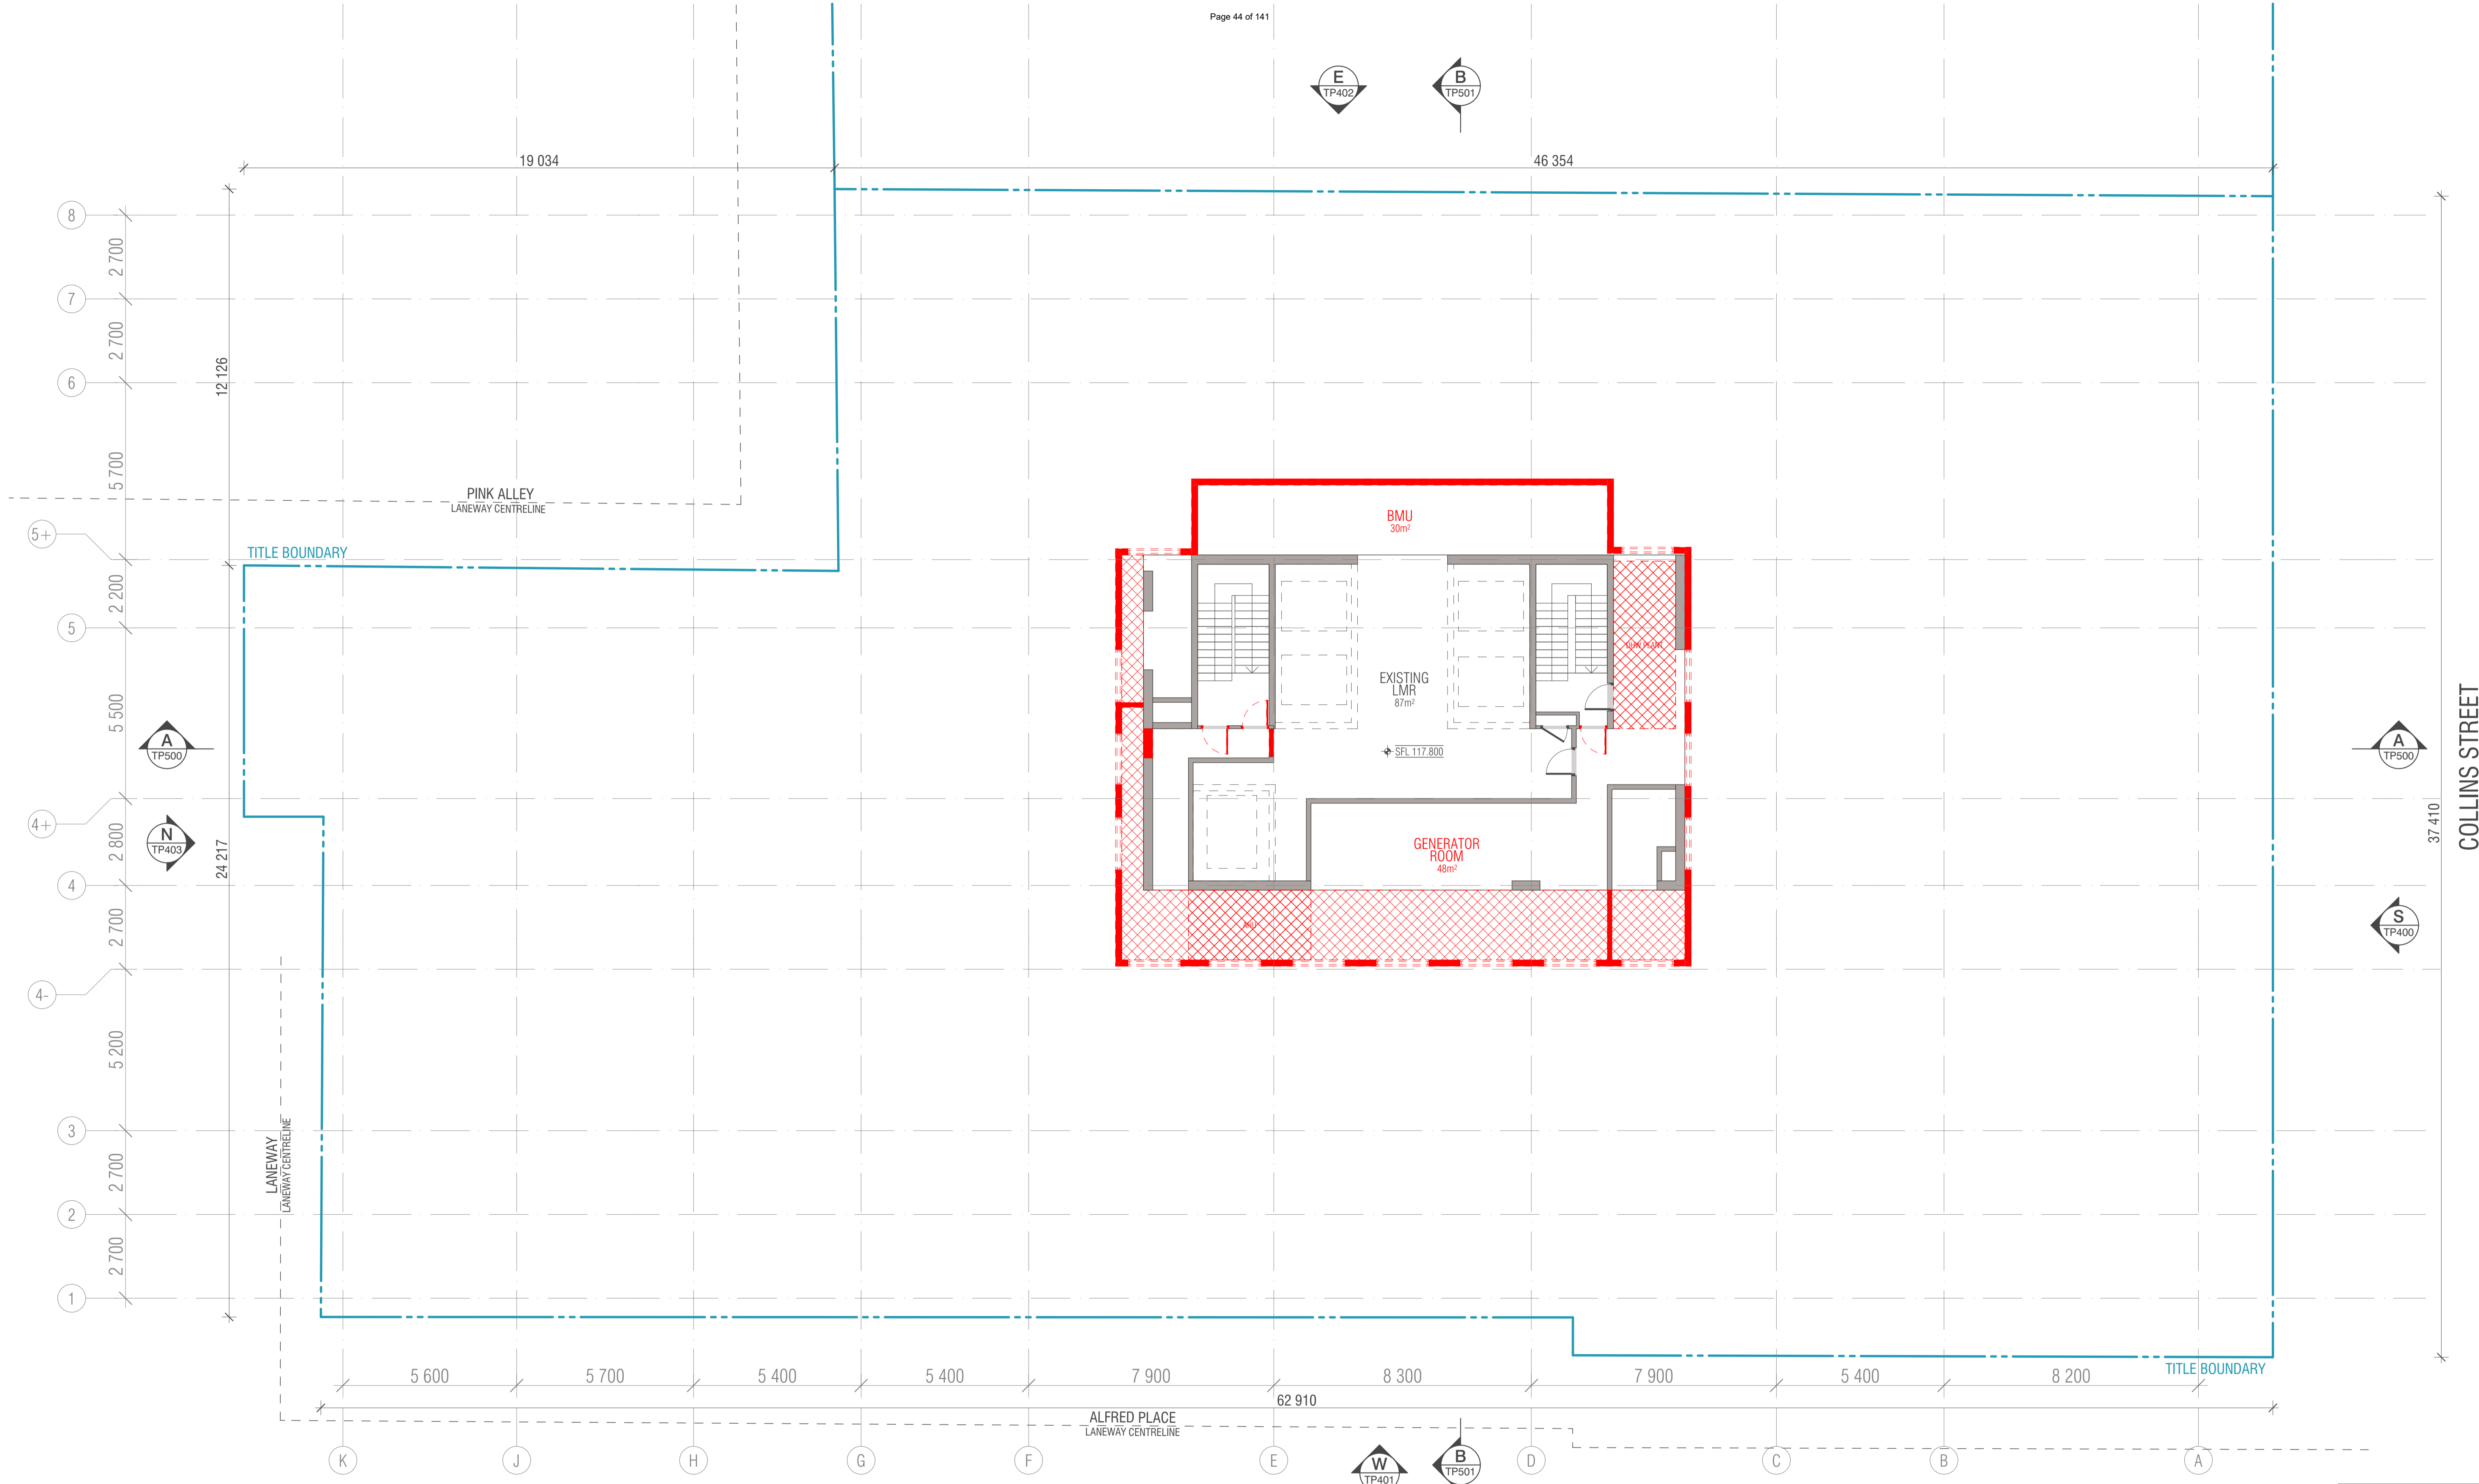

**WALL LEGEND**

- EXISTING
- DEMOLISHED
- PROPOSED

BIMcloud: FK BIMCLOUD - BIMcloud\18155 90 Collins Street Melbourne\00 MODEL\00-CD\BIM MODEL\18155 General

REVISION	DESCRIPTION	DATE	BY
> 01	TOWN PLANNING SUBMISSION 02	10.06.2022	WTK
-	TOWN PLANNING ISSUE 01	16.12.2021	WTK

REVISION	DESCRIPTION	DATE	BY
-	TOWN PLANNING ISSUE 01	16.12.2021	WTK
> 01	TOWN PLANNING SUBMISSION 02	10.06.2022	WTK

**QUALITY ASSURANCE** (FK IS A CERTIFIED COMPANY TO ISO 9001:2015)

THIS PROJECT IS SUBJECT TO THE FK QUALITY ASSURANCE SYSTEM

- SCHEMATIC DESIGN REVIEW FOR THIS PROJECT IS YET TO BE COMPLETED.
- DESIGN DEVELOPMENT REVIEW FOR THIS PROJECT IS YET TO BE COMPLETED.
- TENDER DOCUMENTATION REVIEW FOR THIS PROJECT IS YET TO BE COMPLETED.
- CONSTRUCTION DOCUMENTATION REVIEW FOR THIS DRAWING IS YET TO BE COMPLETED.

IF THIS DRAWING IS STAMPED UNCONTROLLED COPY THEN IT IS TO BE CONSIDERED A DRAFT. SUBJECT TO REVISION WITHOUT NOTICE

**NOTES**

THIS DRAWING IS COPYRIGHT AND SHALL REMAIN THE PROPERTY OF FENDER KATSALIDIS (AUST) PTY LTD. CHECK AND VERIFY ALL DIMENSIONS ON SITE PRIOR TO COMMENCING WORK. DRAWING TO BE READ IN CONJUNCTION WITH ALL OTHER CONTRACT DOCUMENTS. DO NOT SCALE DRAWINGS. USE FIGURED DIMENSIONS ONLY. SEEK CLARIFICATION OF INCONSISTENCIES / CONFLICTS.

DRAWN	DATE	CHECKED	PLOT DATE	JOB NO.	SCALE
WTK	10.06.2022	JV	21.07.2022	18155	1:100@A1

**PROJECT**  
 90 COLLINS REDEVELOPMENT  
 90 COLLINS STREET  
 MELBOURNE VIC 3000




**FENDER KATSALIDIS**  
 WWW.FKAUSTRALIA.COM  
 2 RIVERSIDE QUAY, SOUTHBANK  
 VICTORIA 3006 AUSTRALIA  
 TELEPHONE: +61 3 8696 3888  
 FENDER KATSALIDIS (AUST) PTY LTD ACN 092 943 032



**DRAWING TITLE**  
 DEMOLITION LEVEL 23 TRANSFER FLOOR PLAN

**ISSUE PURPOSE**  
 TOWN PLANNING

**REV.** 01  
**DRAWING NO.** TP223

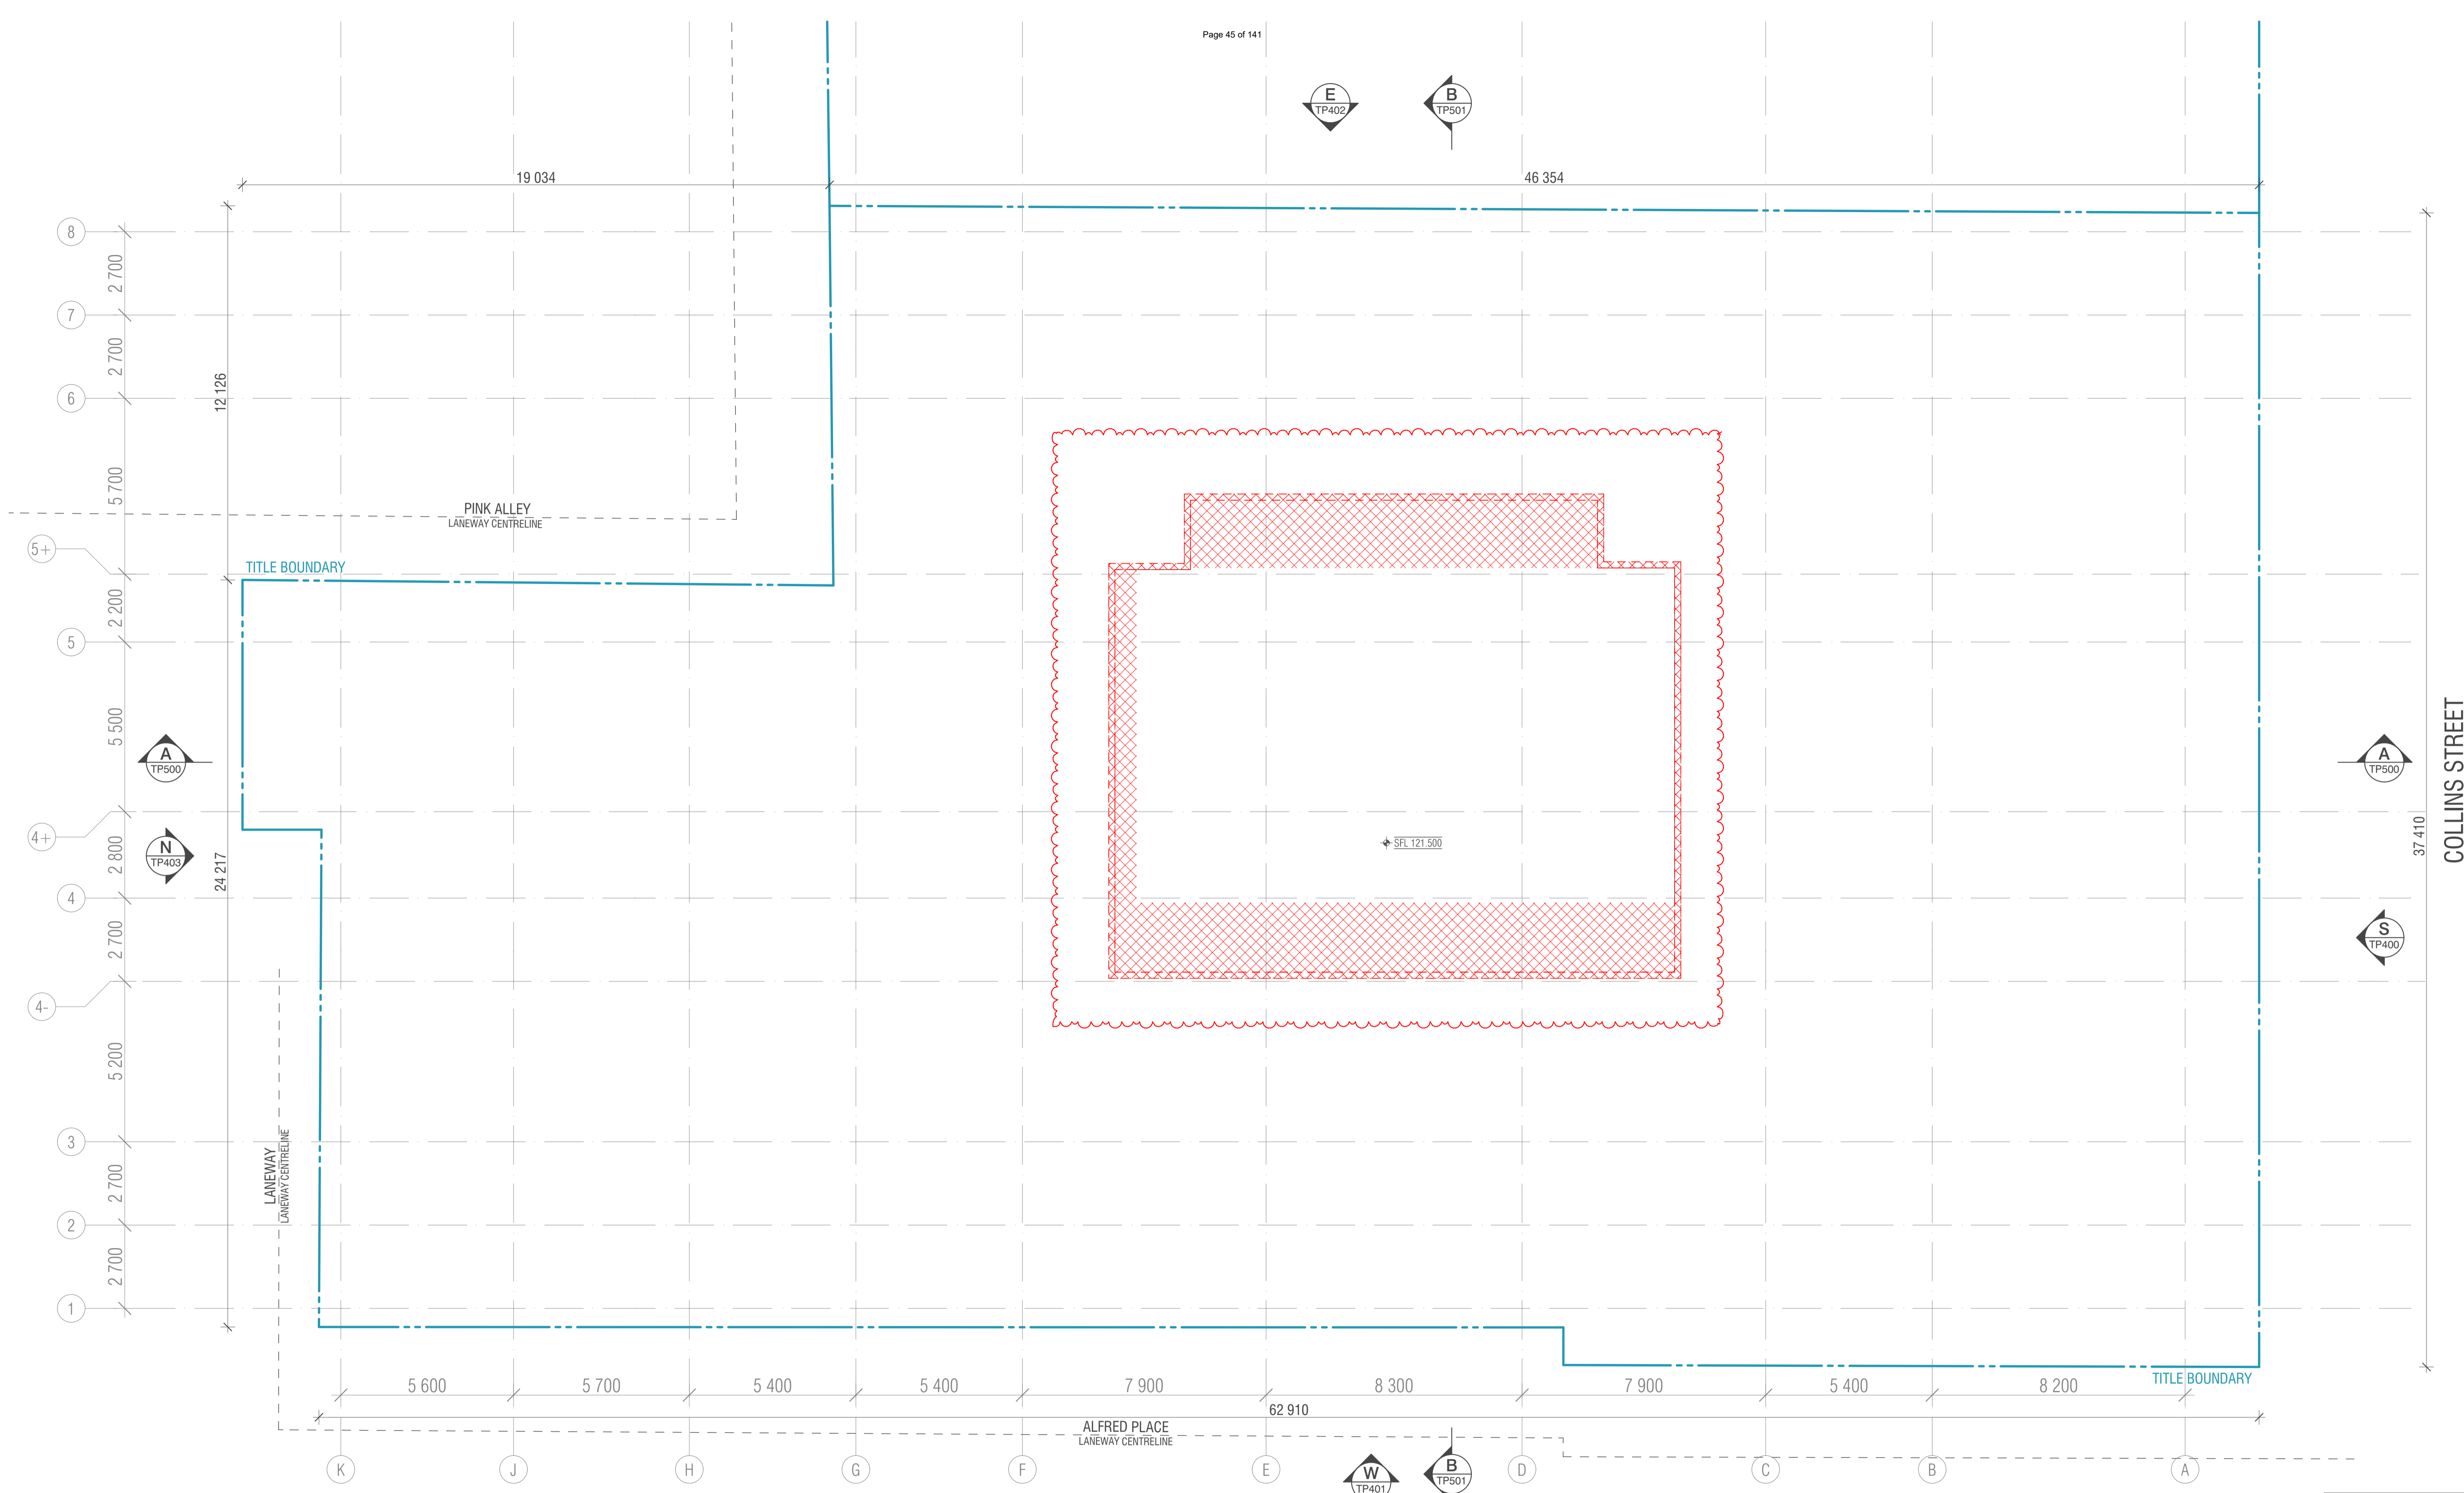

**WALL LEGEND**

- EXISTING
- DEMOLISHED
- PROPOSED

BIMcloud: FK BIMCLOUD - BIMcloud\18155 90 Collins Street Melbourne\00 MODEL\00-CD\BIM MODEL\18155 General

REVISION		REVISION	
01	TOWN PLANNING ISSUE 01	WTK	16.12.2021
02	TOWN PLANNING SUBMISSION 02	WTK	10.06.2022
03	TOWN PLANNING SUBMISSION 03	WTK	15.07.2022

**QUALITY ASSURANCE** (FK IS A CERTIFIED COMPANY TO ISO 9001:2015)

THIS PROJECT IS SUBJECT TO THE FK QUALITY ASSURANCE SYSTEM

- SCHEMATIC DESIGN REVIEW FOR THIS PROJECT IS YET TO BE COMPLETED.
- DESIGN DEVELOPMENT REVIEW FOR THIS PROJECT IS YET TO BE COMPLETED.
- TENDER DOCUMENTATION REVIEW FOR THIS PROJECT IS YET TO BE COMPLETED.
- CONSTRUCTION DOCUMENTATION REVIEW FOR THIS PROJECT IS YET TO BE COMPLETED.

IF THIS DRAWING IS STAMPED UNCONTROLLED COPY THEN IT IS TO BE CONSIDERED A DRAFT. SUBJECT TO REVISION WITHOUT NOTICE

**NOTES**

THIS DRAWING IS COPYRIGHT AND SHALL REMAIN THE PROPERTY OF FENDER KATSALIDIS (AUST) PTY LTD. CHECK AND VERIFY ALL DIMENSIONS ON SITE PRIOR TO COMMENCING WORK. DRAWING TO BE READ IN CONJUNCTION WITH ALL OTHER CONTRACT DOCUMENTS. DO NOT SCALE DRAWINGS. USE FIGURED DIMENSIONS ONLY. SEEK CLARIFICATION OF INCONSISTENCIES / CONFLICTS.

DRAWN	DATE	CHECKED	PLOT DATE	JOB NO.	SCALE
WTK	15.07.2022	JV	21.07.2022	18155	1:100@A1

**PROJECT**

90 COLLINS REDEVELOPMENT  
90 COLLINS STREET  
MELBOURNE VIC 3000




**FENDER KATSALIDIS**  
WWW.FKAUSTRALIA.COM  
2 RIVERSIDE QUAY, SOUTHBANK  
VICTORIA 3006 AUSTRALIA  
TELEPHONE: +61 3 8696 3888  
FENDER KATSALIDIS (AUST) PTY LTD ACN 092 943 032



DRAWING TITLE	ISSUE PURPOSE	REV.	DRAWING NO.
DEMOLITION LEVEL 24 CORE ROOF PLAN	TOWN PLANNING	02	TP224



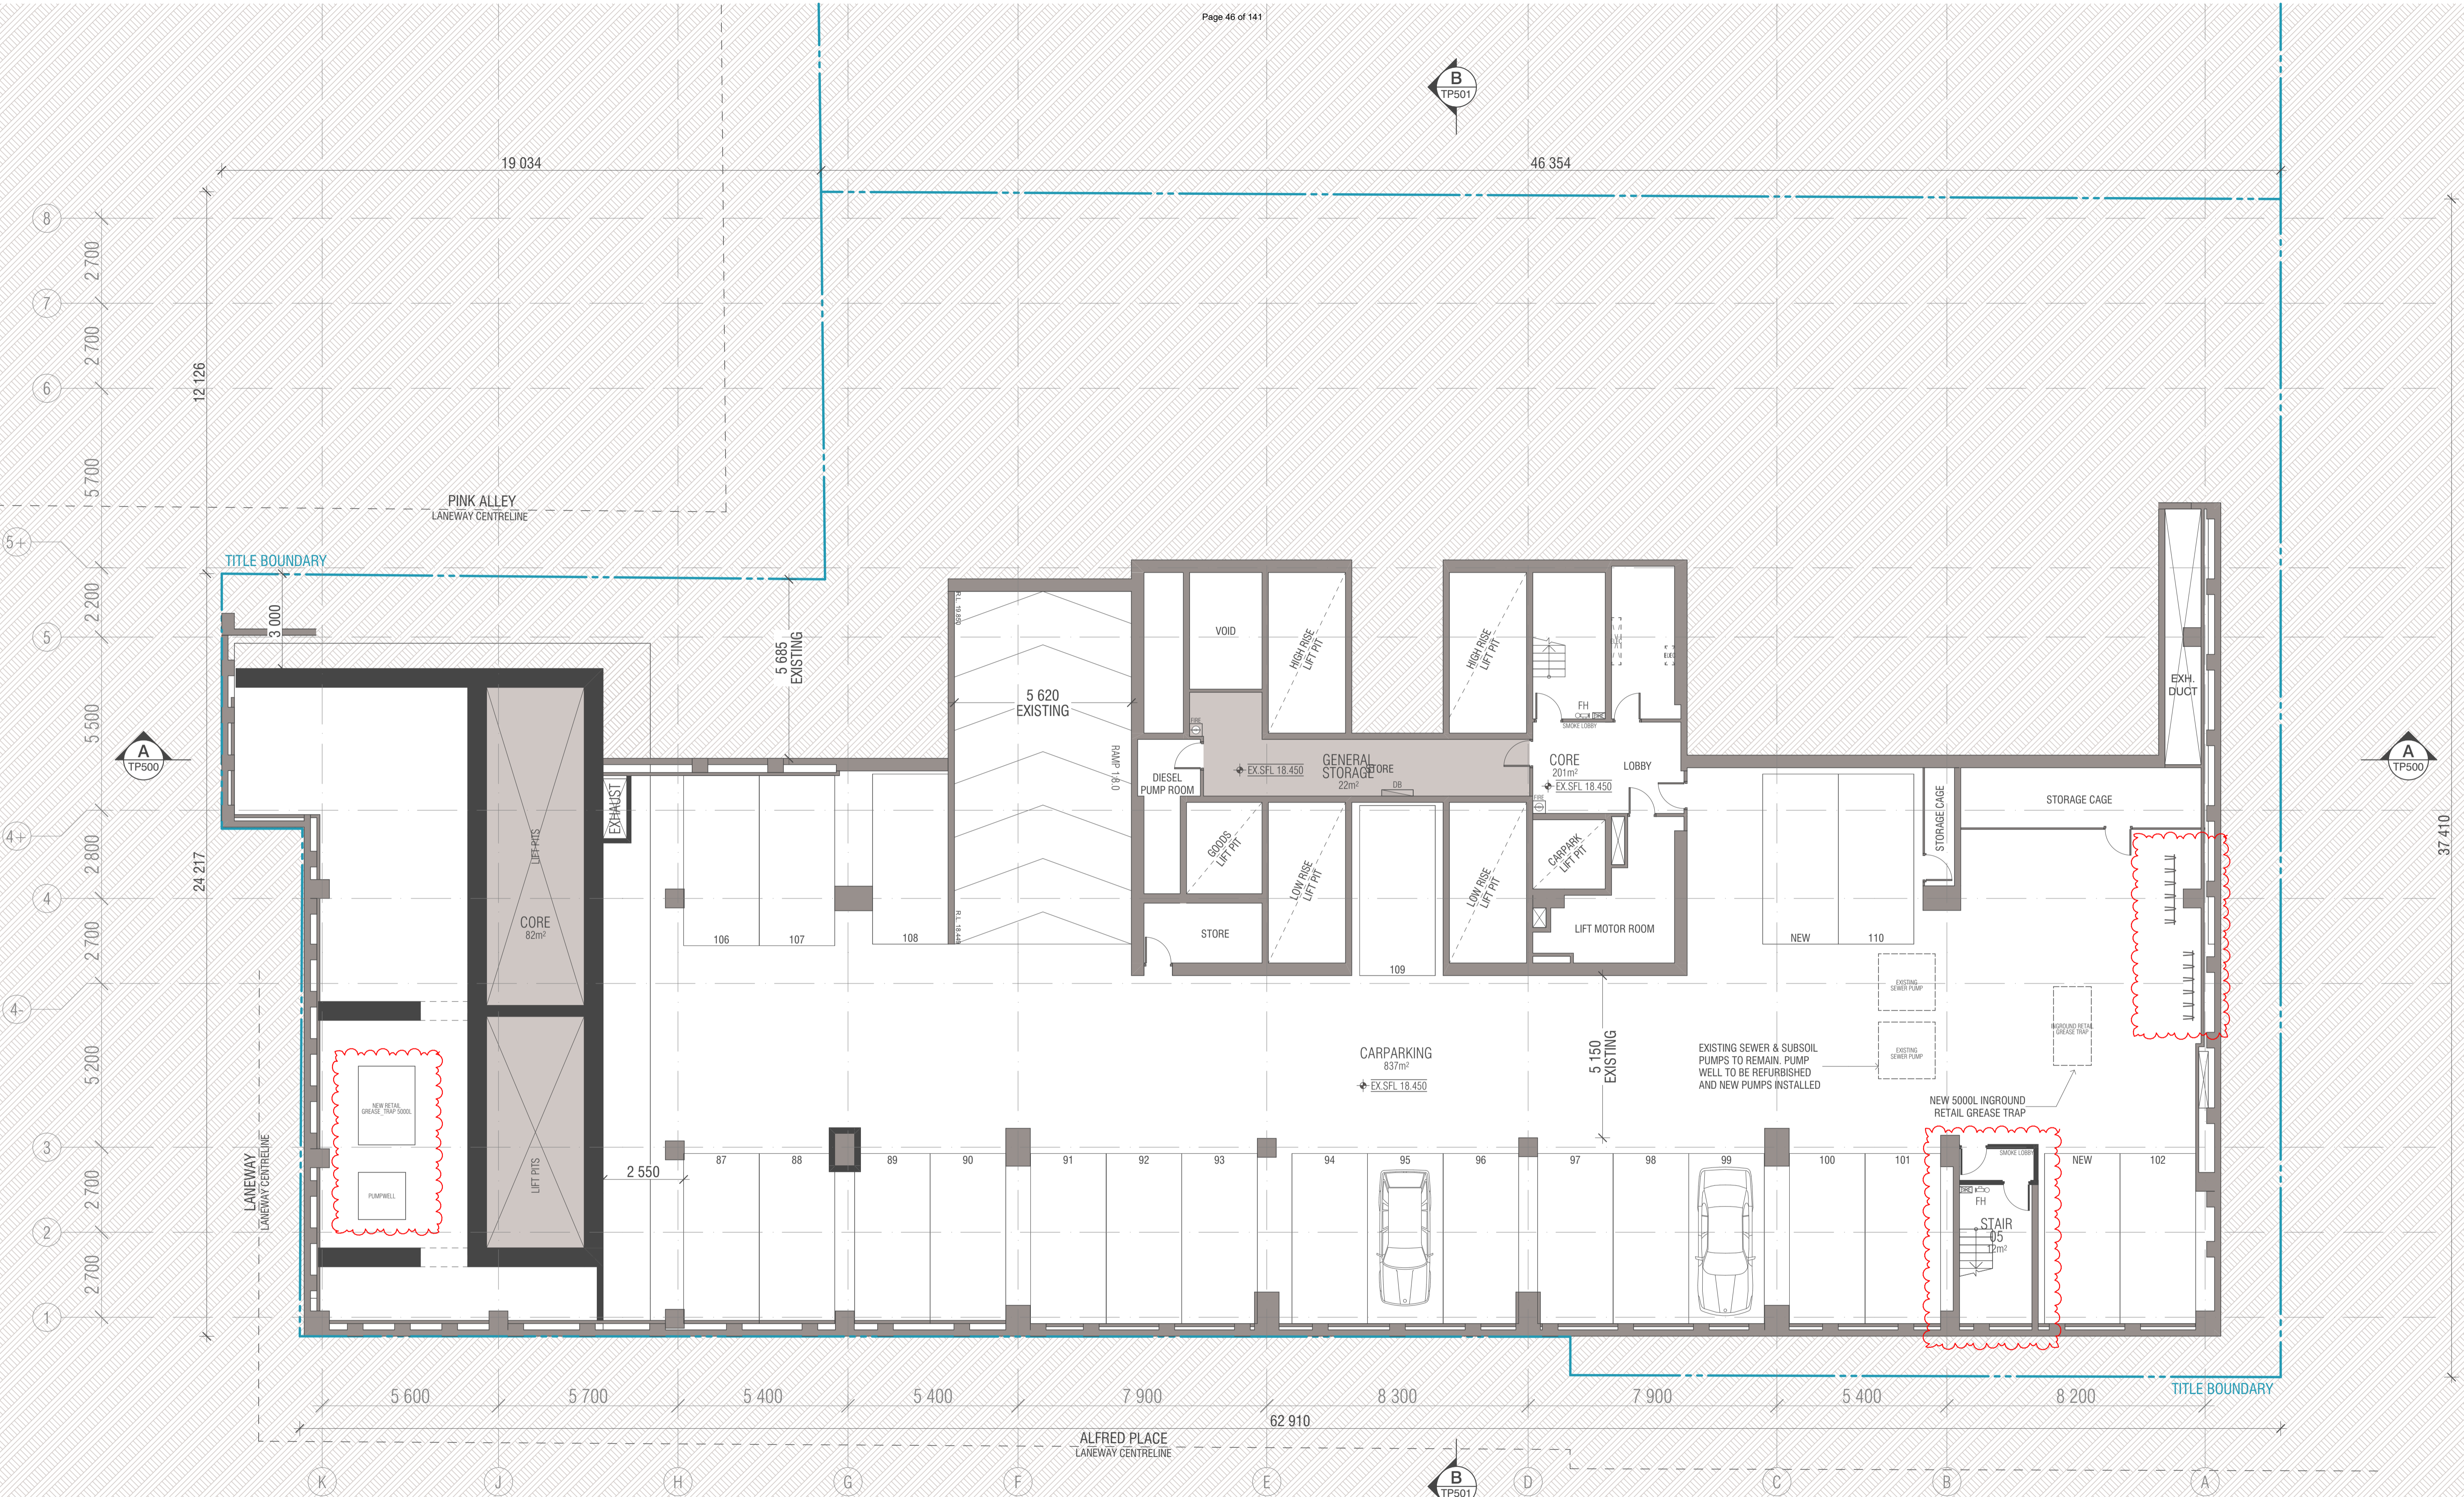

**WALL LEGEND**

- EXISTING
- DEMOLISHED
- PROPOSED

BIMcloud: FK BIMCLOUD - BIMcloud\18155 90 Collins Street Melbourne\00 MODEL\00-CD\BIM MODEL\18155 General

REVISION	REVISION
01 TOWN PLANNING ISSUE 01	WTK 16.12.2021
02 TOWN PLANNING SUBMISSION 02	WTK 10.06.2022
03 TOWN PLANNING SUBMISSION 03	WTK 15.07.2022

**QUALITY ASSURANCE** (FK IS A CERTIFIED COMPANY TO ISO 9001:2015)

THIS PROJECT IS SUBJECT TO THE FK QUALITY ASSURANCE SYSTEM

- SCHEMATIC DESIGN REVIEW FOR THIS PROJECT IS YET TO BE COMPLETED.
- DESIGN DEVELOPMENT REVIEW FOR THIS PROJECT IS YET TO BE COMPLETED.
- TENDER DOCUMENTATION REVIEW FOR THIS PROJECT IS YET TO BE COMPLETED.
- CONSTRUCTION DOCUMENTATION REVIEW FOR THIS PROJECT IS YET TO BE COMPLETED.

IF THIS DRAWING IS STAMPED UNCONTROLLED COPY THEN IT IS TO BE CONSIDERED A DRAFT. SUBJECT TO REVISION WITHOUT NOTICE

**NOTES**

THIS DRAWING IS COPYRIGHT AND SHALL REMAIN THE PROPERTY OF FENDER KATSALIDIS (AUST) PTY LTD. CHECK AND VERIFY ALL DIMENSIONS ON SITE PRIOR TO COMMENCING WORK. DRAWING TO BE READ IN CONJUNCTION WITH ALL OTHER CONTRACT DOCUMENTS. DO NOT SCALE DRAWINGS. USE FIGURED DIMENSIONS ONLY. SEEK CLARIFICATION OF INCONSISTENCIES / CONFLICTS.

DRAWN	DATE	CHECKED	PLOT DATE	JOB NO.	SCALE
WTK	15.07.2022	JV	21.07.2022	18155	1:100@A1

**PROJECT**

90 COLLINS REDEVELOPMENT  
90 COLLINS STREET  
MELBOURNE VIC 3000



**FENDER KATSALIDIS**  
WWW.FKAUSTRALIA.COM  
2 RIVERSIDE QUAY, SOUTH BANK  
VICTORIA 3006 AUSTRALIA  
TELEPHONE: +61 3 8696 3888  
FENDER KATSALIDIS (AUST) PTY LTD ACN 092 943 032



**DRAWING TITLE**


PROPOSED BASEMENT 3 FLOOR PLAN

**ISSUE PURPOSE**

TOWN PLANNING

**REV.** 02 **DRAWING NO.** TP297



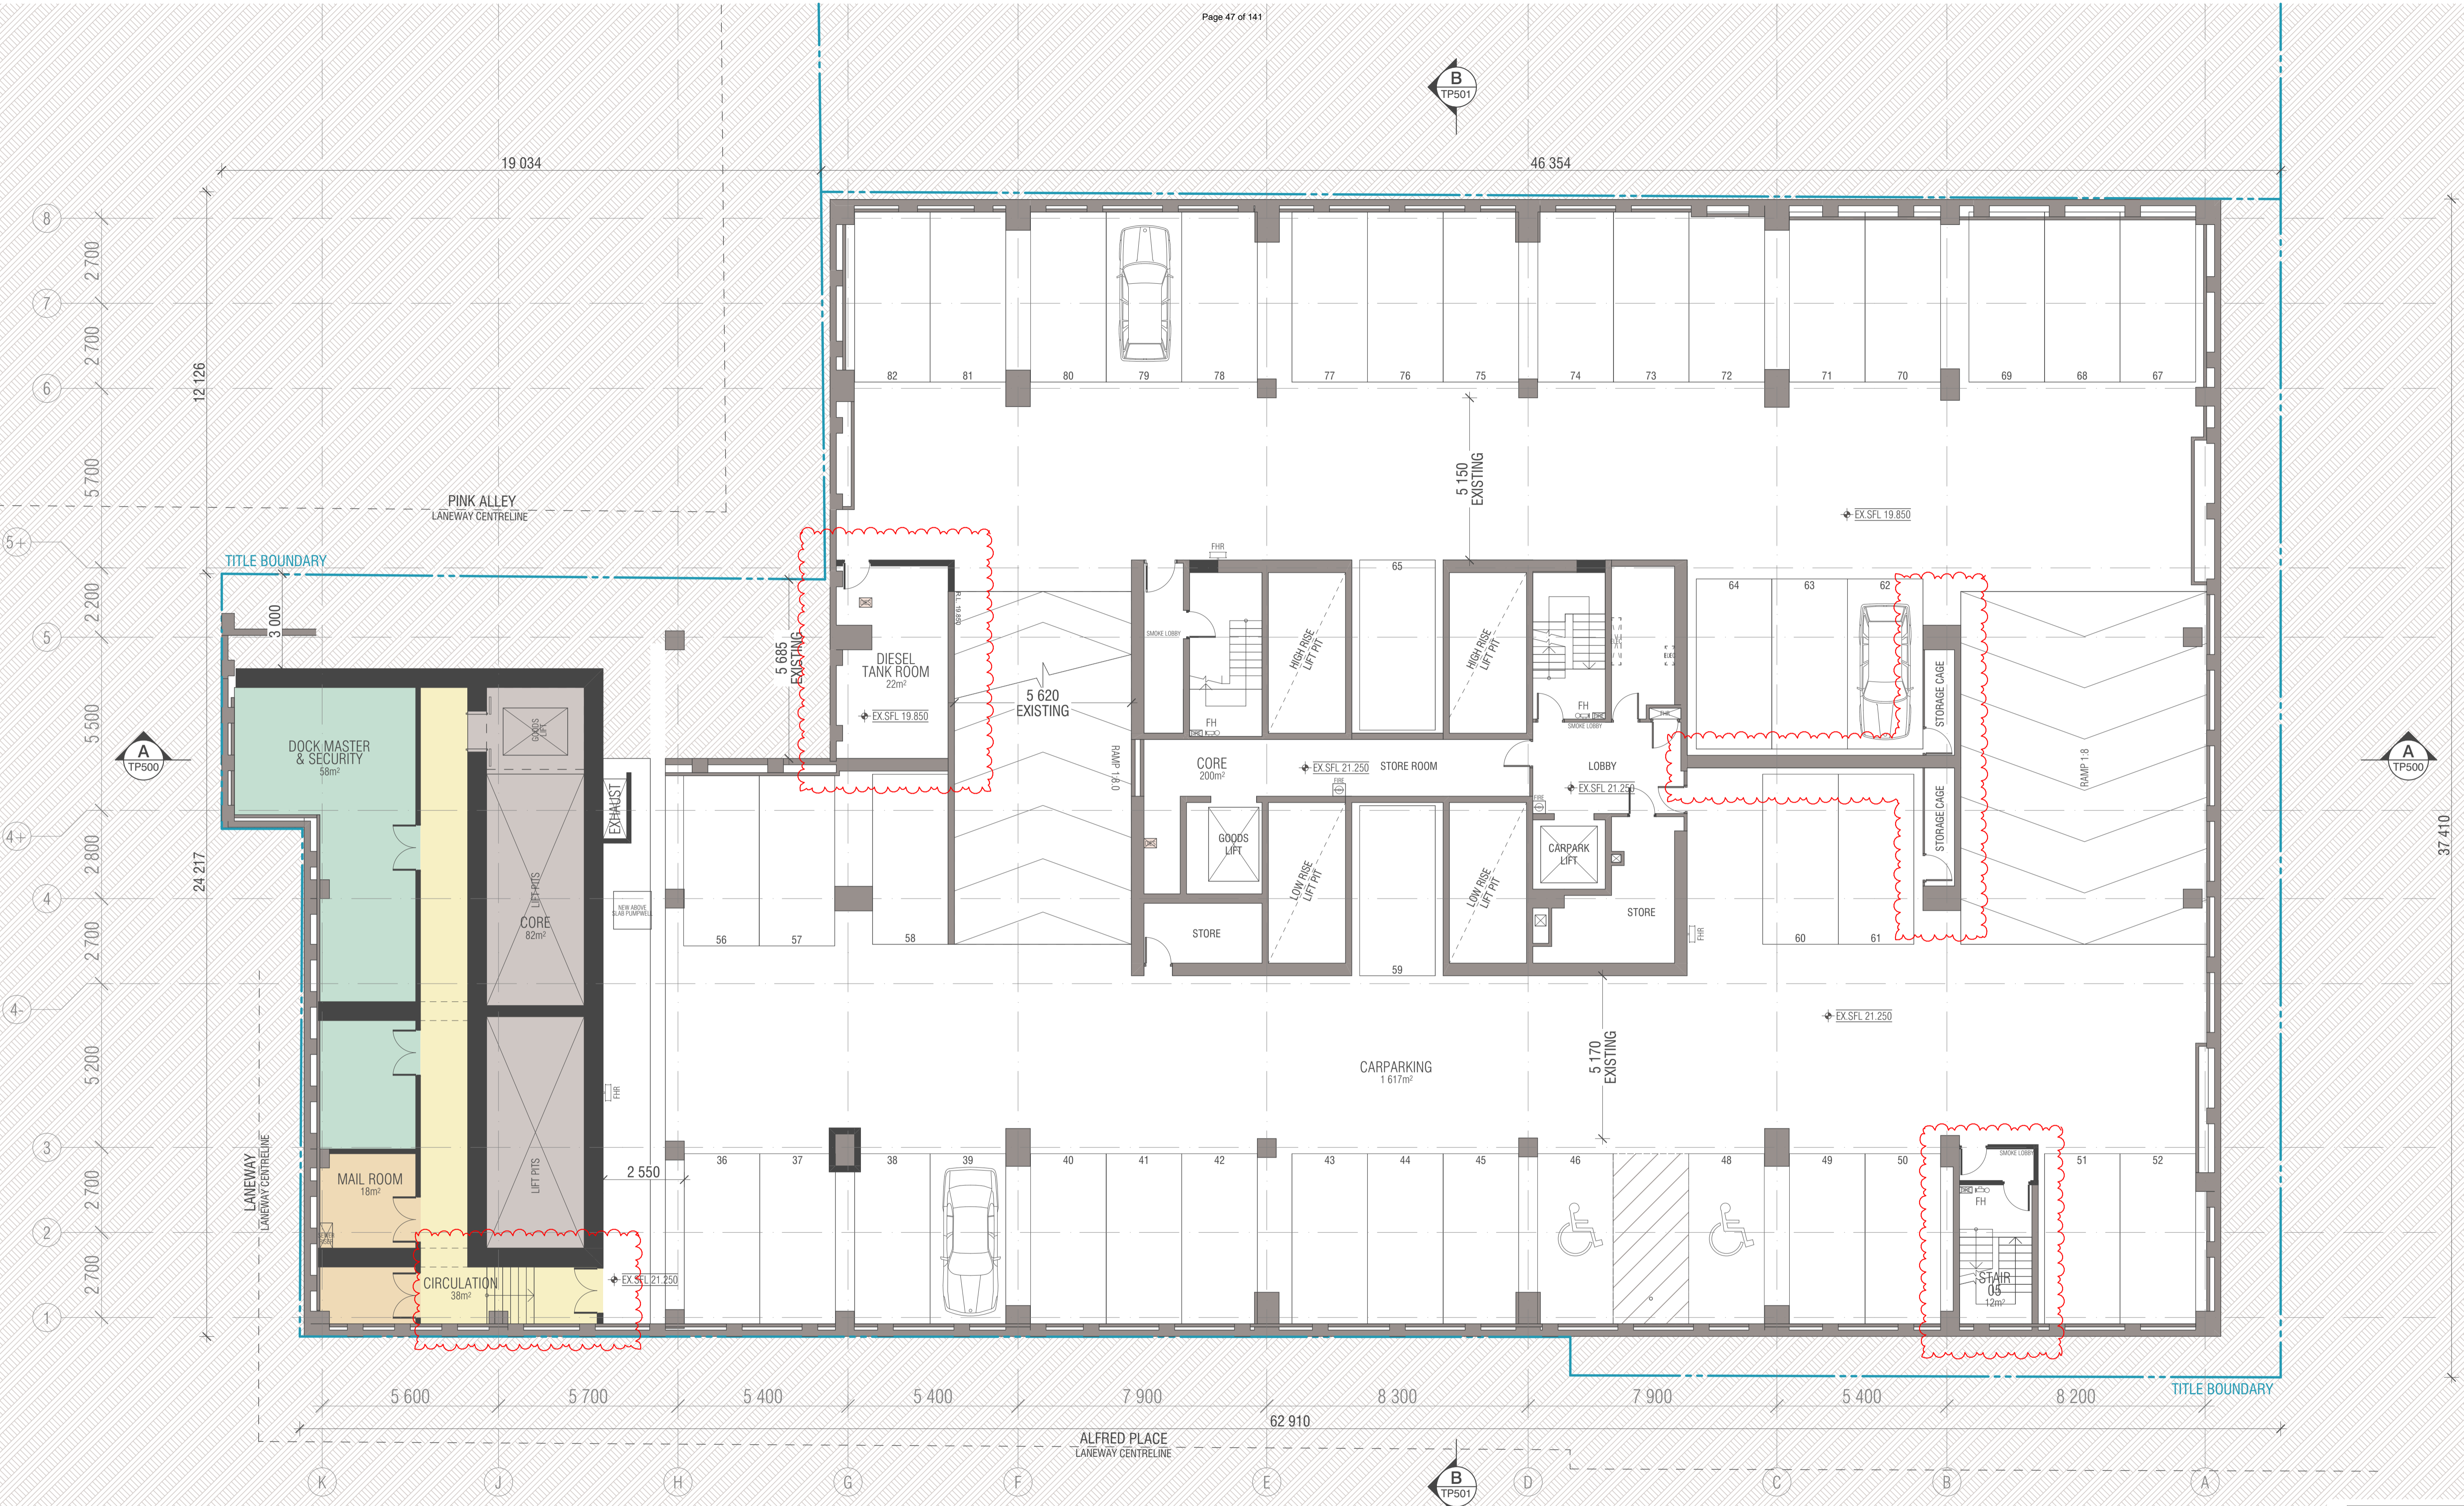

**WALL LEGEND**

- EXISTING
- DEMOLISHED
- PROPOSED

BIMcloud: FK BIMCLOUD - BIMcloud\18155 90 Collins Street Melbourne\00 MODEL\00 - CD\BIM MODEL\18155 General

REVISION	DATE	BY
01	16.12.2021	WTK
02	10.06.2022	WTK
03	15.07.2022	WTK

REVISION	DATE	BY
01	16.12.2021	WTK
02	10.06.2022	WTK
03	15.07.2022	WTK

**QUALITY ASSURANCE** (FK IS A CERTIFIED COMPANY TO ISO 9001:2015)

THIS PROJECT IS SUBJECT TO THE FK QUALITY ASSURANCE SYSTEM

- SCHEMATIC DESIGN REVIEW FOR THIS PROJECT IS YET TO BE COMPLETED.
- DESIGN DEVELOPMENT REVIEW FOR THIS PROJECT IS YET TO BE COMPLETED.
- TENDER DOCUMENTATION REVIEW FOR THIS PROJECT IS YET TO BE COMPLETED.
- CONSTRUCTION DOCUMENTATION REVIEW FOR THIS DRAWING IS YET TO BE COMPLETED.

IF THIS DRAWING IS STAMPED UNCONTROLLED COPY THEN IT IS TO BE CONSIDERED A DRAFT. SUBJECT TO REVISION WITHOUT NOTICE

**NOTES**

THIS DRAWING IS COPYRIGHT AND SHALL REMAIN THE PROPERTY OF FENDER KATSALIDIS (AUST) PTY LTD. CHECK AND VERIFY ALL DIMENSIONS ON SITE PRIOR TO COMMENCING WORK. DRAWING TO BE READ IN CONJUNCTION WITH ALL OTHER CONTRACT DOCUMENTS. DO NOT SCALE DRAWINGS. USE FIGURED DIMENSIONS ONLY. SEEK CLARIFICATION OF INCONSISTENCIES / CONFLICTS.

DRAWN	DATE	CHECKED	PLOT DATE	JOB NO.	SCALE
WTK	15.07.2022	JV	21.07.2022	18155	1:100@A1

**PROJECT**

90 COLLINS REDEVELOPMENT  
90 COLLINS STREET  
MELBOURNE VIC 3000




**FENDER KATSALIDIS**  
WWW.FKAUSTRALIA.COM  
2 RIVERSIDE QUAY, SOUTH BANK  
VICTORIA 3006 AUSTRALIA  
TELEPHONE: +61 3 8696 3888  
FENDER KATSALIDIS (AUST) PTY LTD ACN 092 943 032



ISSUE PURPOSE	REVISION	DRAWING NO.
TOWN PLANNING	02	TP298



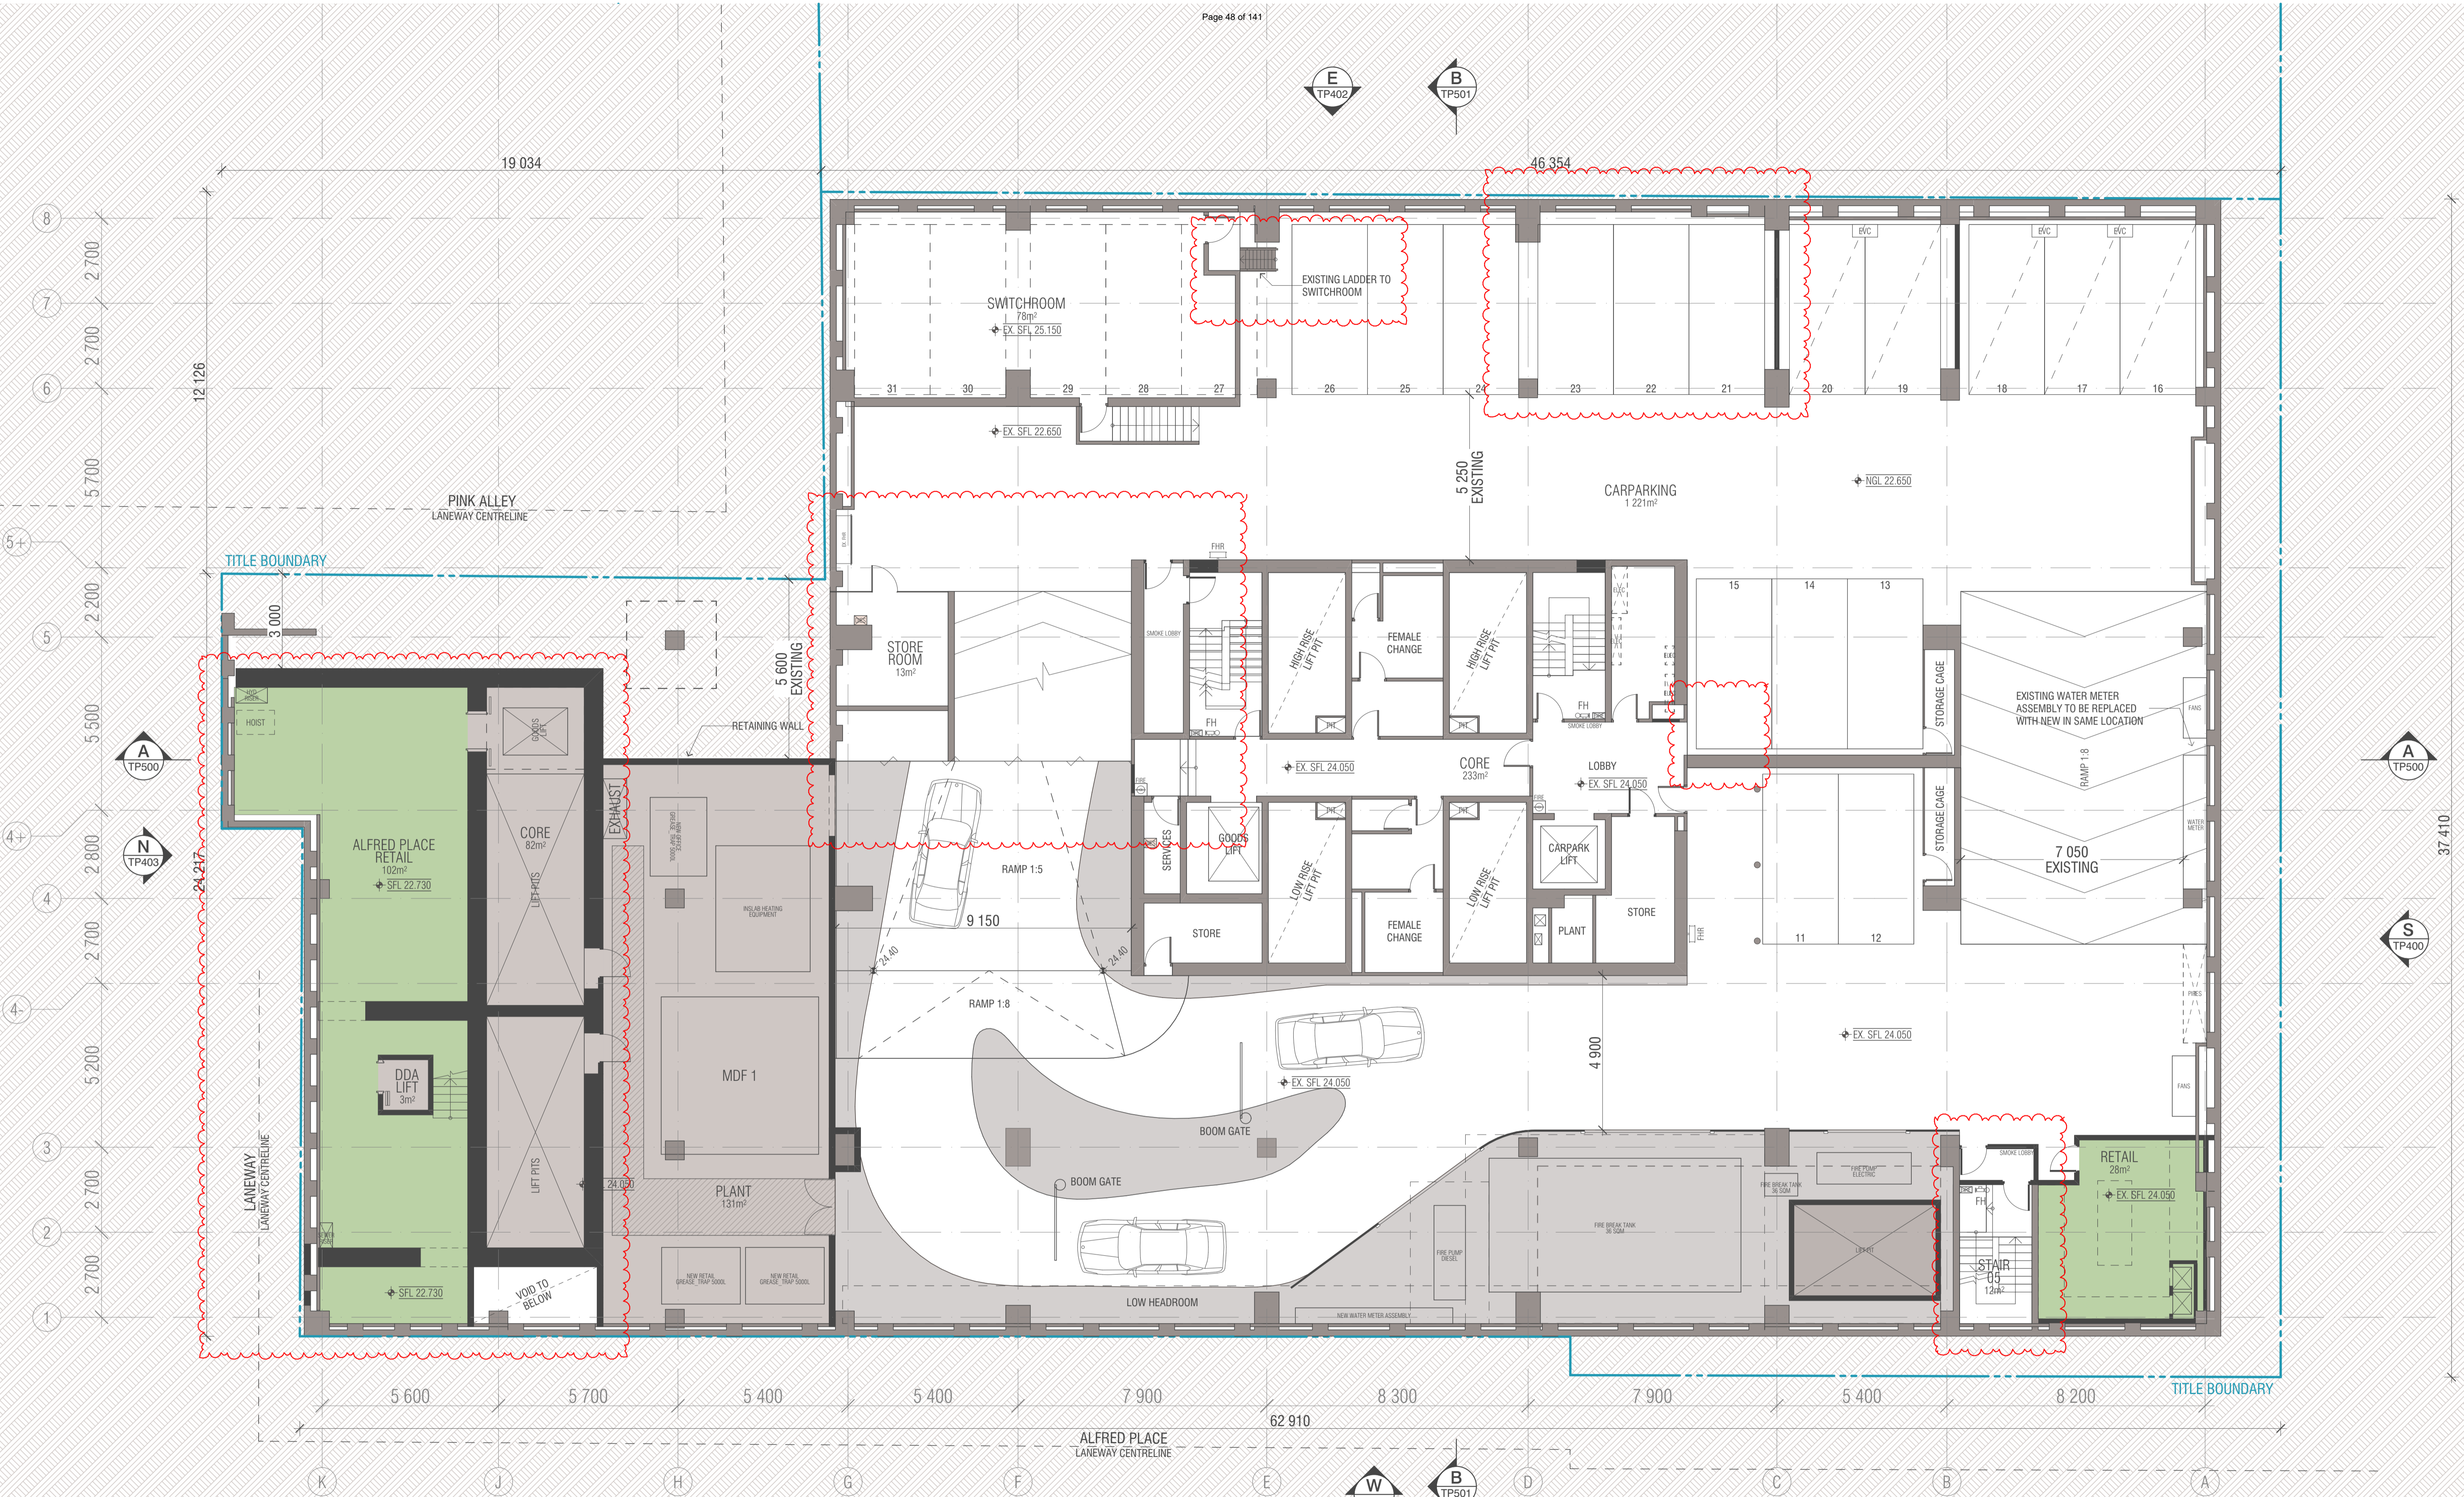

**WALL LEGEND**

- EXISTING
- DEMOLISHED
- PROPOSED

BIMcloud: FK BIMCLOUD - BIMcloud\18155 90 Collins Street Melbourne\00 MODEL\00-CD\BIM MODEL\18155 General

REVISION	DESCRIPTION	DATE
01	TOWN PLANNING ISSUE 01	16.12.2021
02	TOWN PLANNING SUBMISSION 02	10.06.2022
03	TOWN PLANNING SUBMISSION 03	15.07.2022

REVISION	DESCRIPTION	DATE
01	TOWN PLANNING ISSUE 01	16.12.2021
02	TOWN PLANNING SUBMISSION 02	10.06.2022
03	TOWN PLANNING SUBMISSION 03	15.07.2022

**QUALITY ASSURANCE** (FK IS A CERTIFIED COMPANY TO ISO 9001:2015)

THIS PROJECT IS SUBJECT TO THE FK QUALITY ASSURANCE SYSTEM

- SCHEMATIC DESIGN REVIEW FOR THIS PROJECT IS YET TO BE COMPLETED.
- DESIGN DEVELOPMENT REVIEW FOR THIS PROJECT IS YET TO BE COMPLETED.
- TENDER DOCUMENTATION REVIEW FOR THIS PROJECT IS YET TO BE COMPLETED.
- CONSTRUCTION DOCUMENTATION REVIEW FOR THIS DRAWING IS YET TO BE COMPLETED.

IF THIS DRAWING IS STAMPED UNCONTROLLED COPY THEN IT IS TO BE CONSIDERED A DRAFT. SUBJECT TO REVISION WITHOUT NOTICE

**NOTES**

THIS DRAWING IS COPYRIGHT AND SHALL REMAIN THE PROPERTY OF FENDER KATSALIDIS (AUST) PTY LTD. CHECK AND VERIFY ALL DIMENSIONS ON SITE PRIOR TO COMMENCING WORK. DRAWING TO BE READ IN CONJUNCTION WITH ALL OTHER CONTRACT DOCUMENTS. DO NOT SCALE DRAWINGS. USE FIGURED DIMENSIONS ONLY. SEEK CLARIFICATION OF INCONSISTENCIES / CONFLICTS.

DRAWN	DATE	CHECKED	PLOT DATE	JOB NO.	SCALE
WTK	15.07.2022	JV	21.07.2022	18155	1:100@A1

**PROJECT**

90 COLLINS REDEVELOPMENT  
90 COLLINS STREET  
MELBOURNE VIC 3000




**FENDER KATSALIDIS**  
WWW.FKAUSTRALIA.COM  
2 RIVERSIDE QUAY, SOUTH BANK  
VICTORIA 3006 AUSTRALIA  
TELEPHONE: +61 3 8696 3888  
FENDER KATSALIDIS (AUST) PTY LTD ACN 092 943 032



DRAWING TITLE	ISSUE PURPOSE	REV.	DRAWING NO.
PROPOSED BASEMENT 1 FLOOR PLAN	TOWN PLANNING	02	TP299



REFER TP350-TP353 FOR EXTENT OF WORKS TO 86-88 COLLINS STREET  
86-88 COLLINS STREET

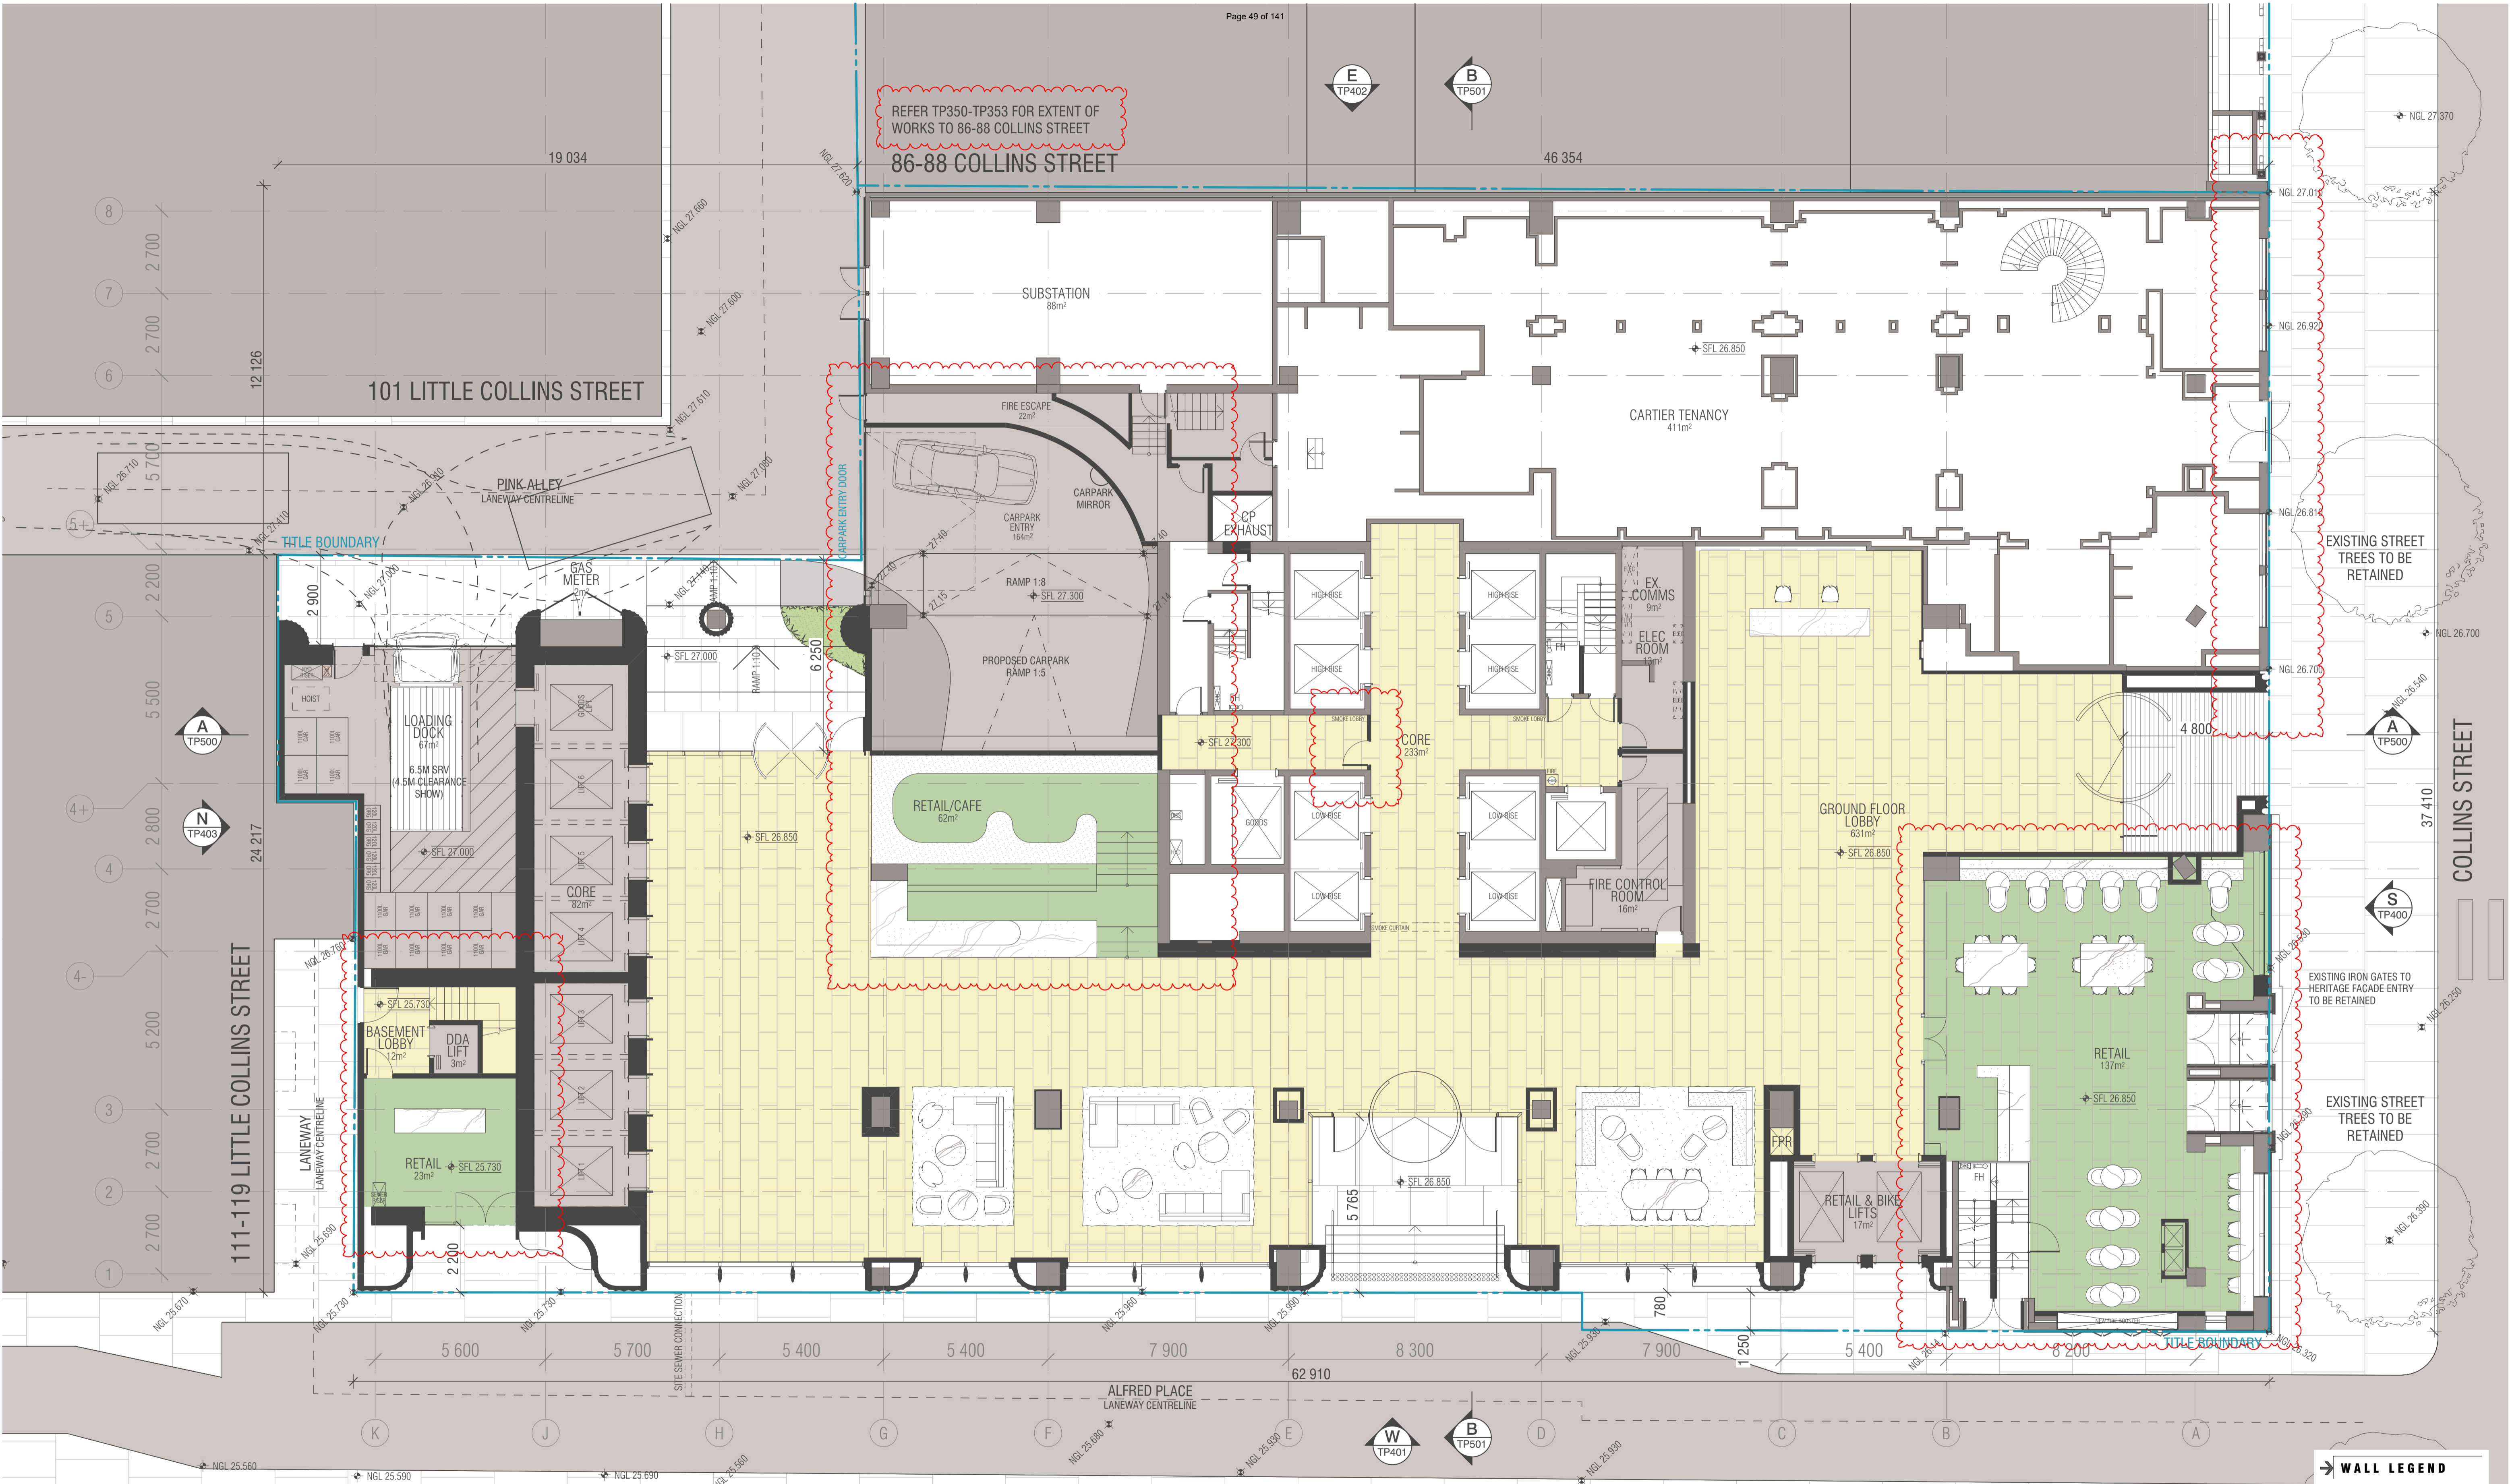

121-127 LITTLE COLLINS STREET

7 ALFRED PLACE

100-108 COLLINS STREET

BIMcloud: FK BIMCLOUD - BIMcloud\18155 90 Collins Street Melbourne\00 MODEL\00-CD\BIM MODEL\18155 General

REVISION	REVISION
01 TOWN PLANNING ISSUE 01	WTK 16.12.2021
02 TOWN PLANNING SUBMISSION 02	WTK 10.06.2022
03 TOWN PLANNING SUBMISSION 03	WTK 15.07.2022

**QUALITY ASSURANCE** (FK IS A CERTIFIED COMPANY TO ISO 9001:2015)

THIS PROJECT IS SUBJECT TO THE FK QUALITY ASSURANCE SYSTEM

- SCHEMATIC DESIGN REVIEW FOR THIS PROJECT IS YET TO BE COMPLETED.
- DESIGN DEVELOPMENT REVIEW FOR THIS PROJECT IS YET TO BE COMPLETED.
- TENDER DOCUMENTATION REVIEW FOR THIS PROJECT IS YET TO BE COMPLETED.
- CONSTRUCTION DOCUMENTATION REVIEW FOR THIS DRAWING IS YET TO BE COMPLETED.

IF THIS DRAWING IS STAMPED UNCONTROLLED COPY THEN IT IS TO BE CONSIDERED A DRAFT. SUBJECT TO REVISION WITHOUT NOTICE

**NOTES**

THIS DRAWING IS COPYRIGHT AND SHALL REMAIN THE PROPERTY OF FENDER KATSALIDIS (AUST) PTY LTD. CHECK AND VERIFY ALL DIMENSIONS ON SITE PRIOR TO COMMENCING WORK. DRAWING TO BE READ IN CONJUNCTION WITH ALL OTHER CONTRACT DOCUMENTS. DO NOT SCALE DRAWINGS. USE FIGURED DIMENSIONS ONLY. SEEK CLARIFICATION OF INCONSISTENCIES / CONFLICTS.


DRAWN	DATE	CHECKED	PLOT DATE	JOB NO.	SCALE
WTK	15.07.2022	JV	21.07.2022	18155	1:100@A1

**PROJECT**

90 COLLINS REDEVELOPMENT  
90 COLLINS STREET  
MELBOURNE VIC 3000



**FENDER KATSALIDIS**  
WWW.FKAUSTRALIA.COM  
2 RIVERSIDE QUAY, SOUTHBANK  
VICTORIA 3006 AUSTRALIA  
TELEPHONE: +61 3 8696 3888  
FENDER KATSALIDIS (AUST) PTY LTD ACN 092 943 032

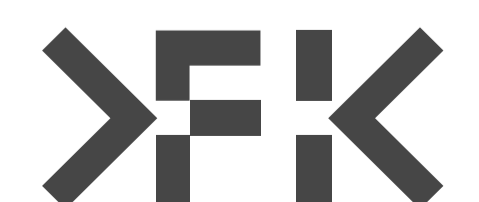

DRAWING TITLE	ISSUE PURPOSE	REV.	DRAWING NO.
PROPOSED GROUND FLOOR PLAN	TOWN PLANNING	02	TP300



REFER TP350-TP353 FOR EXTENT OF WORKS TO 86-88 COLLINS STREET



121-127 LITTLE COLLINS STREET | 7 ALFRED PLACE | 100-108 COLLINS STREET

**WALL LEGEND**

- EXISTING
- DEMOLISHED
- PROPOSED

BIMcloud: FK BIMCLOUD - BIMcloud\18155 90 Collins Street Melbourne\00 MODEL\00-CD\BIM MODEL\18155 General

REVISION	REVISION
01 TOWN PLANNING ISSUE 01	WTK 16.12.2021
02 TOWN PLANNING SUBMISSION 02	WTK 10.06.2022
03 TOWN PLANNING SUBMISSION 03	WTK 15.07.2022

**QUALITY ASSURANCE** (FK IS A CERTIFIED COMPANY TO ISO 9001:2015)

THIS PROJECT IS SUBJECT TO THE FK QUALITY ASSURANCE SYSTEM

- SCHEMATIC DESIGN REVIEW FOR THIS PROJECT IS YET TO BE COMPLETED.
- DESIGN DEVELOPMENT REVIEW FOR THIS PROJECT IS YET TO BE COMPLETED.
- TENDER DOCUMENTATION REVIEW FOR THIS PROJECT IS YET TO BE COMPLETED.
- CONSTRUCTION DOCUMENTATION REVIEW FOR THIS DRAWING IS YET TO BE COMPLETED.

IF THIS DRAWING IS STAMPED UNCONTROLLED COPY THEN IT IS TO BE CONSIDERED A DRAFT. SUBJECT TO REVISION WITHOUT NOTICE

**NOTES**

THIS DRAWING IS COPYRIGHT AND SHALL REMAIN THE PROPERTY OF FENDER KATSALIDIS (AUST) PTY LTD. CHECK AND VERIFY ALL DIMENSIONS ON SITE PRIOR TO COMMENCING WORK. DRAWING TO BE READ IN CONJUNCTION WITH ALL OTHER CONTRACT DOCUMENTS. DO NOT SCALE DRAWINGS. USE FIGURED DIMENSIONS ONLY. SEEK CLARIFICATION OF INCONSISTENCIES / CONFLICTS.


DRAWN	DATE	CHECKED	PLOT DATE	JOB NO.	SCALE
WTK	15.07.2022	JV	21.07.2022	18155	1:100@A1

**PROJECT**

90 COLLINS REDEVELOPMENT  
90 COLLINS STREET  
MELBOURNE VIC 3000



**FENDER KATSALIDIS**  
WWW.FKAUSTRALIA.COM  
2 RIVERSIDE QUAY, SOUTHBANK  
VICTORIA 3006 AUSTRALIA  
TELEPHONE: +61 3 8696 3888  
FENDER KATSALIDIS (AUST) PTY LTD ACN 092 943 032

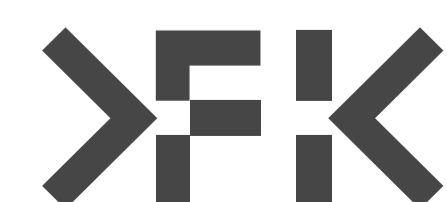


ISSUE PURPOSE	REV.	DRAWING NO.
TOWN PLANNING	02	TP301



REFER TP350-TP353 FOR EXTENT OF WORKS TO 86-88 COLLINS STREET

86-88 COLLINS STREET

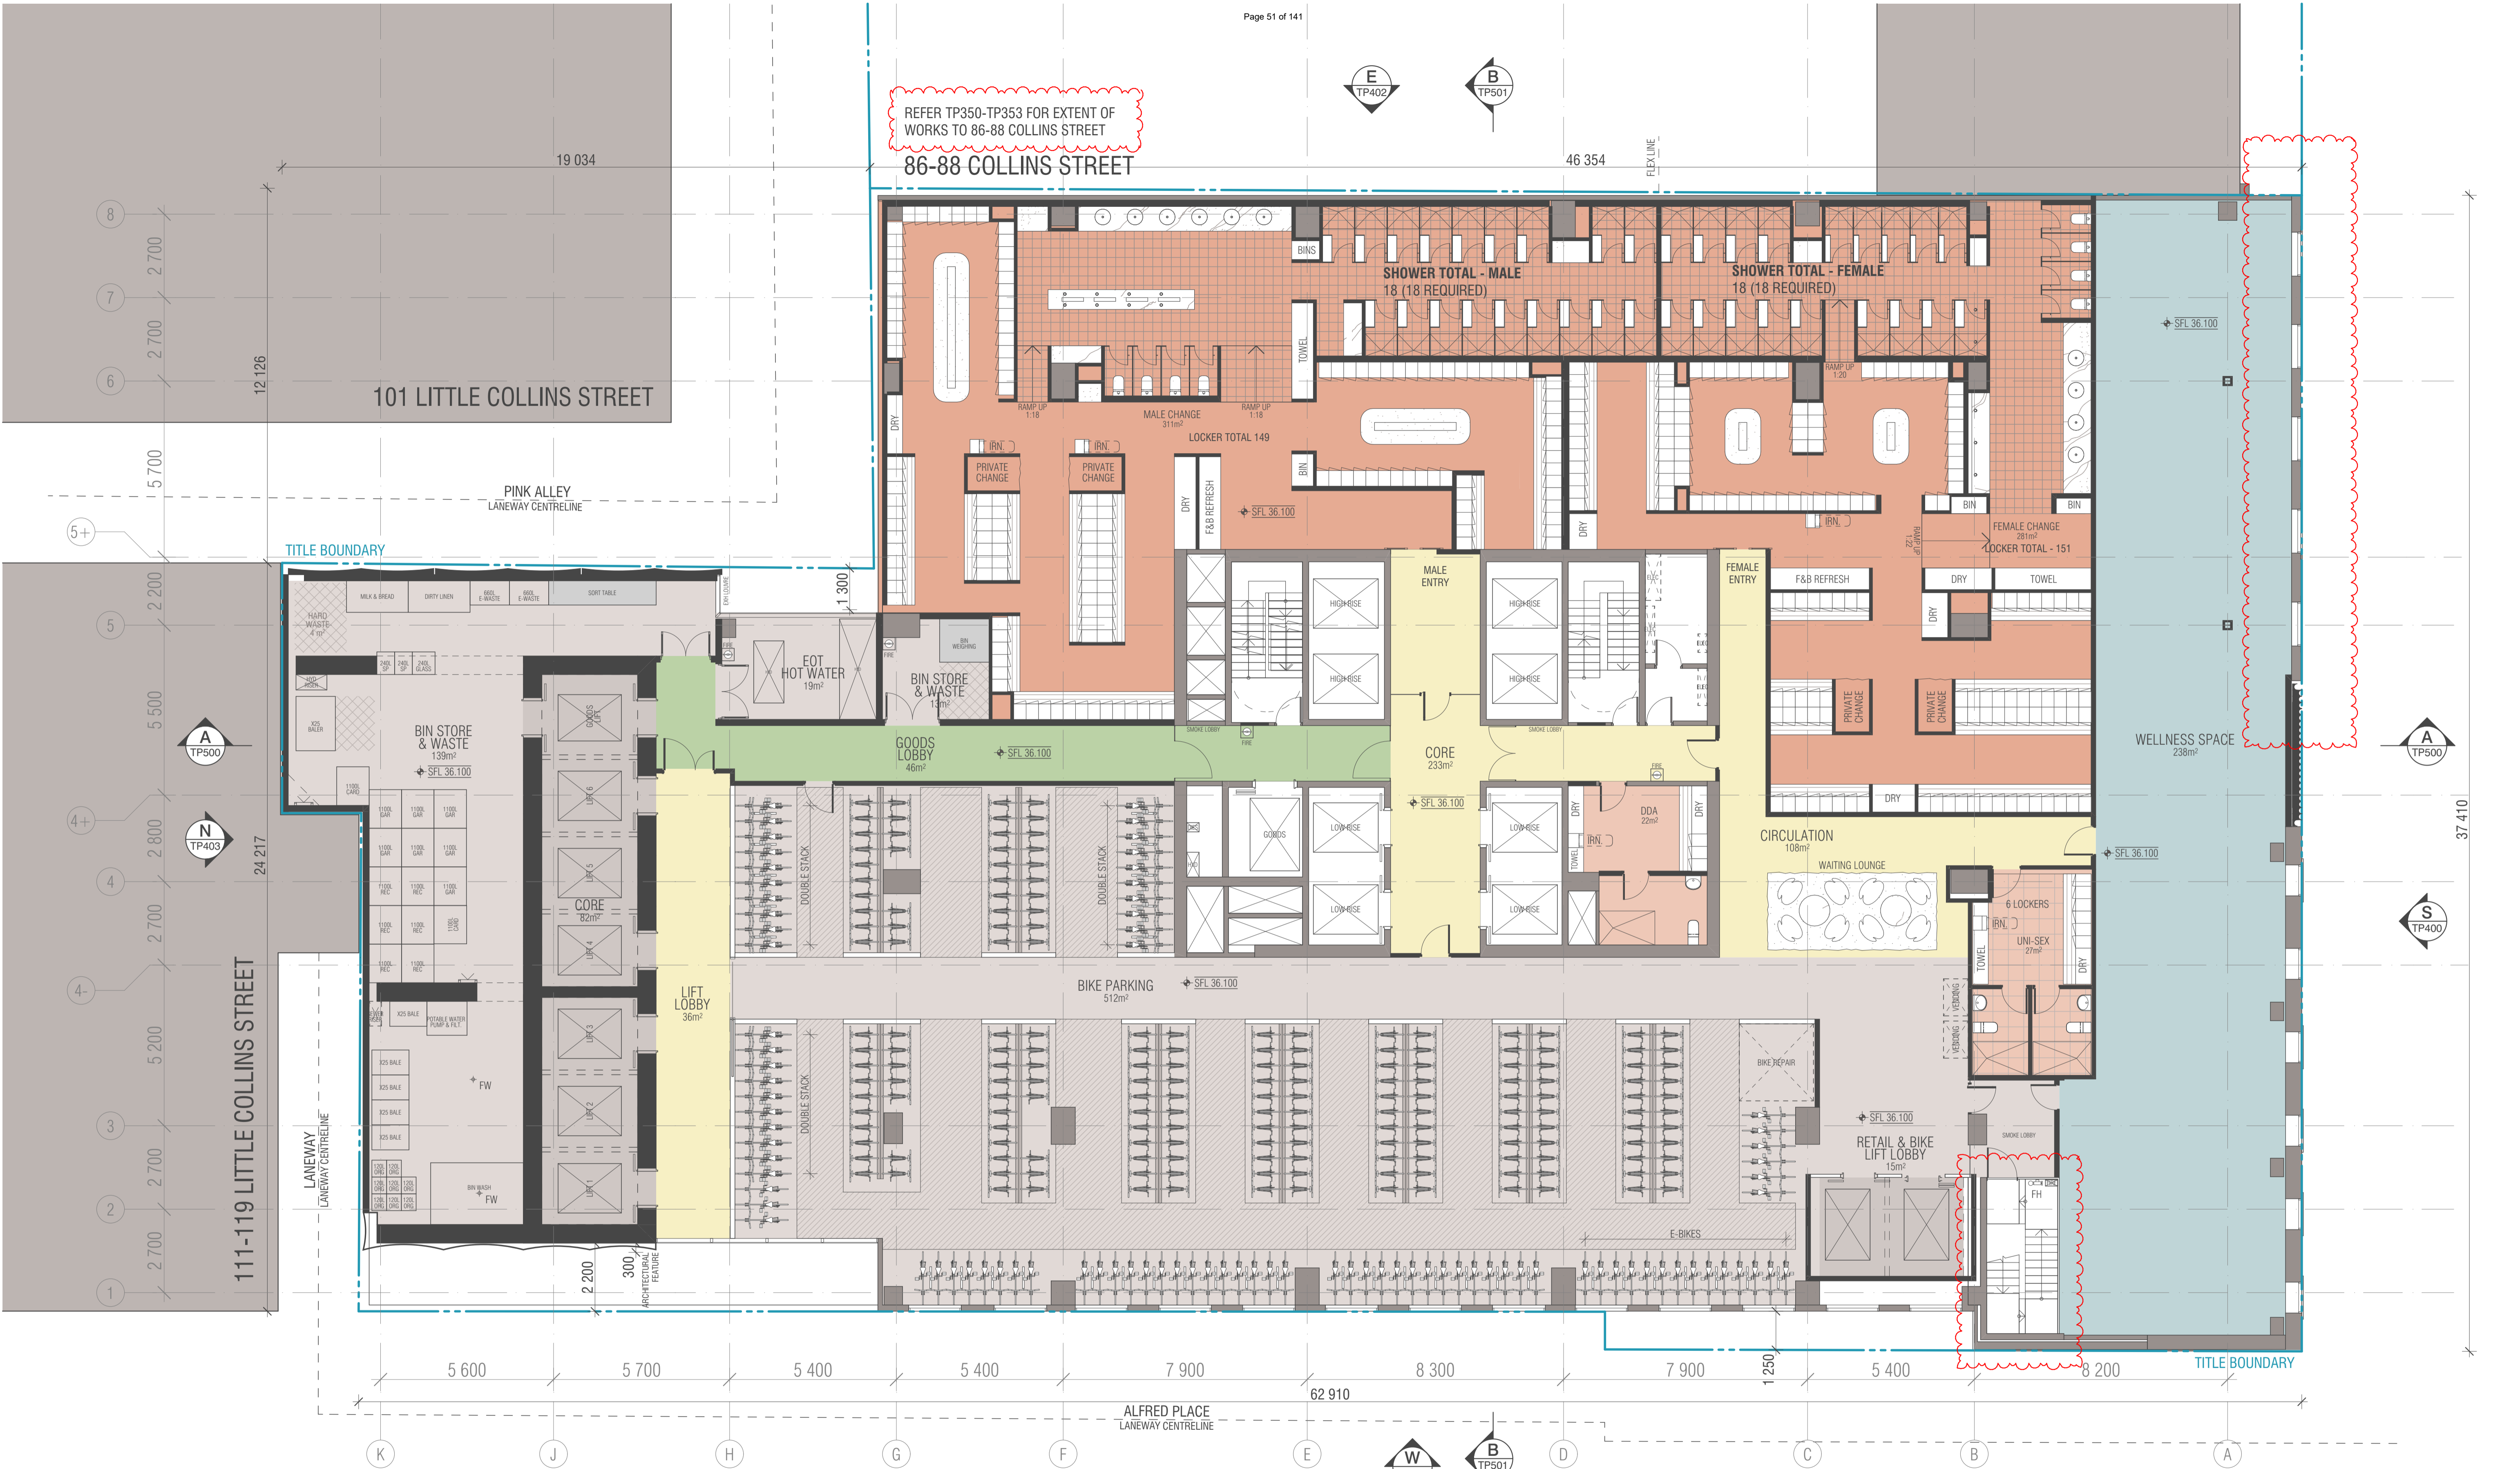

121-127 LITTLE COLLINS STREET

7 ALFRED PLACE

100-108 COLLINS STREET

WALL LEGEND

- EXISTING
- DEMOLISHED
- PROPOSED

BIMcloud: FK8IMCLOUD - BIMcloud\18155 90 Collins Street Melbourne\00 MODEL\00-CD\BIM MODEL\18155 General

REVISION	REVISION
01 TOWN PLANNING ISSUE 01	WTK 16.12.2021
02 TOWN PLANNING SUBMISSION 02	WTK 10.06.2022
03 TOWN PLANNING SUBMISSION 03	WTK 15.07.2022

**QUALITY ASSURANCE** (FK IS A CERTIFIED COMPANY TO ISO 9001:2015)

THIS PROJECT IS SUBJECT TO THE FK QUALITY ASSURANCE SYSTEM


- SCHEMATIC DESIGN REVIEW FOR THIS PROJECT IS YET TO BE COMPLETED.
- DESIGN DEVELOPMENT REVIEW FOR THIS PROJECT IS YET TO BE COMPLETED.
- TENDER DOCUMENTATION REVIEW FOR THIS PROJECT IS YET TO BE COMPLETED.
- CONSTRUCTION DOCUMENTATION REVIEW FOR THIS DRAWING IS YET TO BE COMPLETED.

IF THIS DRAWING IS STAMPED UNCONTROLLED COPY THEN IT IS TO BE CONSIDERED A DRAFT. SUBJECT TO REVISION WITHOUT NOTICE

**NOTES**

THIS DRAWING IS COPYRIGHT AND SHALL REMAIN THE PROPERTY OF FENDER KATSALEDIS (AUST) PTY LTD. CHECK AND VERIFY ALL DIMENSIONS ON SITE PRIOR TO COMMENCING WORK. DRAWING TO BE READ IN CONJUNCTION WITH ALL OTHER CONTRACT DOCUMENTS. DO NOT SCALE DRAWINGS. USE FIGURED DIMENSIONS ONLY. SEEK CLARIFICATION OF INCONSISTENCIES / CONFLICTS.

DRAWN	DATE	CHECKED	PLOT DATE	JOB NO.	SCALE
WTK	15.07.2022	JV	21.07.2022	18155	1:100@A1

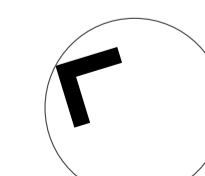

**PROJECT**

90 COLLINS REDEVELOPMENT  
90 COLLINS STREET  
MELBOURNE VIC 3000



**FENDER KATSALEDIS**  
WWW.FKAUSTRALIA.COM  
2 RIVERSIDE QUAY, SOUTH BANK  
VICTORIA 3006 AUSTRALIA  
TELEPHONE: +61 3 8696 3888  
FENDER KATSALEDIS (AUST) PTY LTD ACN 092 943 032



**ISSUE PURPOSE**

TOWN PLANNING

**REV.** 02  
**DRAWING NO.** TP302





**WALL LEGEND**

- EXISTING
- DEMOLISHED
- PROPOSED

121-127 LITTLE COLLINS STREET | 7 ALFRED PLACE | 100-108 COLLINS STREET

BIMcloud: FK3M/CLOUD - BIMcloud/18155 90 Collins Street Melbourne/00 MODEL/00 - CD/BIM MODEL/18155 General

REVISION	REVISION
01 TOWN PLANNING ISSUE 01	WTK 16.12.2021
02 TOWN PLANNING SUBMISSION 02	WTK 10.06.2022
03 TOWN PLANNING SUBMISSION 03	WTK 15.07.2022

**QUALITY ASSURANCE** (FK IS A CERTIFIED COMPANY TO ISO 9001:2015)  
 THIS PROJECT IS SUBJECT TO THE FK QUALITY ASSURANCE SYSTEM

- SCHEMATIC DESIGN REVIEW FOR THIS PROJECT IS YET TO BE COMPLETED.
- DESIGN DEVELOPMENT REVIEW FOR THIS PROJECT IS YET TO BE COMPLETED.
- TENDER DOCUMENTATION REVIEW FOR THIS PROJECT IS YET TO BE COMPLETED.
- CONSTRUCTION DOCUMENTATION REVIEW FOR THIS PROJECT IS YET TO BE COMPLETED.

IF THIS DRAWING IS STAMPED UNCONTROLLED COPY THEN IT IS TO BE CONSIDERED A DRAFT. SUBJECT TO REVISION WITHOUT NOTICE

**NOTES**

THIS DRAWING IS COPYRIGHT AND SHALL REMAIN THE PROPERTY OF FENDER KATSALEDIS (AUST) PTY LTD  
 CHECK AND VERIFY ALL DIMENSIONS ON SITE PRIOR TO COMMENCING WORK. DRAWING TO BE READ IN CONJUNCTION WITH ALL OTHER CONTRACT DOCUMENTS. DO NOT SCALE DRAWINGS. USE FIGURED DIMENSIONS ONLY. SEEK CLARIFICATION OF INCONSISTENCIES / CONFLICTS.

DRAWN	DATE	CHECKED	PLOT DATE	JOB NO.	SCALE
WTK	15.07.2022	JV	21.07.2022	18155	1:100@A1


**PROJECT**  
 90 COLLINS REDEVELOPMENT  
 90 COLLINS STREET  
 MELBOURNE VIC 3000

**FENDER KATSALEDIS**  
 WWW.FKAUSTRALIA.COM  
 2 RIVERSIDE QUAY, SOUTH BANK  
 VICTORIA 3006 AUSTRALIA  
 TELEPHONE: +61 3 8696 3888  
 FENDER KATSALEDIS (AUST) PTY LTD ACN 092 943 032

**ISSUE PURPOSE**  
 TOWN PLANNING

**REV. DRAWING NO.**  
 02 TP303



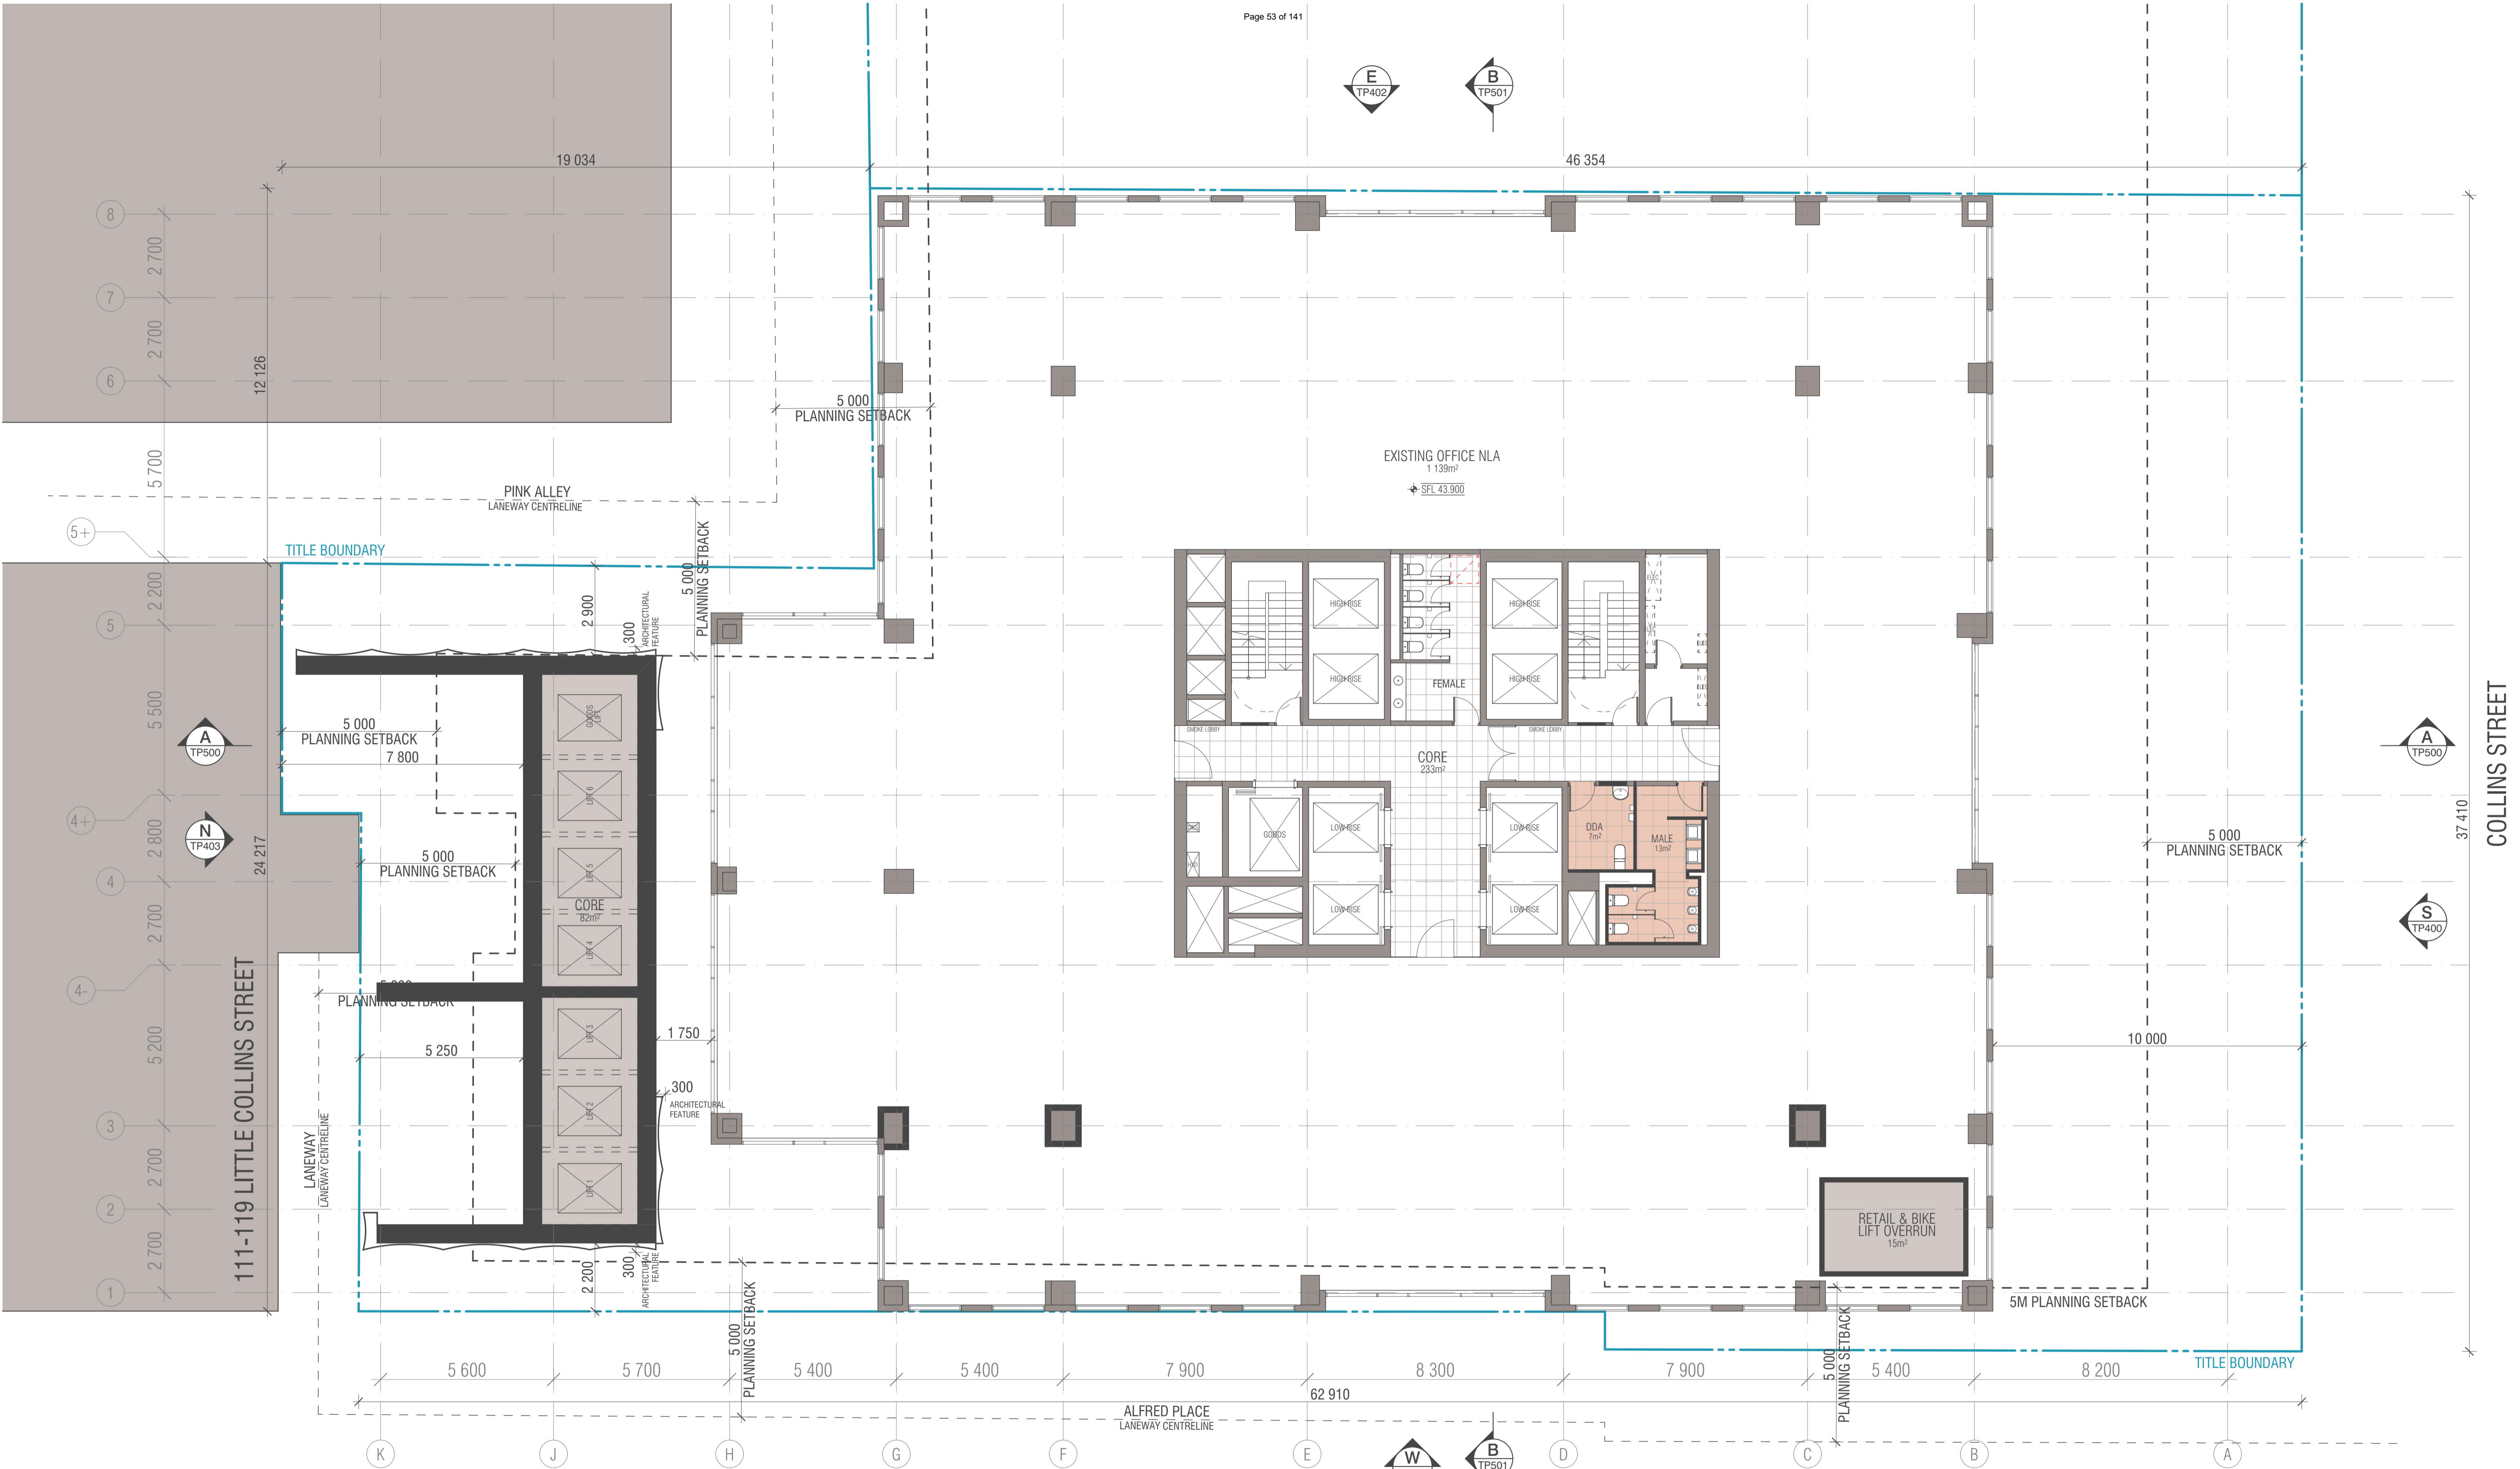

121-127 LITTLE COLLINS STREET | 7 ALFRED PLACE | 100-108 COLLINS STREET

**WALL LEGEND**  
 — EXISTING  
 — DEMOLISHED  
 — PROPOSED

BIMcloud: FK BIMCLOUD - BIMcloud\18155 90 Collins Street Melbourne\00 MODEL\00-CD\BIM MODEL\18155 General

REVISION	DATE	BY
> 01 TOWN PLANNING SUBMISSION 02	10.06.2022	WTK
01 TOWN PLANNING ISSUE 01	16.12.2021	WTK

REVISION	DATE	BY
> 01 TOWN PLANNING SUBMISSION 02	10.06.2022	WTK
01 TOWN PLANNING ISSUE 01	16.12.2021	WTK

**QUALITY ASSURANCE** (FK IS A CERTIFIED COMPANY TO ISO 9001:2015)  
 THIS PROJECT IS SUBJECT TO THE FK QUALITY ASSURANCE SYSTEM

- SCHEMATIC DESIGN REVIEW FOR THIS PROJECT IS YET TO BE COMPLETED.
- DESIGN DEVELOPMENT REVIEW FOR THIS PROJECT IS YET TO BE COMPLETED.
- TENDER DOCUMENTATION REVIEW FOR THIS PROJECT IS YET TO BE COMPLETED.
- CONSTRUCTION DOCUMENTATION REVIEW FOR THIS PROJECT IS YET TO BE COMPLETED.

IF THIS DRAWING IS STAMPED UNCONTROLLED COPY THEN IT IS TO BE CONSIDERED A DRAFT. SUBJECT TO REVISION WITHOUT NOTICE

**NOTES**  
 THIS DRAWING IS COPYRIGHT AND SHALL REMAIN THE PROPERTY OF FENDER KATSLIDIS (AUST) PTY LTD  
 CHECK AND VERIFY ALL DIMENSIONS ON SITE PRIOR TO COMMENCING WORK. DRAWING TO BE READ IN CONJUNCTION WITH ALL OTHER CONTRACT DOCUMENTS. DO NOT SCALE DRAWINGS. USE FIGURED DIMENSIONS ONLY. SEEK CLARIFICATION OF INCONSISTENCIES / CONFLICTS.

**PROJECT**  
 90 COLLINS REDEVELOPMENT  
 90 COLLINS STREET  
 MELBOURNE VIC 3000

**FENDER KATSLIDIS**  
 WWW.FKAUSTRALIA.COM  
 2 RIVERSIDE QUAY, SOUTH BANK  
 VICTORIA 3006 AUSTRALIA  
 TELEPHONE: +61 3 8696 3888  
 FENDER KATSLIDIS (AUST) PTY LTD ACN 092 943 032

REVISION	DATE	CHECKED	PLOT DATE	JOB NO.	SCALE	DRAWING TITLE	ISSUE PURPOSE	REV.	DRAWING NO.
> 01	10.06.2022	JV	21.07.2022	18155	1:100@A1	PROPOSED LEVEL 4 FLOOR PLAN	TOWN PLANNING	01	TP304





**WALL LEGEND**

- EXISTING
- DEMOLISHED
- PROPOSED

BIMcloud: FKBMICLOUD - BIMcloud\18155 90 Collins Street Melbourne\00 MODEL\00-CD\BIM MODEL\18155 General

REVISION	DESCRIPTION	DATE
> 01	TOWN PLANNING SUBMISSION 02	10.06.2022
-	TOWN PLANNING ISSUE 01	16.12.2021

REVISION	DESCRIPTION	DATE
-	TOWN PLANNING ISSUE 01	16.12.2021
> 01	TOWN PLANNING SUBMISSION 02	10.06.2022

**QUALITY ASSURANCE** (FK IS A CERTIFIED COMPANY TO ISO 9001:2015)

THIS PROJECT IS SUBJECT TO THE FK QUALITY ASSURANCE SYSTEM

- SCHEMATIC DESIGN REVIEW FOR THIS PROJECT IS YET TO BE COMPLETED.
- DESIGN DEVELOPMENT REVIEW FOR THIS PROJECT IS YET TO BE COMPLETED.
- TENDER DOCUMENTATION REVIEW FOR THIS PROJECT IS YET TO BE COMPLETED.
- CONSTRUCTION DOCUMENTATION REVIEW FOR THIS PROJECT IS YET TO BE COMPLETED.

IF THIS DRAWING IS STAMPED UNCONTROLLED COPY THEN IT IS TO BE CONSIDERED A DRAFT. SUBJECT TO REVISION WITHOUT NOTICE

**NOTES**

THIS DRAWING IS COPYRIGHT AND SHALL REMAIN THE PROPERTY OF FENDER KATSLIDIS (AUST) PTY LTD. CHECK AND VERIFY ALL DIMENSIONS ON SITE PRIOR TO COMMENCING WORK. DRAWING TO BE READ IN CONJUNCTION WITH ALL OTHER CONTRACT DOCUMENTS. DO NOT SCALE DRAWINGS. USE FIGURED DIMENSIONS ONLY. SEEK CLARIFICATION OF INCONSISTENCIES / CONFLICTS.


DRAWN	DATE	CHECKED	PLOT DATE	JOB NO.	SCALE
WTK	10.06.2022	JV	21.07.2022	18155	1:100@A1

**PROJECT**

90 COLLINS REDEVELOPMENT  
90 COLLINS STREET  
MELBOURNE VIC 3000




**FENDER KATSLIDIS**  
WWW.FKAUSTRALIA.COM  
2 RIVERSIDE QUAY, SOUTH BANK  
VICTORIA 3006 AUSTRALIA  
TELEPHONE: +61 3 8696 3888  
FENDER KATSLIDIS (AUST) PTY LTD ACN 092 943 032

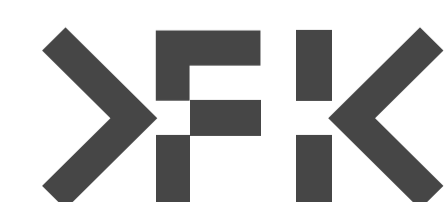

DRAWING TITLE	ISSUE PURPOSE	REV.	DRAWING NO.
PROPOSED LEVEL 5-13 FLOOR PLAN	TOWN PLANNING	01	TP305



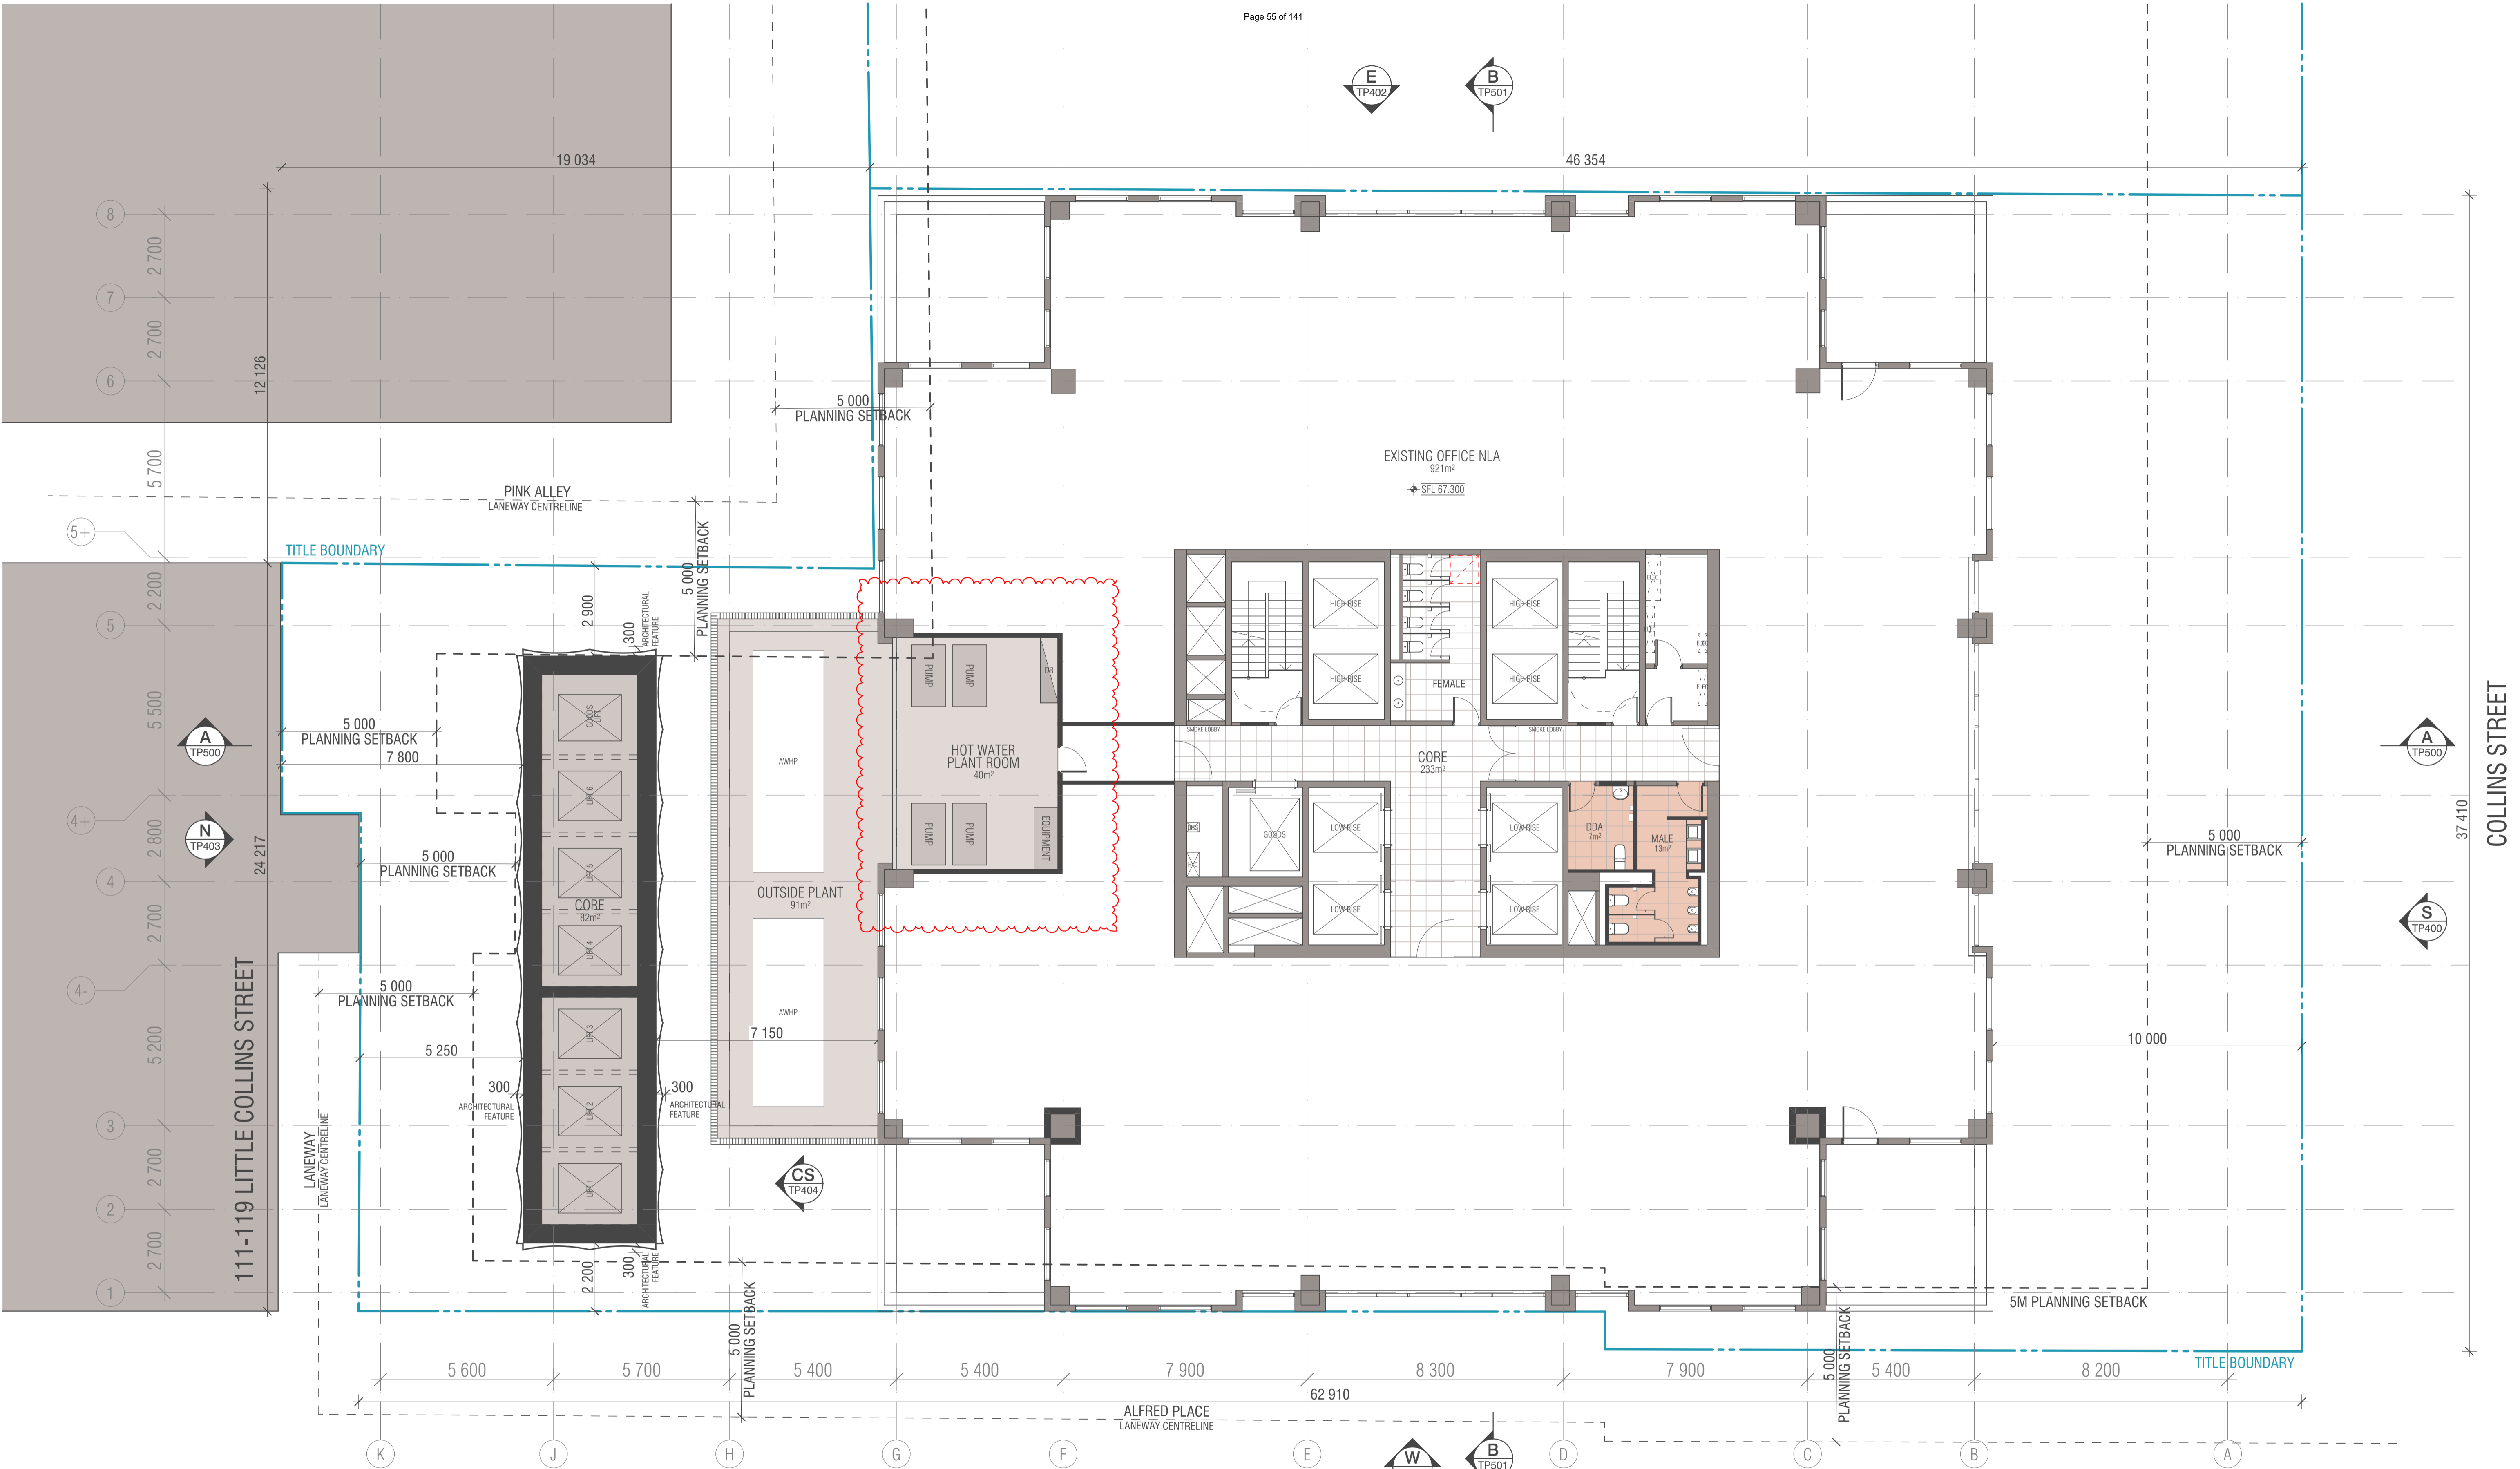

121-127 LITTLE COLLINS STREET

**WALL LEGEND**

- EXISTING
- DEMOLISHED
- PROPOSED

BIMcloud: FK BIMCLOUD - BIMcloud\18155 90 Collins Street Melbourne\00 MODEL\00-CD\BIM MODEL\18155 General

REVISION	DATE	BY
01	16.12.2021	WTK
02	10.06.2022	WTK
03	15.07.2022	WTK

REVISION	DATE	BY
01	16.12.2021	WTK
02	10.06.2022	WTK
03	15.07.2022	WTK

**QUALITY ASSURANCE** (FK IS A CERTIFIED COMPANY TO ISO 9001:2015)

THIS PROJECT IS SUBJECT TO THE FK QUALITY ASSURANCE SYSTEM

- SCHEMATIC DESIGN REVIEW FOR THIS PROJECT IS YET TO BE COMPLETED.
- DESIGN DEVELOPMENT REVIEW FOR THIS PROJECT IS YET TO BE COMPLETED.
- TENDER DOCUMENTATION REVIEW FOR THIS PROJECT IS YET TO BE COMPLETED.
- CONSTRUCTION DOCUMENTATION REVIEW FOR THIS DRAWING IS YET TO BE COMPLETED.

IF THIS DRAWING IS STAMPED UNCONTROLLED COPY THEN IT IS TO BE CONSIDERED A DRAFT. SUBJECT TO REVISION WITHOUT NOTICE

**NOTES**

THIS DRAWING IS COPYRIGHT AND SHALL REMAIN THE PROPERTY OF FENDER KATSALIDIS (AUST) PTY LTD. CHECK AND VERIFY ALL DIMENSIONS ON SITE PRIOR TO COMMENCING WORK. DRAWING TO BE READ IN CONJUNCTION WITH ALL OTHER CONTRACT DOCUMENTS. DO NOT SCALE DRAWINGS. USE FIGURED DIMENSIONS ONLY. SEEK CLARIFICATION OF INCONSISTENCIES / CONFLICTS.

DRAWN	DATE	CHECKED	PLOT DATE	JOB NO.	SCALE
WTK	15.07.2022	JV	21.07.2022	18155	1:100@A1

**PROJECT**

90 COLLINS REDEVELOPMENT  
90 COLLINS STREET  
MELBOURNE VIC 3000

**FENDER KATSALIDIS**

WWW.FKAUSTRALIA.COM  
2 RIVERSIDE QUAY, SOUTH BANK  
VICTORIA 3006 AUSTRALIA  
TELEPHONE: +61 3 8696 3888  
FENDER KATSALIDIS (AUST) PTY LTD ACN 092 943 032


**ISSUE PURPOSE**

TOWN PLANNING

**REV.** 02

**DRAWING NO.** TP310



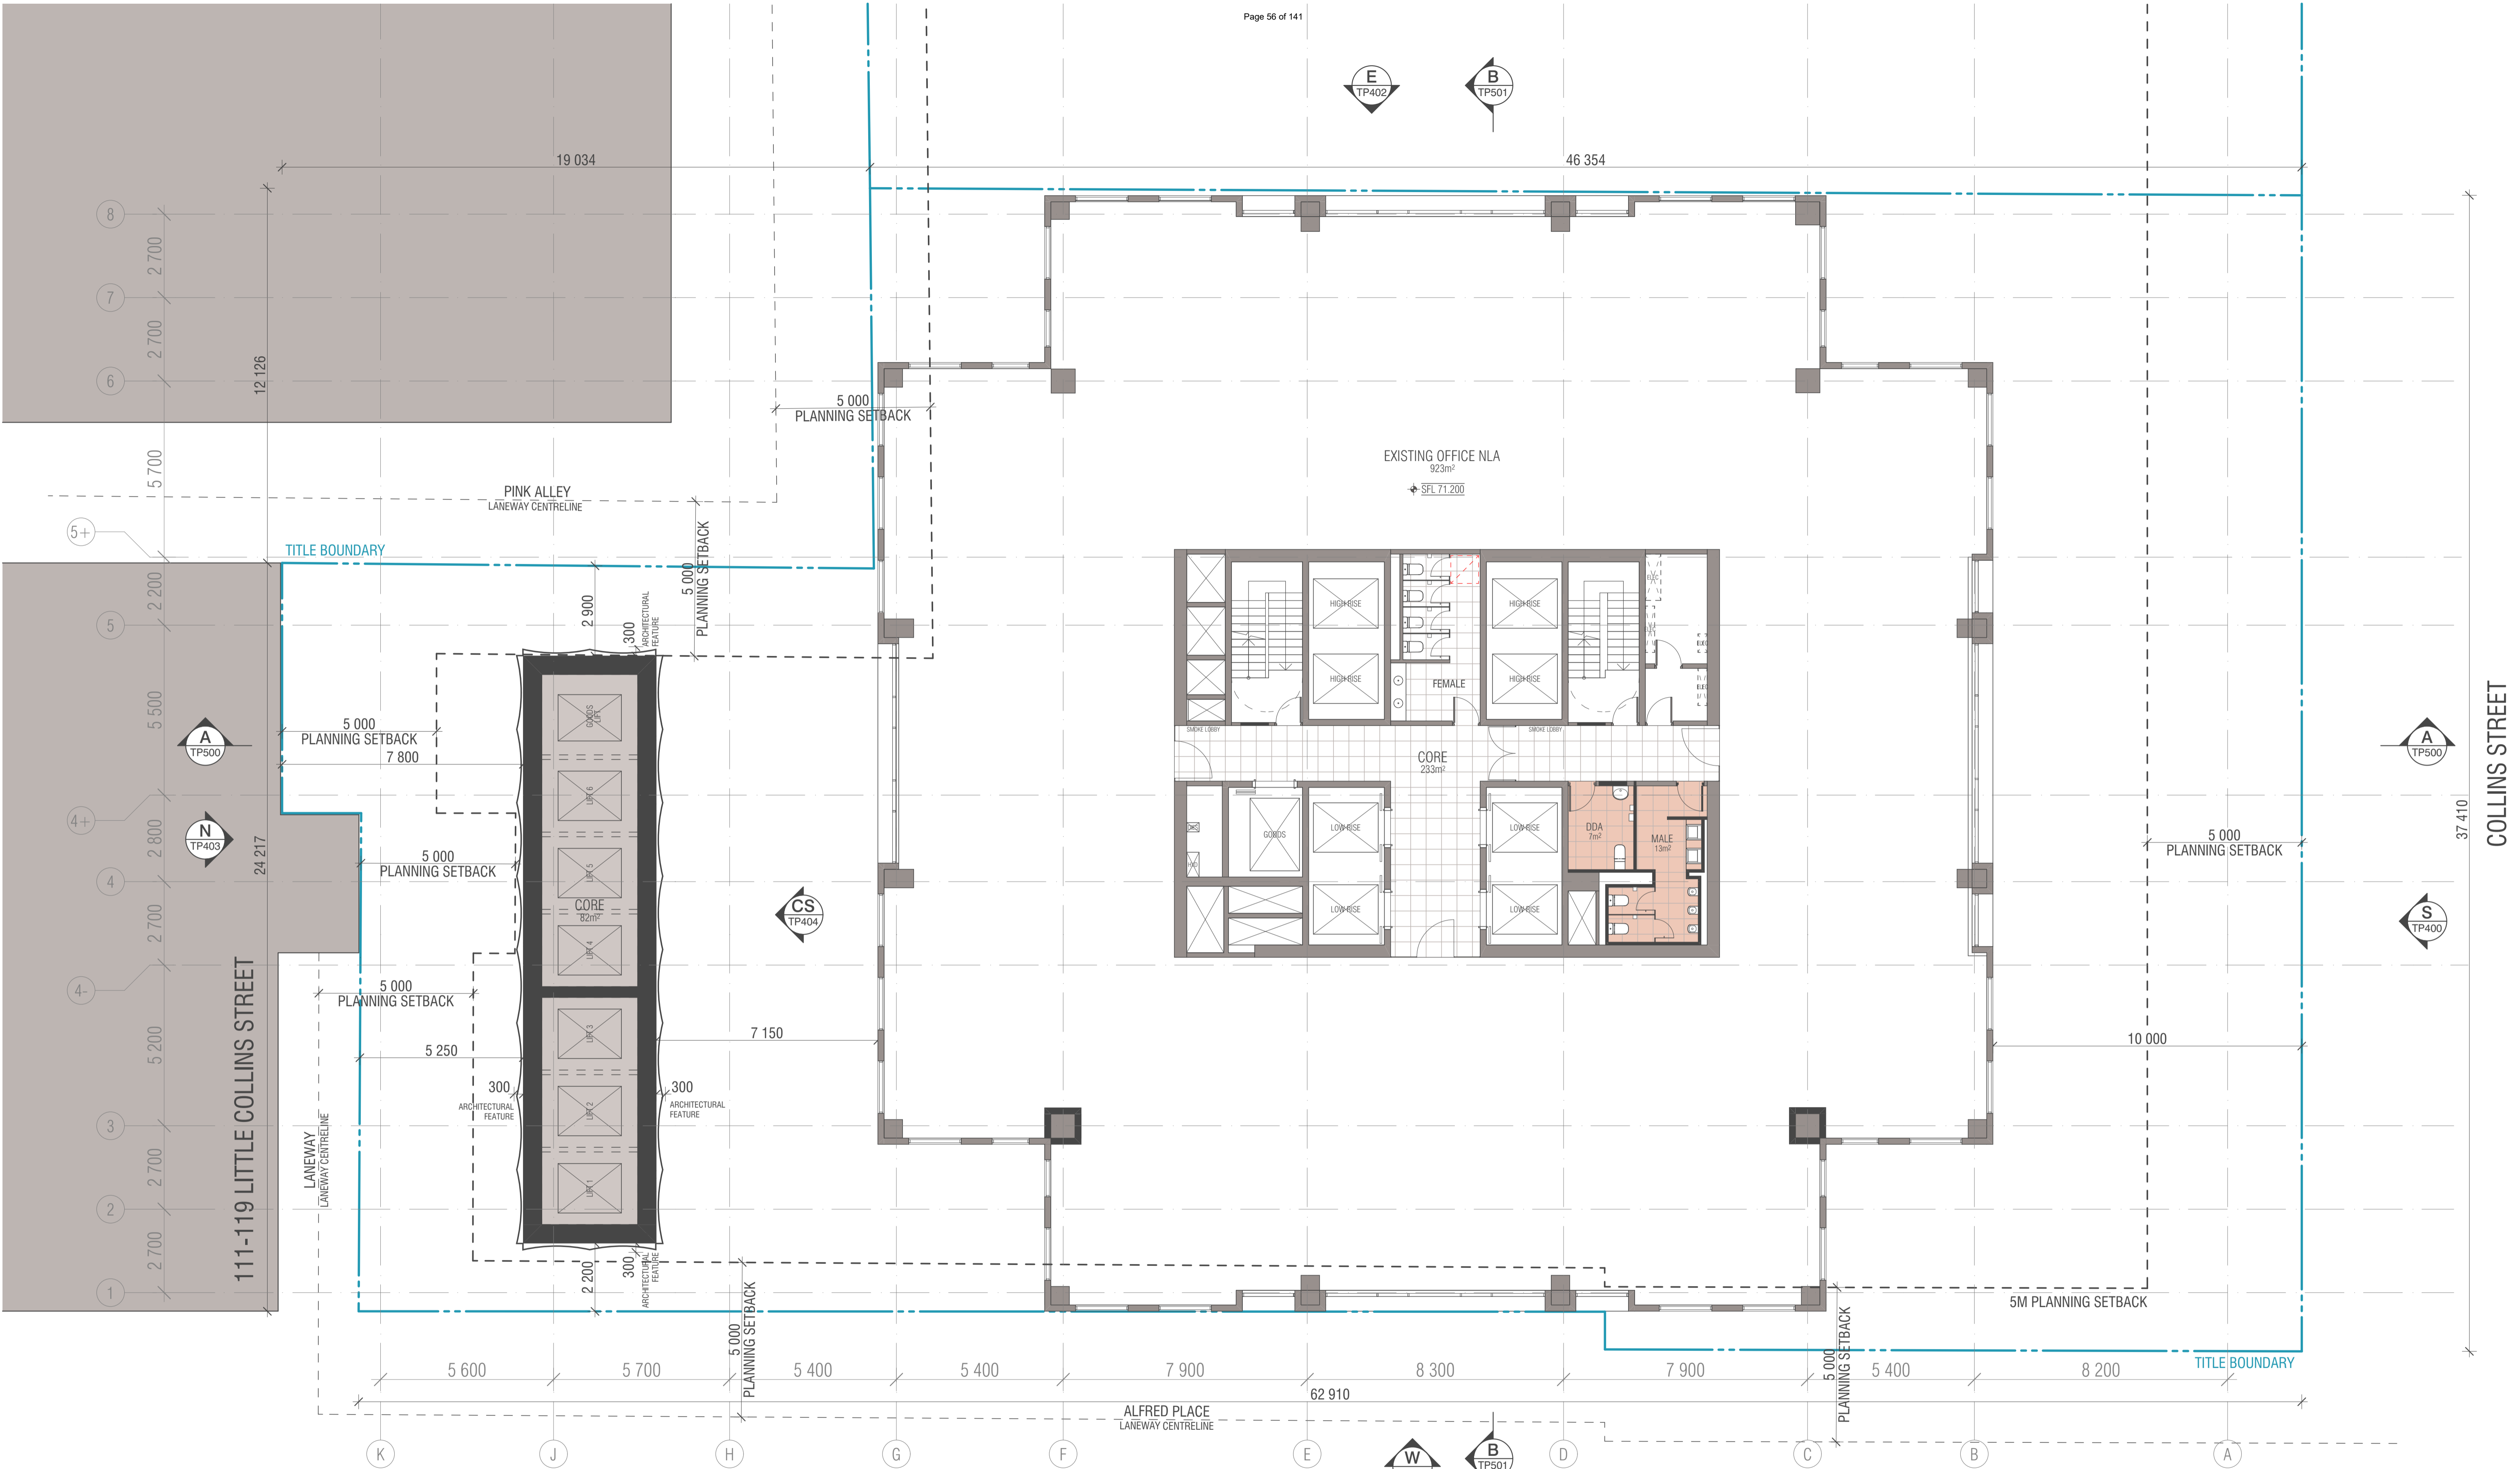

121-127 LITTLE COLLINS STREET

**WALL LEGEND**

- EXISTING
- DEMOLISHED
- PROPOSED

BIMcloud: FK BIMCLOUD - BIMcloud\18155 90 Collins Street Melbourne\00 MODEL\00-CD\BIM MODEL\18155 General

REVISION	DATE	BY
> 01 TOWN PLANNING SUBMISSION 02	10.06.2022	WTK
01 TOWN PLANNING ISSUE 01	16.12.2021	WTK

REVISION	DATE	BY
> 01 TOWN PLANNING SUBMISSION 02	10.06.2022	WTK
01 TOWN PLANNING ISSUE 01	16.12.2021	WTK

**QUALITY ASSURANCE** (FK IS A CERTIFIED COMPANY TO ISO 9001:2015)

THIS PROJECT IS SUBJECT TO THE FK QUALITY ASSURANCE SYSTEM

- SCHEMATIC DESIGN REVIEW FOR THIS PROJECT IS YET TO BE COMPLETED.
- DESIGN DEVELOPMENT REVIEW FOR THIS PROJECT IS YET TO BE COMPLETED.
- TENDER DOCUMENTATION REVIEW FOR THIS PROJECT IS YET TO BE COMPLETED.
- CONSTRUCTION DOCUMENTATION REVIEW FOR THIS PROJECT IS YET TO BE COMPLETED.

IF THIS DRAWING IS STAMPED UNCONTROLLED COPY THEN IT IS TO BE CONSIDERED A DRAFT. SUBJECT TO REVISION WITHOUT NOTICE

**NOTES**

THIS DRAWING IS COPYRIGHT AND SHALL REMAIN THE PROPERTY OF FENDER KATSALIDIS (AUST) PTY LTD. CHECK AND VERIFY ALL DIMENSIONS ON SITE PRIOR TO COMMENCING WORK. DRAWING TO BE READ IN CONJUNCTION WITH ALL OTHER CONTRACT DOCUMENTS. DO NOT SCALE DRAWINGS. USE FIGURED DIMENSIONS ONLY. SEEK CLARIFICATION OF INCONSISTENCIES / CONFLICTS.


DRAWN	DATE	CHECKED	PLOT DATE	JOB NO.	SCALE
WTK	10.06.2022	JV	21.07.2022	18155	1:100@A1

**PROJECT**

90 COLLINS REDEVELOPMENT  
90 COLLINS STREET  
MELBOURNE VIC 3000



**FENDER KATSALIDIS**  
WWW.FKAUSTRALIA.COM  
2 RIVERSIDE QUAY, SOUTHBANK  
VICTORIA 3006 AUSTRALIA  
TELEPHONE: +61 3 8696 3888  
FENDER KATSALIDIS (AUST) PTY LTD ACN 092 943 032

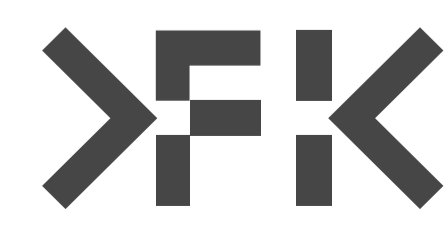

**DRAWING TITLE**


PROPOSED LEVEL 11-13 FLOOR PLAN

**ISSUE PURPOSE**

TOWN PLANNING

**REV.** 01  
**DRAWING NO.** TP311



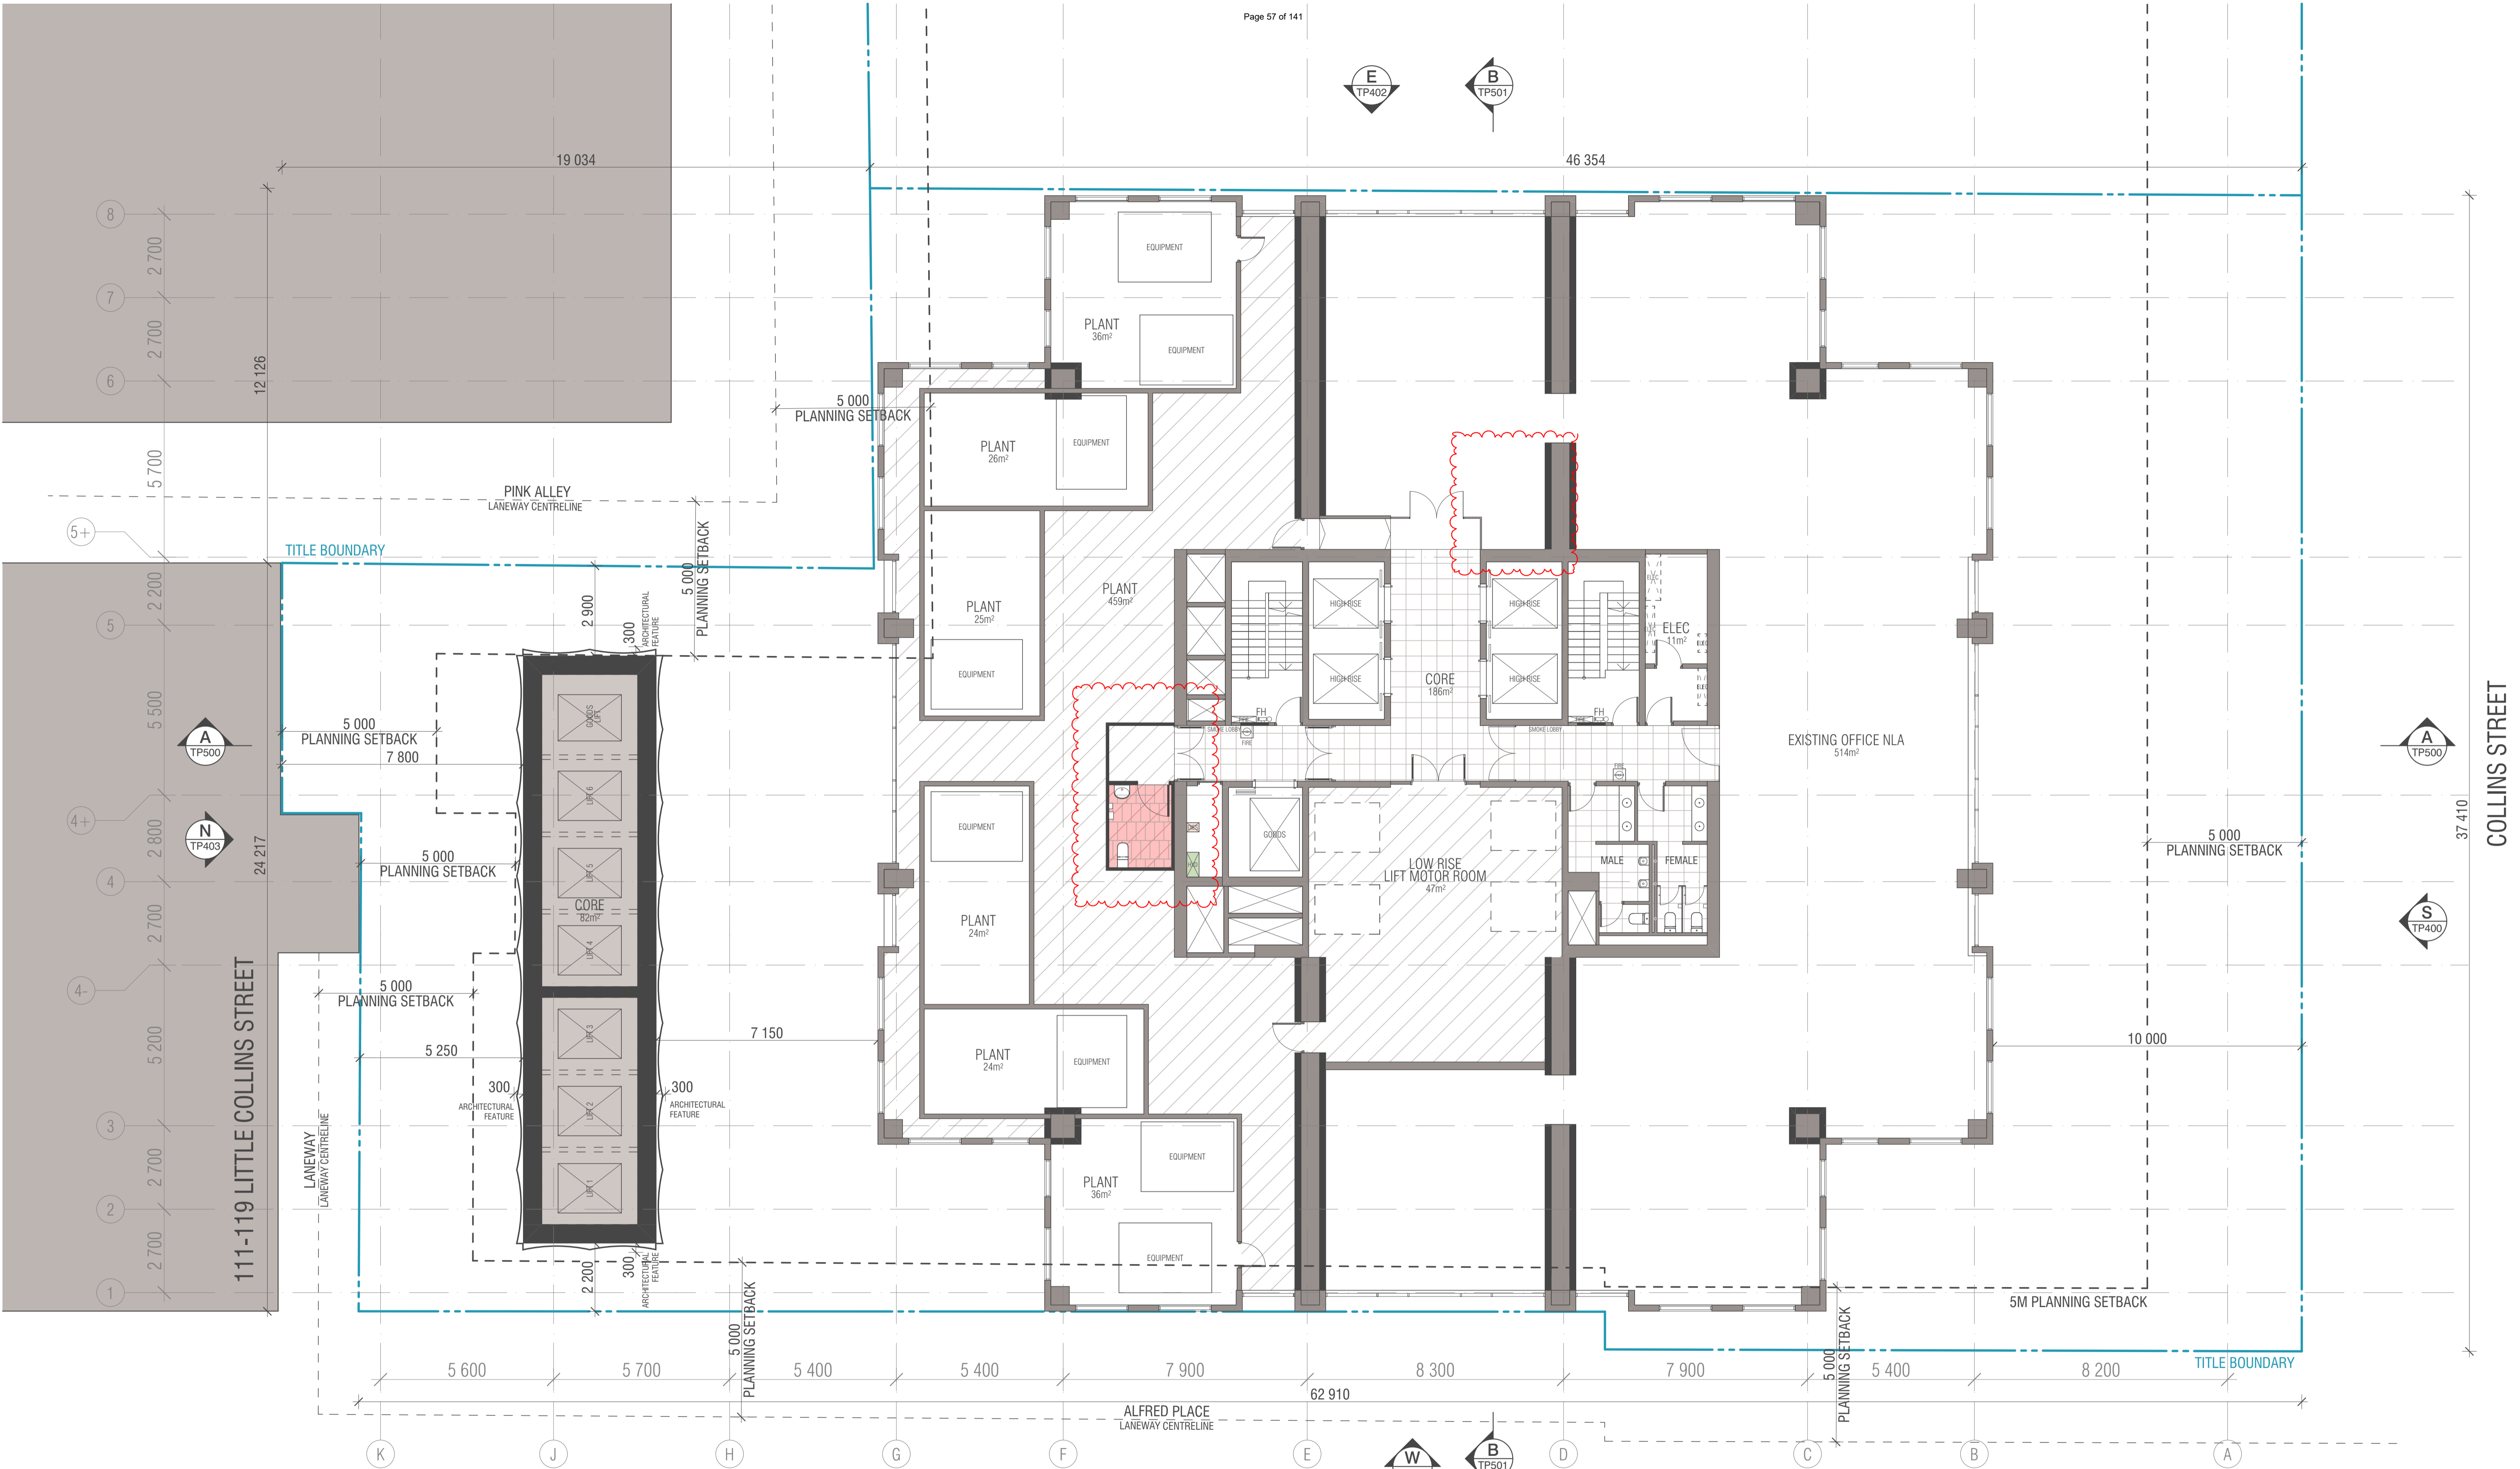

**WALL LEGEND**

- EXISTING
- DEMOLISHED
- PROPOSED

BIMcloud: FK BIMCLOUD - BIMcloud\18155 90 Collins Street Melbourne\00 MODEL\00-CD\BIM MODEL\18155 General

REVISION	REVISION
01 TOWN PLANNING ISSUE 01	WTK 16.12.2021
02 TOWN PLANNING SUBMISSION 02	WTK 10.06.2022
03 TOWN PLANNING SUBMISSION 03	WTK 15.07.2022

**QUALITY ASSURANCE** (FK IS A CERTIFIED COMPANY TO ISO 9001:2015)

THIS PROJECT IS SUBJECT TO THE FK QUALITY ASSURANCE SYSTEM

- SCHEMATIC DESIGN REVIEW FOR THIS PROJECT IS YET TO BE COMPLETED.
- DESIGN DEVELOPMENT REVIEW FOR THIS PROJECT IS YET TO BE COMPLETED.
- TENDER DOCUMENTATION REVIEW FOR THIS PROJECT IS YET TO BE COMPLETED.
- CONSTRUCTION DOCUMENTATION REVIEW FOR THIS DRAWING IS YET TO BE COMPLETED.

IF THIS DRAWING IS STAMPED UNCONTROLLED COPY THEN IT IS TO BE CONSIDERED A DRAFT. SUBJECT TO REVISION WITHOUT NOTICE

**NOTES**

THIS DRAWING IS COPYRIGHT AND SHALL REMAIN THE PROPERTY OF FENDER KATSALIDIS (AUST) PTY LTD. CHECK AND VERIFY ALL DIMENSIONS ON SITE PRIOR TO COMMENCING WORK. DRAWING TO BE READ IN CONJUNCTION WITH ALL OTHER CONTRACT DOCUMENTS. DO NOT SCALE DRAWINGS. USE FIGURED DIMENSIONS ONLY. SEEK CLARIFICATION OF INCONSISTENCIES / CONFLICTS.


DRAWN	DATE	CHECKED	PLOT DATE	JOB NO.	SCALE
WTK	15.07.2022	JV	21.07.2022	18155	1:100@A1

**PROJECT**

90 COLLINS REDEVELOPMENT  
90 COLLINS STREET  
MELBOURNE VIC 3000



**FENDER KATSALIDIS**  
WWW.FKAUSTRALIA.COM  
2 RIVERSIDE QUAY, SOUTHBANK  
VICTORIA 3006 AUSTRALIA  
TELEPHONE: +61 3 8696 3888  
FENDER KATSALIDIS (AUST) PTY LTD ACN 092 943 032

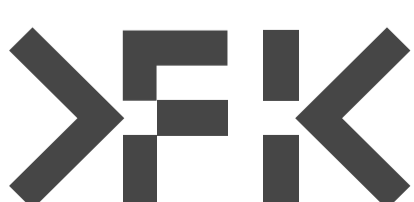


**DRAWING TITLE**

PROPOSED LEVEL 14 FLOOR PLAN

**ISSUE PURPOSE**

TOWN PLANNING

**REV.** 02 **DRAWING NO.** TP314

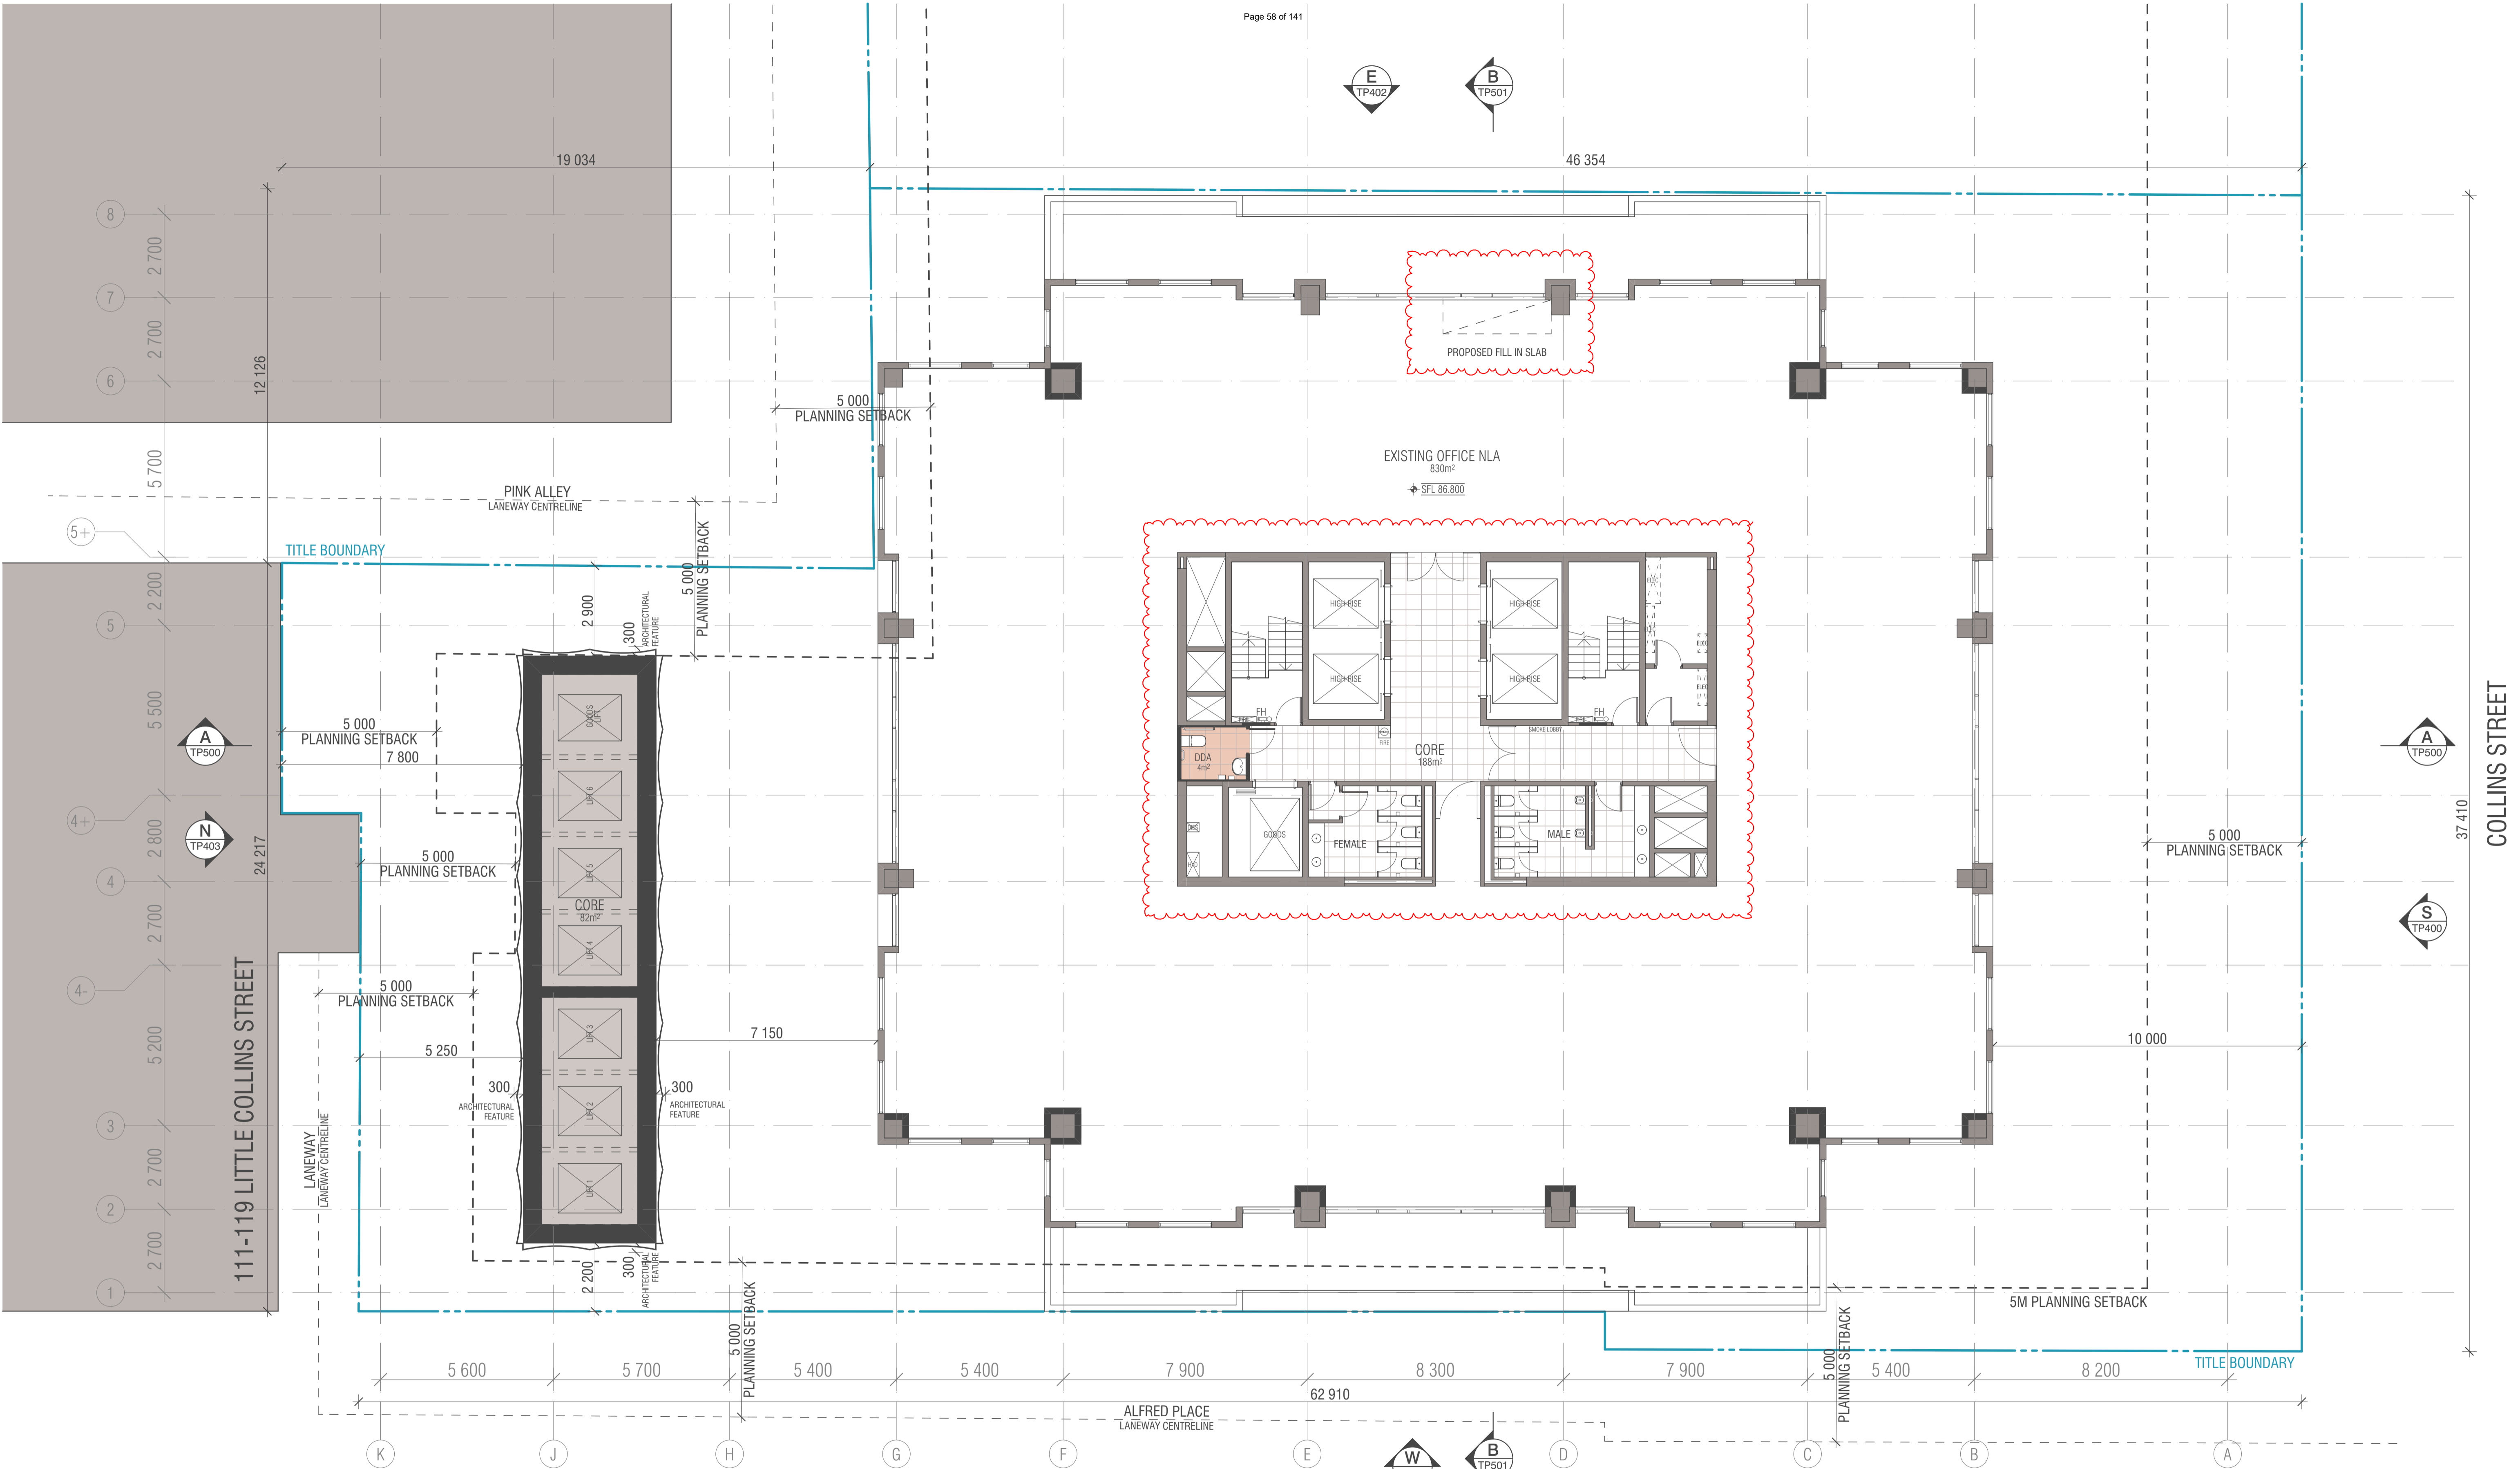

**WALL LEGEND**

- EXISTING
- DEMOLISHED
- PROPOSED

BIMcloud: FK BIMCLOUD - BIMcloud\18155 90 Collins Street Melbourne\00 MODEL\00-CD\BIM MODEL\18155 General

REVISION	REVISION
01 TOWN PLANNING ISSUE 01	WTK 16.12.2021
02 TOWN PLANNING SUBMISSION 02	WTK 10.06.2022
03 TOWN PLANNING SUBMISSION 03	WTK 15.07.2022

**QUALITY ASSURANCE** (FK IS A CERTIFIED COMPANY TO ISO 9001:2015)

THIS PROJECT IS SUBJECT TO THE FK QUALITY ASSURANCE SYSTEM

- SCHEMATIC DESIGN REVIEW FOR THIS PROJECT IS YET TO BE COMPLETED.
- DESIGN DEVELOPMENT REVIEW FOR THIS PROJECT IS YET TO BE COMPLETED.
- TENDER DOCUMENTATION REVIEW FOR THIS PROJECT IS YET TO BE COMPLETED.
- CONSTRUCTION DOCUMENTATION REVIEW FOR THIS PROJECT IS YET TO BE COMPLETED.

IF THIS DRAWING IS STAMPED UNCONTROLLED COPY THEN IT IS TO BE CONSIDERED A DRAFT. SUBJECT TO REVISION WITHOUT NOTICE

**NOTES**

THIS DRAWING IS COPYRIGHT AND SHALL REMAIN THE PROPERTY OF FENDER KATSLIDIS (AUST) PTY LTD. CHECK AND VERIFY ALL DIMENSIONS ON SITE PRIOR TO COMMENCING WORK. DRAWING TO BE READ IN CONJUNCTION WITH ALL OTHER CONTRACT DOCUMENTS. DO NOT SCALE DRAWINGS. USE FIGURED DIMENSIONS ONLY. SEEK CLARIFICATION OF INCONSISTENCIES / CONFLICTS.


DRAWN	DATE	CHECKED	PLOT DATE	JOB NO.	SCALE
WTK	15.07.2022	JV	21.07.2022	18155	1:100@A1

**PROJECT**

90 COLLINS REDEVELOPMENT  
90 COLLINS STREET  
MELBOURNE VIC 3000



**FENDER KATSLIDIS**  
WWW.FKAUSTRALIA.COM  
2 RIVERSIDE QUAY, SOUTHBANK  
VICTORIA 3006 AUSTRALIA  
TELEPHONE: +61 3 8696 3888  
FENDER KATSLIDIS (AUST) PTY LTD ACN 092 943 032

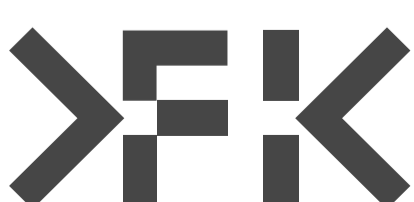

**DRAWING TITLE**


PROPOSED LEVEL 15 FLOOR PLAN

**ISSUE PURPOSE**

TOWN PLANNING

**REV.** 02 **DRAWING NO.** TP315



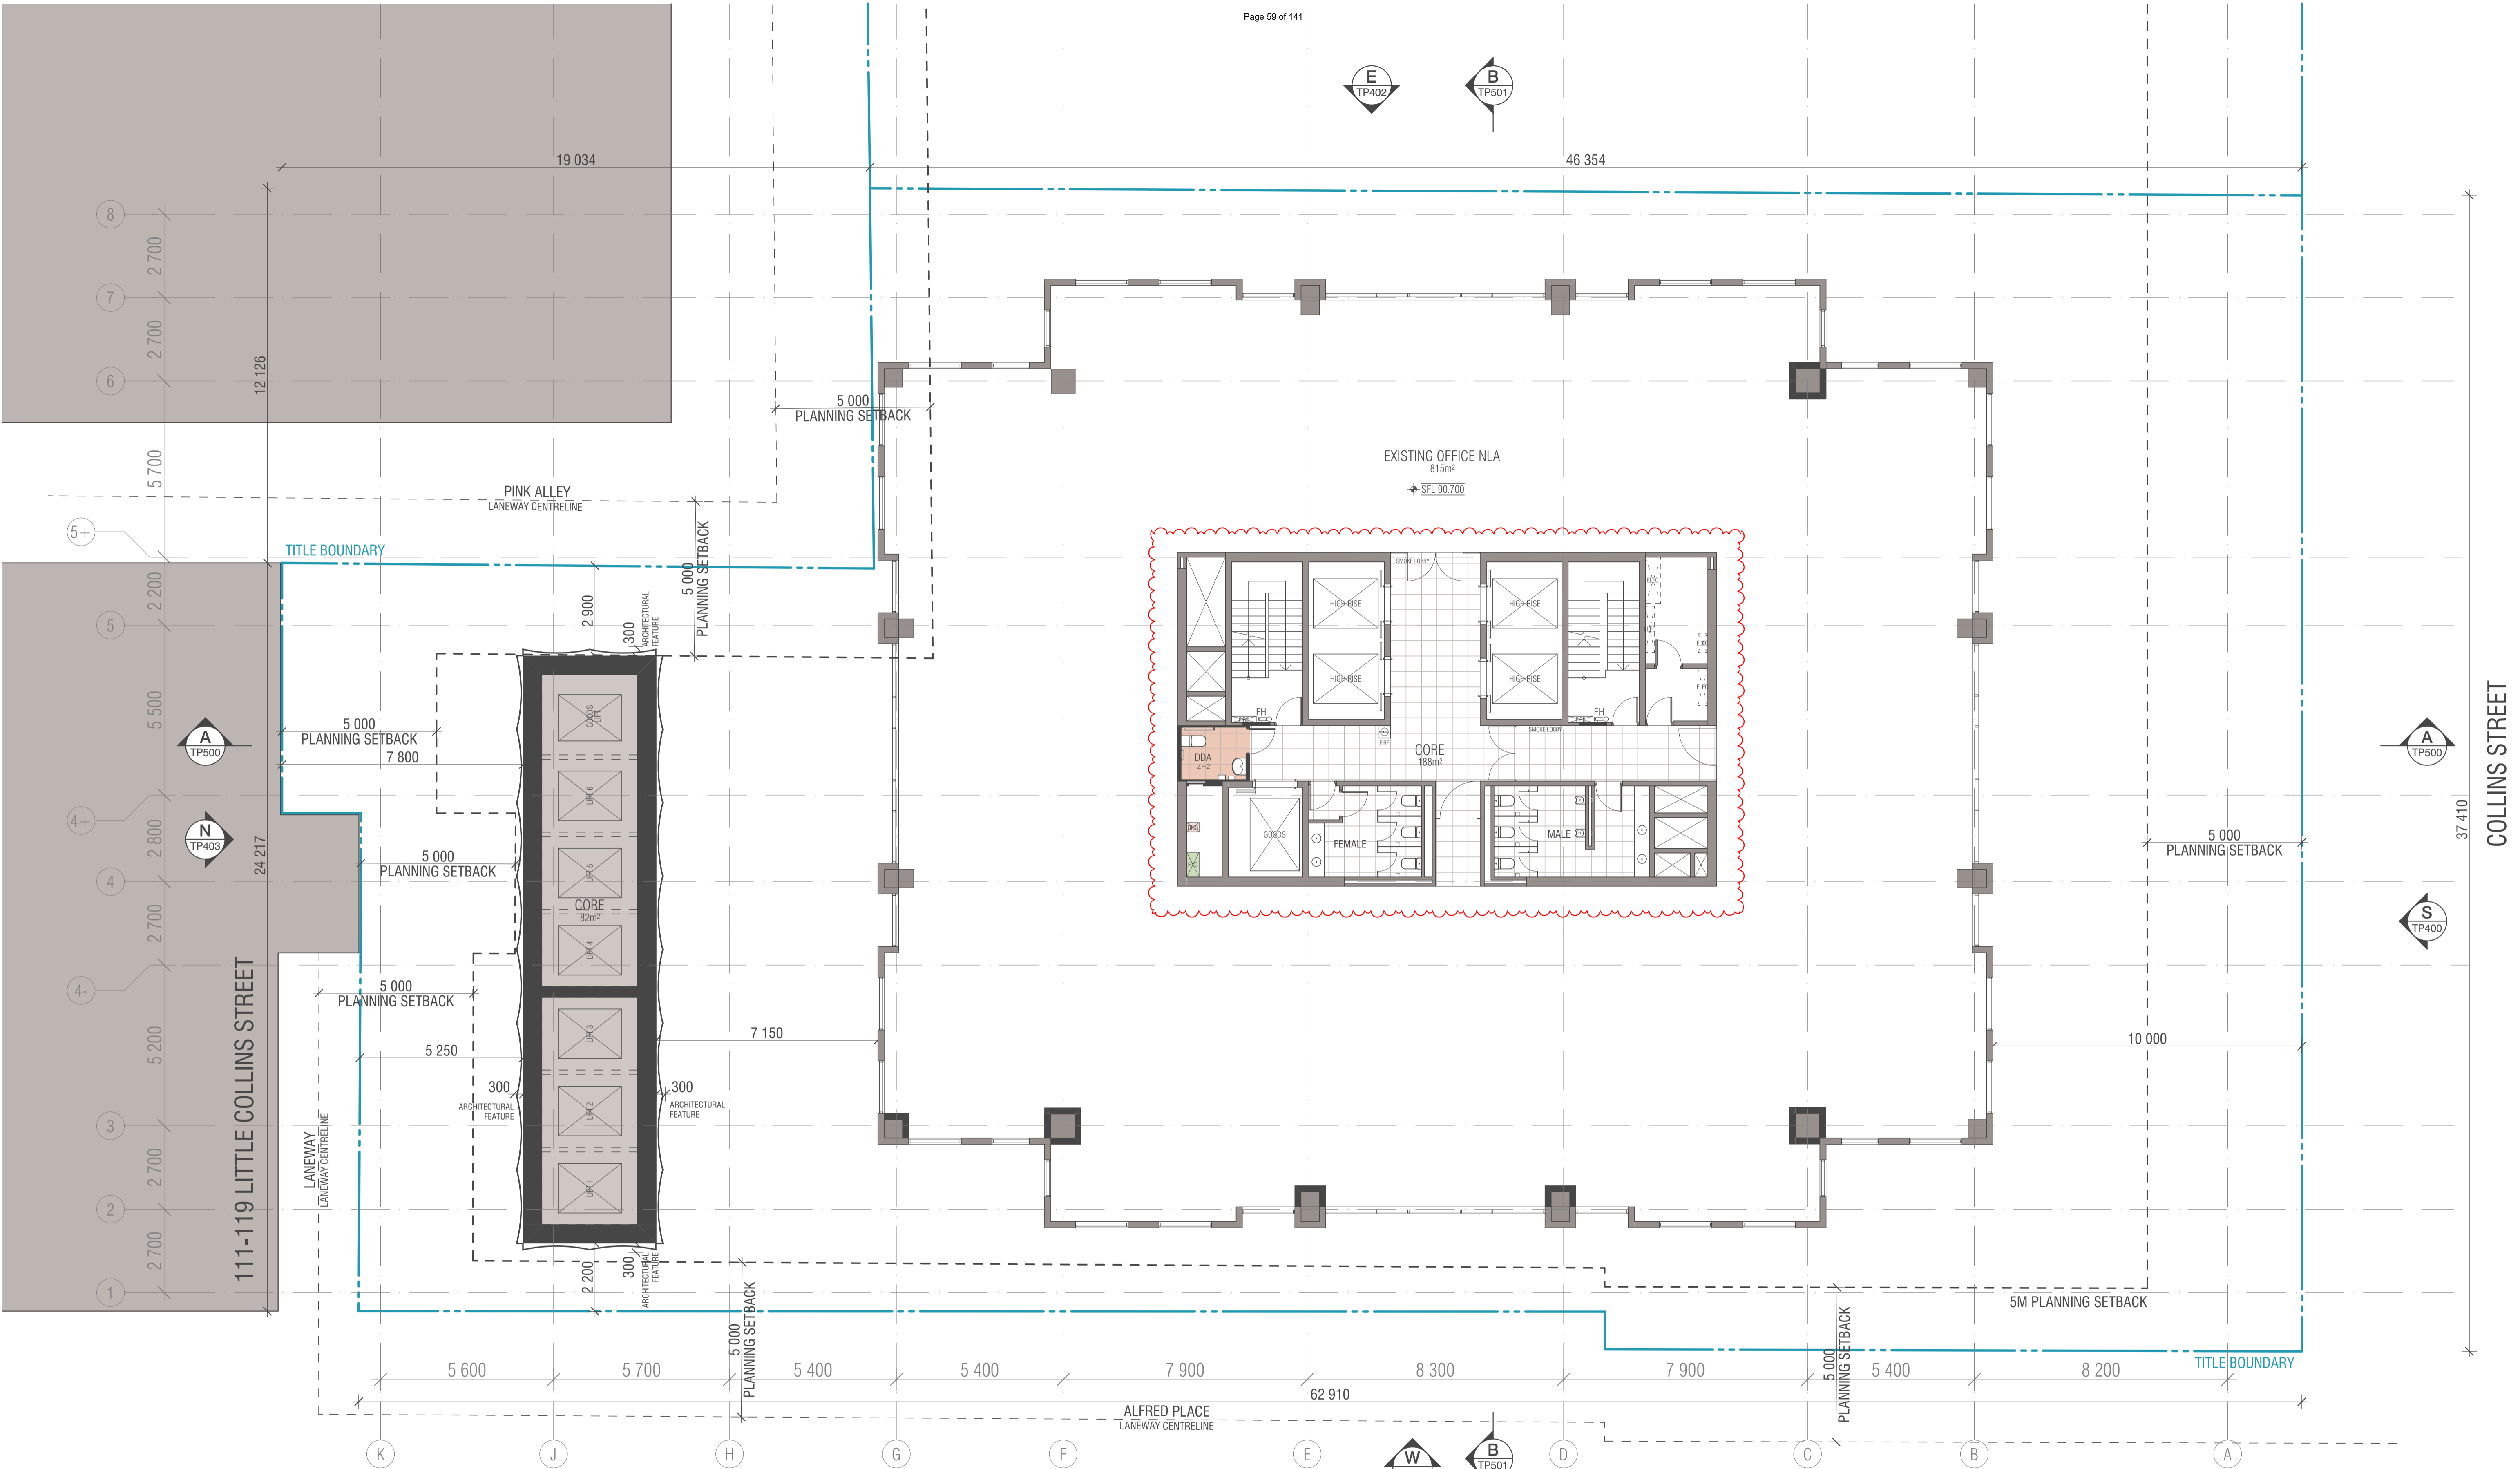

**WALL LEGEND**

- EXISTING
- DEMOLISHED
- PROPOSED

BIMcloud: FK BIMCLOUD - BIMcloud\18155 90 Collins Street Melbourne\00 MODEL\00-CD\BIM MODEL\18155 General

REVISION	REVISION
01 TOWN PLANNING ISSUE 01	WTK 16.12.2021
02 TOWN PLANNING SUBMISSION 02	WTK 10.06.2022
03 TOWN PLANNING SUBMISSION 03	WTK 15.07.2022

**QUALITY ASSURANCE** (FK IS A CERTIFIED COMPANY TO ISO 9001:2015)

THIS PROJECT IS SUBJECT TO THE FK QUALITY ASSURANCE SYSTEM

- SCHEMATIC DESIGN REVIEW FOR THIS PROJECT IS YET TO BE COMPLETED.
- DESIGN DEVELOPMENT REVIEW FOR THIS PROJECT IS YET TO BE COMPLETED.
- TENDER DOCUMENTATION REVIEW FOR THIS PROJECT IS YET TO BE COMPLETED.
- CONSTRUCTION DOCUMENTATION REVIEW FOR THIS DRAWING IS YET TO BE COMPLETED.

IF THIS DRAWING IS STAMPED UNCONTROLLED COPY THEN IT IS TO BE CONSIDERED A DRAFT. SUBJECT TO REVISION WITHOUT NOTICE

**NOTES**

THIS DRAWING IS COPYRIGHT AND SHALL REMAIN THE PROPERTY OF FENDER KATSLIDIS (AUST) PTY LTD. CHECK AND VERIFY ALL DIMENSIONS ON SITE PRIOR TO COMMENCING WORK. DRAWING TO BE READ IN CONJUNCTION WITH ALL OTHER CONTRACT DOCUMENTS. DO NOT SCALE DRAWINGS. USE FIGURED DIMENSIONS ONLY. SEEK CLARIFICATION OF INCONSISTENCIES / CONFLICTS.


DRAWN	DATE	CHECKED	PLOT DATE	JOB NO.	SCALE
WTK	15.07.2022	JV	21.07.2022	18155	1:100@A1

**PROJECT**

90 COLLINS REDEVELOPMENT  
90 COLLINS STREET  
MELBOURNE VIC 3000



**FENDER KATSLIDIS**  
WWW.FKAUSTRALIA.COM  
2 RIVERSIDE QUAY, SOUTHBANK  
VICTORIA 3006 AUSTRALIA  
TELEPHONE: +61 3 8696 3888  
FENDER KATSLIDIS (AUST) PTY LTD ACN 092 943 032

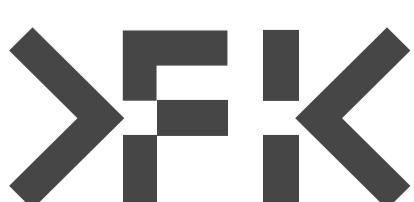


**DRAWING TITLE**

PROPOSED LEVEL 16-19 FLOOR PLAN

**ISSUE PURPOSE**

TOWN PLANNING

**REV.** 02 **DRAWING NO.** TP316

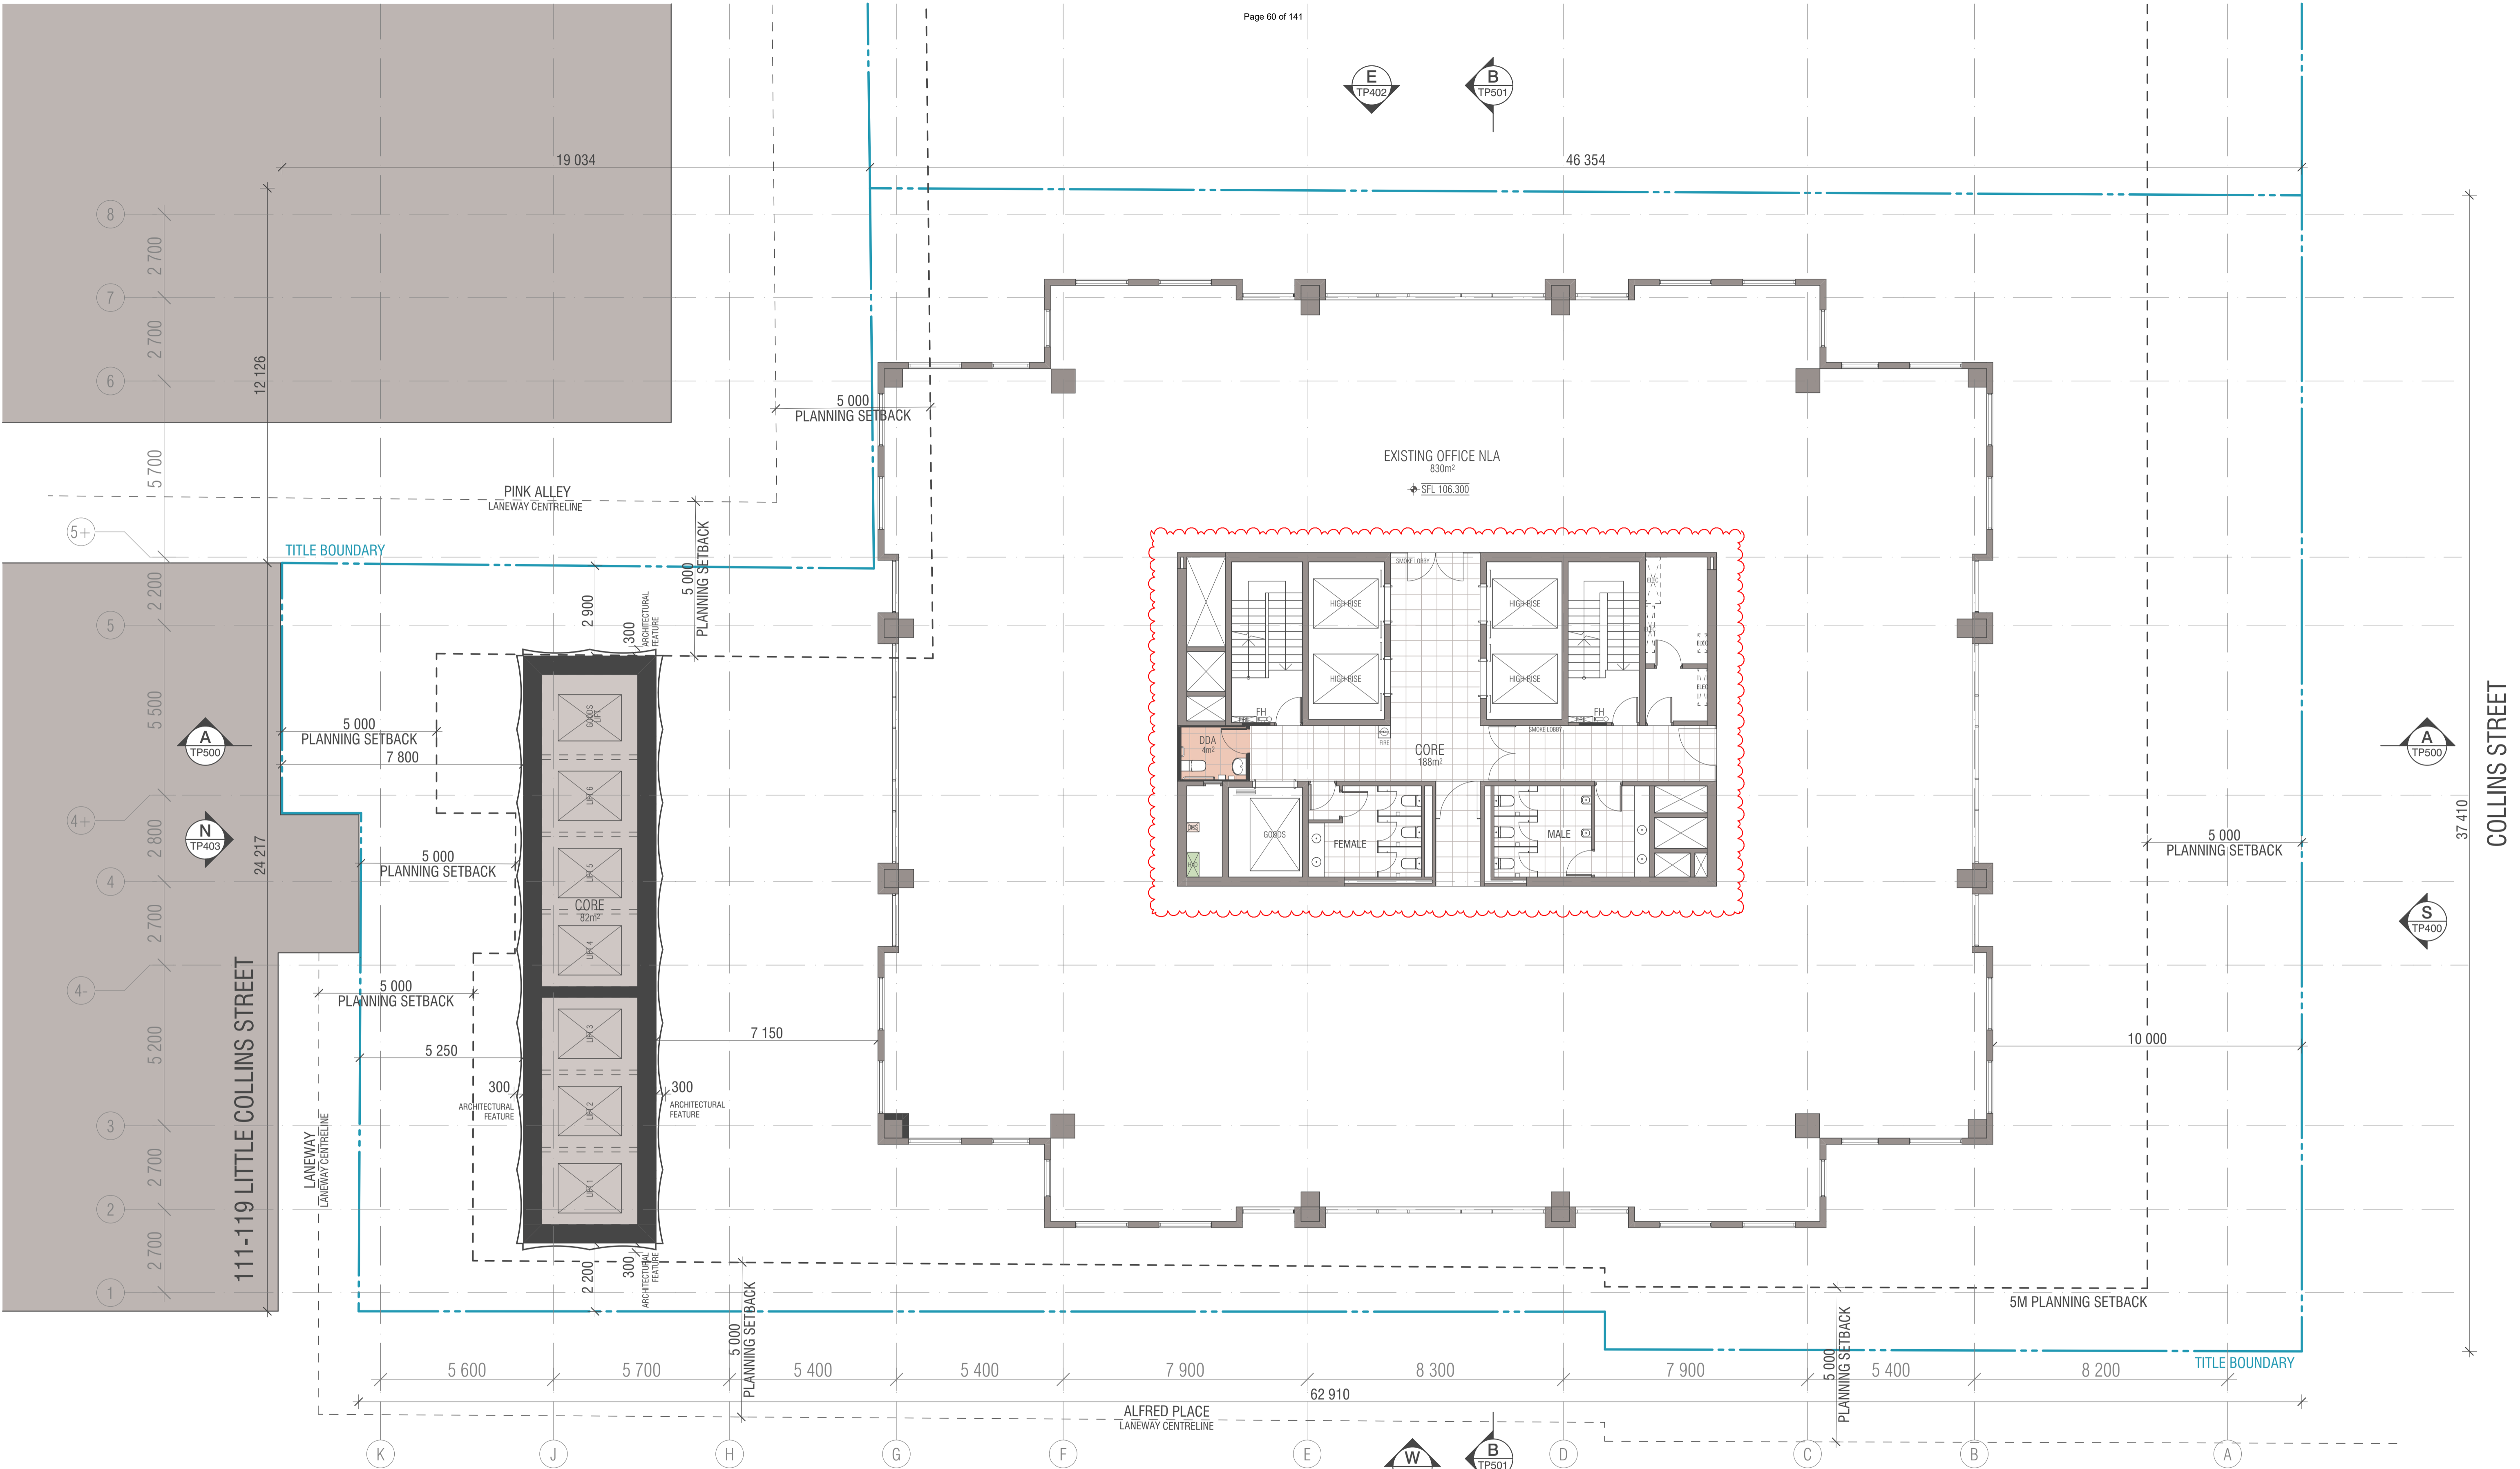

BIMcloud: FK BIMCLOUD - BIMcloud\18155 90 Collins Street Melbourne\00 MODEL\00-CD\BIM MODEL\18155 General

REVISION	REVISION
01 TOWN PLANNING ISSUE 01	WTK 16.12.2021
02 TOWN PLANNING SUBMISSION 02	WTK 10.06.2022
03 TOWN PLANNING SUBMISSION 03	WTK 15.07.2022

**QUALITY ASSURANCE** (FK IS A CERTIFIED COMPANY TO ISO 9001:2015)

THIS PROJECT IS SUBJECT TO THE FK QUALITY ASSURANCE SYSTEM

- SCHEMATIC DESIGN REVIEW FOR THIS PROJECT IS YET TO BE COMPLETED.
- DESIGN DEVELOPMENT REVIEW FOR THIS PROJECT IS YET TO BE COMPLETED.
- TENDER DOCUMENTATION REVIEW FOR THIS PROJECT IS YET TO BE COMPLETED.
- CONSTRUCTION DOCUMENTATION REVIEW FOR THIS PROJECT IS YET TO BE COMPLETED.

IF THIS DRAWING IS STAMPED UNCONTROLLED COPY THEN IT IS TO BE CONSIDERED A DRAFT. SUBJECT TO REVISION WITHOUT NOTICE

**NOTES**

THIS DRAWING IS COPYRIGHT AND SHALL REMAIN THE PROPERTY OF FENDER KATSAIDIS (AUST) PTY LTD  
 CHECK AND VERIFY ALL DIMENSIONS ON SITE PRIOR TO COMMENCING WORK. DRAWING TO BE READ  
 IN CONJUNCTION WITH ALL OTHER CONTRACT DOCUMENTS. DO NOT SCALE DRAWINGS. USE FIGURED  
 DIMENSIONS ONLY. SEEK CLARIFICATION OF INCONSISTENCIES / CONFLICTS.


DRAWN	DATE	CHECKED	PLOT DATE	JOB NO.	SCALE
WTK	15.07.2022	JV	21.07.2022	18155	1:100@A1

**PROJECT**

90 COLLINS REDEVELOPMENT  
 90 COLLINS STREET  
 MELBOURNE VIC 3000



**FENDER KATSAIDIS**  
 WWW.FKAUSTRALIA.COM  
 2 RIVERSIDE QUAY, SOUTHBANK  
 VICTORIA 3006 AUSTRALIA  
 TELEPHONE: +61 3 8696 3888  
 FENDER KATSAIDIS (AUST) PTY LTD ACN 092 943 032

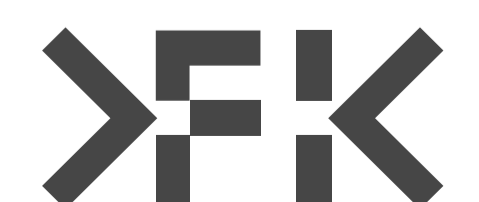

**DRAWING TITLE**


PROPOSED LEVEL 20 FLOOR PLAN

**ISSUE PURPOSE**

TOWN PLANNING

**REV.** 02 **DRAWING NO.** TP320



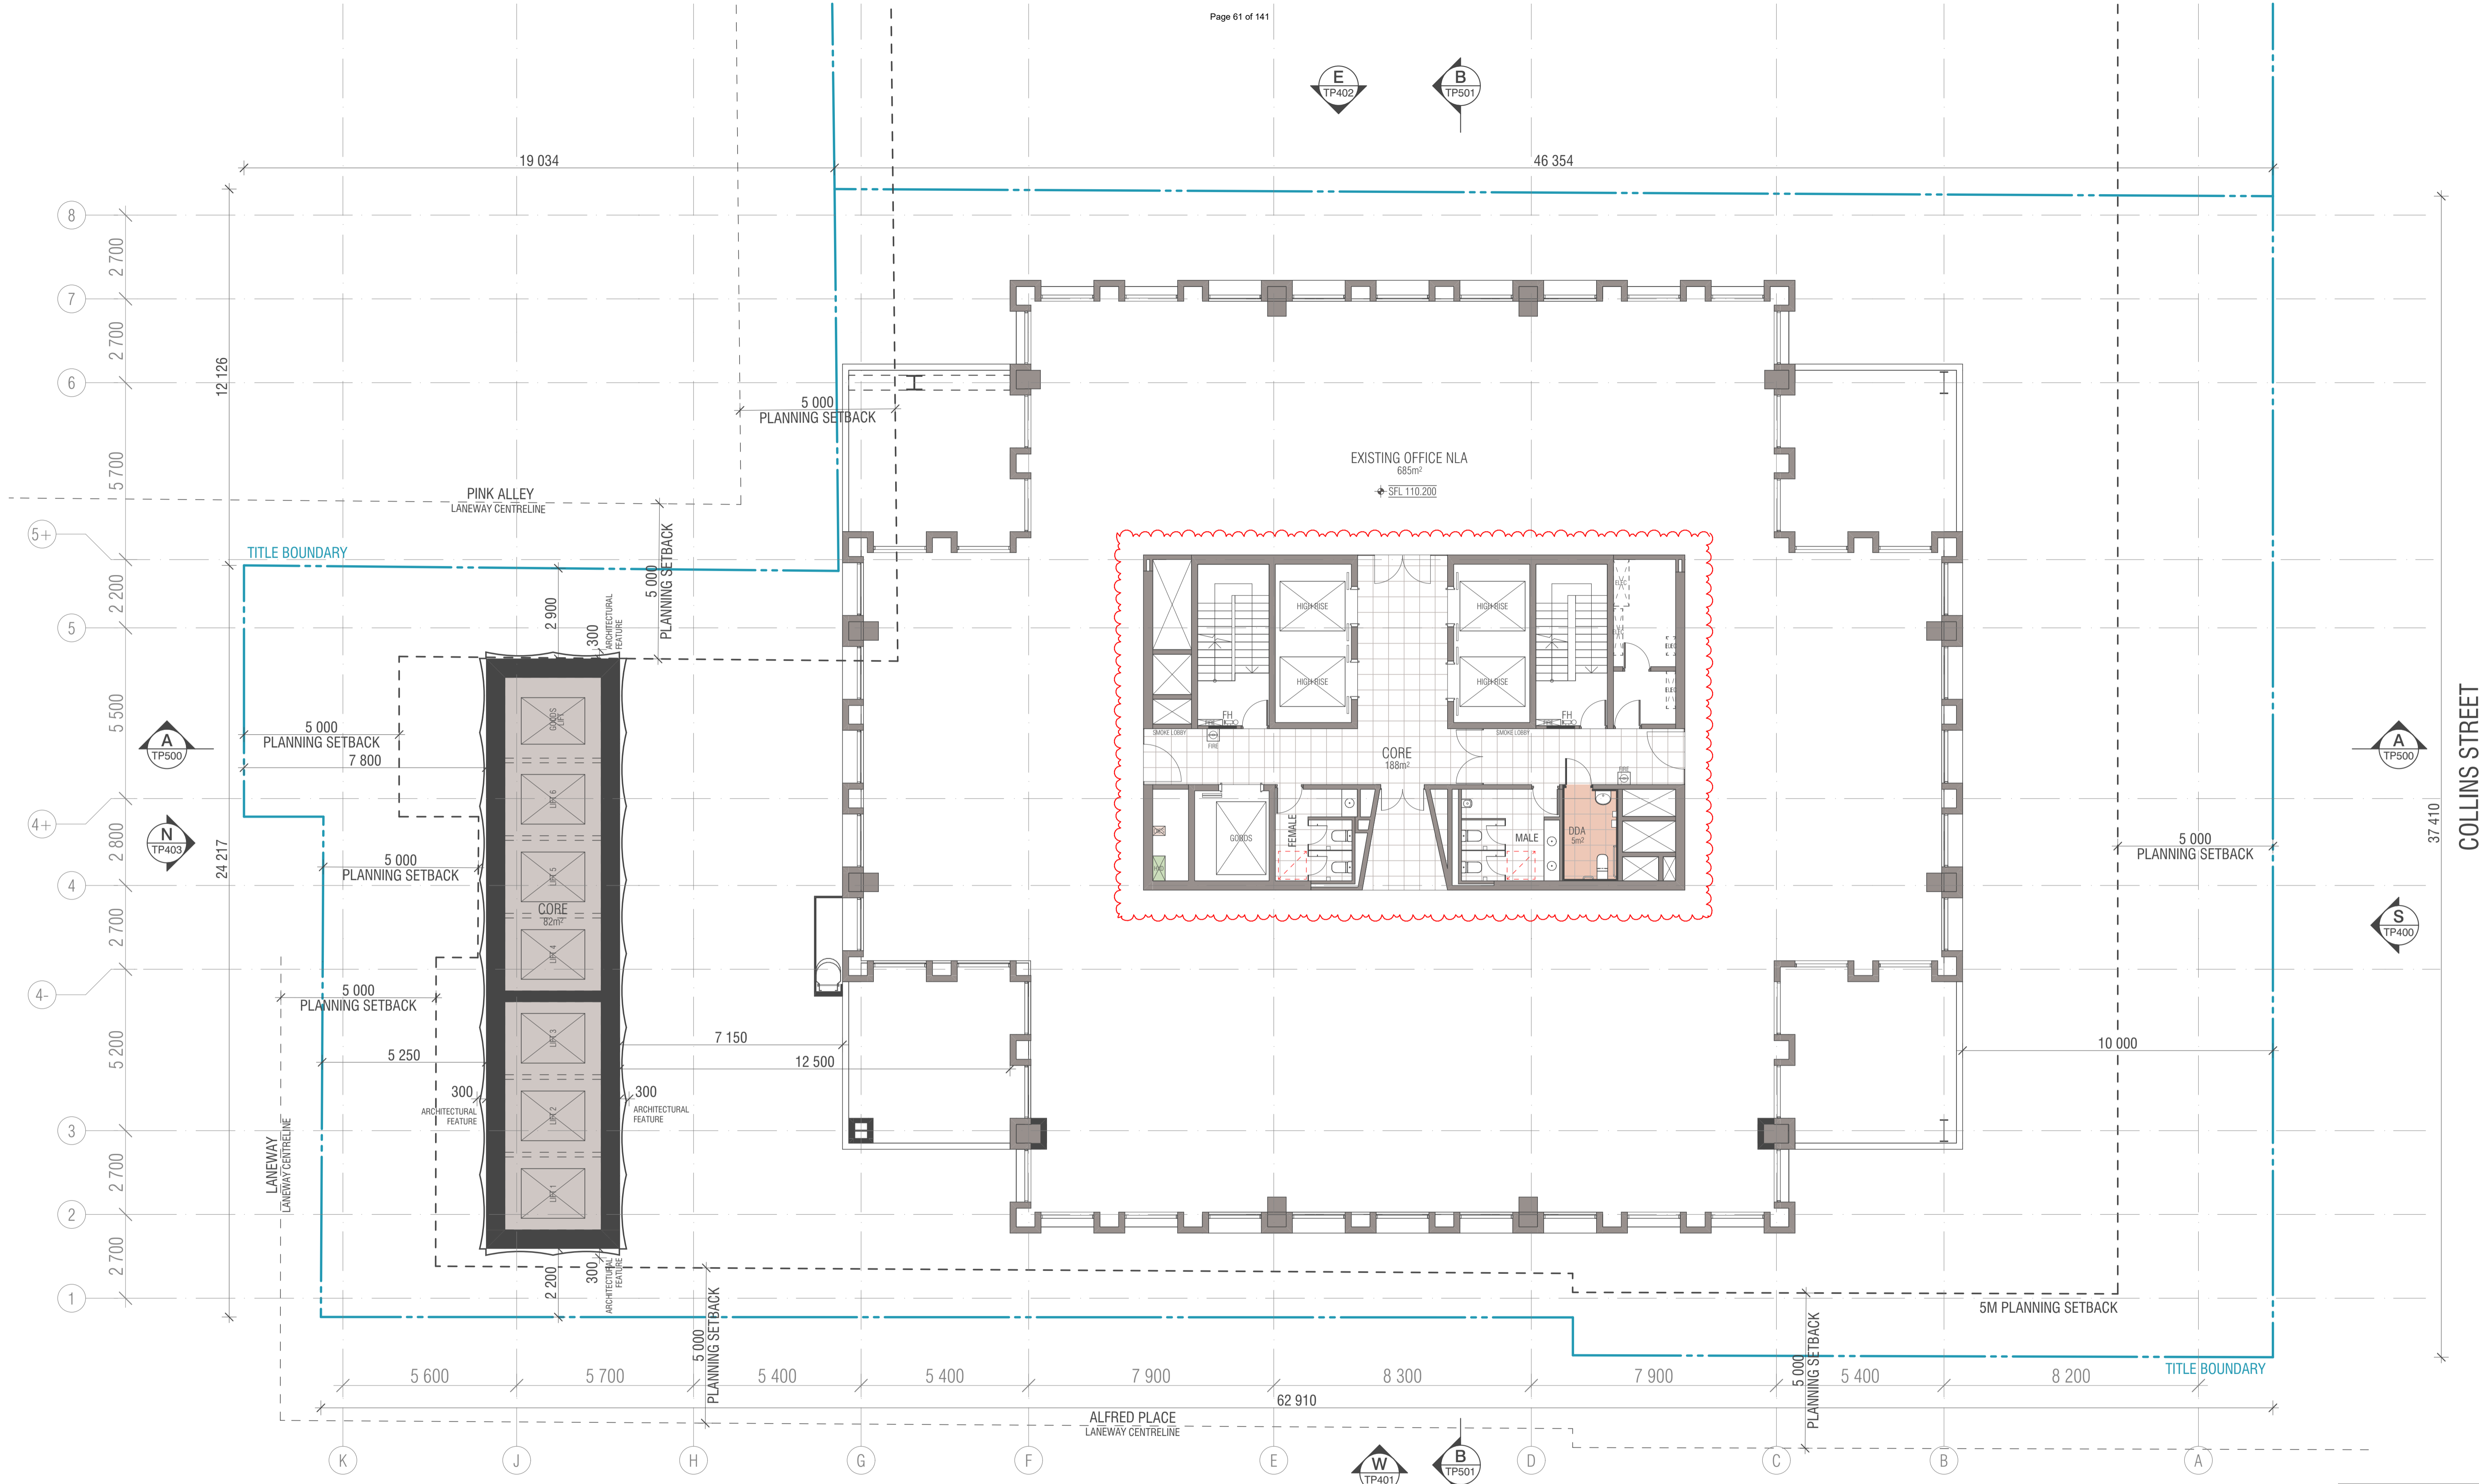

**WALL LEGEND**

- EXISTING
- DEMOLISHED
- PROPOSED

BIMcloud: FK BIMCLOUD - BIMcloud\18155 90 Collins Street Melbourne\00 MODEL\00 - CD\BIM MODEL\18155 General

REVISION	DATE	BY
01	16.12.2021	WTK
02	10.06.2022	WTK
03	15.07.2022	WTK

REVISION	DATE	BY
01	16.12.2021	WTK
02	10.06.2022	WTK
03	15.07.2022	WTK

**QUALITY ASSURANCE** (FK IS A CERTIFIED COMPANY TO ISO 9001:2015)

THIS PROJECT IS SUBJECT TO THE FK QUALITY ASSURANCE SYSTEM

- SCHEMATIC DESIGN REVIEW FOR THIS PROJECT IS YET TO BE COMPLETED.
- DESIGN DEVELOPMENT REVIEW FOR THIS PROJECT IS YET TO BE COMPLETED.
- TENDER DOCUMENTATION REVIEW FOR THIS PROJECT IS YET TO BE COMPLETED.
- CONSTRUCTION DOCUMENTATION REVIEW FOR THIS DRAWING IS YET TO BE COMPLETED.

IF THIS DRAWING IS STAMPED UNCONTROLLED COPY THEN IT IS TO BE CONSIDERED A DRAFT. SUBJECT TO REVISION WITHOUT NOTICE

**NOTES**

THIS DRAWING IS COPYRIGHT AND SHALL REMAIN THE PROPERTY OF FENDER KATSLIDIS (AUST) PTY LTD. CHECK AND VERIFY ALL DIMENSIONS ON SITE PRIOR TO COMMENCING WORK. DRAWING TO BE READ IN CONJUNCTION WITH ALL OTHER CONTRACT DOCUMENTS. DO NOT SCALE DRAWINGS. USE FIGURED DIMENSIONS ONLY. SEEK CLARIFICATION OF INCONSISTENCIES / CONFLICTS.

DRAWN	DATE	CHECKED	PLOT DATE	JOB NO.	SCALE
WTK	15.07.2022	JV	21.07.2022	18155	1:100@A1

**PROJECT**



90 COLLINS REDEVELOPMENT  
90 COLLINS STREET  
MELBOURNE VIC 3000



**FENDER KATSLIDIS**  
WWW.FKAUSTRALIA.COM  
2 RIVERSIDE QUAY, SOUTHBANK  
VICTORIA 3006 AUSTRALIA  
TELEPHONE: +61 3 8696 3888  
FENDER KATSLIDIS (AUST) PTY LTD ACN 092 943 032



ISSUE PURPOSE	REV.	DRAWING NO.
TOWN PLANNING	02	TP321

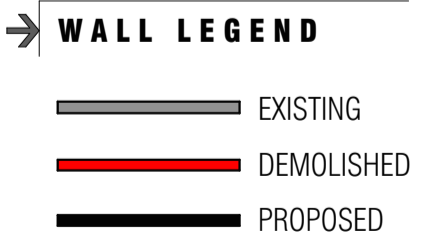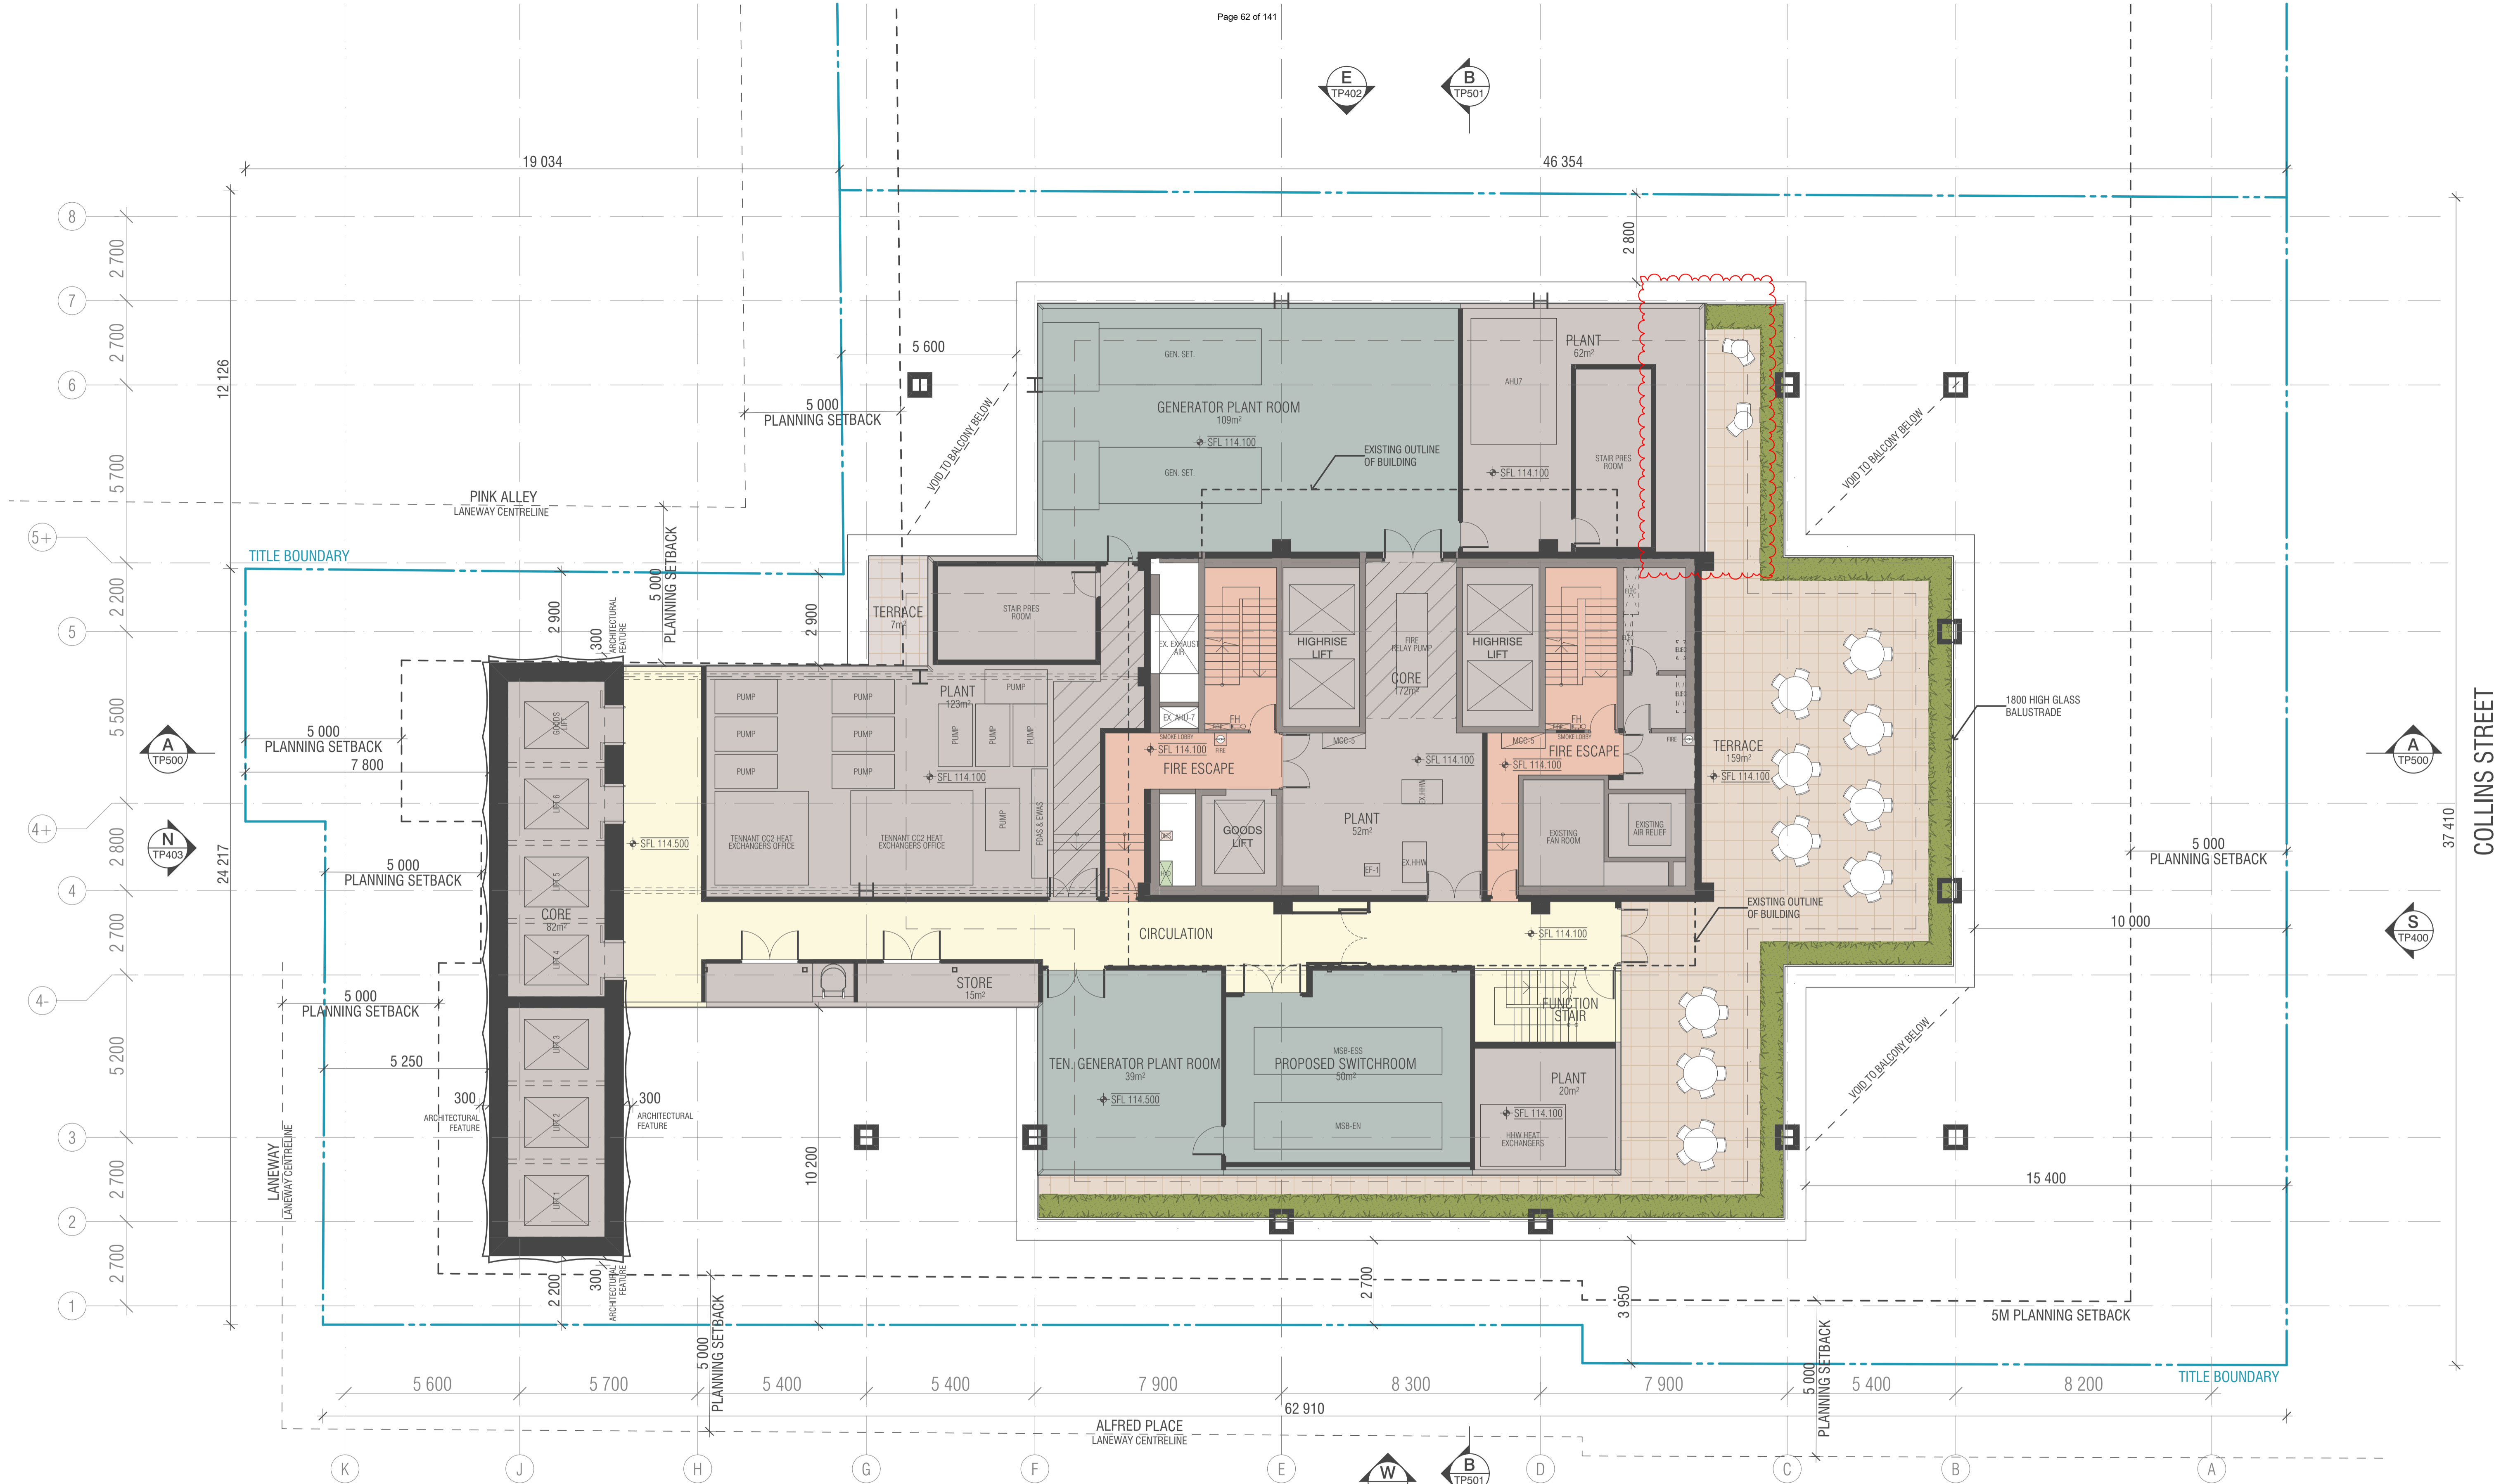

BIMcloud: FK BIMCLOUD - BIMcloud\18155 90 Collins Street Melbourne\00 MODEL\00-CD\BIM MODEL\18155 General

REVISION	REVISION
01 TOWN PLANNING ISSUE 01	WTK 16.12.2021
02 TOWN PLANNING SUBMISSION 02	WTK 10.06.2022
03 TOWN PLANNING SUBMISSION 03	WTK 15.07.2022

**QUALITY ASSURANCE** (FK IS A CERTIFIED COMPANY TO ISO 9001:2015)

THIS PROJECT IS SUBJECT TO THE FK QUALITY ASSURANCE SYSTEM

- SCHEMATIC DESIGN REVIEW FOR THIS PROJECT IS YET TO BE COMPLETED.
- DESIGN DEVELOPMENT REVIEW FOR THIS PROJECT IS YET TO BE COMPLETED.
- TENDER DOCUMENTATION REVIEW FOR THIS PROJECT IS YET TO BE COMPLETED.
- CONSTRUCTION DOCUMENTATION REVIEW FOR THIS DRAWING IS YET TO BE COMPLETED.

IF THIS DRAWING IS STAMPED UNCONTROLLED COPY THEN IT IS TO BE CONSIDERED A DRAFT. SUBJECT TO REVISION WITHOUT NOTICE

**NOTES**

THIS DRAWING IS COPYRIGHT AND SHALL REMAIN THE PROPERTY OF FENDER KATSALIDIS (AUST) PTY LTD. CHECK AND VERIFY ALL DIMENSIONS ON SITE PRIOR TO COMMENCING WORK. DRAWING TO BE READ IN CONJUNCTION WITH ALL OTHER CONTRACT DOCUMENTS. DO NOT SCALE DRAWINGS. USE FIGURED DIMENSIONS ONLY. SEEK CLARIFICATION OF INCONSISTENCIES / CONFLICTS.

DRAWN	DATE	CHECKED	PLOT DATE	JOB NO.	SCALE
WTK	15.07.2022	JV	21.07.2022	18155	1:100@A1

**PROJECT**

90 COLLINS REDEVELOPMENT  
90 COLLINS STREET  
MELBOURNE VIC 3000



**FENDER KATSALIDIS**  
WWW.FKAUSTRALIA.COM  
2 RIVERSIDE QUAY, SOUTH BANK  
VICTORIA 3006 AUSTRALIA  
TELEPHONE: +61 3 8696 3888  
FENDER KATSALIDIS (AUST) PTY LTD ACN 092 943 032



**DRAWING TITLE**



PROPOSED LEVEL 22 FLOOR PLAN

**ISSUE PURPOSE**

TOWN PLANNING

**REV.** 02 **DRAWING NO.** TP322



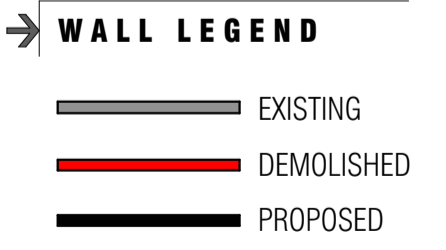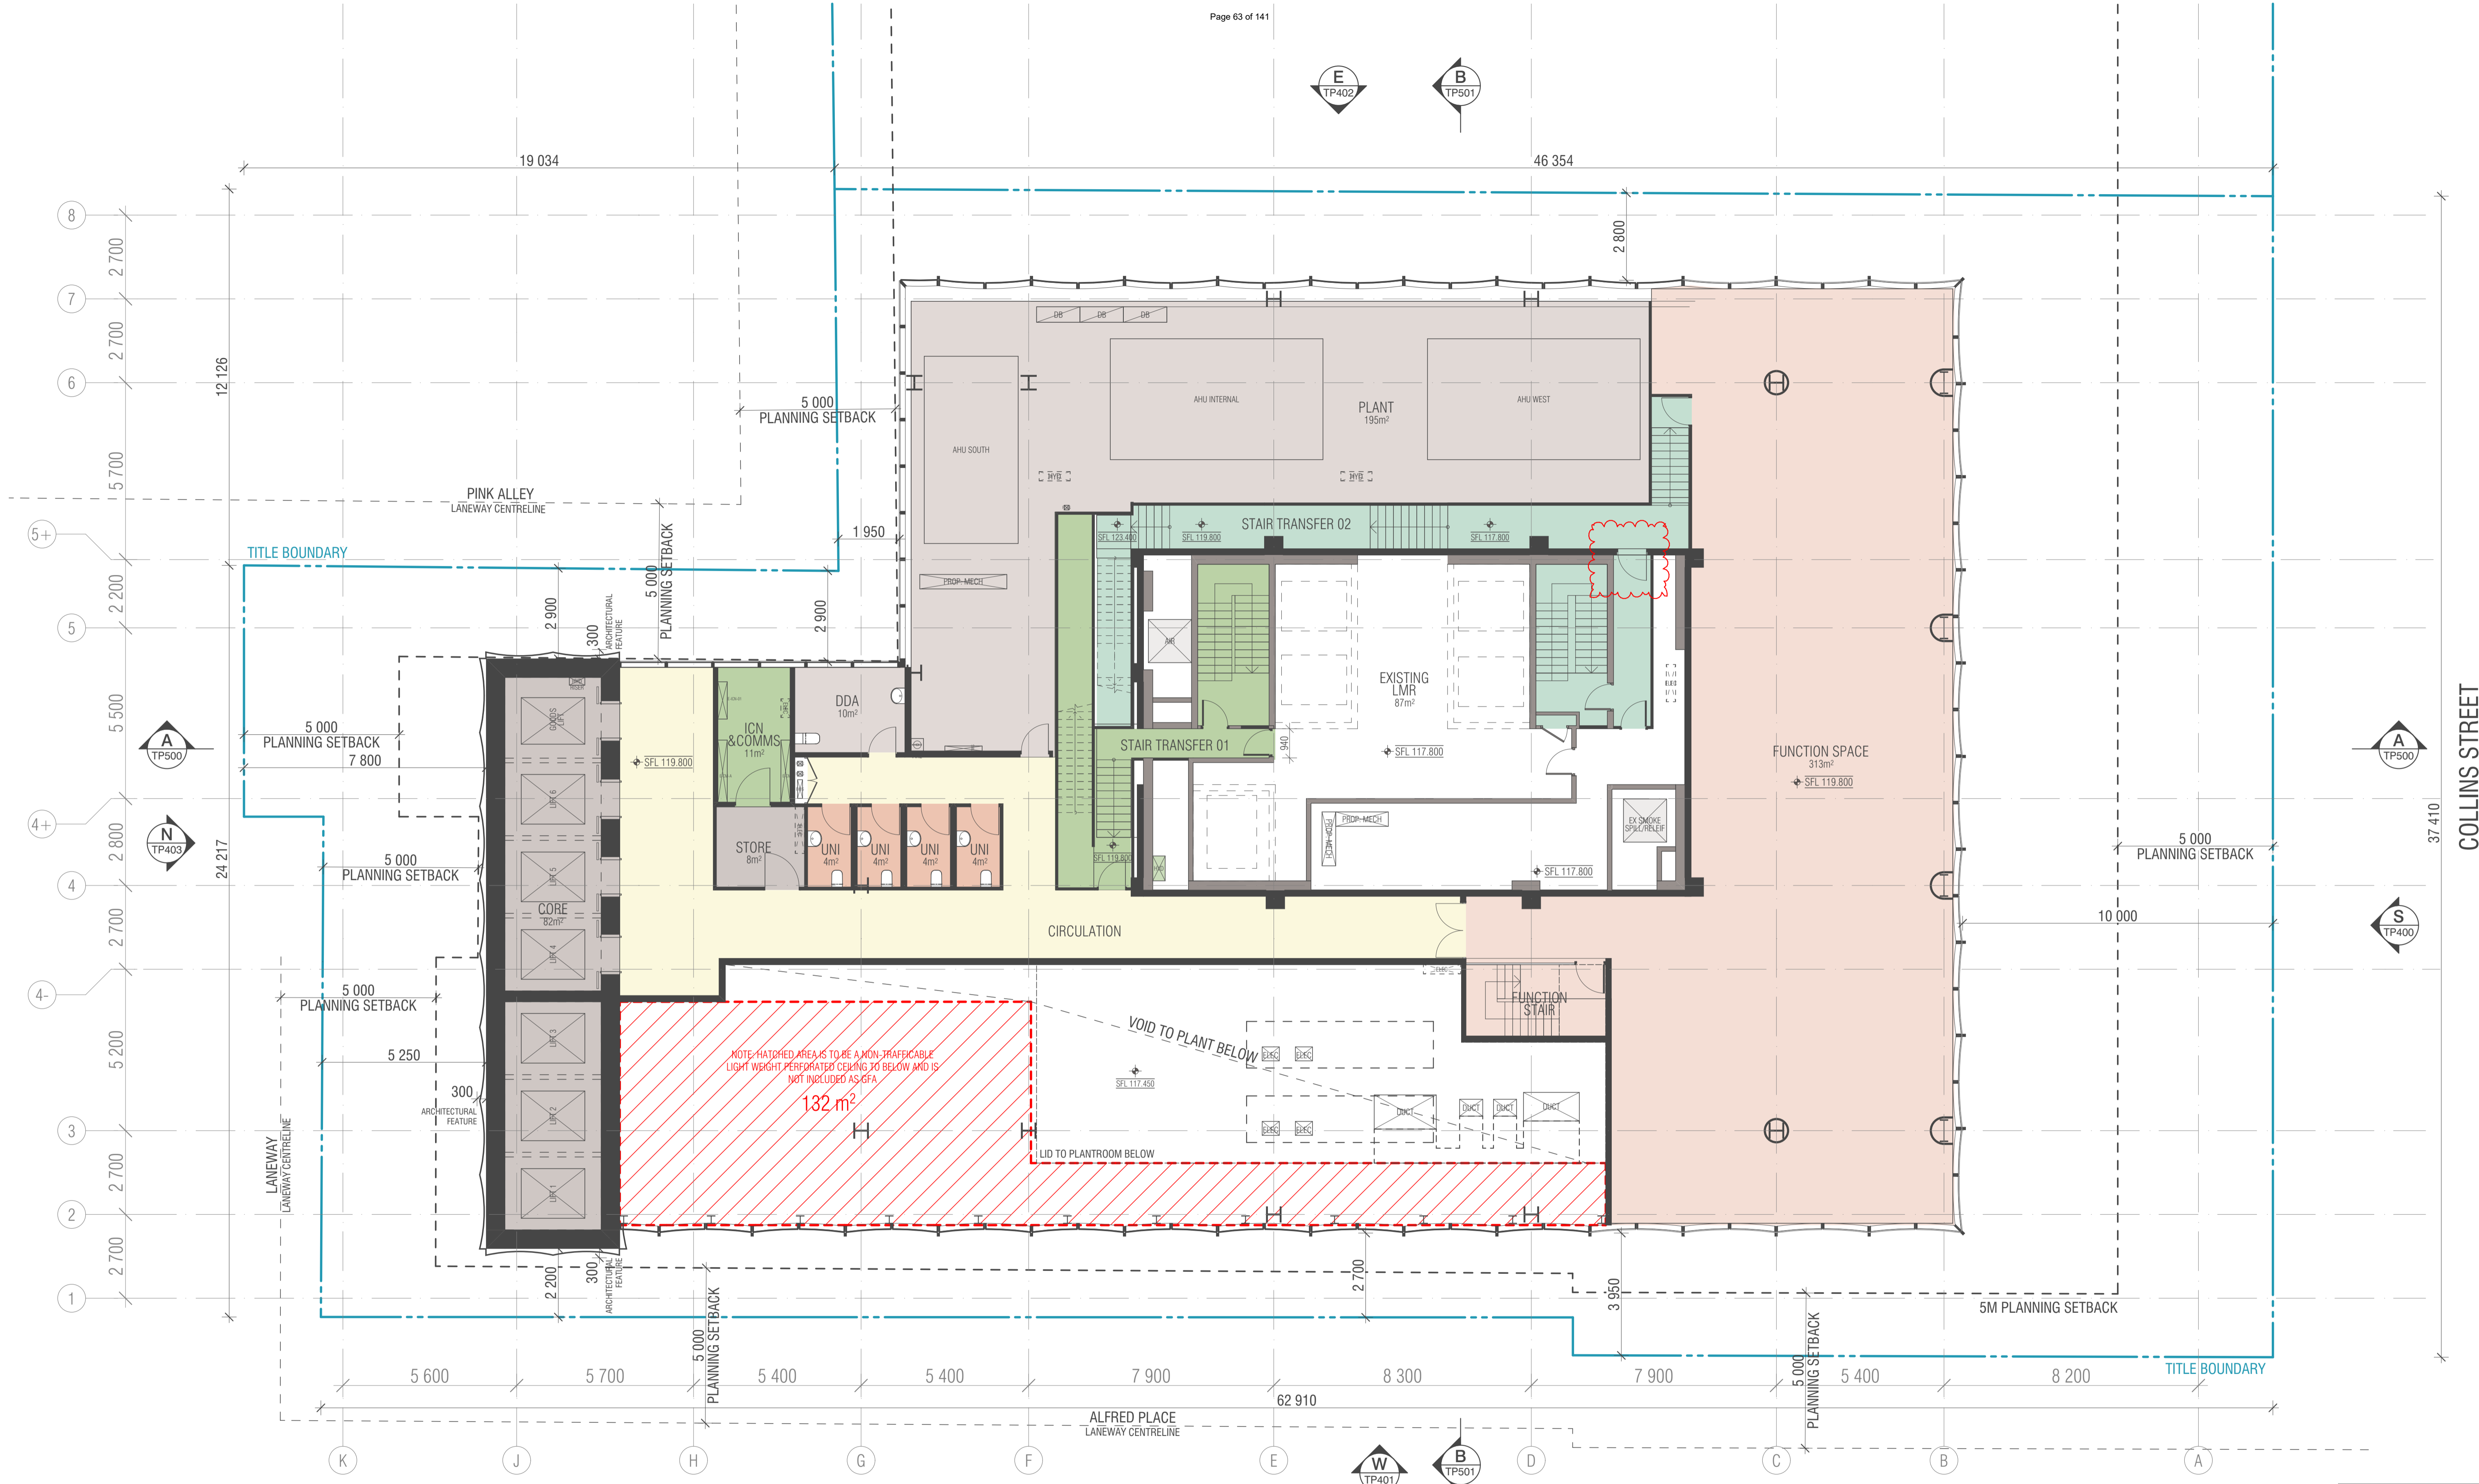

BIMcloud: FK BIMCLOUD - BIMcloud\18155 90 Collins Street Melbourne\00 MODEL\00 - CD\BIM MODEL\18155 General

REVISION	REVISION
01 TOWN PLANNING ISSUE 01	WTK 16.12.2021
02 TOWN PLANNING SUBMISSION 02	WTK 10.06.2022
03 TOWN PLANNING SUBMISSION 03	WTK 15.07.2022

**QUALITY ASSURANCE** (FK IS A CERTIFIED COMPANY TO ISO 9001:2015)  
 THIS PROJECT IS SUBJECT TO THE FK QUALITY ASSURANCE SYSTEM

- SCHEMATIC DESIGN REVIEW FOR THIS PROJECT IS YET TO BE COMPLETED.
- DESIGN DEVELOPMENT REVIEW FOR THIS PROJECT IS YET TO BE COMPLETED.
- TENDER DOCUMENTATION REVIEW FOR THIS PROJECT IS YET TO BE COMPLETED.
- CONSTRUCTION DOCUMENTATION REVIEW FOR THIS DRAWING IS YET TO BE COMPLETED.

IF THIS DRAWING IS STAMPED UNCONTROLLED COPY THEN IT IS TO BE CONSIDERED A DRAFT. SUBJECT TO REVISION WITHOUT NOTICE

**NOTES**  
 THIS DRAWING IS COPYRIGHT AND SHALL REMAIN THE PROPERTY OF FENDER KATSALIDIS (AUST) PTY LTD  
 CHECK AND VERIFY ALL DIMENSIONS ON SITE PRIOR TO COMMENCING WORK. DRAWING TO BE READ IN CONJUNCTION WITH ALL OTHER CONTRACT DOCUMENTS. DO NOT SCALE DRAWINGS. USE FIGURED DIMENSIONS ONLY. SEEK CLARIFICATION OF INCONSISTENCIES / CONFLICTS.

DRAWN	DATE	CHECKED	PLOT DATE	JOB NO.	SCALE
WTK	15.07.2022	JV	21.07.2022	18155	1:100@A1

**PROJECT**  
 90 COLLINS REDEVELOPMENT  
 90 COLLINS STREET  
 MELBOURNE VIC 3000





**FENDER KATSALIDIS**  
 WWW.FKAUSTRALIA.COM  
 2 RIVERSIDE QUAY, SOUTH BANK  
 VICTORIA 3006 AUSTRALIA  
 TELEPHONE: +61 3 8696 3888  
 FENDER KATSALIDIS (AUST) PTY LTD ACN 092 943 032



**DRAWING TITLE**  
 PROPOSED LEVEL 23 TRANSFER FLOOR PLAN

**ISSUE PURPOSE**  
 TOWN PLANNING

**REV.** 02  
**DRAWING NO.** TP323

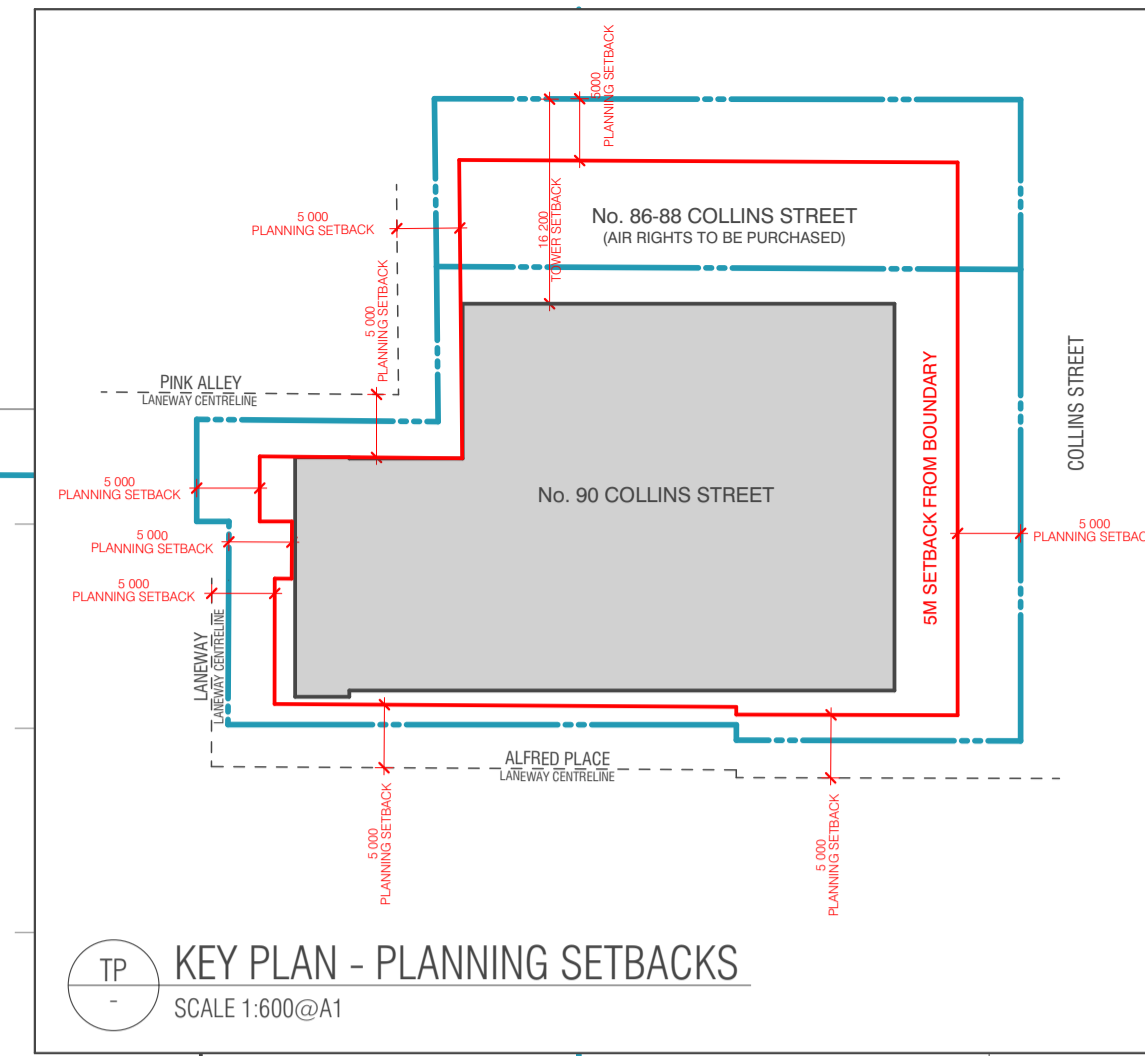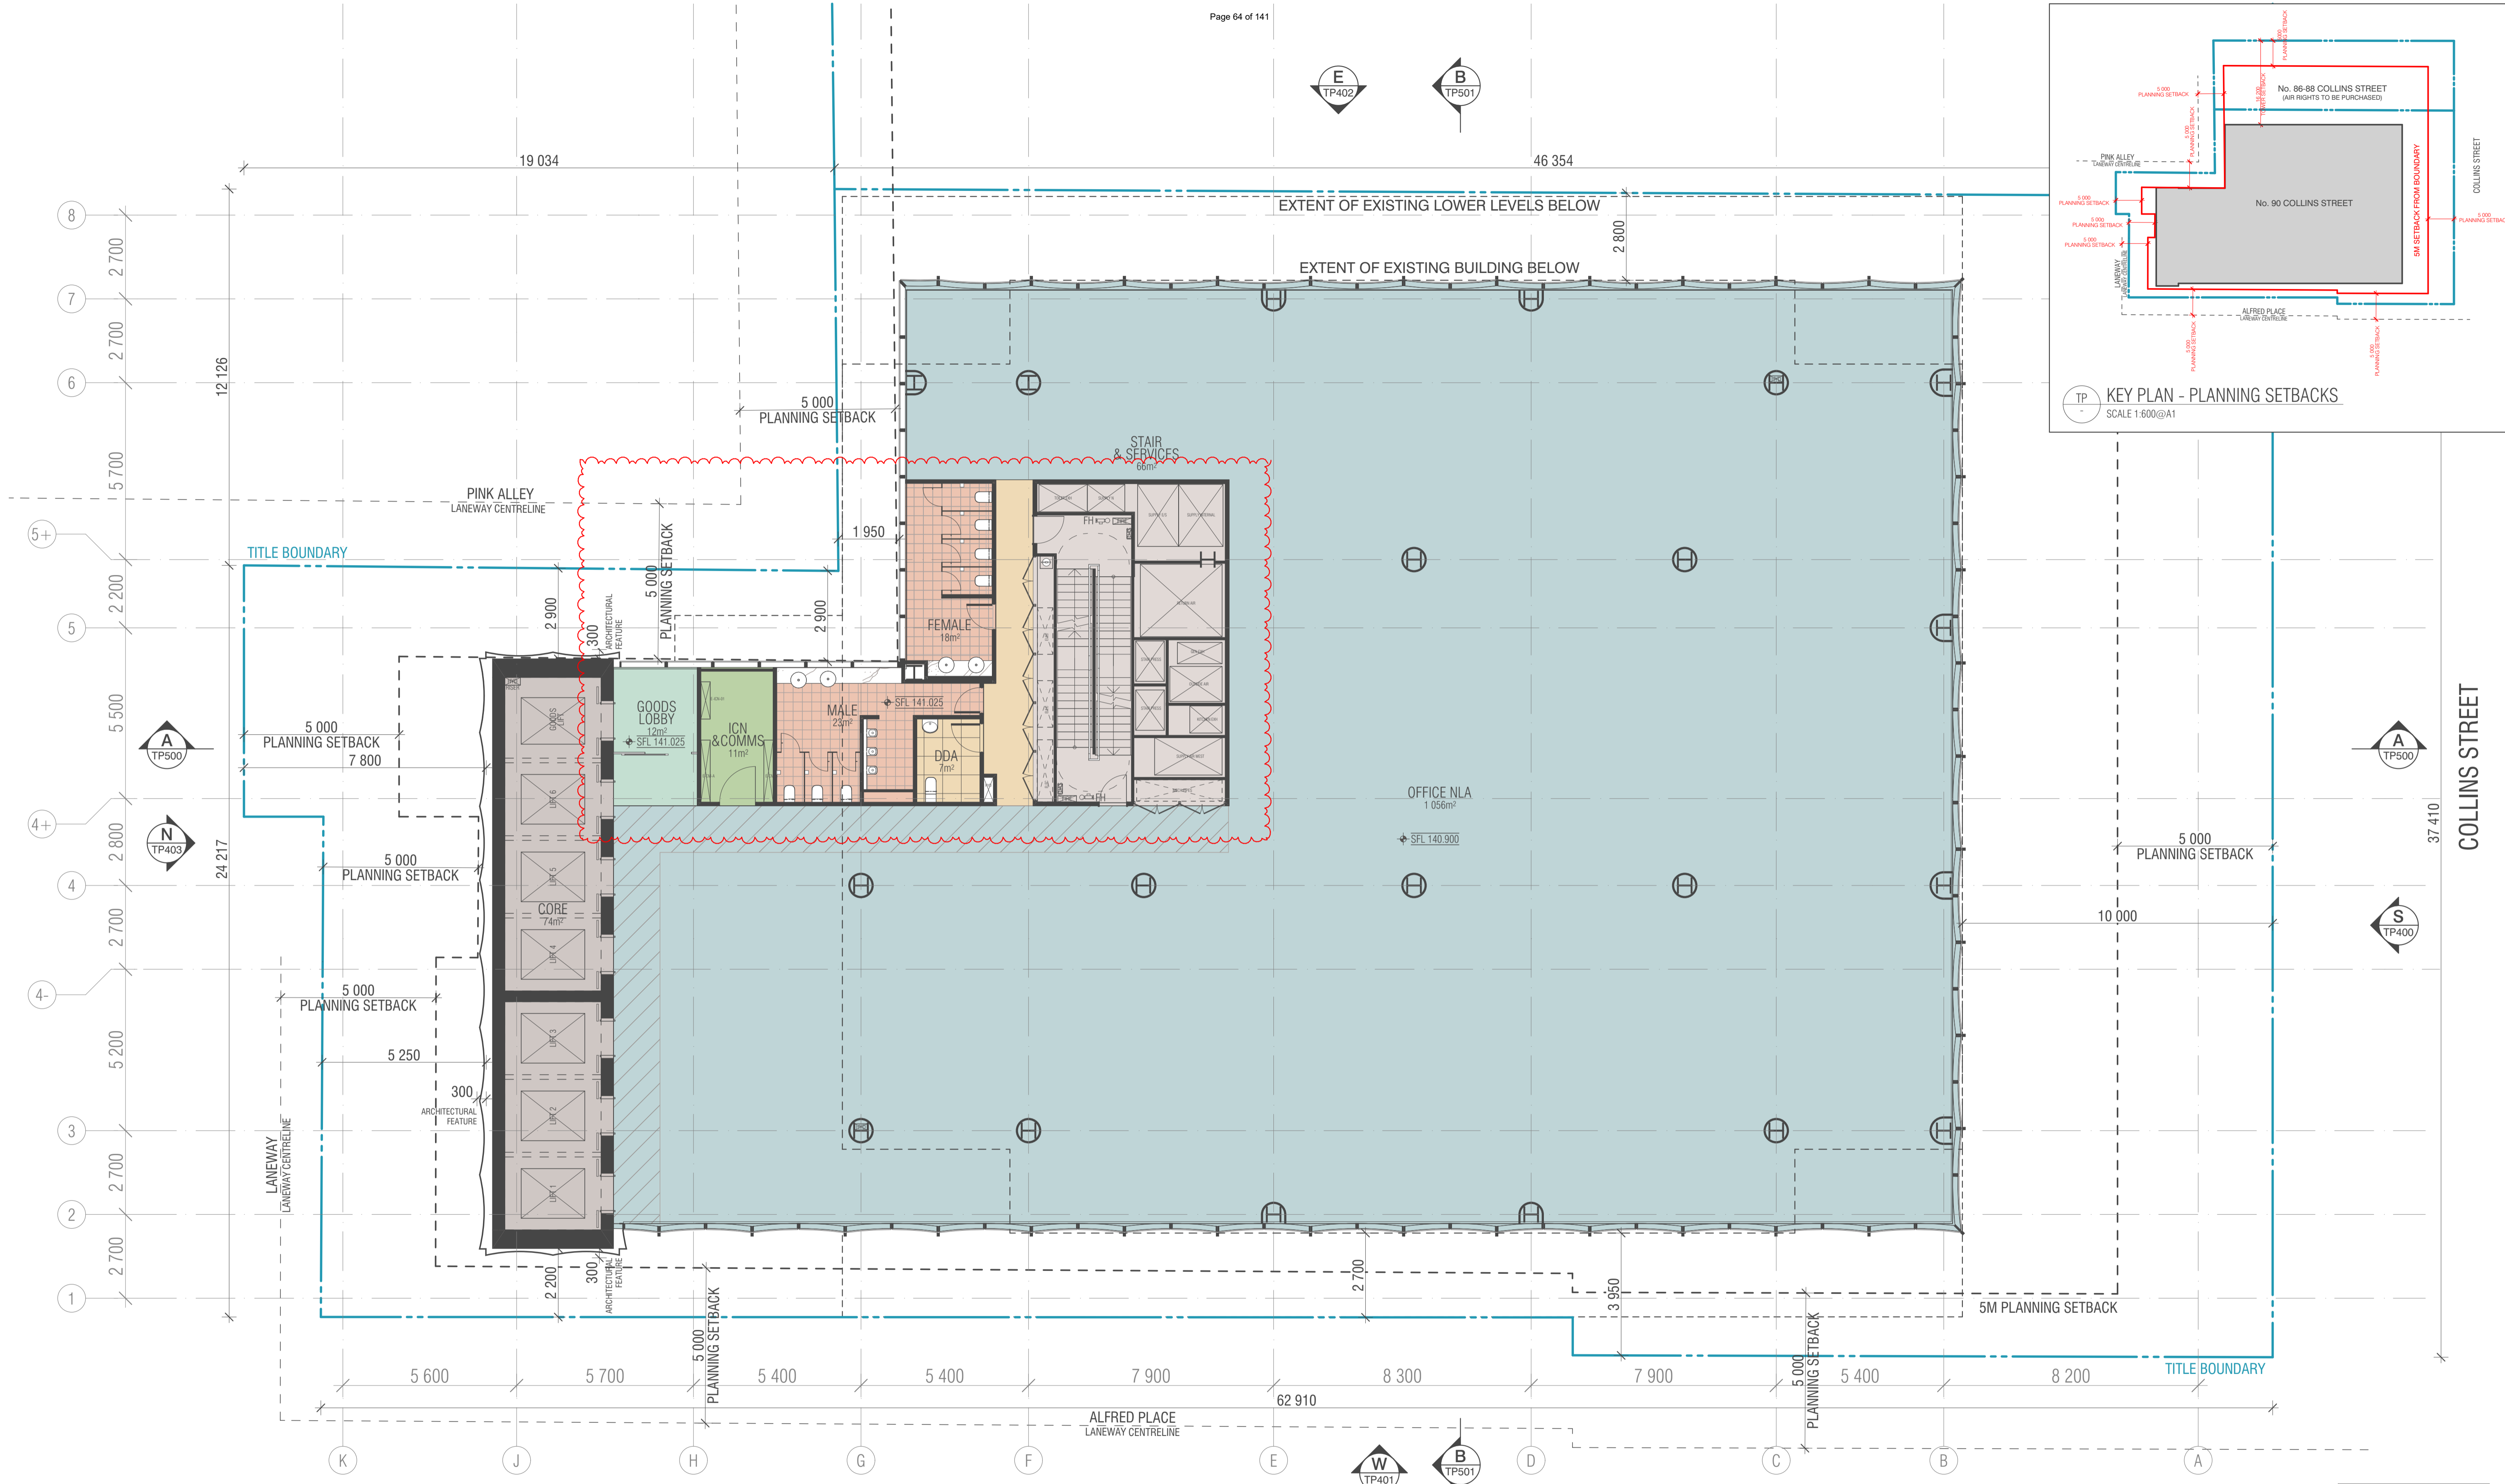

**WALL LEGEND**

	EXISTING
	DEMOLISHED
	PROPOSED

BIMcloud: FK8IMCLOUD - BIMcloud\18155 90 Collins Street Melbourne\00 MODEL\00 - CD\BIM MODEL\18155 General

REVISION	DATE	BY
> 01	16.12.2021	WTK
> 02	10.06.2022	WTK


REVISION	DATE	BY
> 01	16.12.2021	WTK
> 02	10.06.2022	WTK

**QUALITY ASSURANCE** (FK IS A CERTIFIED COMPANY TO ISO 9001:2015)  
 THIS PROJECT IS SUBJECT TO THE FK QUALITY ASSURANCE SYSTEM

- SCHEMATIC DESIGN REVIEW FOR THIS PROJECT IS YET TO BE COMPLETED.
- DESIGN DEVELOPMENT REVIEW FOR THIS PROJECT IS YET TO BE COMPLETED.
- TENDER DOCUMENTATION REVIEW FOR THIS PROJECT IS YET TO BE COMPLETED.
- CONSTRUCTION DOCUMENTATION REVIEW FOR THIS DRAWING IS YET TO BE COMPLETED.

IF THIS DRAWING IS STAMPED UNCONTROLLED COPY THEN IT IS TO BE CONSIDERED A DRAFT. SUBJECT TO REVISION WITHOUT NOTICE

**NOTES**  
 THIS DRAWING IS COPYRIGHT AND SHALL REMAIN THE PROPERTY OF FENDER KATSALIDIS (AUST) PTY LTD  
 CHECK AND VERIFY ALL DIMENSIONS ON SITE PRIOR TO COMMENCING WORK. DRAWING TO BE READ IN CONJUNCTION WITH ALL OTHER CONTRACT DOCUMENTS. DO NOT SCALE DRAWINGS. USE FIGURED DIMENSIONS ONLY. SEEK CLARIFICATION OF INCONSISTENCIES / CONFLICTS.

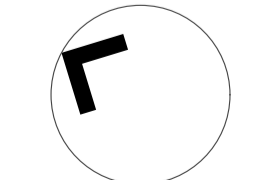

**PROJECT**  
 90 COLLINS REDEVELOPMENT  
 90 COLLINS STREET  
 MELBOURNE VIC 3000



**FENDER KATSALIDIS**  
 WWW.FKAUSTRALIA.COM  
 2 RIVERSIDE QUAY, SOUTH BANK  
 VICTORIA 3006 AUSTRALIA  
 TELEPHONE: +61 3 8696 3888  
 FENDER KATSALIDIS (AUST) PTY LTD ACN 092 943 032





DRAWN	DATE	CHECKED	PLOT DATE	JOB NO.	SCALE
WTK	10.06.2022	JV	21.07.2022	18155	1:100@A1

**DRAWING TITLE**  
 PROPOSED LEVEL 24-37 TYPICAL FLOOR PLAN

**ISSUE PURPOSE**  
 TOWN PLANNING

**REV.** 01 **DRAWING NO.** TP324



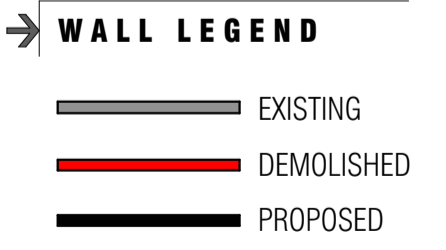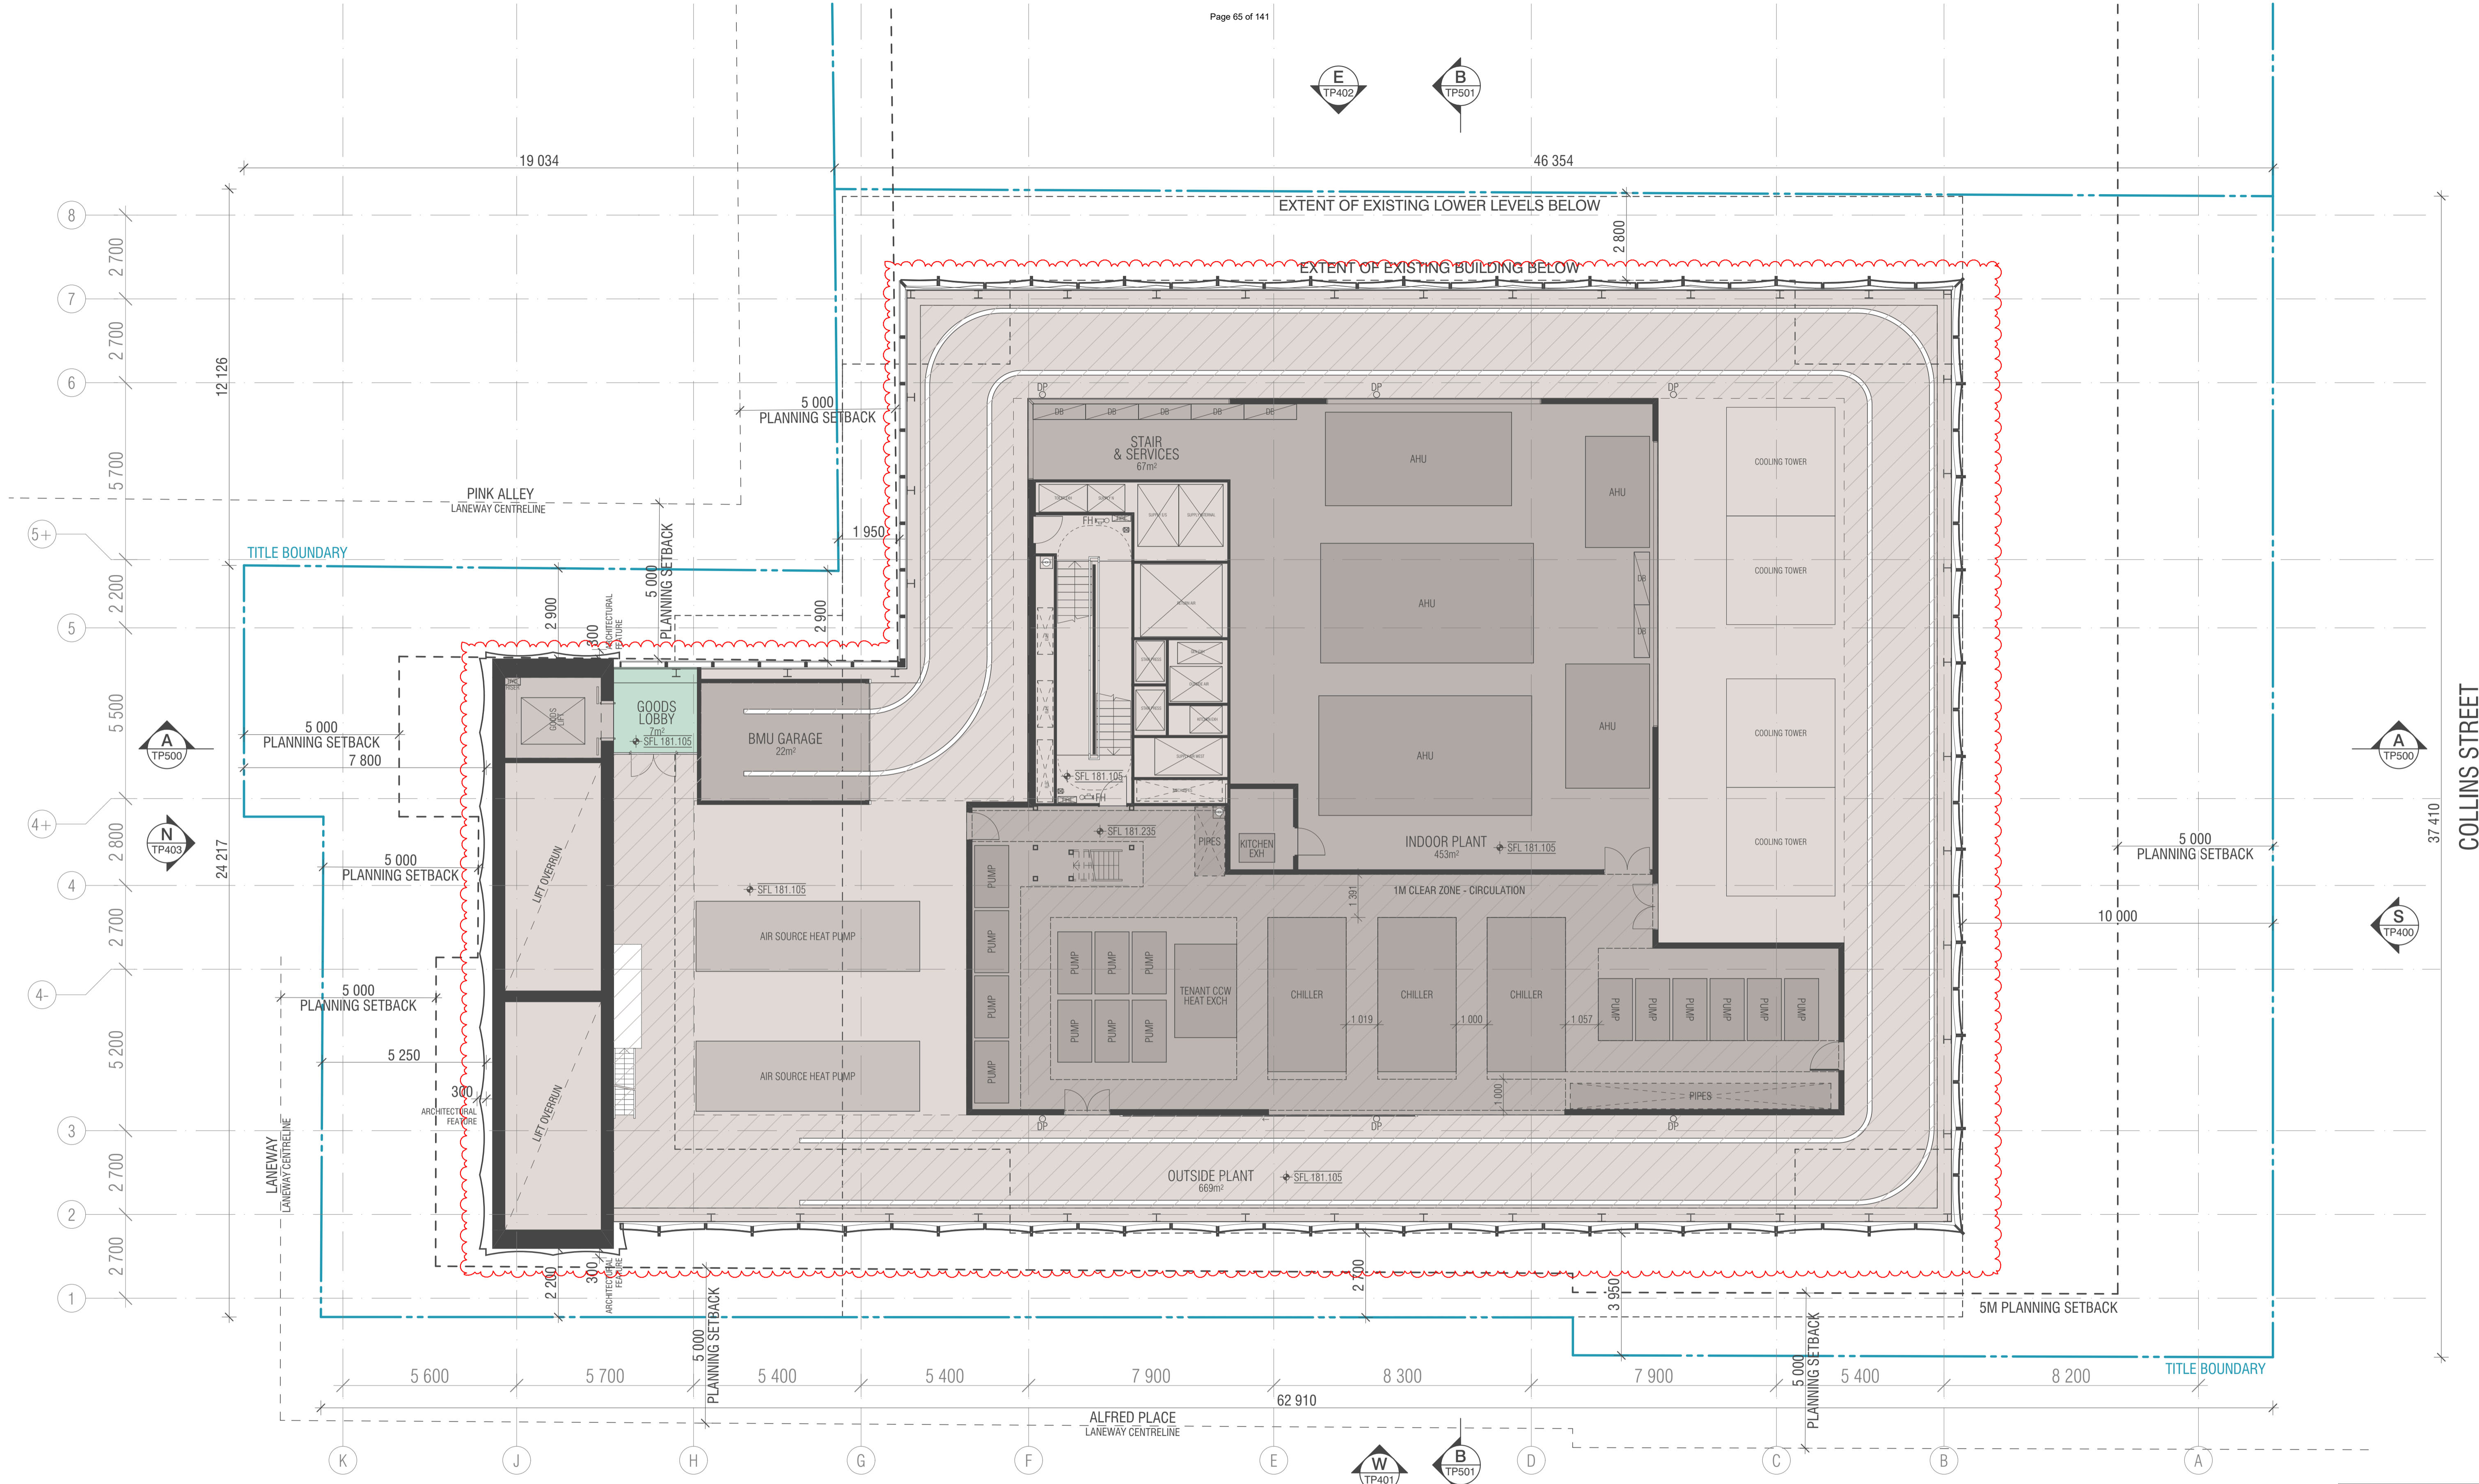

BIMcloud: FK BIMCLOUD - BIMcloud\18155 90 Collins Street Melbourne\00 MODEL\00-CD\BIM MODEL\18155 General

REVISION	DESCRIPTION	DATE
01	TOWN PLANNING ISSUE 01	16.12.2021
02	TOWN PLANNING SUBMISSION 02	10.06.2022
03	TOWN PLANNING SUBMISSION 03	15.07.2022

REVISION	DESCRIPTION	DATE
01	TOWN PLANNING ISSUE 01	16.12.2021
02	TOWN PLANNING SUBMISSION 02	10.06.2022
03	TOWN PLANNING SUBMISSION 03	15.07.2022

**QUALITY ASSURANCE** (FK IS A CERTIFIED COMPANY TO ISO 9001:2015)

THIS PROJECT IS SUBJECT TO THE FK QUALITY ASSURANCE SYSTEM

- SCHEMATIC DESIGN REVIEW FOR THIS PROJECT IS YET TO BE COMPLETED.
- DESIGN DEVELOPMENT REVIEW FOR THIS PROJECT IS YET TO BE COMPLETED.
- TENDER DOCUMENTATION REVIEW FOR THIS PROJECT IS YET TO BE COMPLETED.
- CONSTRUCTION DOCUMENTATION REVIEW FOR THIS DRAWING IS YET TO BE COMPLETED.

IF THIS DRAWING IS STAMPED UNCONTROLLED COPY THEN IT IS TO BE CONSIDERED A DRAFT. SUBJECT TO REVISION WITHOUT NOTICE

**NOTES**

THIS DRAWING IS COPYRIGHT AND SHALL REMAIN THE PROPERTY OF FENDER KATSALIDIS (AUST) PTY LTD. CHECK AND VERIFY ALL DIMENSIONS ON SITE PRIOR TO COMMENCING WORK. DRAWING TO BE READ IN CONJUNCTION WITH ALL OTHER CONTRACT DOCUMENTS. DO NOT SCALE DRAWINGS. USE FIGURED DIMENSIONS ONLY. SEEK CLARIFICATION OF INCONSISTENCIES / CONFLICTS.


DRAWN	DATE	CHECKED	PLOT DATE	JOB NO.	SCALE
WTK	15.07.2022	JV	21.07.2022	18155	1:100@A1

**PROJECT**


90 COLLINS REDEVELOPMENT  
90 COLLINS STREET  
MELBOURNE VIC 3000



**FENDER KATSALIDIS**  
WWW.FKAUSTRALIA.COM  
2 RIVERSIDE QUAY, SOUTH BANK  
VICTORIA 3006 AUSTRALIA  
TELEPHONE: +61 3 8696 3888  
FENDER KATSALIDIS (AUST) PTY LTD ACN 092 943 032

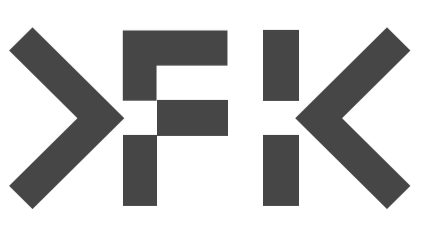

DRAWING TITLE	ISSUE PURPOSE	REV.	DRAWING NO.
PROPOSED LEVEL 38 ROOF PLANT	TOWN PLANNING	02	TP337

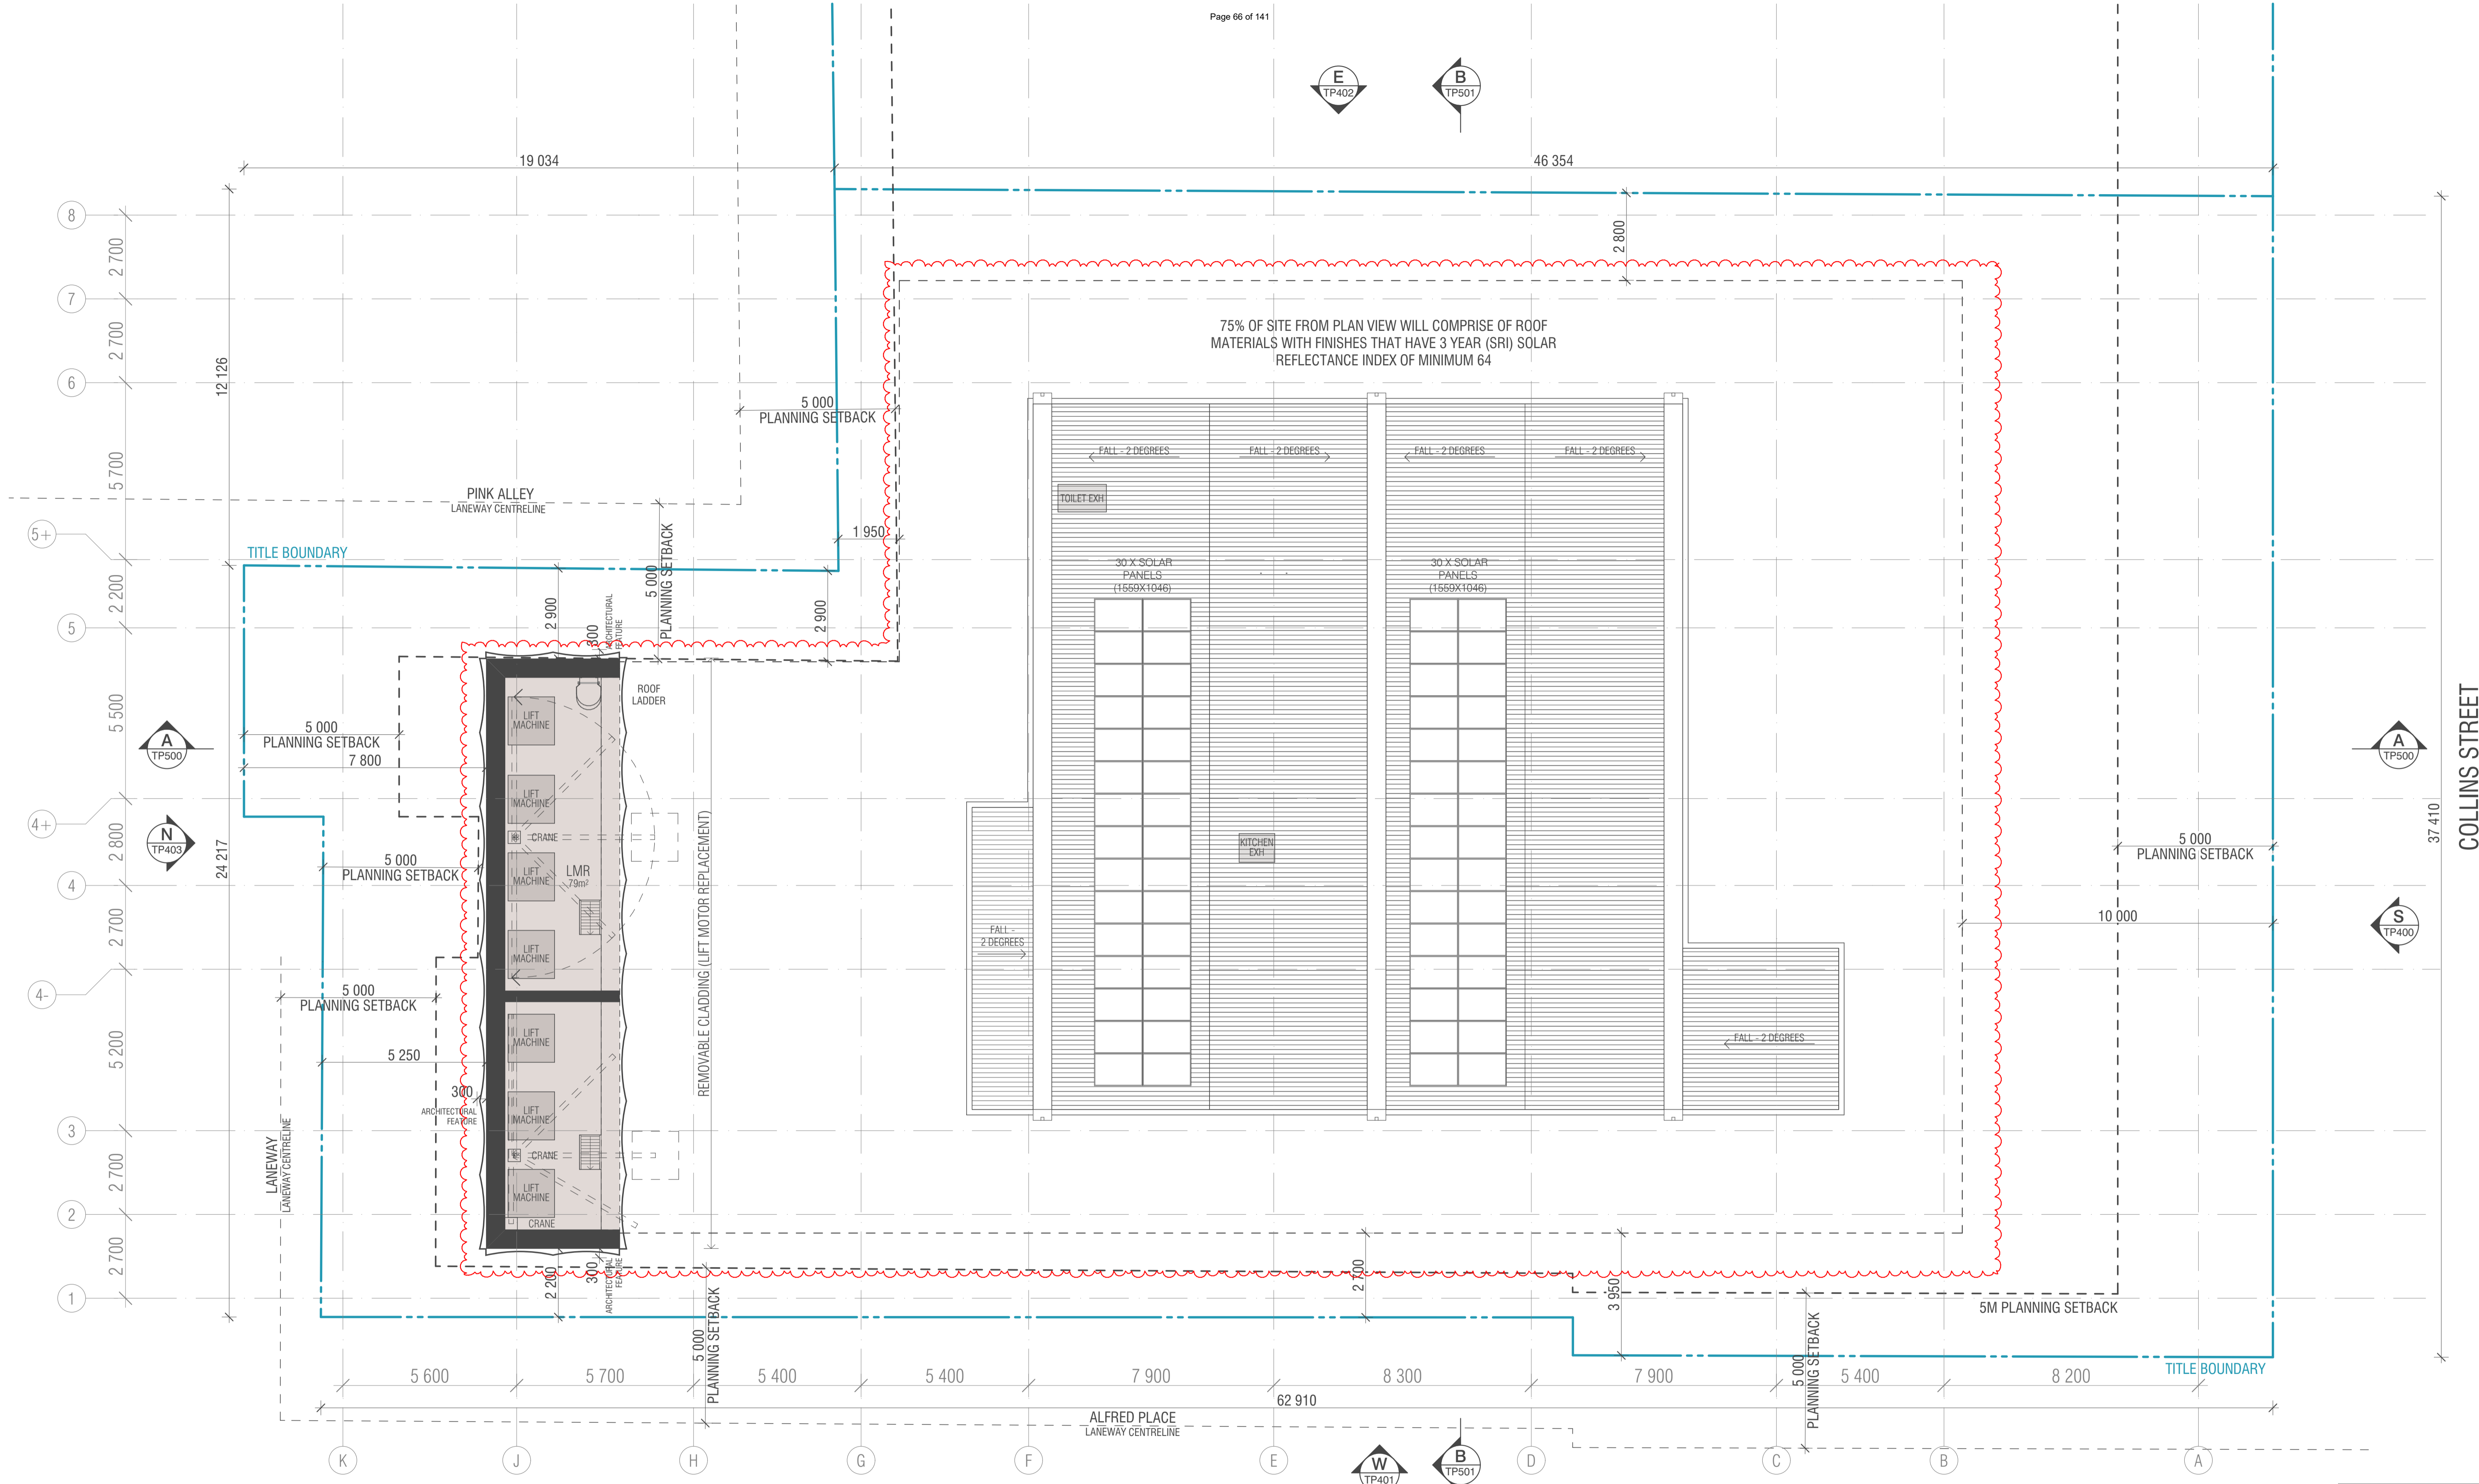

75% OF SITE FROM PLAN VIEW WILL COMPRISE OF ROOF MATERIALS WITH FINISHES THAT HAVE 3 YEAR (SRI) SOLAR REFLECTANCE INDEX OF MINIMUM 64

**WALL LEGEND**

- EXISTING
- DEMOLISHED
- PROPOSED

BIMcloud: FBIMCLOUD - BIMcloud\18155 90 Collins Street Melbourne\00 MODEL\00-CD\BIM MODEL\18155 General

REVISION	REVISION
01 TOWN PLANNING ISSUE 01	WTK 16.12.2021
02 TOWN PLANNING SUBMISSION 02	WTK 10.06.2022
03 TOWN PLANNING SUBMISSION 03	WTK 15.07.2022

**QUALITY ASSURANCE** (FK IS A CERTIFIED COMPANY TO ISO 9001:2015)

THIS PROJECT IS SUBJECT TO THE FK QUALITY ASSURANCE SYSTEM

- SCHEMATIC DESIGN REVIEW FOR THIS PROJECT IS YET TO BE COMPLETED.
- DESIGN DEVELOPMENT REVIEW FOR THIS PROJECT IS YET TO BE COMPLETED.
- TENDER DOCUMENTATION REVIEW FOR THIS PROJECT IS YET TO BE COMPLETED.
- CONSTRUCTION DOCUMENTATION REVIEW FOR THIS DRAWING IS YET TO BE COMPLETED.

IF THIS DRAWING IS STAMPED UNCONTROLLED COPY THEN IT IS TO BE CONSIDERED A DRAFT. SUBJECT TO REVISION WITHOUT NOTICE

**NOTES**

THIS DRAWING IS COPYRIGHT AND SHALL REMAIN THE PROPERTY OF FENDER KATSALIDIS (AUST) PTY LTD. CHECK AND VERIFY ALL DIMENSIONS ON SITE PRIOR TO COMMENCING WORK. DRAWING TO BE READ IN CONJUNCTION WITH ALL OTHER CONTRACT DOCUMENTS. DO NOT SCALE DRAWINGS. USE FIGURED DIMENSIONS ONLY. SEEK CLARIFICATION OF INCONSISTENCIES / CONFLICTS.

DRAWN	DATE	CHECKED	PLOT DATE	JOB NO.	SCALE
WTK	15.07.2022	JV	21.07.2022	18155	1:100@A1

**PROJECT**

90 COLLINS REDEVELOPMENT  
90 COLLINS STREET  
MELBOURNE VIC 3000



**FENDER KATSALIDIS**  
WWW.FKAUSTRALIA.COM  
2 RIVERSIDE QUAY, SOUTHBANK  
VICTORIA 3006 AUSTRALIA  
TELEPHONE: +61 3 8696 3888  
FENDER KATSALIDIS (AUST) PTY LTD ACN 092 943 032



**DRAWING TITLE**


PROPOSED LEVEL 39 LIFT MOTOR ROOM

**ISSUE PURPOSE**

TOWN PLANNING

**REV.** 02 **DRAWING NO.** TP339



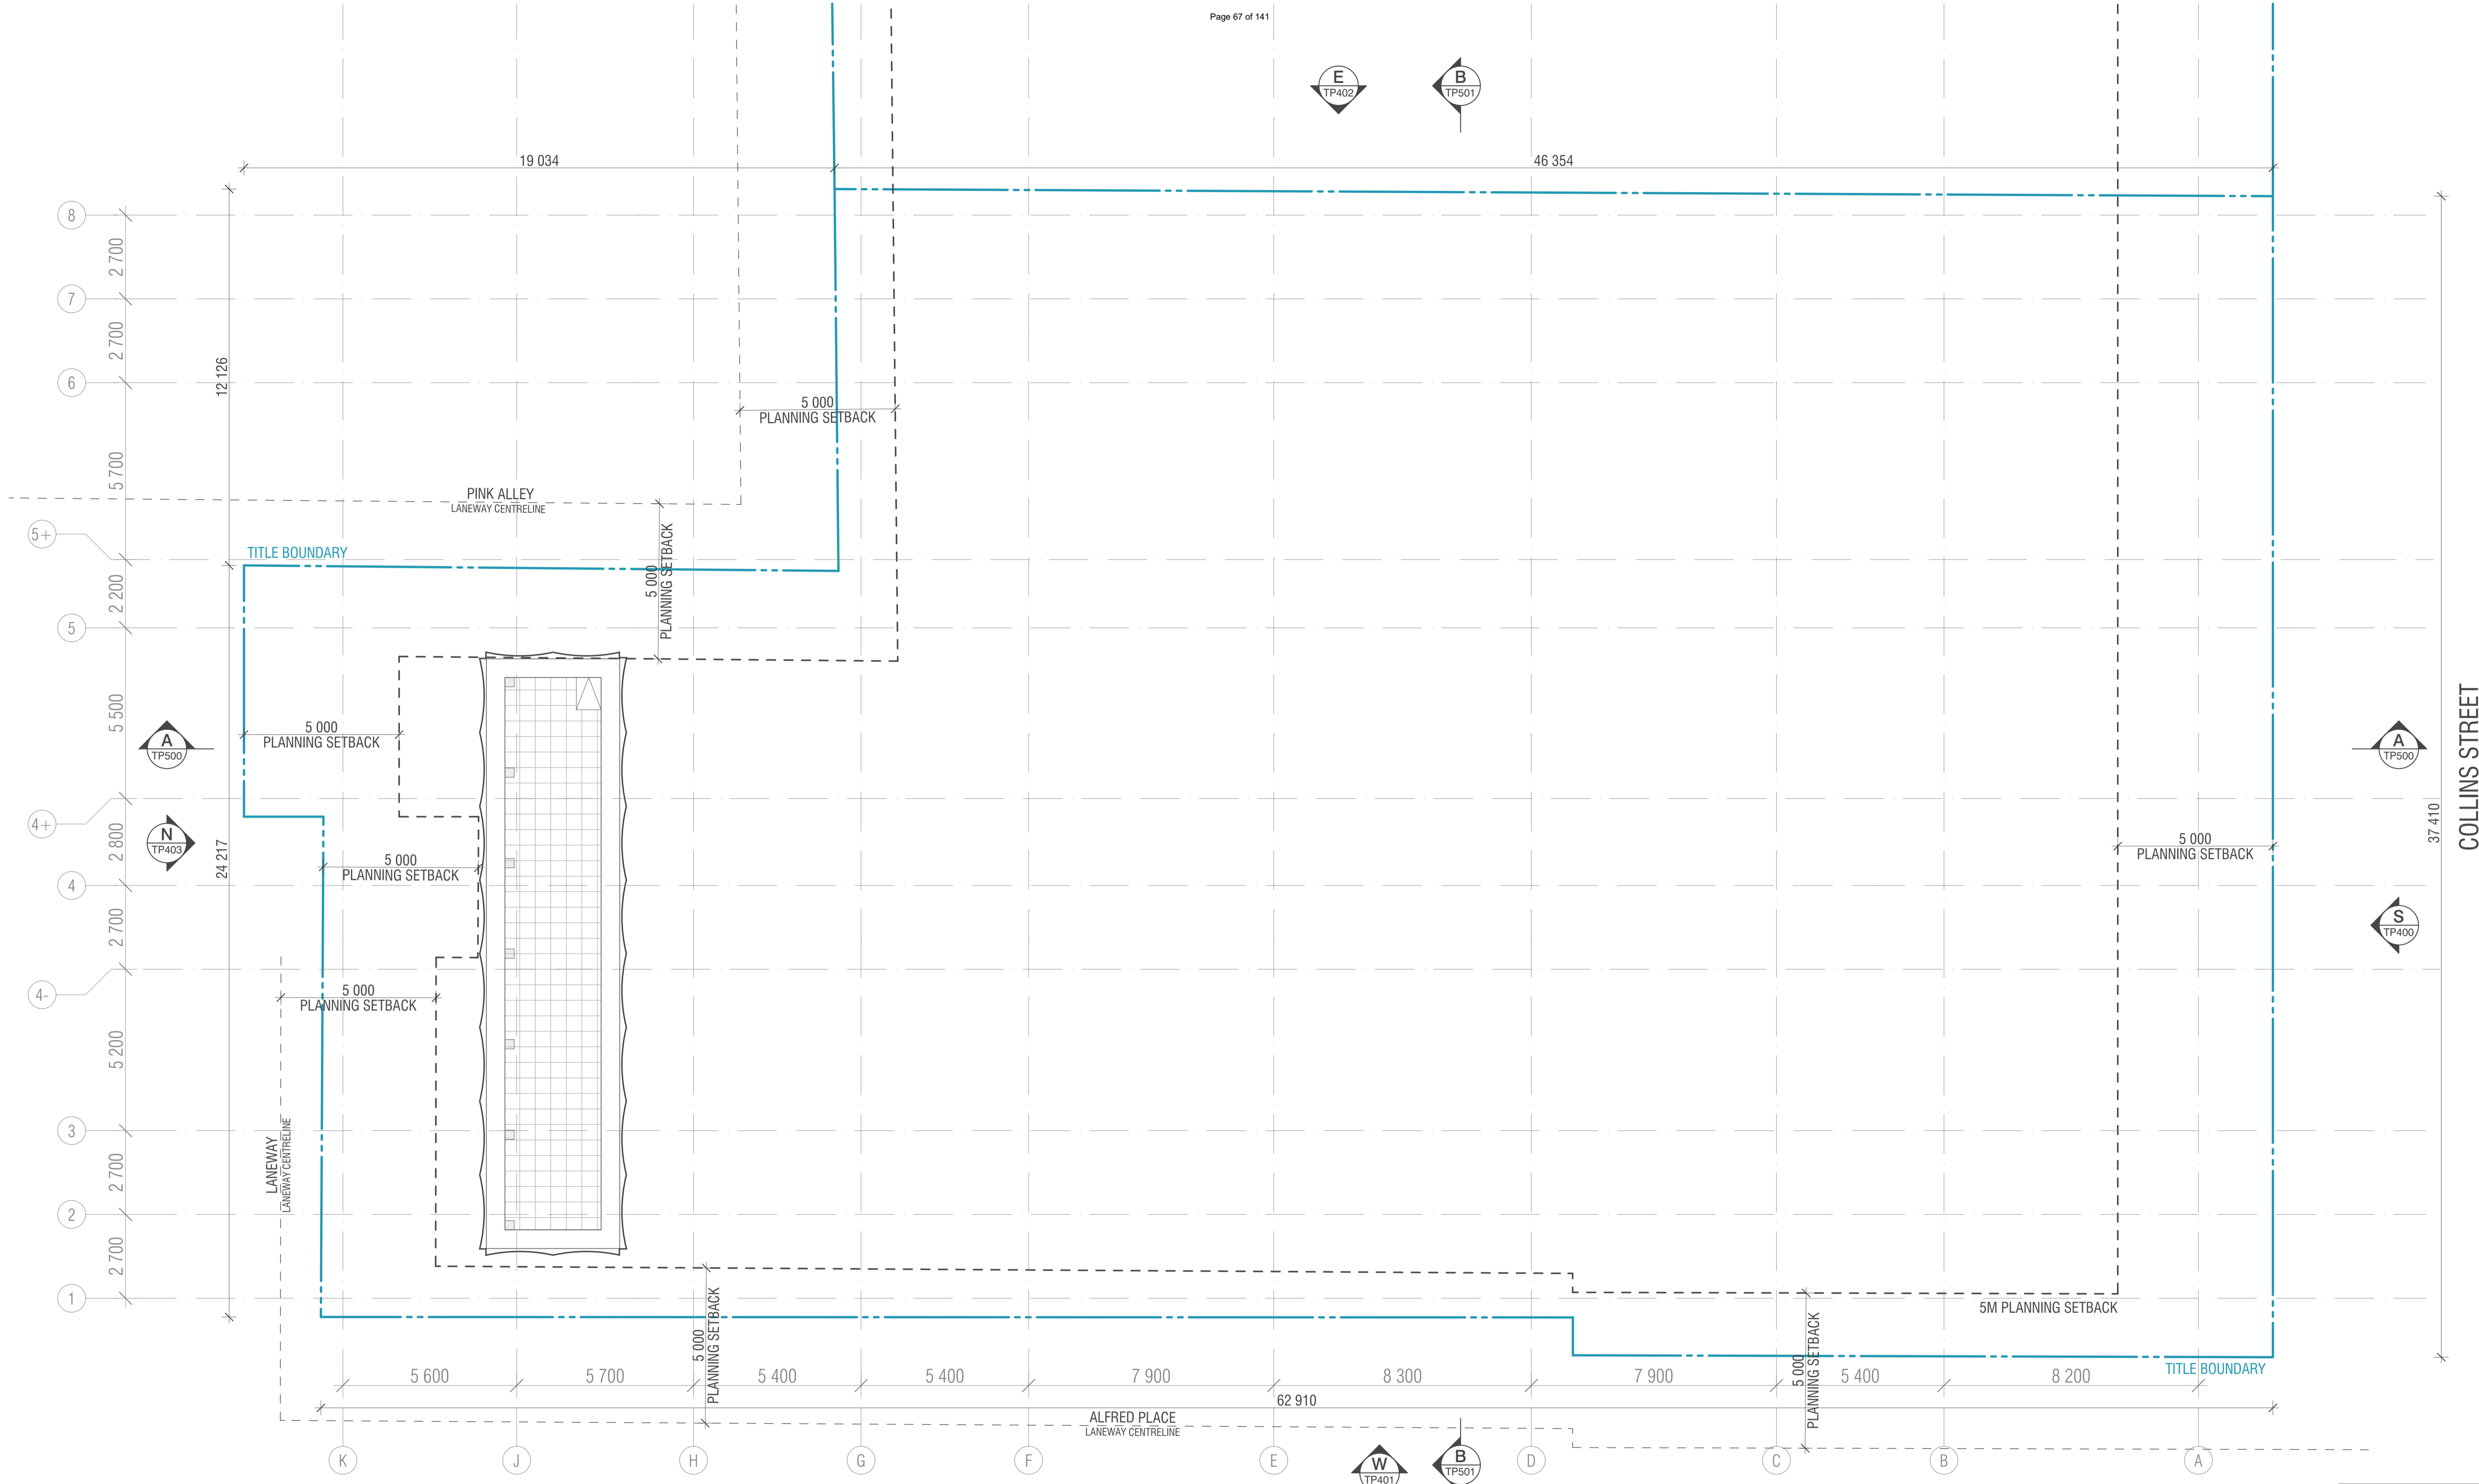

**WALL LEGEND**

- EXISTING
- DEMOLISHED
- PROPOSED

BIMcloud: FK BIMCLOUD - BIMcloud\18155 90 Collins Street Melbourne\00 MODEL\00 - CD\BIM MODEL\18155 General

REVISION	REVISION
TOWN PLANNING SUBMISSION 02	WTK 10.06.2022

**QUALITY ASSURANCE** (FK IS A CERTIFIED COMPANY TO ISO 9001:2015)

THIS PROJECT IS SUBJECT TO THE FK QUALITY ASSURANCE SYSTEM

- SCHEMATIC DESIGN REVIEW FOR THIS PROJECT IS YET TO BE COMPLETED.
- DESIGN DEVELOPMENT REVIEW FOR THIS PROJECT IS YET TO BE COMPLETED.
- TENDER DOCUMENTATION REVIEW FOR THIS PROJECT IS YET TO BE COMPLETED.
- CONSTRUCTION DOCUMENTATION REVIEW FOR THIS DRAWING IS YET TO BE COMPLETED.

IF THIS DRAWING IS STAMPED UNCONTROLLED COPY THEN IT IS TO BE CONSIDERED A DRAFT. SUBJECT TO REVISION WITHOUT NOTICE

**NOTES**

THIS DRAWING IS COPYRIGHT AND SHALL REMAIN THE PROPERTY OF FENDER KATSAIDIS (AUST) PTY LTD. CHECK AND VERIFY ALL DIMENSIONS ON SITE PRIOR TO COMMENCING WORK. DRAWING TO BE READ IN CONJUNCTION WITH ALL OTHER CONTRACT DOCUMENTS. DO NOT SCALE DRAWINGS. USE FIGURED DIMENSIONS ONLY. SEEK CLARIFICATION OF INCONSISTENCIES / CONFLICTS.

DRAWN	DATE	CHECKED	PLOT DATE	JOB NO.	SCALE
WTK	10.06.2022	JV	21.07.2022	18155	1:100@A1

**PROJECT**

90 COLLINS REDEVELOPMENT  
90 COLLINS STREET  
MELBOURNE VIC 3000



**FENDER KATSAIDIS**  
WWW.FKAUSTRALIA.COM  
2 RIVERSIDE QUAY, SOUTH BANK  
VICTORIA 3006 AUSTRALIA  
TELEPHONE: +61 3 8696 3888  
FENDER KATSAIDIS (AUST) PTY LTD ACN 092 943 032



**DRAWING TITLE**

PROPOSED CORE ROOF PLAN


**ISSUE PURPOSE**

TOWN PLANNING


**REV.** **DRAWING NO.**

- **TP340**



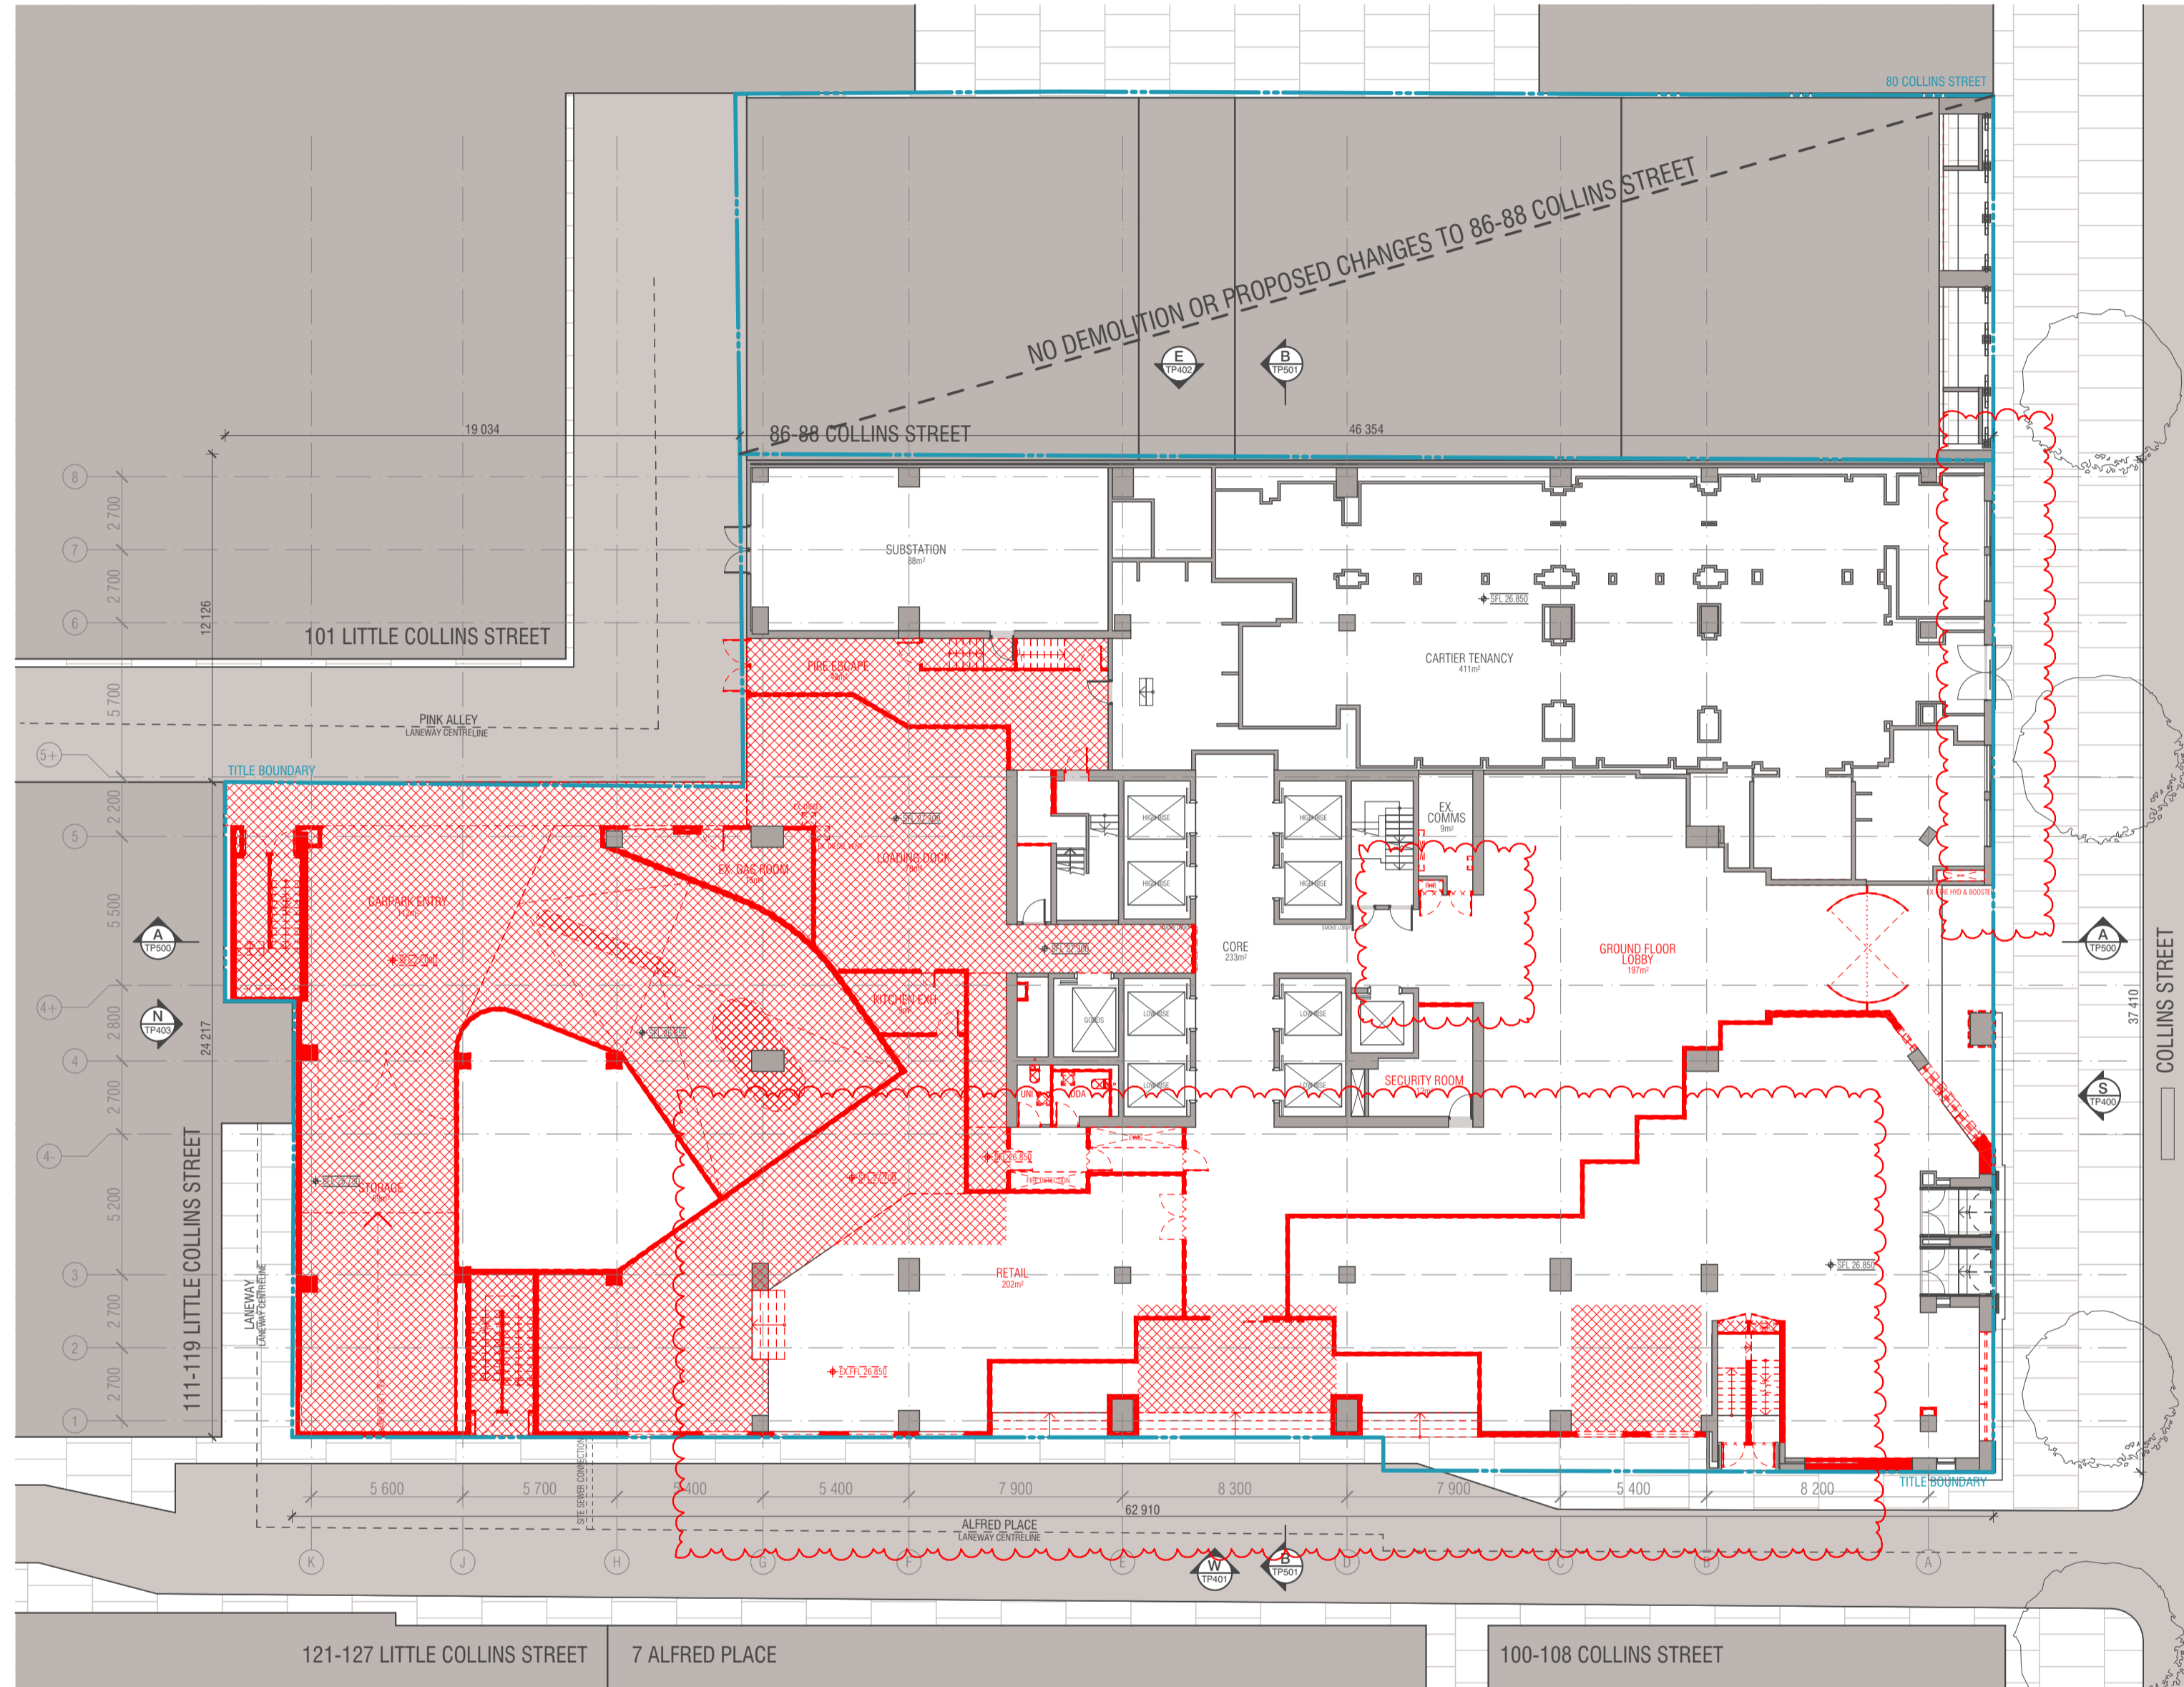

DEMOLITION GROUND FLOOR  
SCALE 1:200@A1

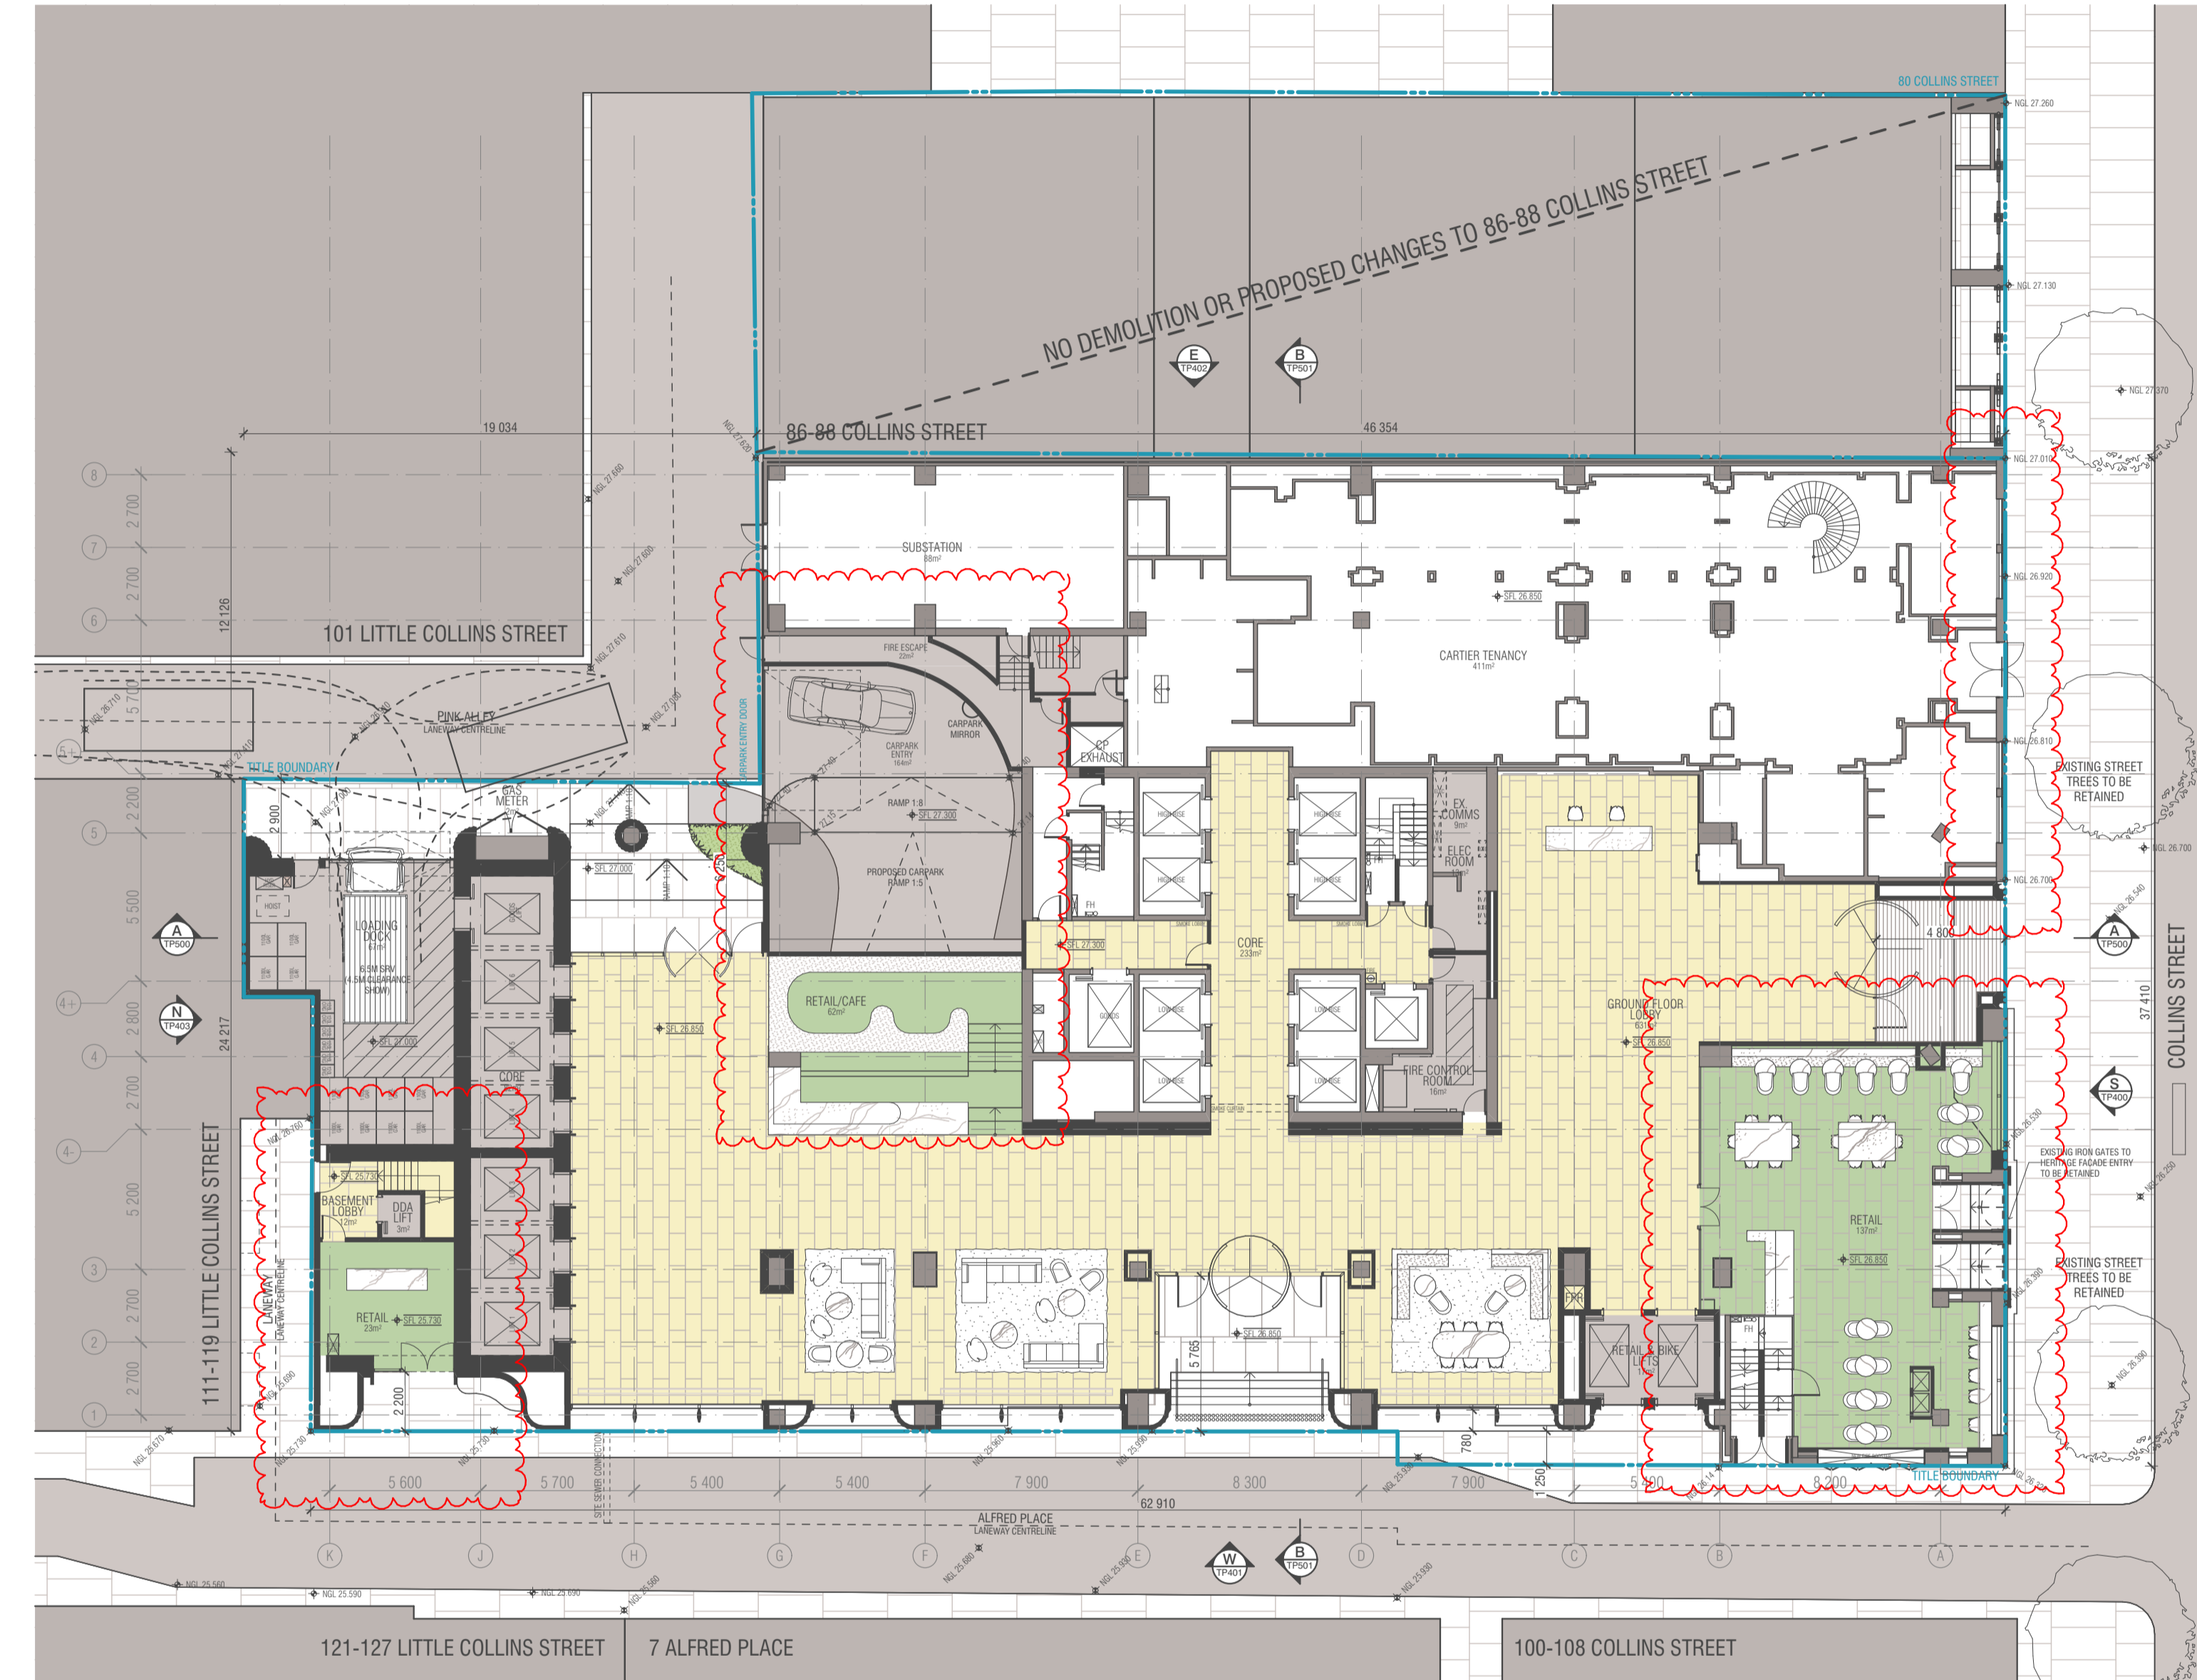

PROPOSED GROUND FLOOR  
SCALE 1:200@A1

WALL LEGEND

- EXISTING
- DEMOLISHED
- PROPOSED

BIMcloud: FK BIMCLOUD - BIMcloud\18155 90 Collins Street Melbourne\00 MODEL\OD-CD\BIM MODEL\18155 General

REVISION	DESCRIPTION	DATE
> 01	TOWN PLANNING SUBMISSION 03	15.07.2022
	TOWN PLANNING ISSUE 01	10.06.2022

**QUALITY ASSURANCE** (FK IS A CERTIFIED COMPANY TO ISO 9001:2015)  
THIS PROJECT IS SUBJECT TO THE FK QUALITY ASSURANCE SYSTEM


- SCHEMATIC DESIGN REVIEW FOR THIS PROJECT IS YET TO BE COMPLETED.
- DESIGN DEVELOPMENT REVIEW FOR THIS PROJECT IS YET TO BE COMPLETED.
- TENDER DOCUMENTATION REVIEW FOR THIS PROJECT IS YET TO BE COMPLETED.
- CONSTRUCTION DOCUMENTATION REVIEW FOR THIS DRAWING IS YET TO BE COMPLETED.

IF THIS DRAWING IS STAMPED UNCONTROLLED COPY THEN IT IS TO BE CONSIDERED A DRAFT. SUBJECT TO REVISION WITHOUT NOTICE

**NOTES**  
THIS DRAWING IS COPYRIGHT AND SHALL REMAIN THE PROPERTY OF FENDER KATSALIDIS (AUST) PTY LTD  
CHECK AND VERIFY ALL DIMENSIONS ON SITE PRIOR TO COMMENCING WORK. DRAWING TO BE READ IN CONJUNCTION WITH ALL OTHER CONTRACT DOCUMENTS. DO NOT SCALE DRAWINGS. USE FIGURED DIMENSIONS ONLY. SEEK CLARIFICATION OF INCONSISTENCIES / CONFLICTS.

DRAWN	DATE	CHECKED	PLOT DATE	JOB NO.	SCALE
WTK	15.07.2022	JV	21.07.2022	18155	1:100@A1

**PROJECT**  
90 COLLINS REDEVELOPMENT  
90 COLLINS STREET  
MELBOURNE VIC 3000

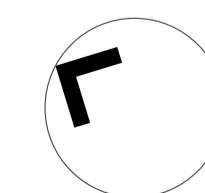

**FENDER KATSALIDIS**  
WWW.FKAUSTRALIA.COM  
2 RIVERSIDE QUAY, SOUTH BANK  
VICTORIA 3006 AUSTRALIA  
TELEPHONE: +61 3 8696 3888  
FENDER KATSALIDIS (AUST) PTY LTD ACN 092 943 032




**DRAWING TITLE**  
COMBINED SITE GROUND FLOOR PLAN


**ISSUE PURPOSE**  
TOWN PLANNING

**REV.** 01  
**DRAWING NO.** TP350



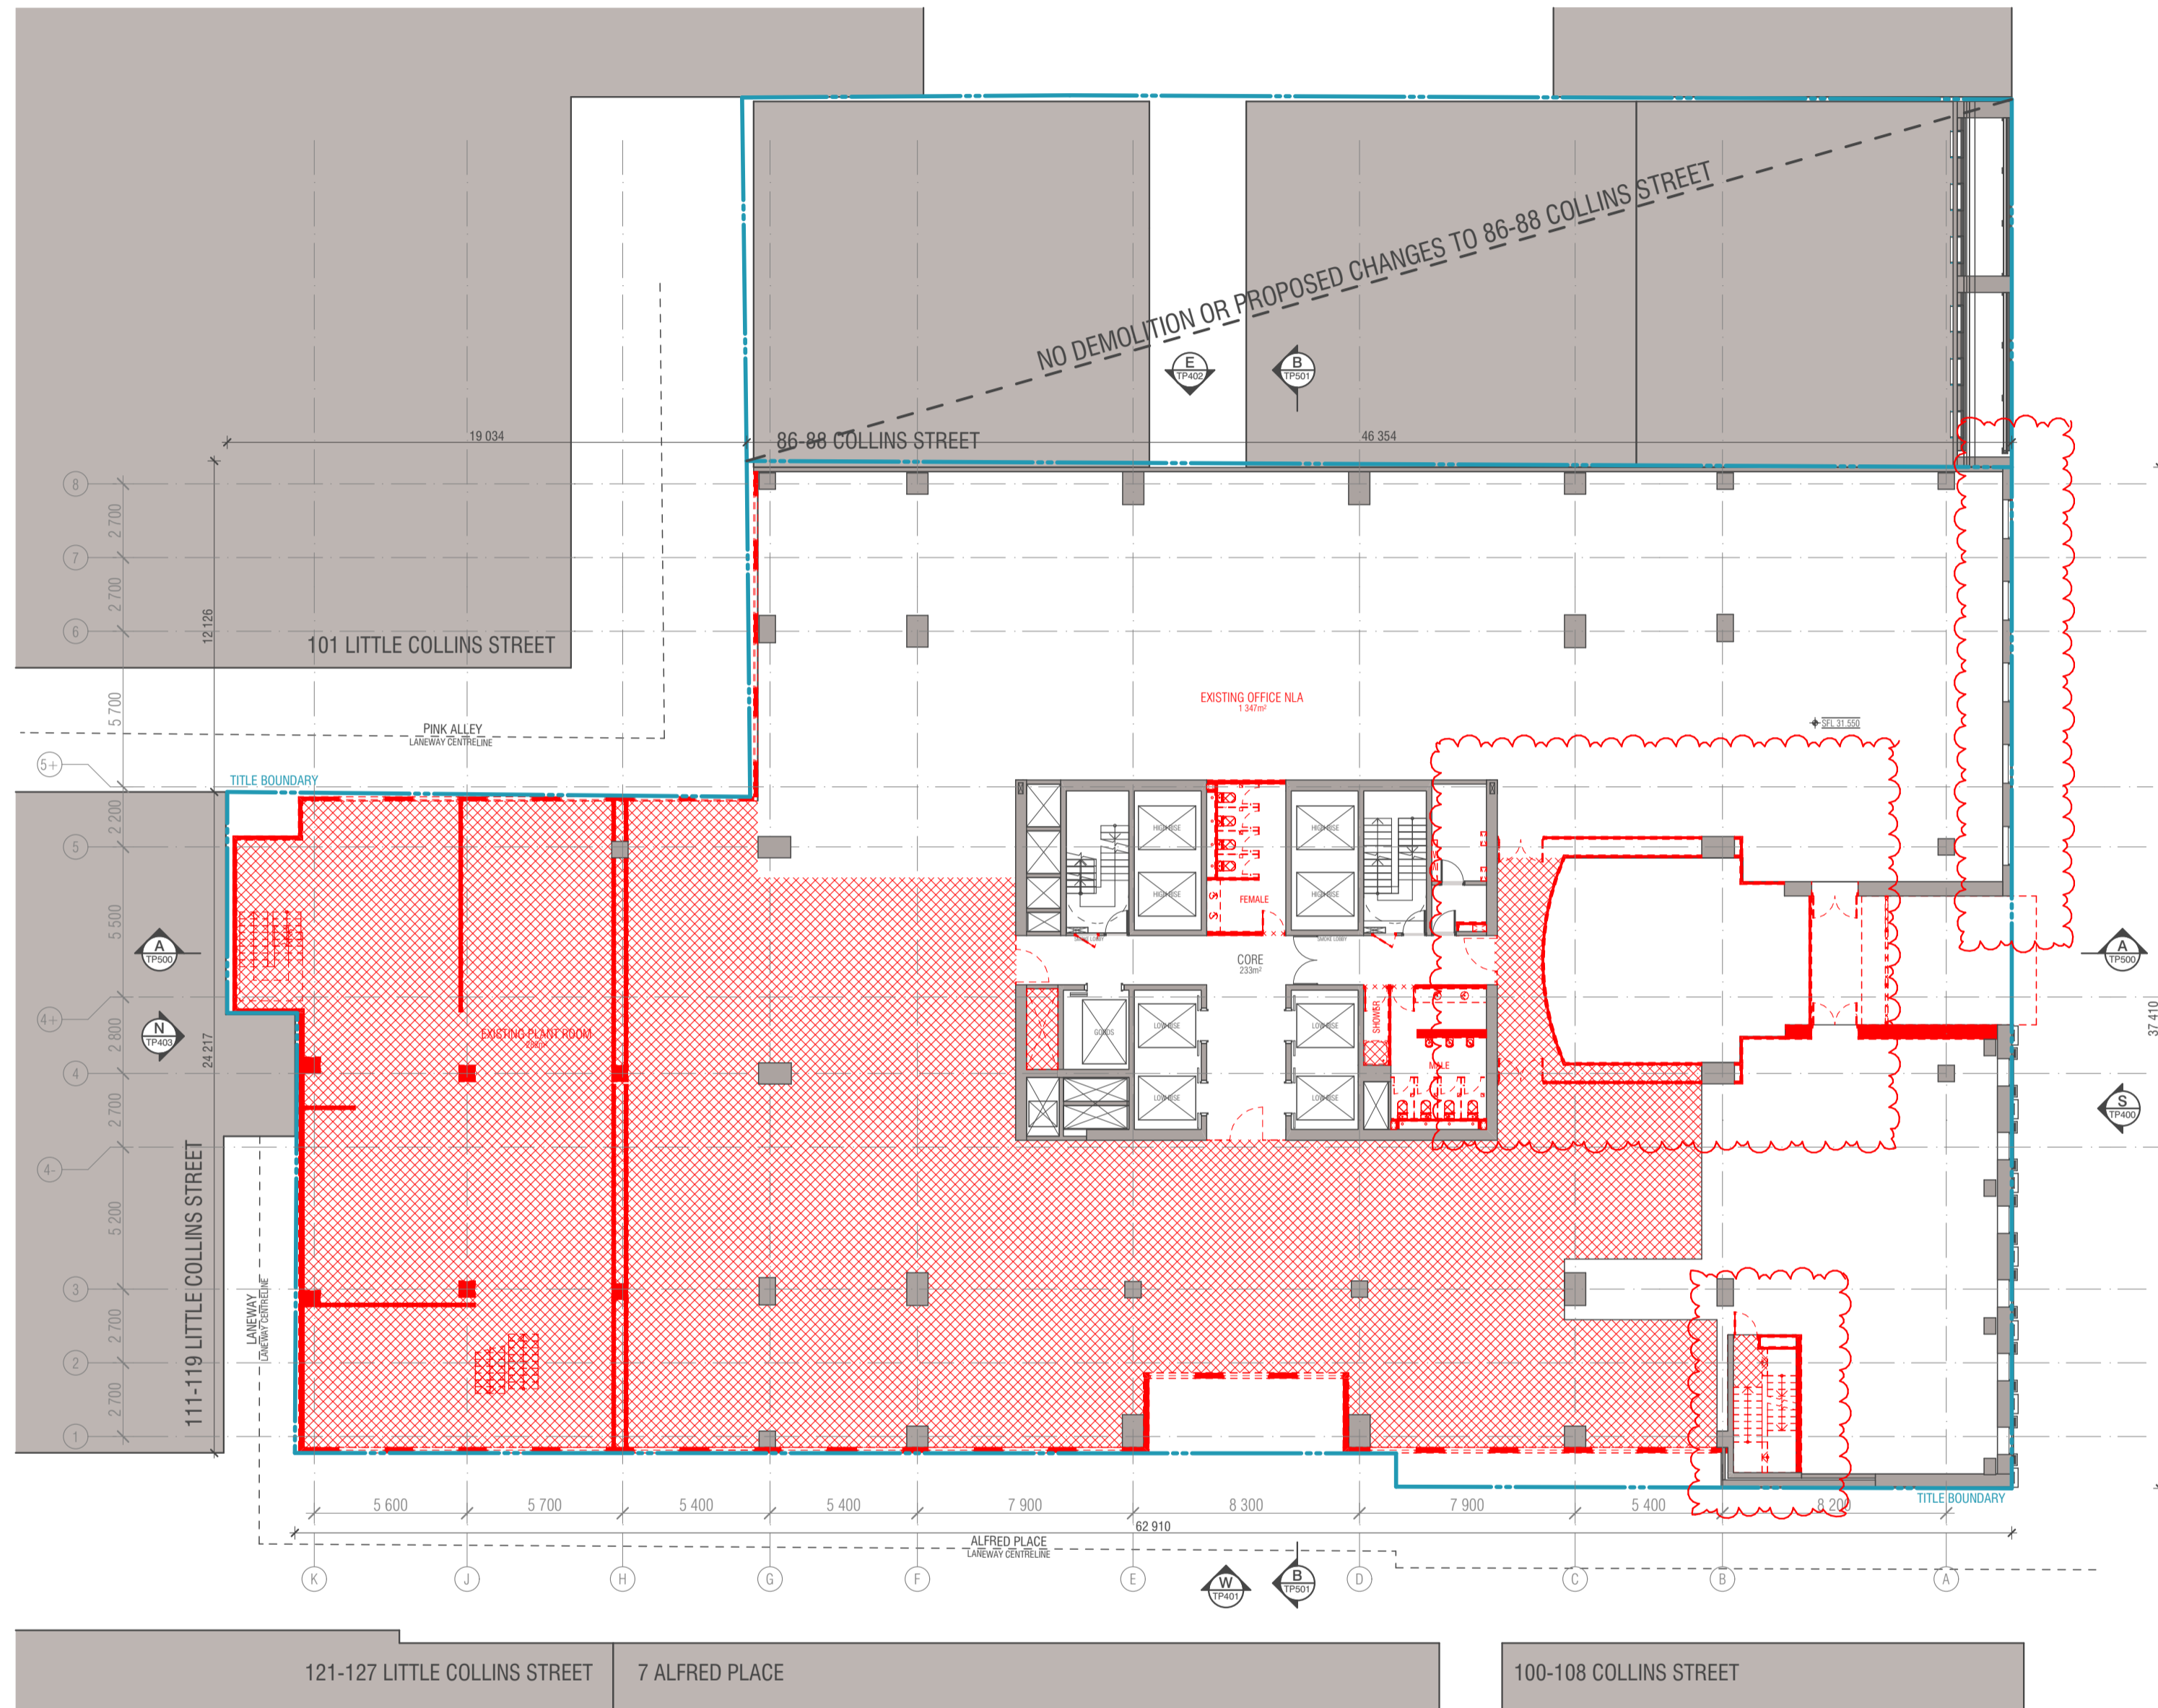

DEMOLITION LEVEL 1  
SCALE 1:200@A1

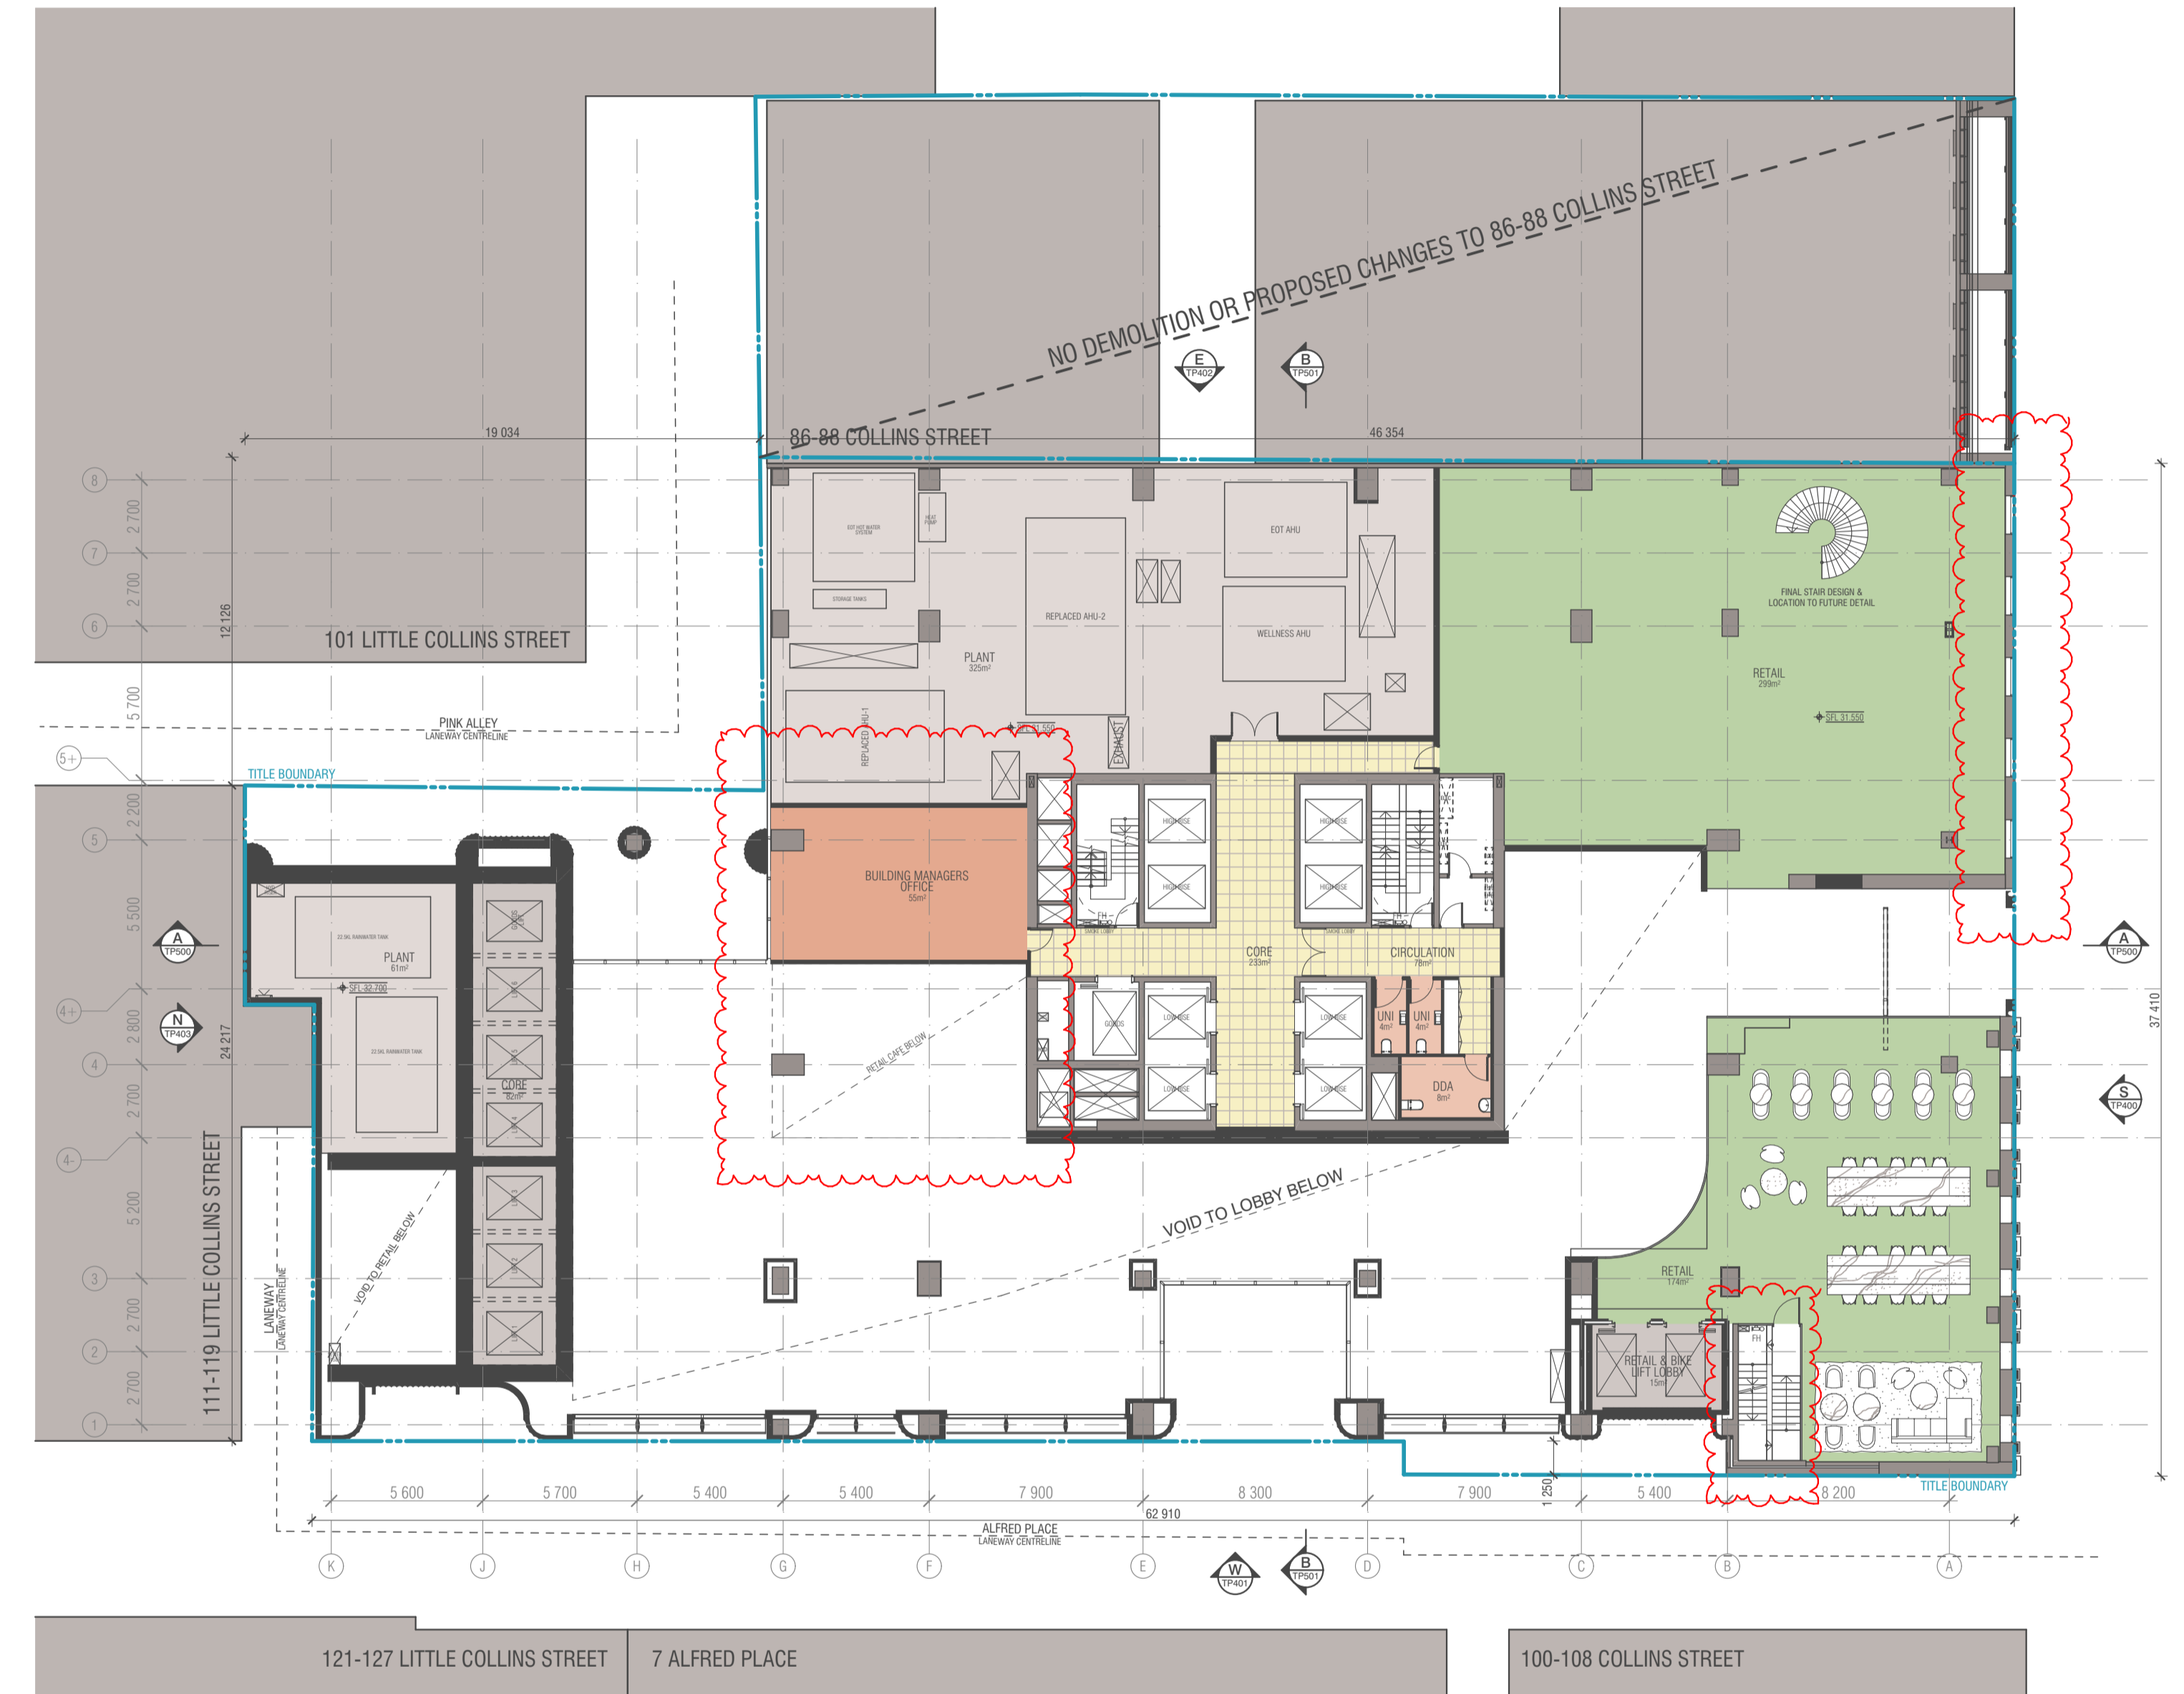

PROPOSED LEVEL 1  
SCALE 1:200@A1

WALL LEGEND

- EXISTING
- DEMOLISHED
- PROPOSED

BIMcloud: FK BIMCLOUD - BIMcloud\18155 90 Collins Street Melbourne\00 MODEL\OD-CD\BIM MODEL\18155 General

REVISION	REVISION
01 TOWN PLANNING ISSUE 01	WTK 10.06.2022
02 TOWN PLANNING SUBMISSION 03	WTK 15.07.2022

**QUALITY ASSURANCE** (FK IS A CERTIFIED COMPANY TO ISO 9001:2015)  
THIS PROJECT IS SUBJECT TO THE FK QUALITY ASSURANCE SYSTEM

- SCHEMATIC DESIGN REVIEW FOR THIS PROJECT IS YET TO BE COMPLETED.
- DESIGN DEVELOPMENT REVIEW FOR THIS PROJECT IS YET TO BE COMPLETED.
- TENDER DOCUMENTATION REVIEW FOR THIS PROJECT IS YET TO BE COMPLETED.
- CONSTRUCTION DOCUMENTATION REVIEW FOR THIS DRAWING IS YET TO BE COMPLETED.

IF THIS DRAWING IS STAMPED UNCONTROLLED COPY THEN IT IS TO BE CONSIDERED A DRAFT. SUBJECT TO REVISION WITHOUT NOTICE

**NOTES**  
THIS DRAWING IS COPYRIGHT AND SHALL REMAIN THE PROPERTY OF FENDER KATSLIDIS (AUST) PTY LTD  
CHECK AND VERIFY ALL DIMENSIONS ON SITE PRIOR TO COMMENCING WORK. DRAWING TO BE READ IN CONJUNCTION WITH ALL OTHER CONTRACT DOCUMENTS. DO NOT SCALE DRAWINGS. USE FIGURED DIMENSIONS ONLY. SEEK CLARIFICATION OF INCONSISTENCIES / CONFLICTS.

DRAWN	DATE	CHECKED	PLOT DATE	JOB NO.	SCALE
WTK	15.07.2022	JV	21.07.2022	18155	1:100@A1

**PROJECT**  
90 COLLINS REDEVELOPMENT  
90 COLLINS STREET  
MELBOURNE VIC 3000



**FENDER KATSLIDIS**  
WWW.FKAUSTRALIA.COM  
2 RIVERSIDE QUAY, SOUTHBANK  
VICTORIA 3006 AUSTRALIA  
TELEPHONE: +61 3 8696 3888  
FENDER KATSLIDIS (AUST) PTY LTD ACN 092 943 032




**DRAWING TITLE**  
COMBINED SITE LEVEL 01 FLOOR PLAN


**ISSUE PURPOSE**  
TOWN PLANNING

**REV.** 01  
**DRAWING NO.** TP351



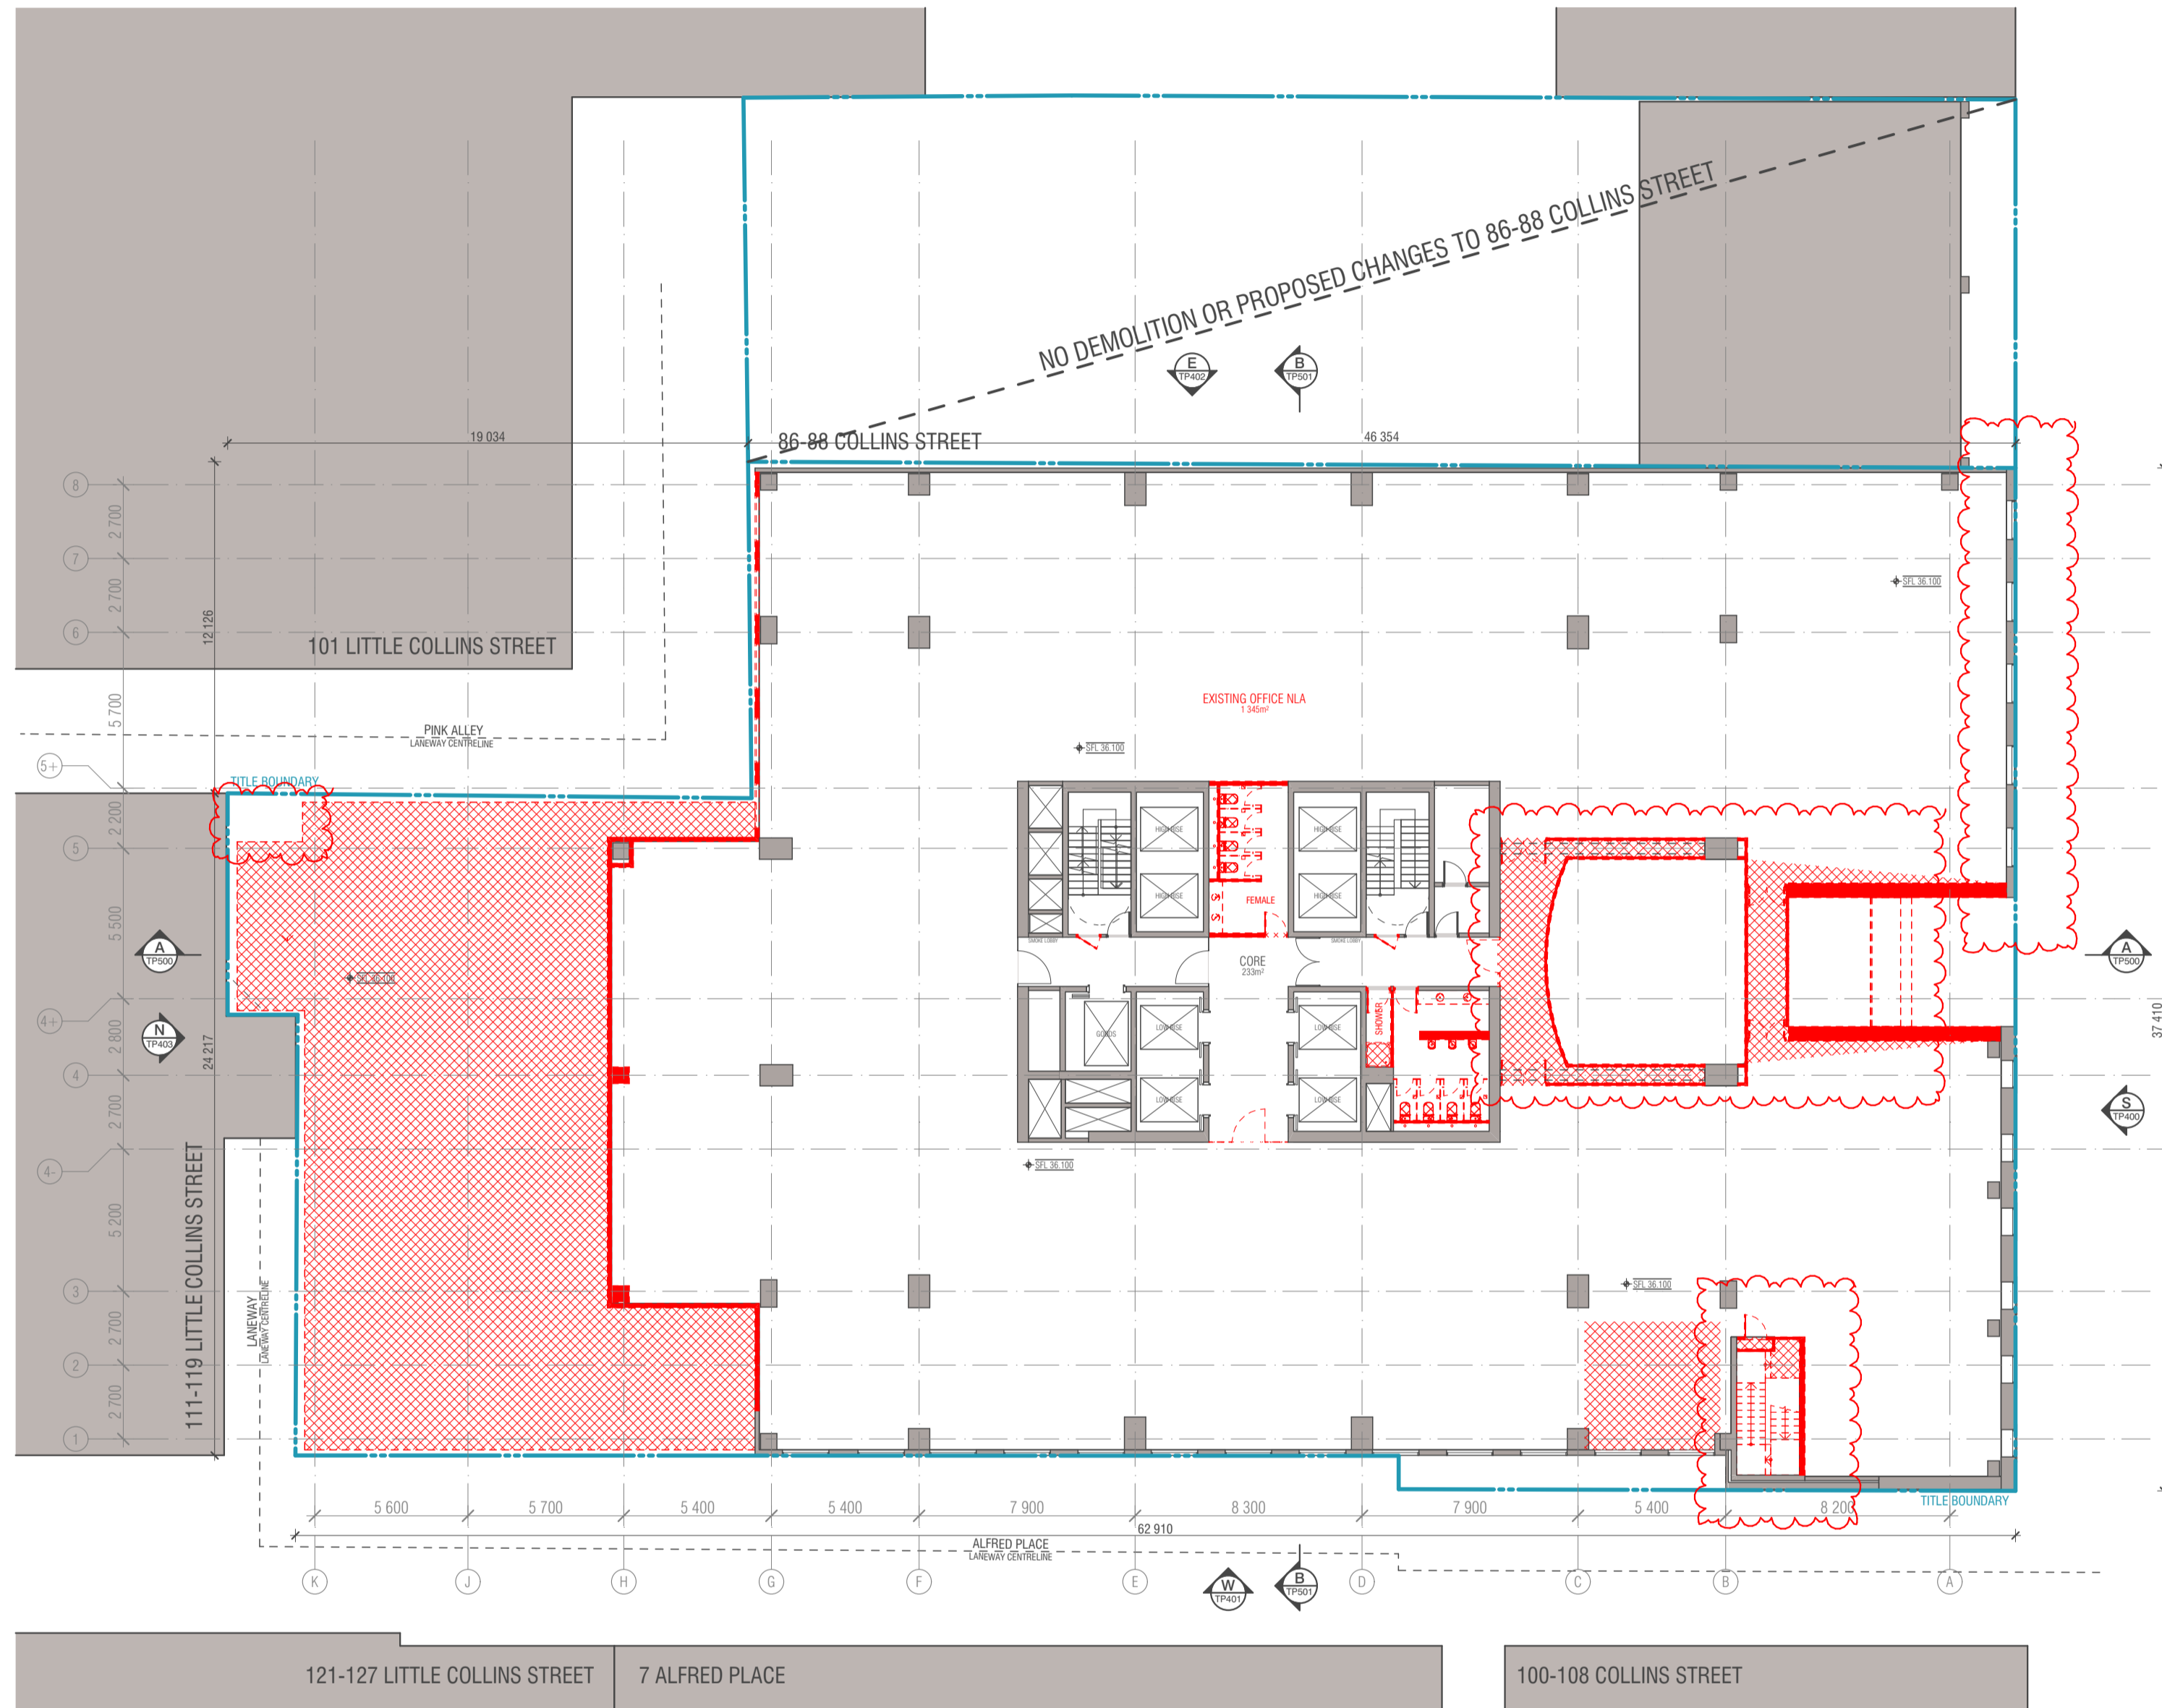

DEMOLITION LEVEL 2  
SCALE 1:200@A1

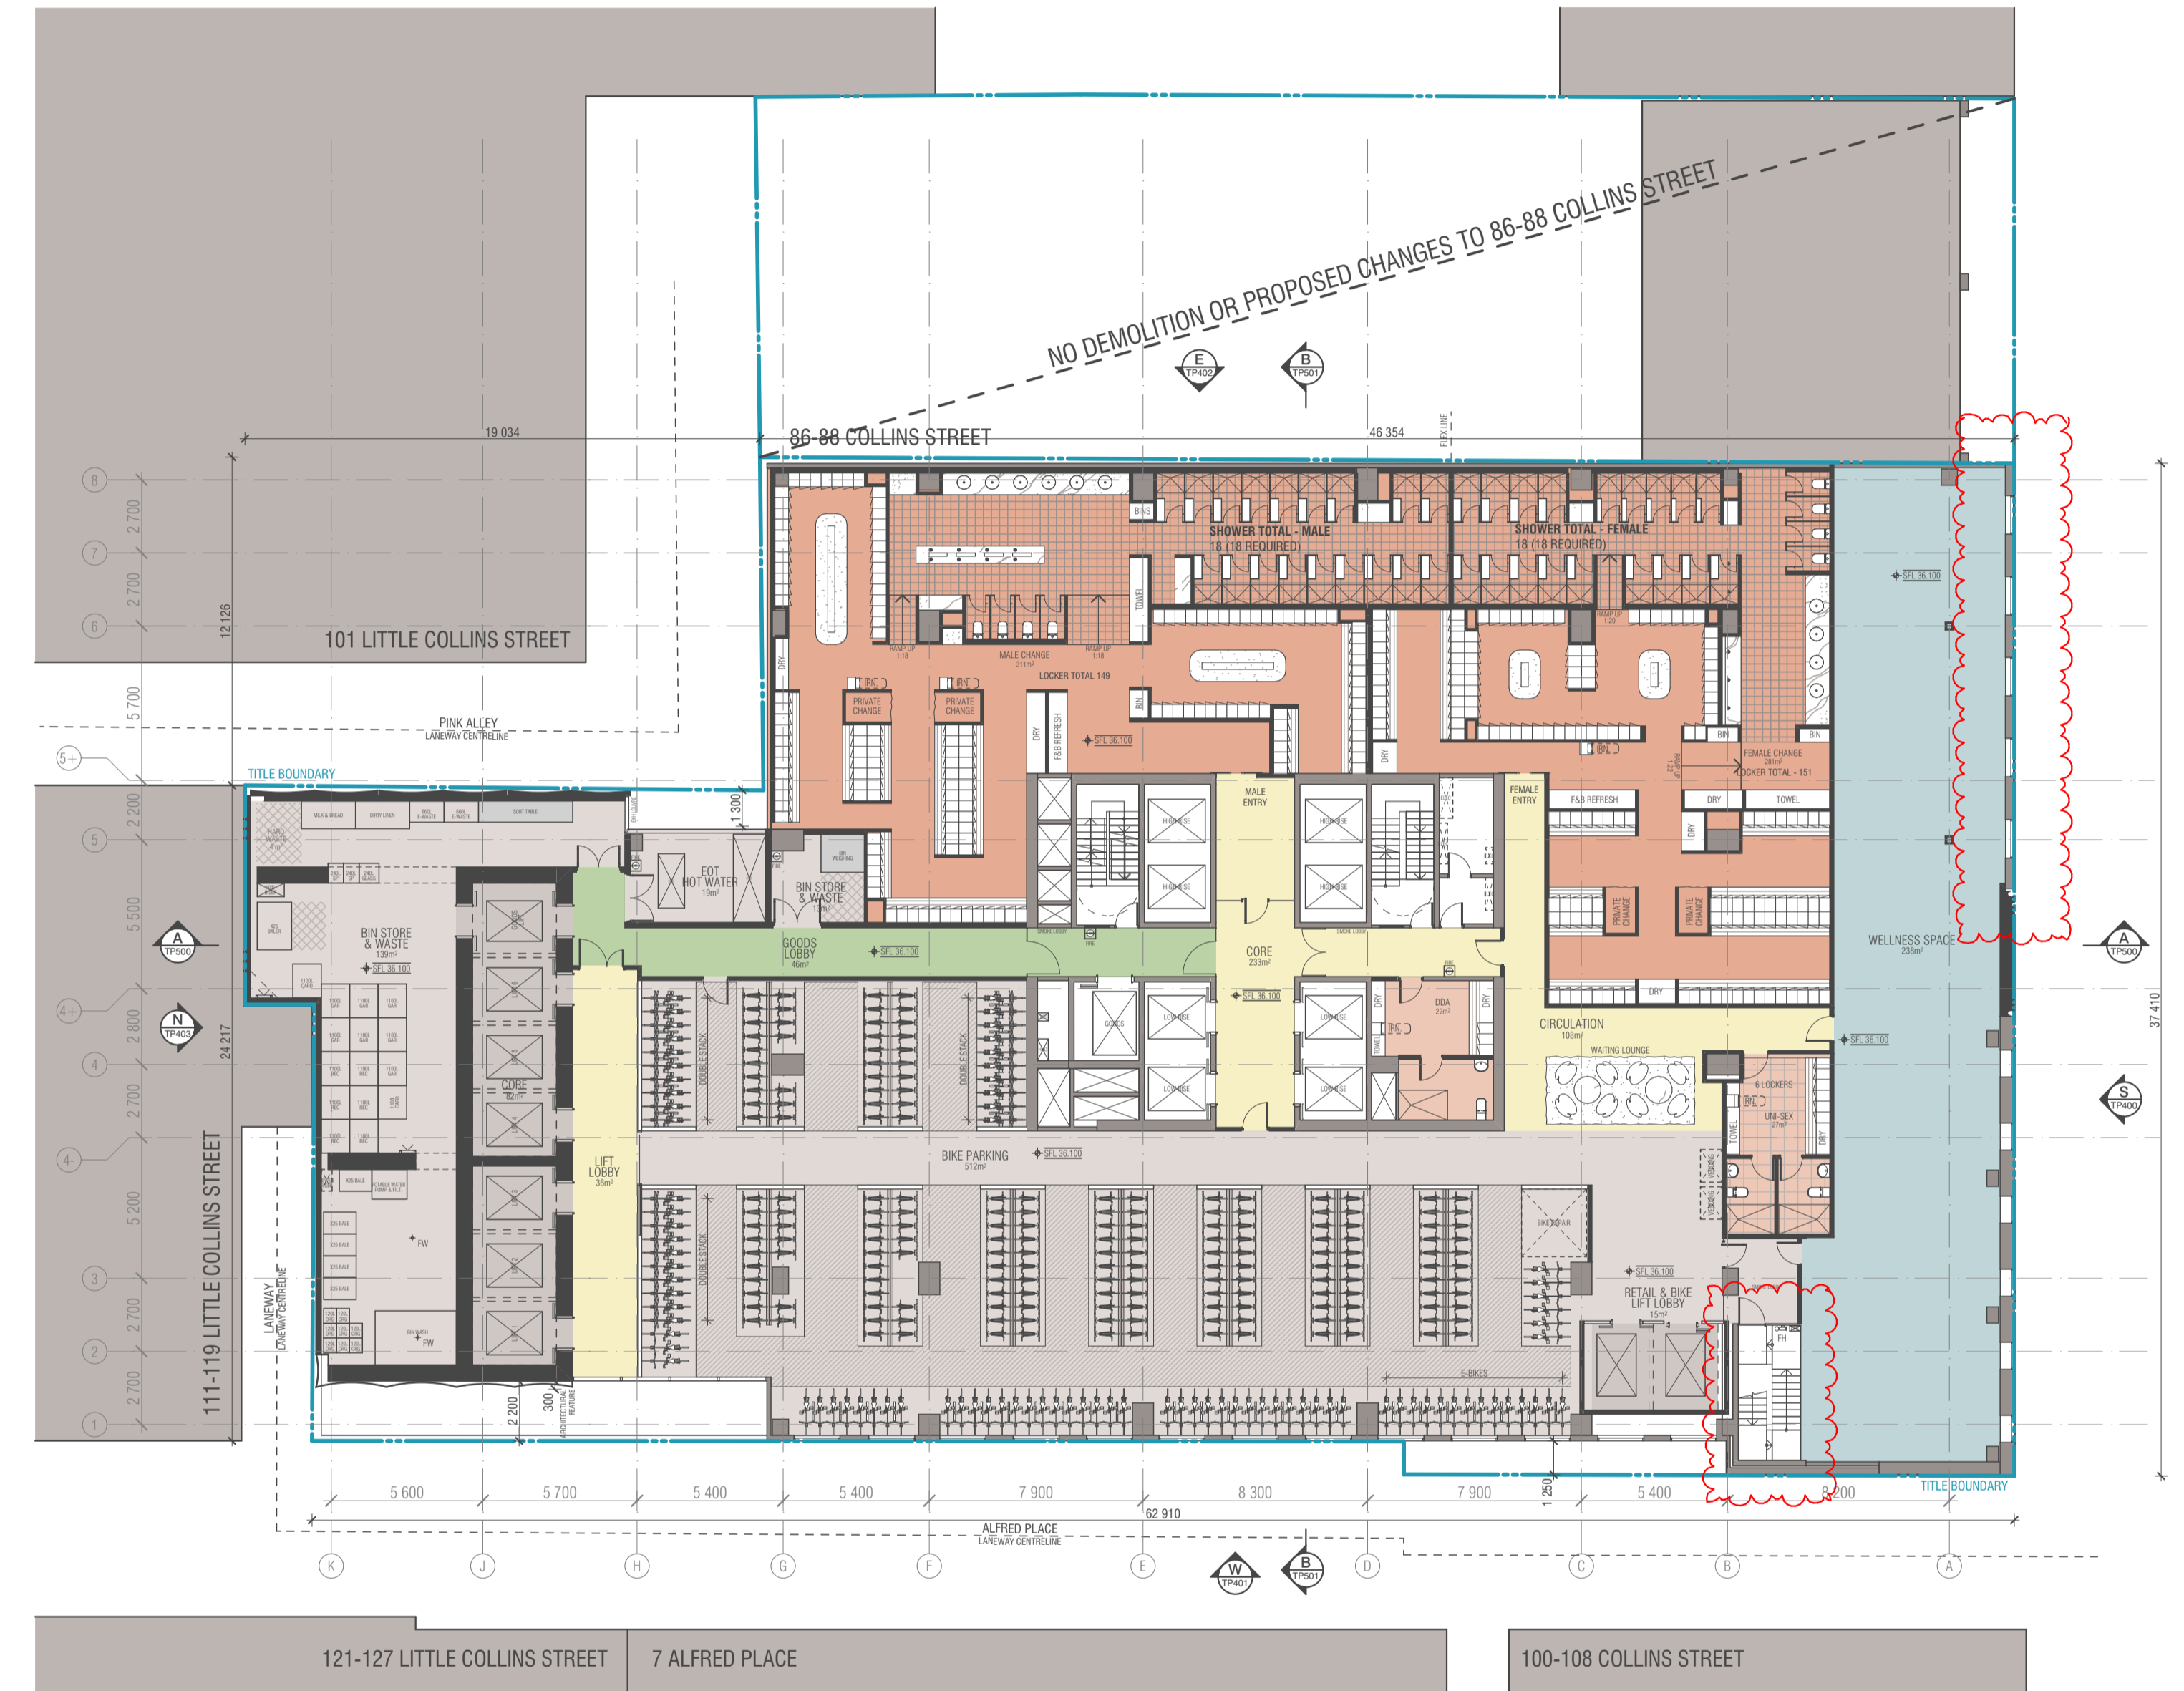

PROPOSED LEVEL 2  
SCALE 1:200@A1

**WALL LEGEND**

- EXISTING
- DEMOLISHED
- PROPOSED

BIMcloud: FK BIMCLOUD - BIMcloud\18155 90 Collins Street Melbourne\00 MODEL\00-CD\BIM MODEL\18155 General

REVISION	REVISION
01 TOWN PLANNING ISSUE 01	WTK 10.06.2022
02 TOWN PLANNING SUBMISSION 03	WTK 15.07.2022

**QUALITY ASSURANCE** (FK IS A CERTIFIED COMPANY TO ISO 9001:2015)  
THIS PROJECT IS SUBJECT TO THE FK QUALITY ASSURANCE SYSTEM

- SCHEMATIC DESIGN REVIEW FOR THIS PROJECT IS YET TO BE COMPLETED.
- DESIGN DEVELOPMENT REVIEW FOR THIS PROJECT IS YET TO BE COMPLETED.
- TENDER DOCUMENTATION REVIEW FOR THIS PROJECT IS YET TO BE COMPLETED.
- CONSTRUCTION DOCUMENTATION REVIEW FOR THIS DRAWING IS YET TO BE COMPLETED.

IF THIS DRAWING IS STAMPED UNCONTROLLED COPY THEN IT IS TO BE CONSIDERED A DRAFT. SUBJECT TO REVISION WITHOUT NOTICE


**NOTES**  
THIS DRAWING IS COPYRIGHT AND SHALL REMAIN THE PROPERTY OF FENDER KATSAIDIS (AUST) PTY LTD  
CHECK AND VERIFY ALL DIMENSIONS ON SITE PRIOR TO COMMENCING WORK. DRAWING TO BE READ IN CONJUNCTION WITH ALL OTHER CONTRACT DOCUMENTS. DO NOT SCALE DRAWINGS. USE FIGURED DIMENSIONS ONLY. SEEK CLARIFICATION OF INCONSISTENCIES / CONFLICTS.

DRAWN	DATE	CHECKED	PLOT DATE	JOB NO.	SCALE
WTK	15.07.2022	JV	21.07.2022	18155	1:100@A1

**PROJECT**  
90 COLLINS REDEVELOPMENT  
90 COLLINS STREET  
MELBOURNE VIC 3000




**FENDER KATSAIDIS**  
WWW.FKAUSTRALIA.COM  
2 RIVERSIDE QUAY, SOUTHBANK  
VICTORIA 3006 AUSTRALIA  
TELEPHONE: +61 3 8696 3888  
FENDER KATSAIDIS (AUST) PTY LTD ACN 092 943 032

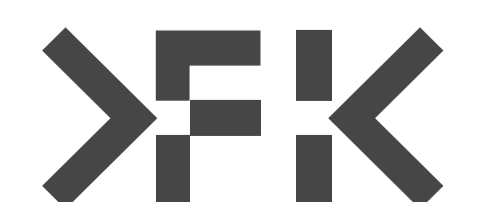


DRAWING TITLE	ISSUE PURPOSE	REV.	DRAWING NO.
COMBINED SITE LEVEL 02 FLOOR PLAN	TOWN PLANNING	01	TP352



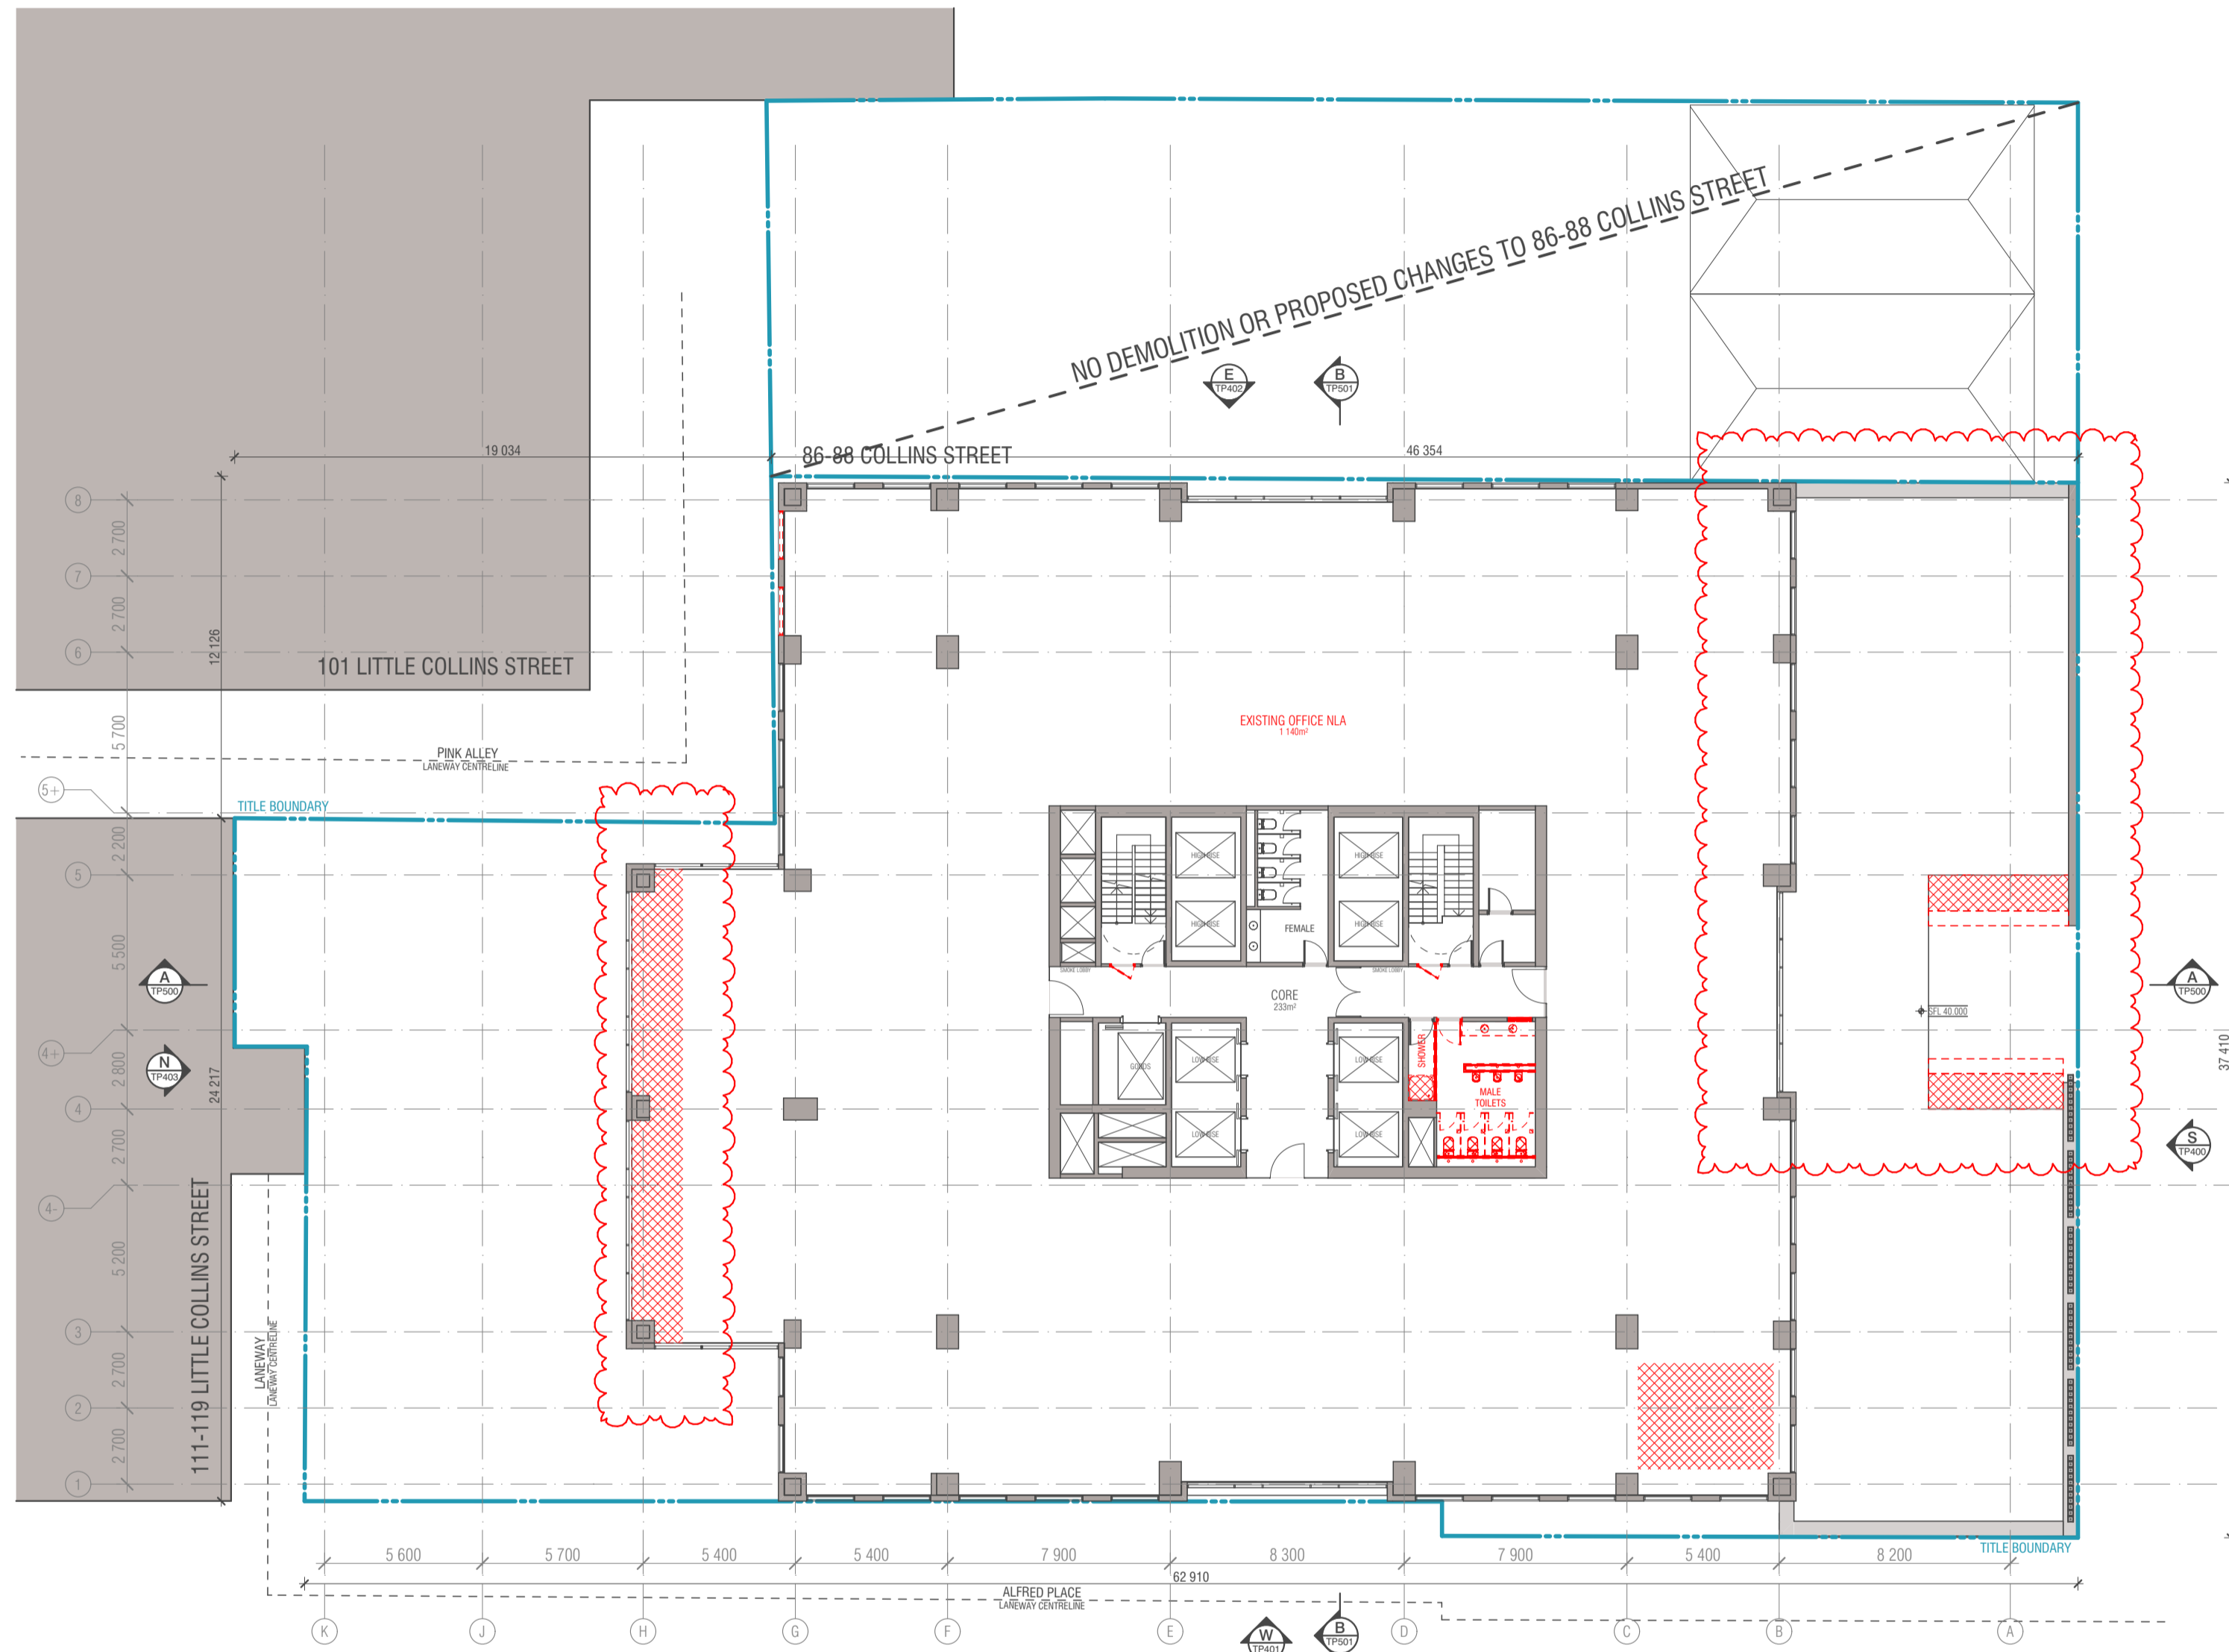

121-127 LITTLE COLLINS STREET | 7 ALFRED PLACE | 100-108 COLLINS STREET

DEMOLITION LEVEL 3  
SCALE 1:200@A1

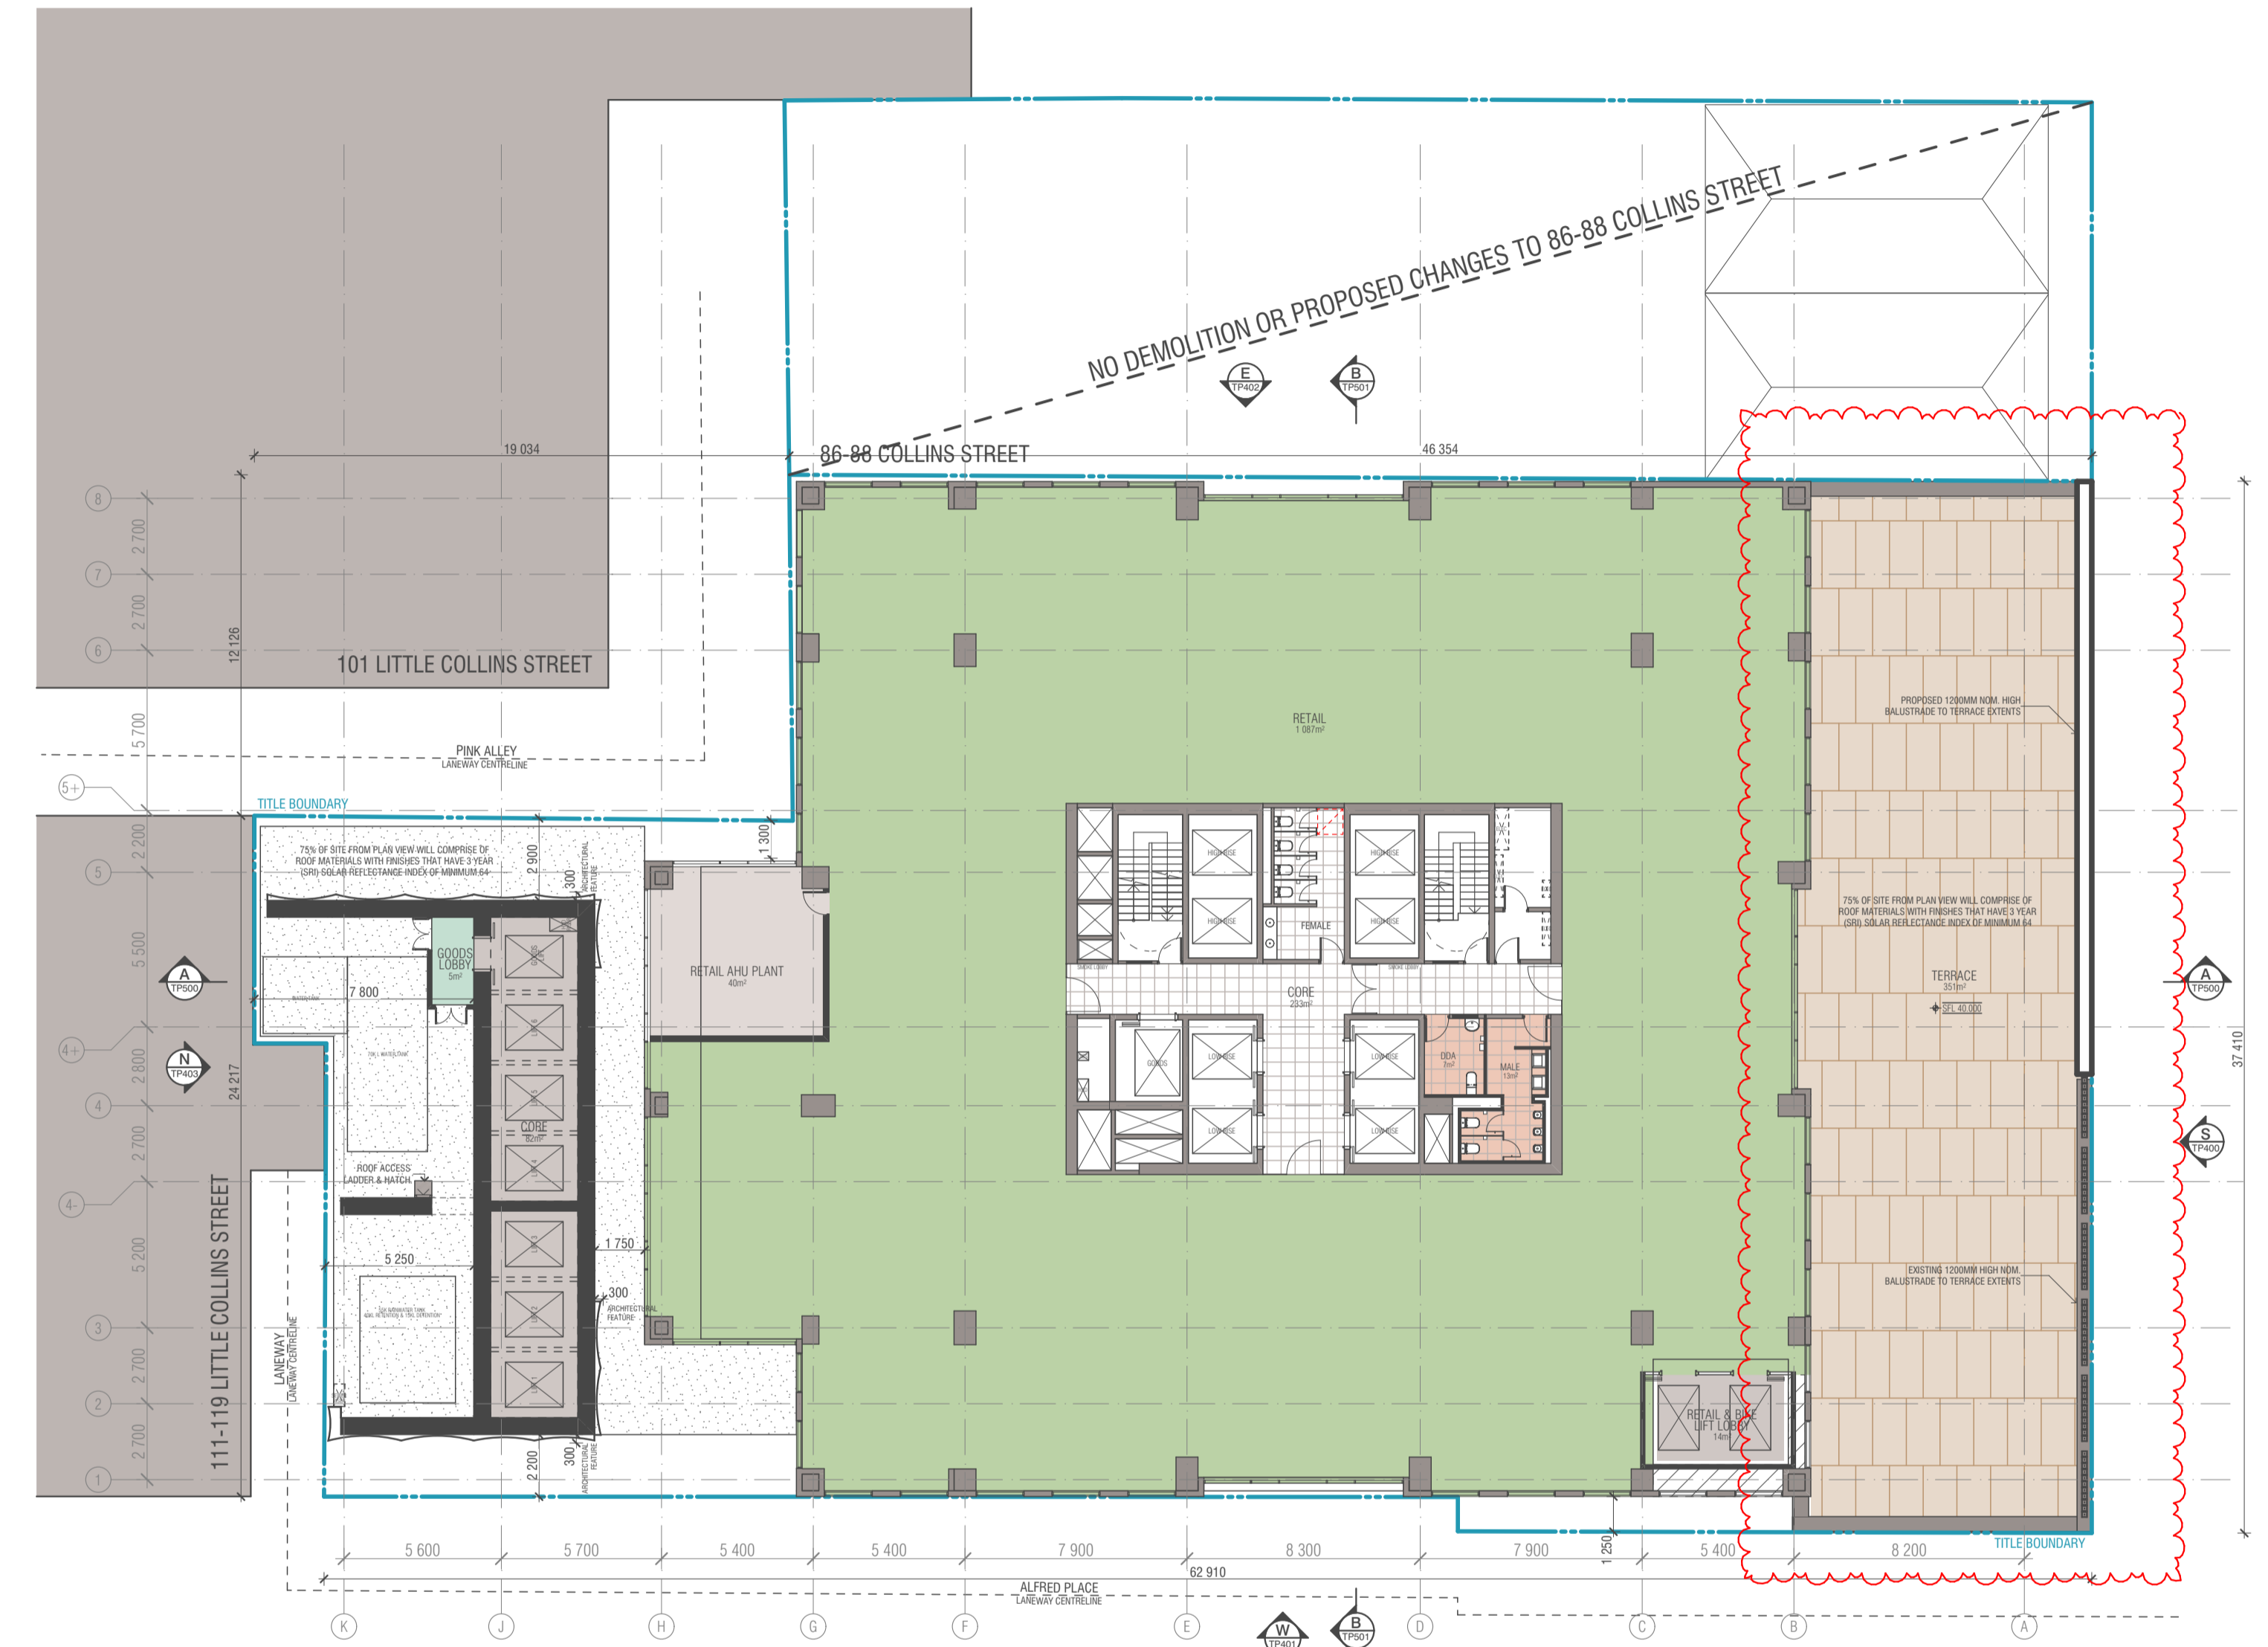

121-127 LITTLE COLLINS STREET | 7 ALFRED PLACE | 100-108 COLLINS STREET

PROPOSED LEVEL 3  
SCALE 1:200@A1

**WALL LEGEND**

- EXISTING
- DEMOLISHED
- PROPOSED

BIMcloud: FK BIMCLOUD - BIMcloud\18155 90 Collins Street Melbourne\00 MODEL\OD-CD\BIM MODEL\18155 General

REVISION	DESCRIPTION	DATE
01	TOWN PLANNING SUBMISSION 03	15.07.2022
02	TOWN PLANNING ISSUE 01	10.06.2022

REVISION	DESCRIPTION	DATE
01	TOWN PLANNING SUBMISSION 03	15.07.2022
02	TOWN PLANNING ISSUE 01	10.06.2022

**QUALITY ASSURANCE** (FK IS A CERTIFIED COMPANY TO ISO 9001:2015)

THIS PROJECT IS SUBJECT TO THE FK QUALITY ASSURANCE SYSTEM

- SCHEMATIC DESIGN REVIEW FOR THIS PROJECT IS YET TO BE COMPLETED.
- DESIGN DEVELOPMENT REVIEW FOR THIS PROJECT IS YET TO BE COMPLETED.
- TENDER DOCUMENTATION REVIEW FOR THIS PROJECT IS YET TO BE COMPLETED.
- CONSTRUCTION DOCUMENTATION REVIEW FOR THIS DRAWING IS YET TO BE COMPLETED.

IF THIS DRAWING IS STAMPED UNCONTROLLED COPY THEN IT IS TO BE CONSIDERED A DRAFT. SUBJECT TO REVISION WITHOUT NOTICE

**NOTES**


THIS DRAWING IS COPYRIGHT AND SHALL REMAIN THE PROPERTY OF FENDER KATSALEDIS (AUST) PTY LTD. CHECK AND VERIFY ALL DIMENSIONS ON SITE PRIOR TO COMMENCING WORK. DRAWING TO BE READ IN CONJUNCTION WITH ALL OTHER CONTRACT DOCUMENTS. DO NOT SCALE DRAWINGS. USE FIGURED DIMENSIONS ONLY. SEEK CLARIFICATION OF INCONSISTENCIES / CONFLICTS.

DRAWN	DATE	CHECKED	PLOT DATE	JOB NO.	SCALE
WTK	15.07.2022	JV	21.07.2022	18155	1:100@A1

**PROJECT**

90 COLLINS REDEVELOPMENT  
90 COLLINS STREET  
MELBOURNE VIC 3000


**FENDER KATSALEDIS**  
WWW.FKAUSTRALIA.COM  
2 RIVERSIDE QUAY, SOUTHBANK  
VICTORIA 3006 AUSTRALIA  
TELEPHONE: +61 3 8696 3888  
FENDER KATSALEDIS (AUST) PTY LTD ACN 092 943 032

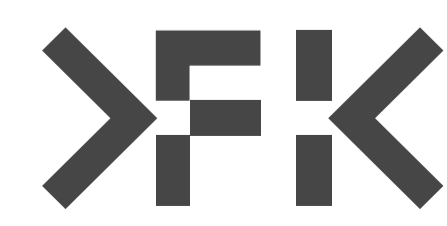

DRAWING TITLE	ISSUE PURPOSE	REV.	DRAWING NO.
COMBINED SITE LEVEL 03 FLOOR PLAN	TOWN PLANNING	01	TP353




KEY PLAN

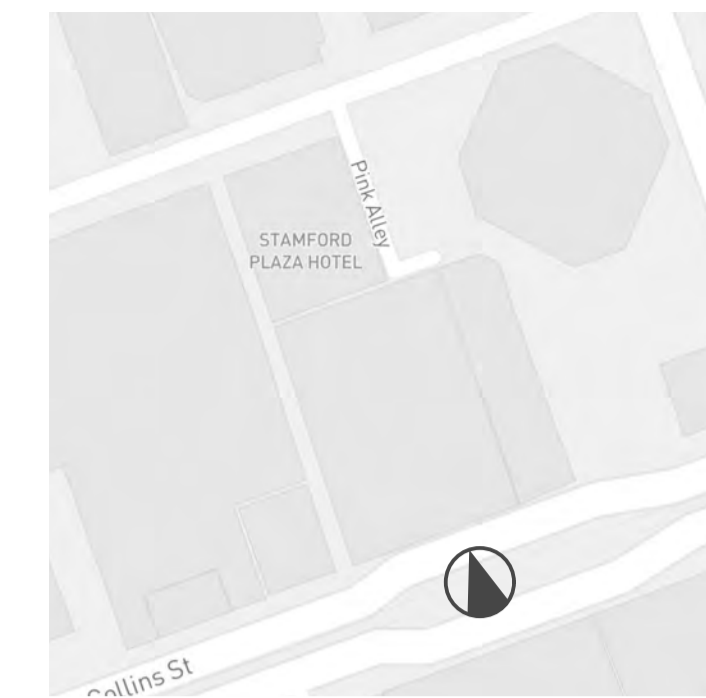


ELEVATIONS LEGEND

- G1 GLASS - SILVER GREY
- G2 GLASS - SILVER GREY SPANDREL
- G3 GLASS - CLEAR
- M1 METAL CLADDING - COPPER COLOUR
- M2 METAL CLADDING - COPPER COLOUR RAINSCREEN
- M3 METAL CLADDING - CHARCOAL COLOUR
- M4 METAL CLADDING - CHARCOAL PERFORATED
- M5 METAL LOUVRES - CHARCOAL COLOUR
- C1 POLISHED CONCRETE LOOK FINISH (OFF WHITE)
- C2 CONCRETE - GREY
- S1 BLUESTONE LOOK
- P1 HERITAGE FACADE PAINT COLOR

CHANGES HIGHLIGHTED IN COLOUR TO EXISTING & PROPOSED ELEVATIONS

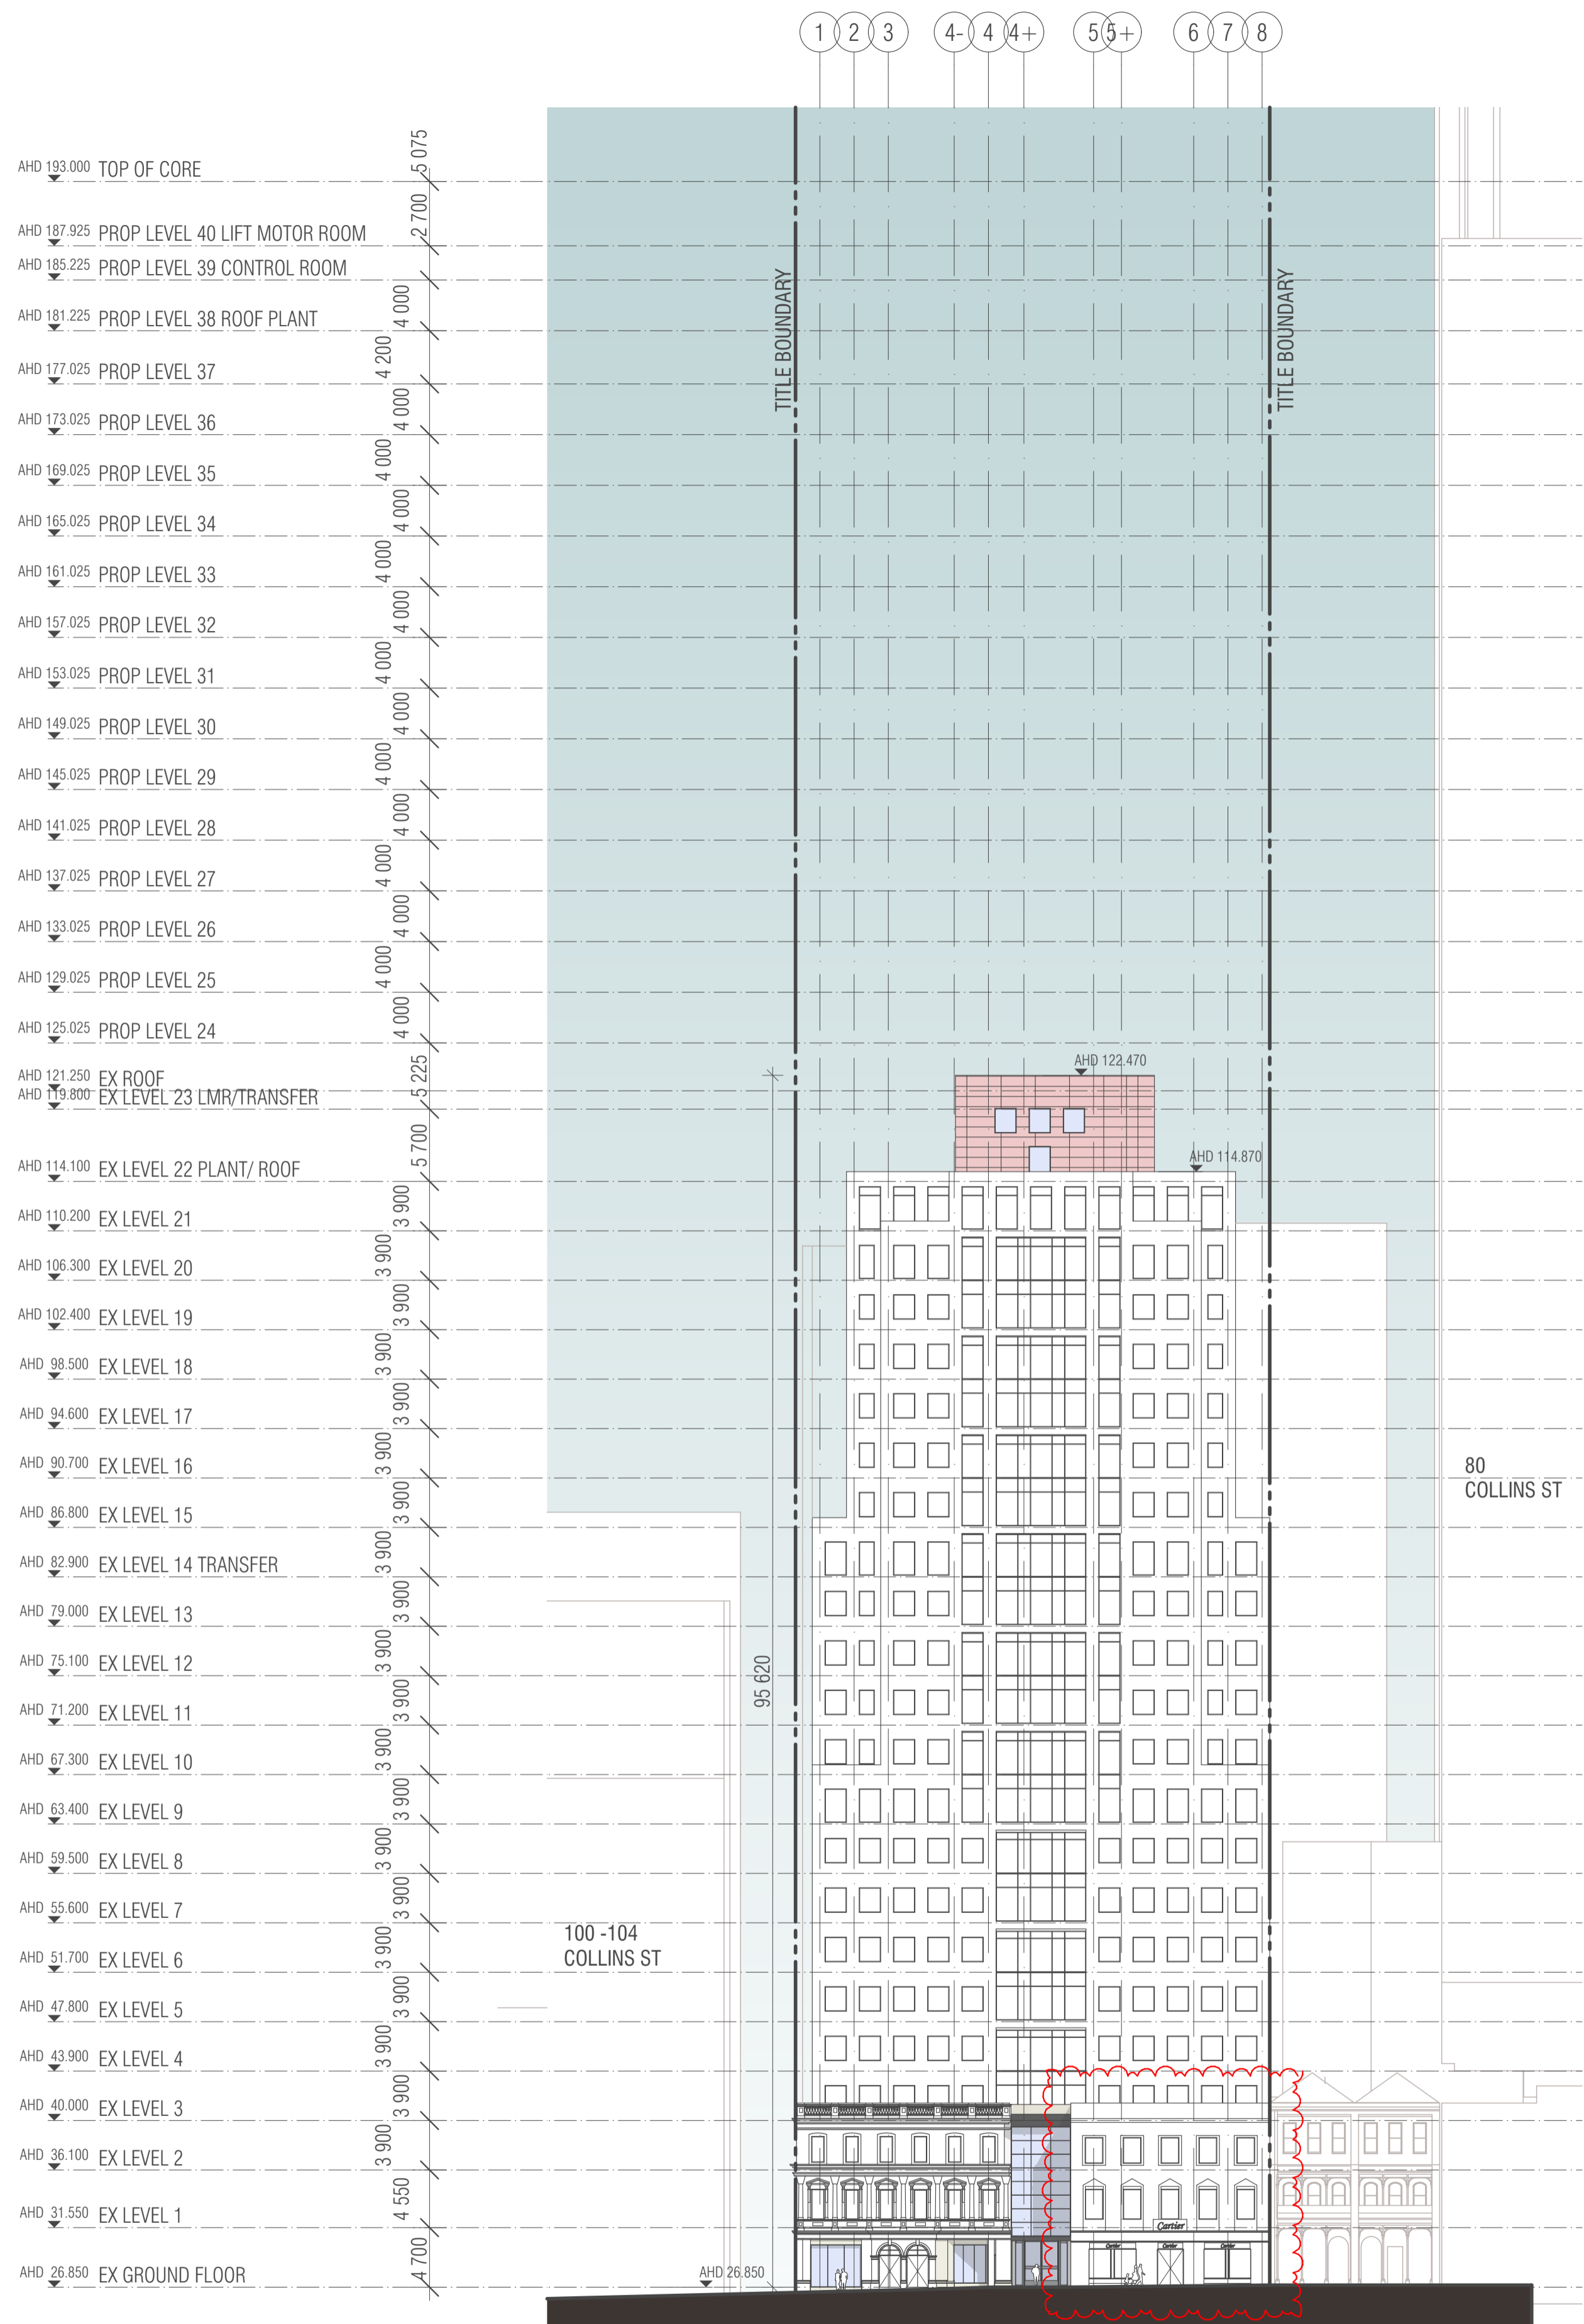

EXISTING SOUTH ELEVATION  
SCALE 1:375@A1

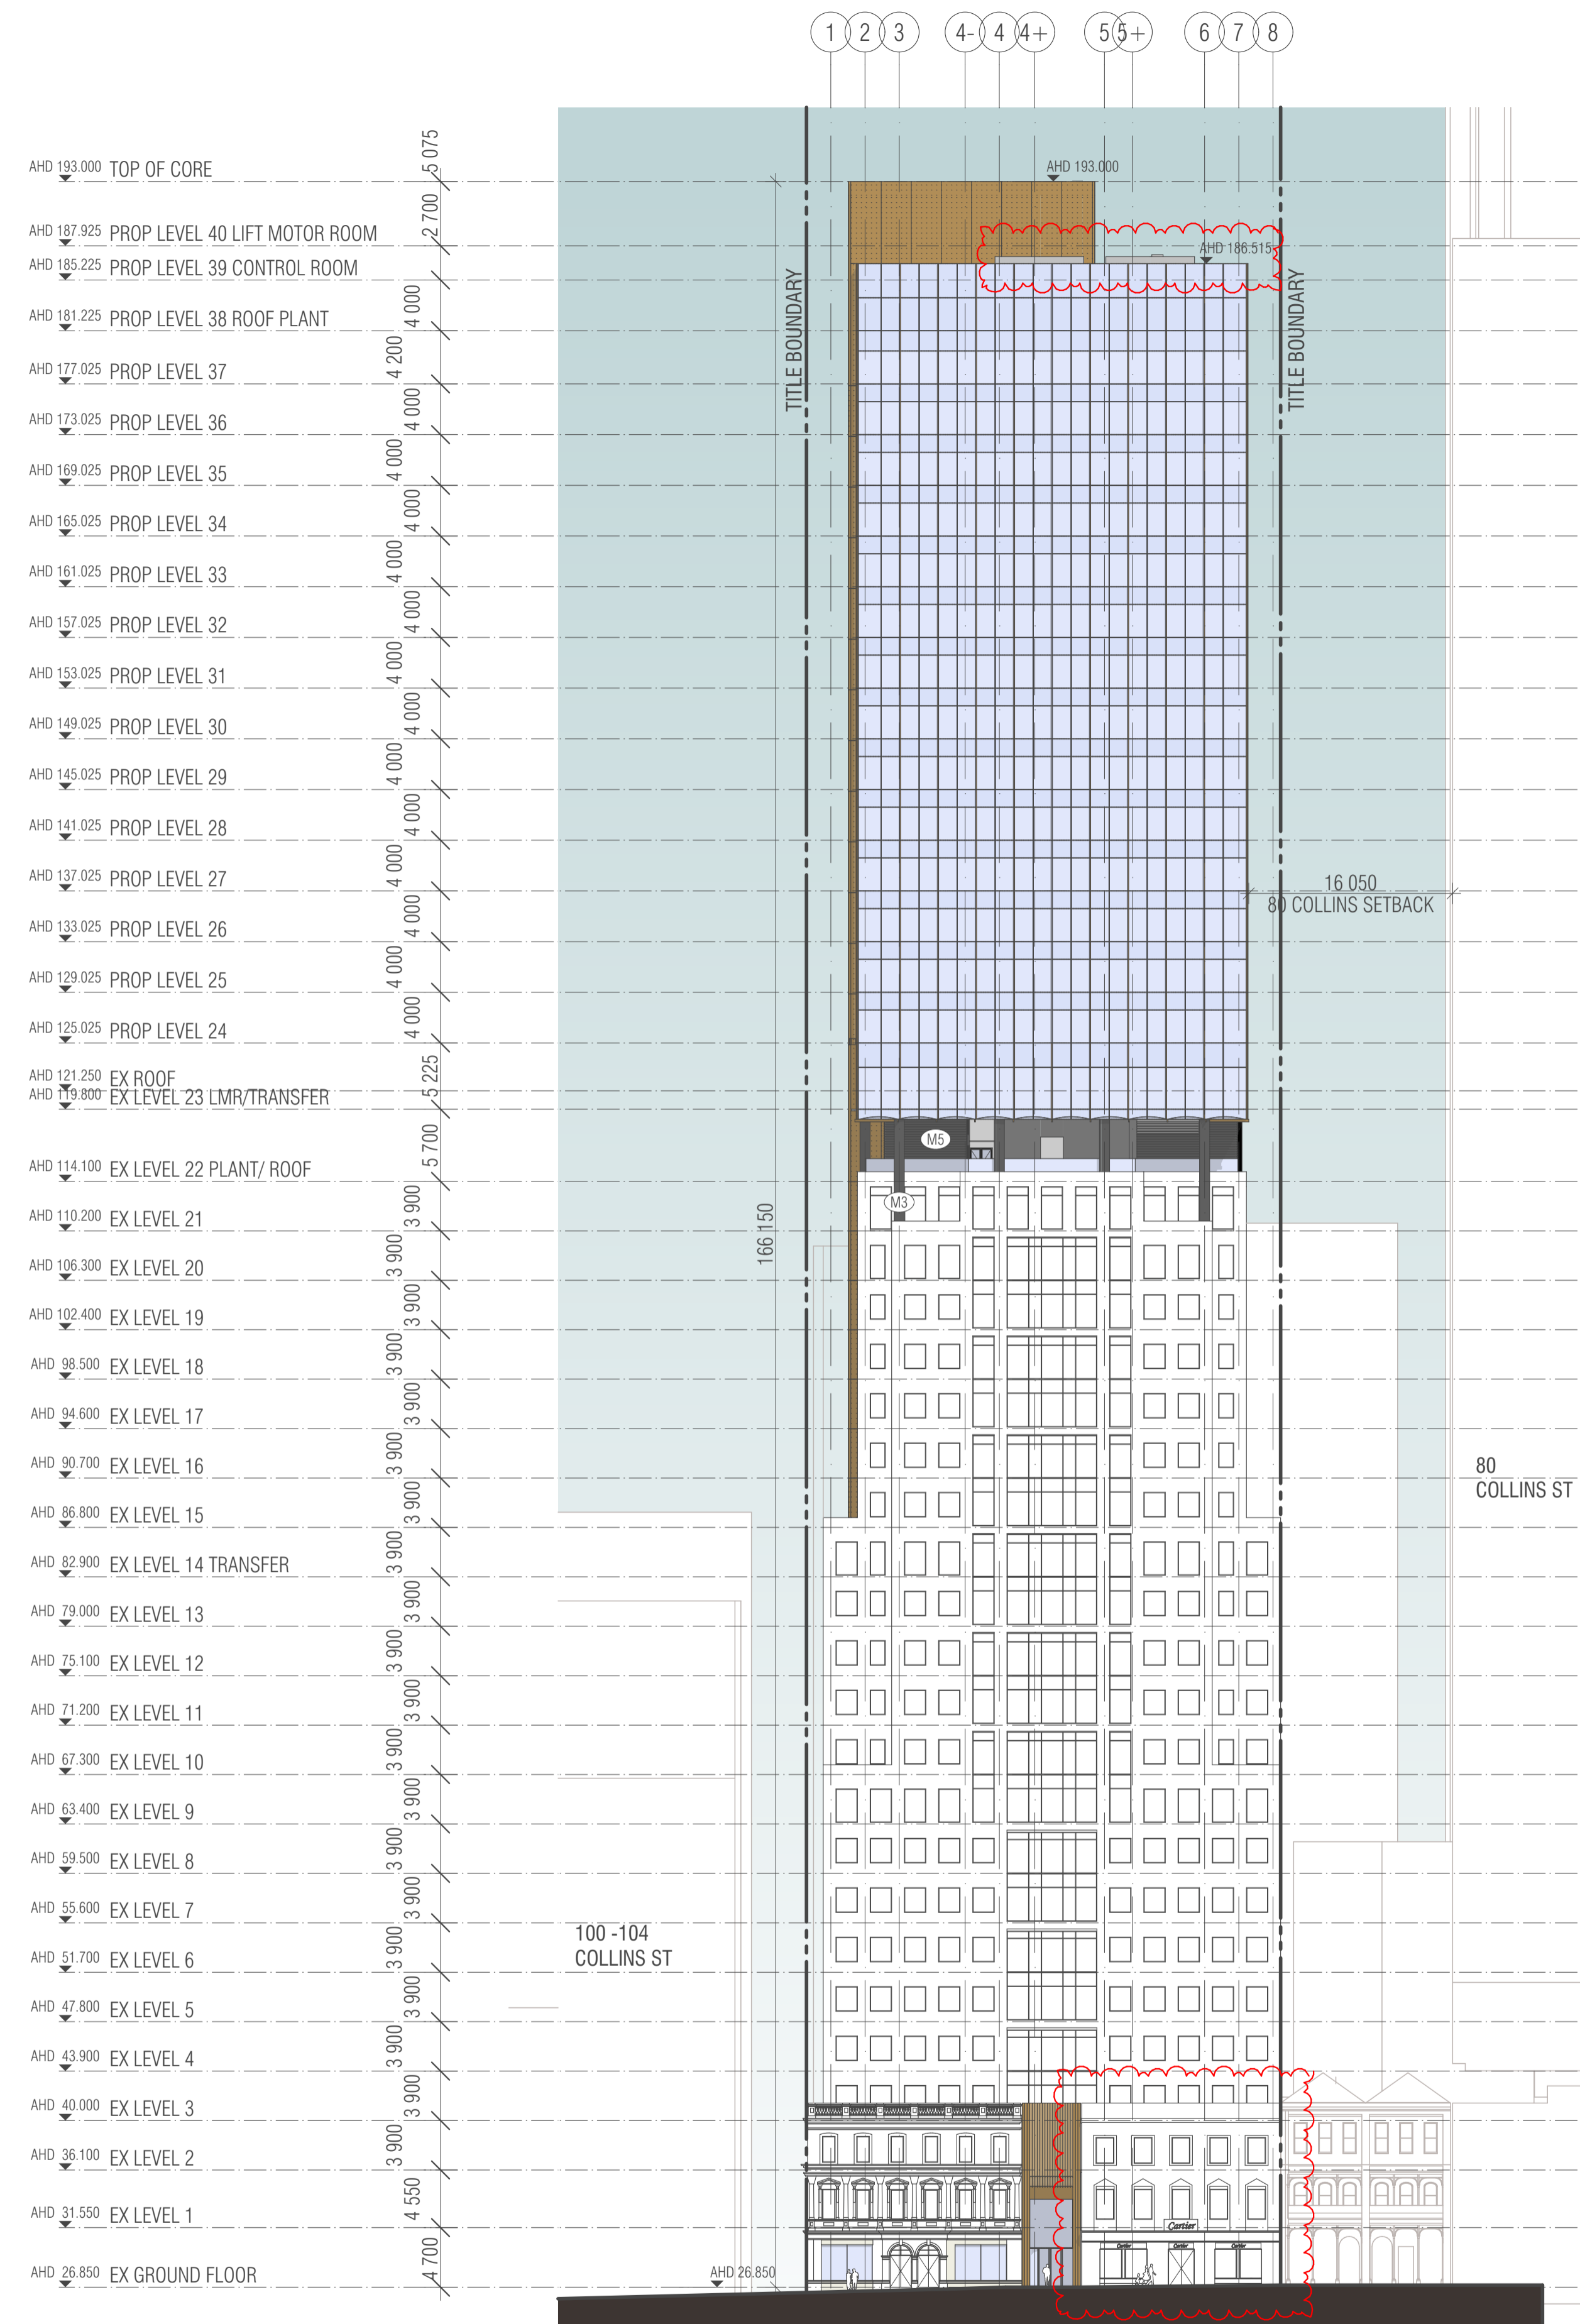

PROPOSED SOUTH ELEVATION  
SCALE 1:375@A1

BIMcloud: FK BIMCLOUD - BIMcloud\18155 90 Collins Street Melbourne\00 MODEL\OD - CD\BIM MODEL\18155 General

REVISION	DESCRIPTION	DATE
-	TOWN PLANNING ISSUE 01	16.12.2021
01	TOWN PLANNING SUBMISSION 02	10.06.2022
> 02	TOWN PLANNING SUBMISSION 03	15.07.2022

REVISION

QUALITY ASSURANCE (FK IS A CERTIFIED COMPANY TO ISO 9001:2015)

- THIS PROJECT IS SUBJECT TO THE FK QUALITY ASSURANCE SYSTEM
- SCHEMATIC DESIGN REVIEW FOR THIS PROJECT IS YET TO BE COMPLETED.
  - DESIGN DEVELOPMENT REVIEW FOR THIS PROJECT IS YET TO BE COMPLETED.
  - TENDER DOCUMENTATION REVIEW FOR THIS PROJECT IS YET TO BE COMPLETED.
  - CONSTRUCTION DOCUMENTATION REVIEW FOR THIS DRAWING IS YET TO BE COMPLETED.
- IF THIS DRAWING IS STAMPED UNCONTROLLED COPY THEN IT IS TO BE CONSIDERED A DRAFT. SUBJECT TO REVISION WITHOUT NOTICE

NOTES

THIS DRAWING IS COPYRIGHT AND SHALL REMAIN THE PROPERTY OF FENDER KATSALIDIS (AUST) PTY LTD. CHECK AND VERIFY ALL DIMENSIONS ON SITE PRIOR TO COMMENCING WORK. DRAWING TO BE READ IN CONJUNCTION WITH ALL OTHER CONTRACT DOCUMENTS. DO NOT SCALE DRAWINGS. USE FIGURED DIMENSIONS ONLY. SEEK CLARIFICATION OF INCONSISTENCIES / CONFLICTS.

DRAWN	DATE	CHECKED	PLOT DATE	JOB NO.	SCALE	DRAWING TITLE
WTK	15.07.2022	JV	21.07.2022	18155	AS SHOWN@A1	PROPOSED SOUTH ELEVATION

PROJECT  
90 COLLINS REDEVELOPMENT  
90 COLLINS STREET  
MELBOURNE VIC 3000




FENDER KATSALIDIS  
WWW.FKAUSTRALIA.COM  
2 RIVERSIDE QUAY, SOUTH BANK  
VICTORIA 3006 AUSTRALIA  
TELEPHONE: +61 3 8696 3888  
FENDER KATSALIDIS (AUST) PTY LTD ACN 092 943 032




ISSUE PURPOSE  
TOWN PLANNING

REV. 02  
DRAWING NO. TP400



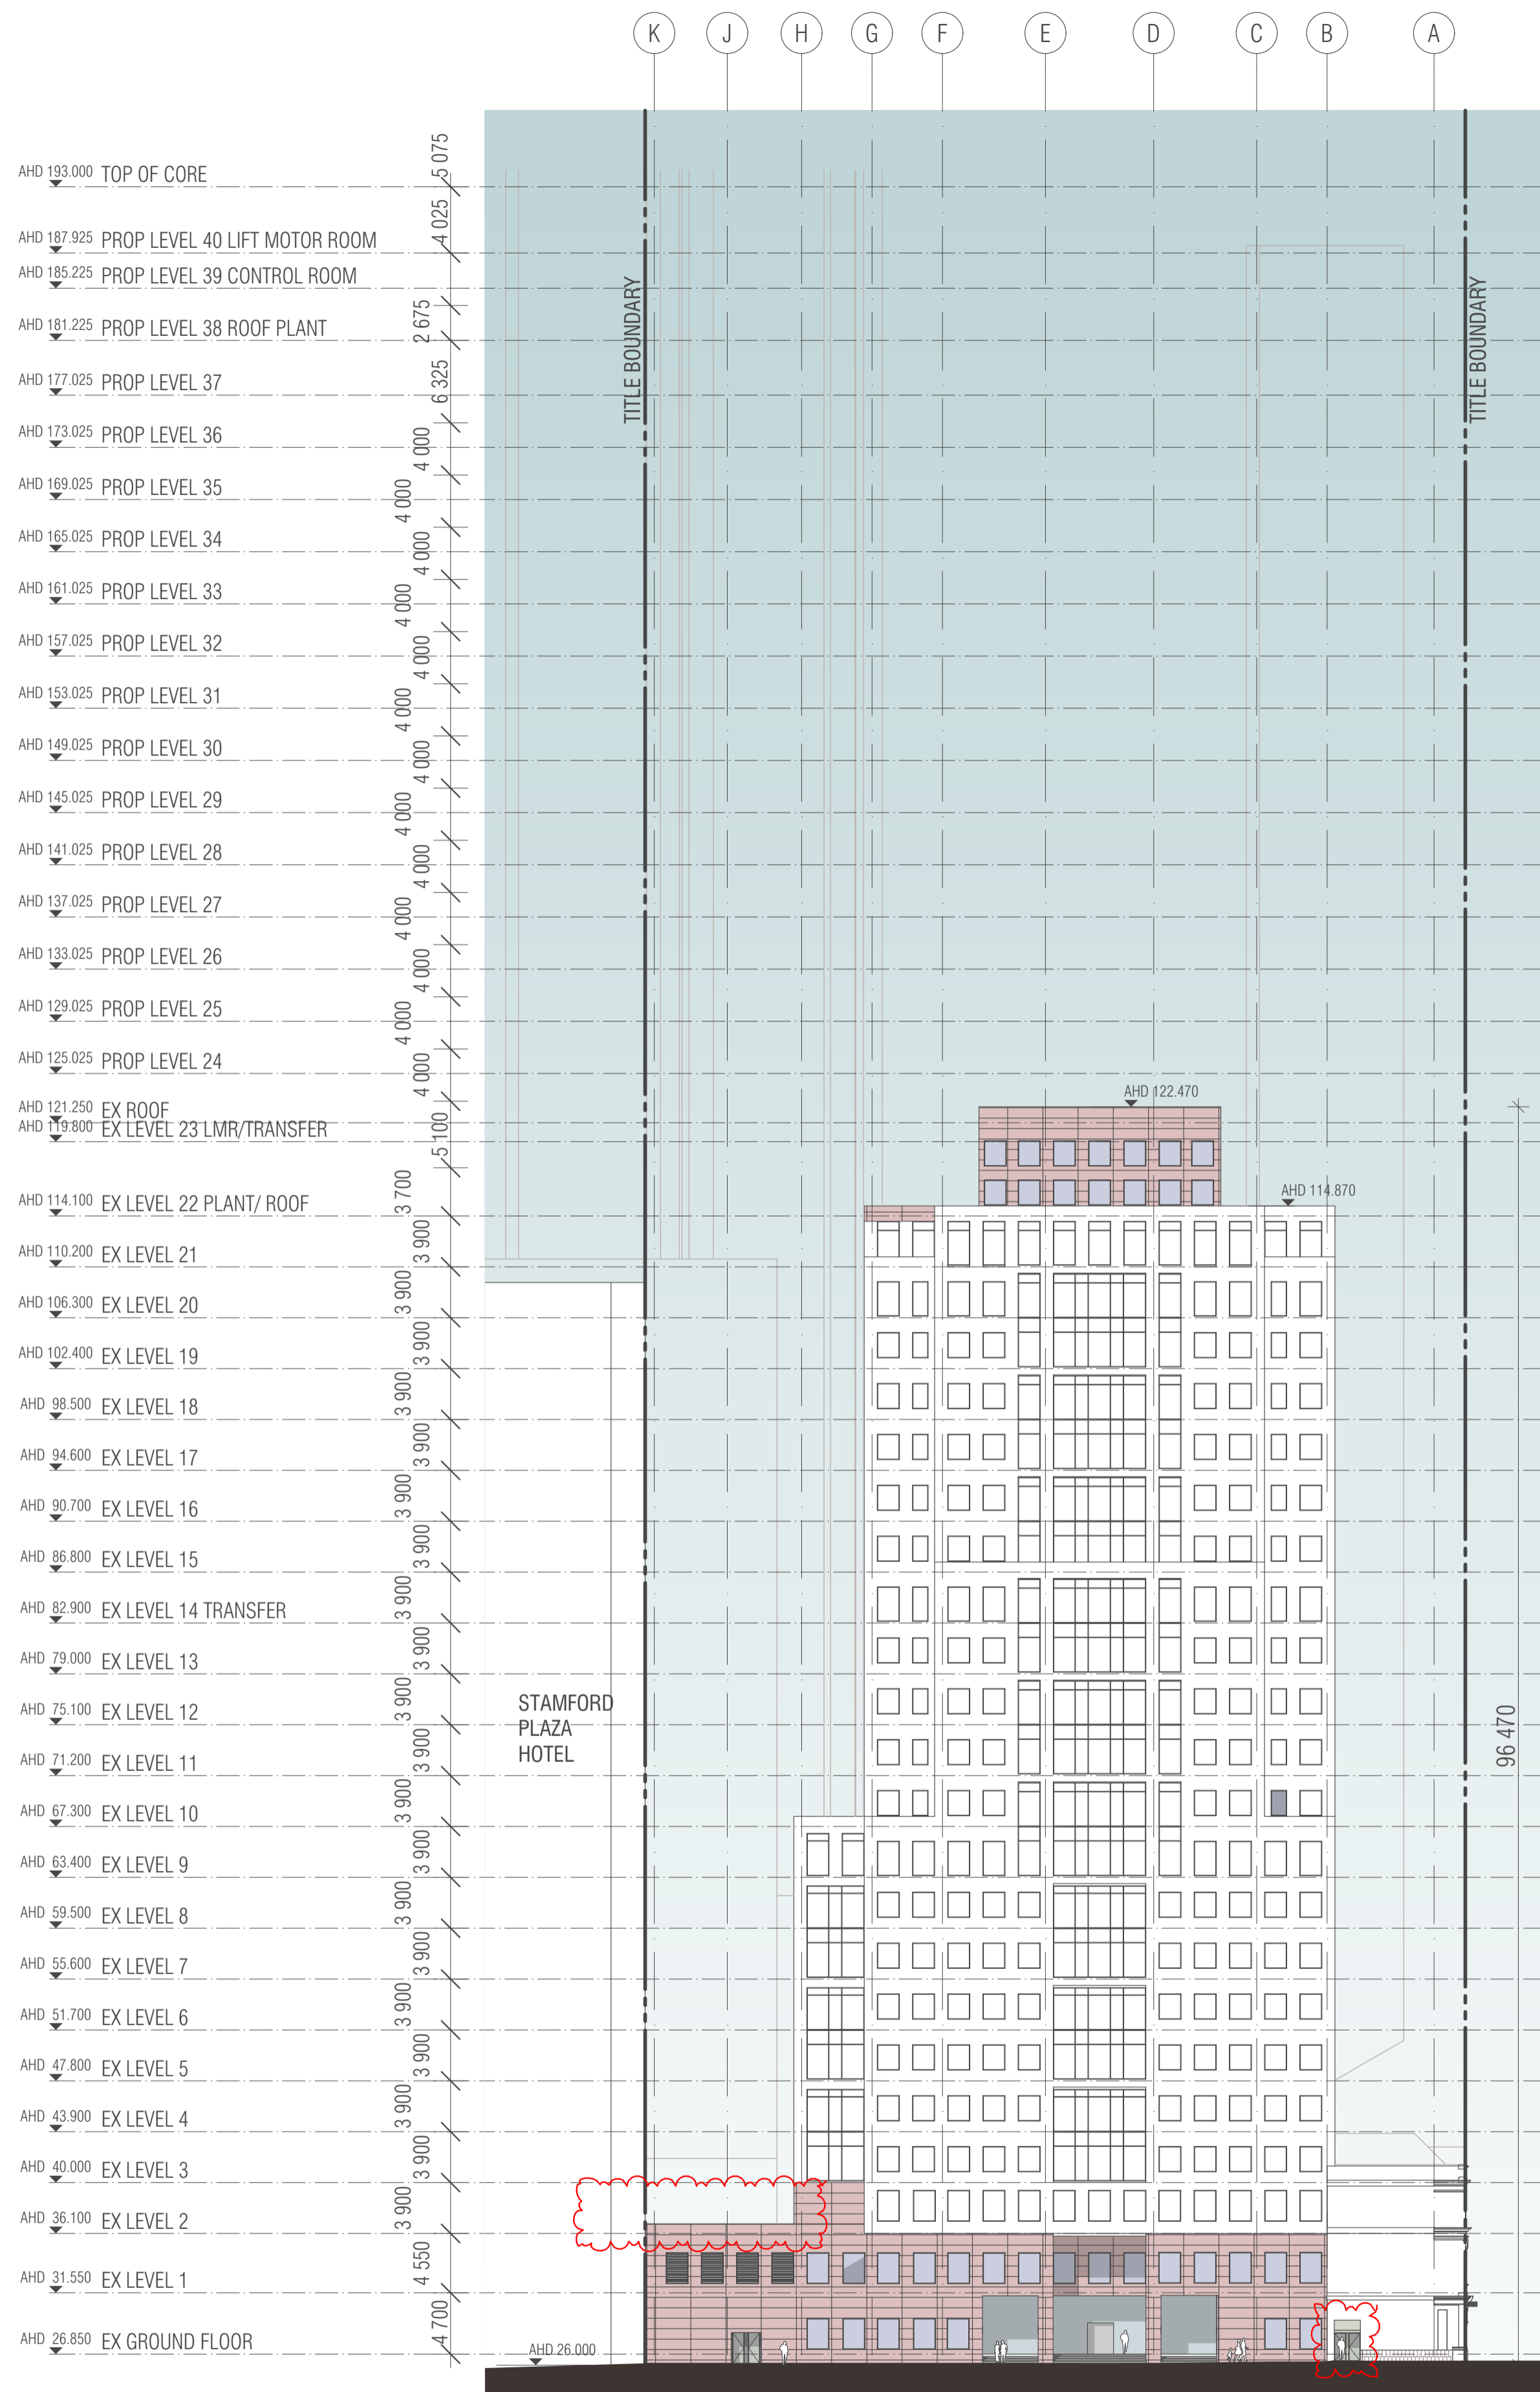


W EXISTING WEST ELEVATION  
SCALE 1:375@A1

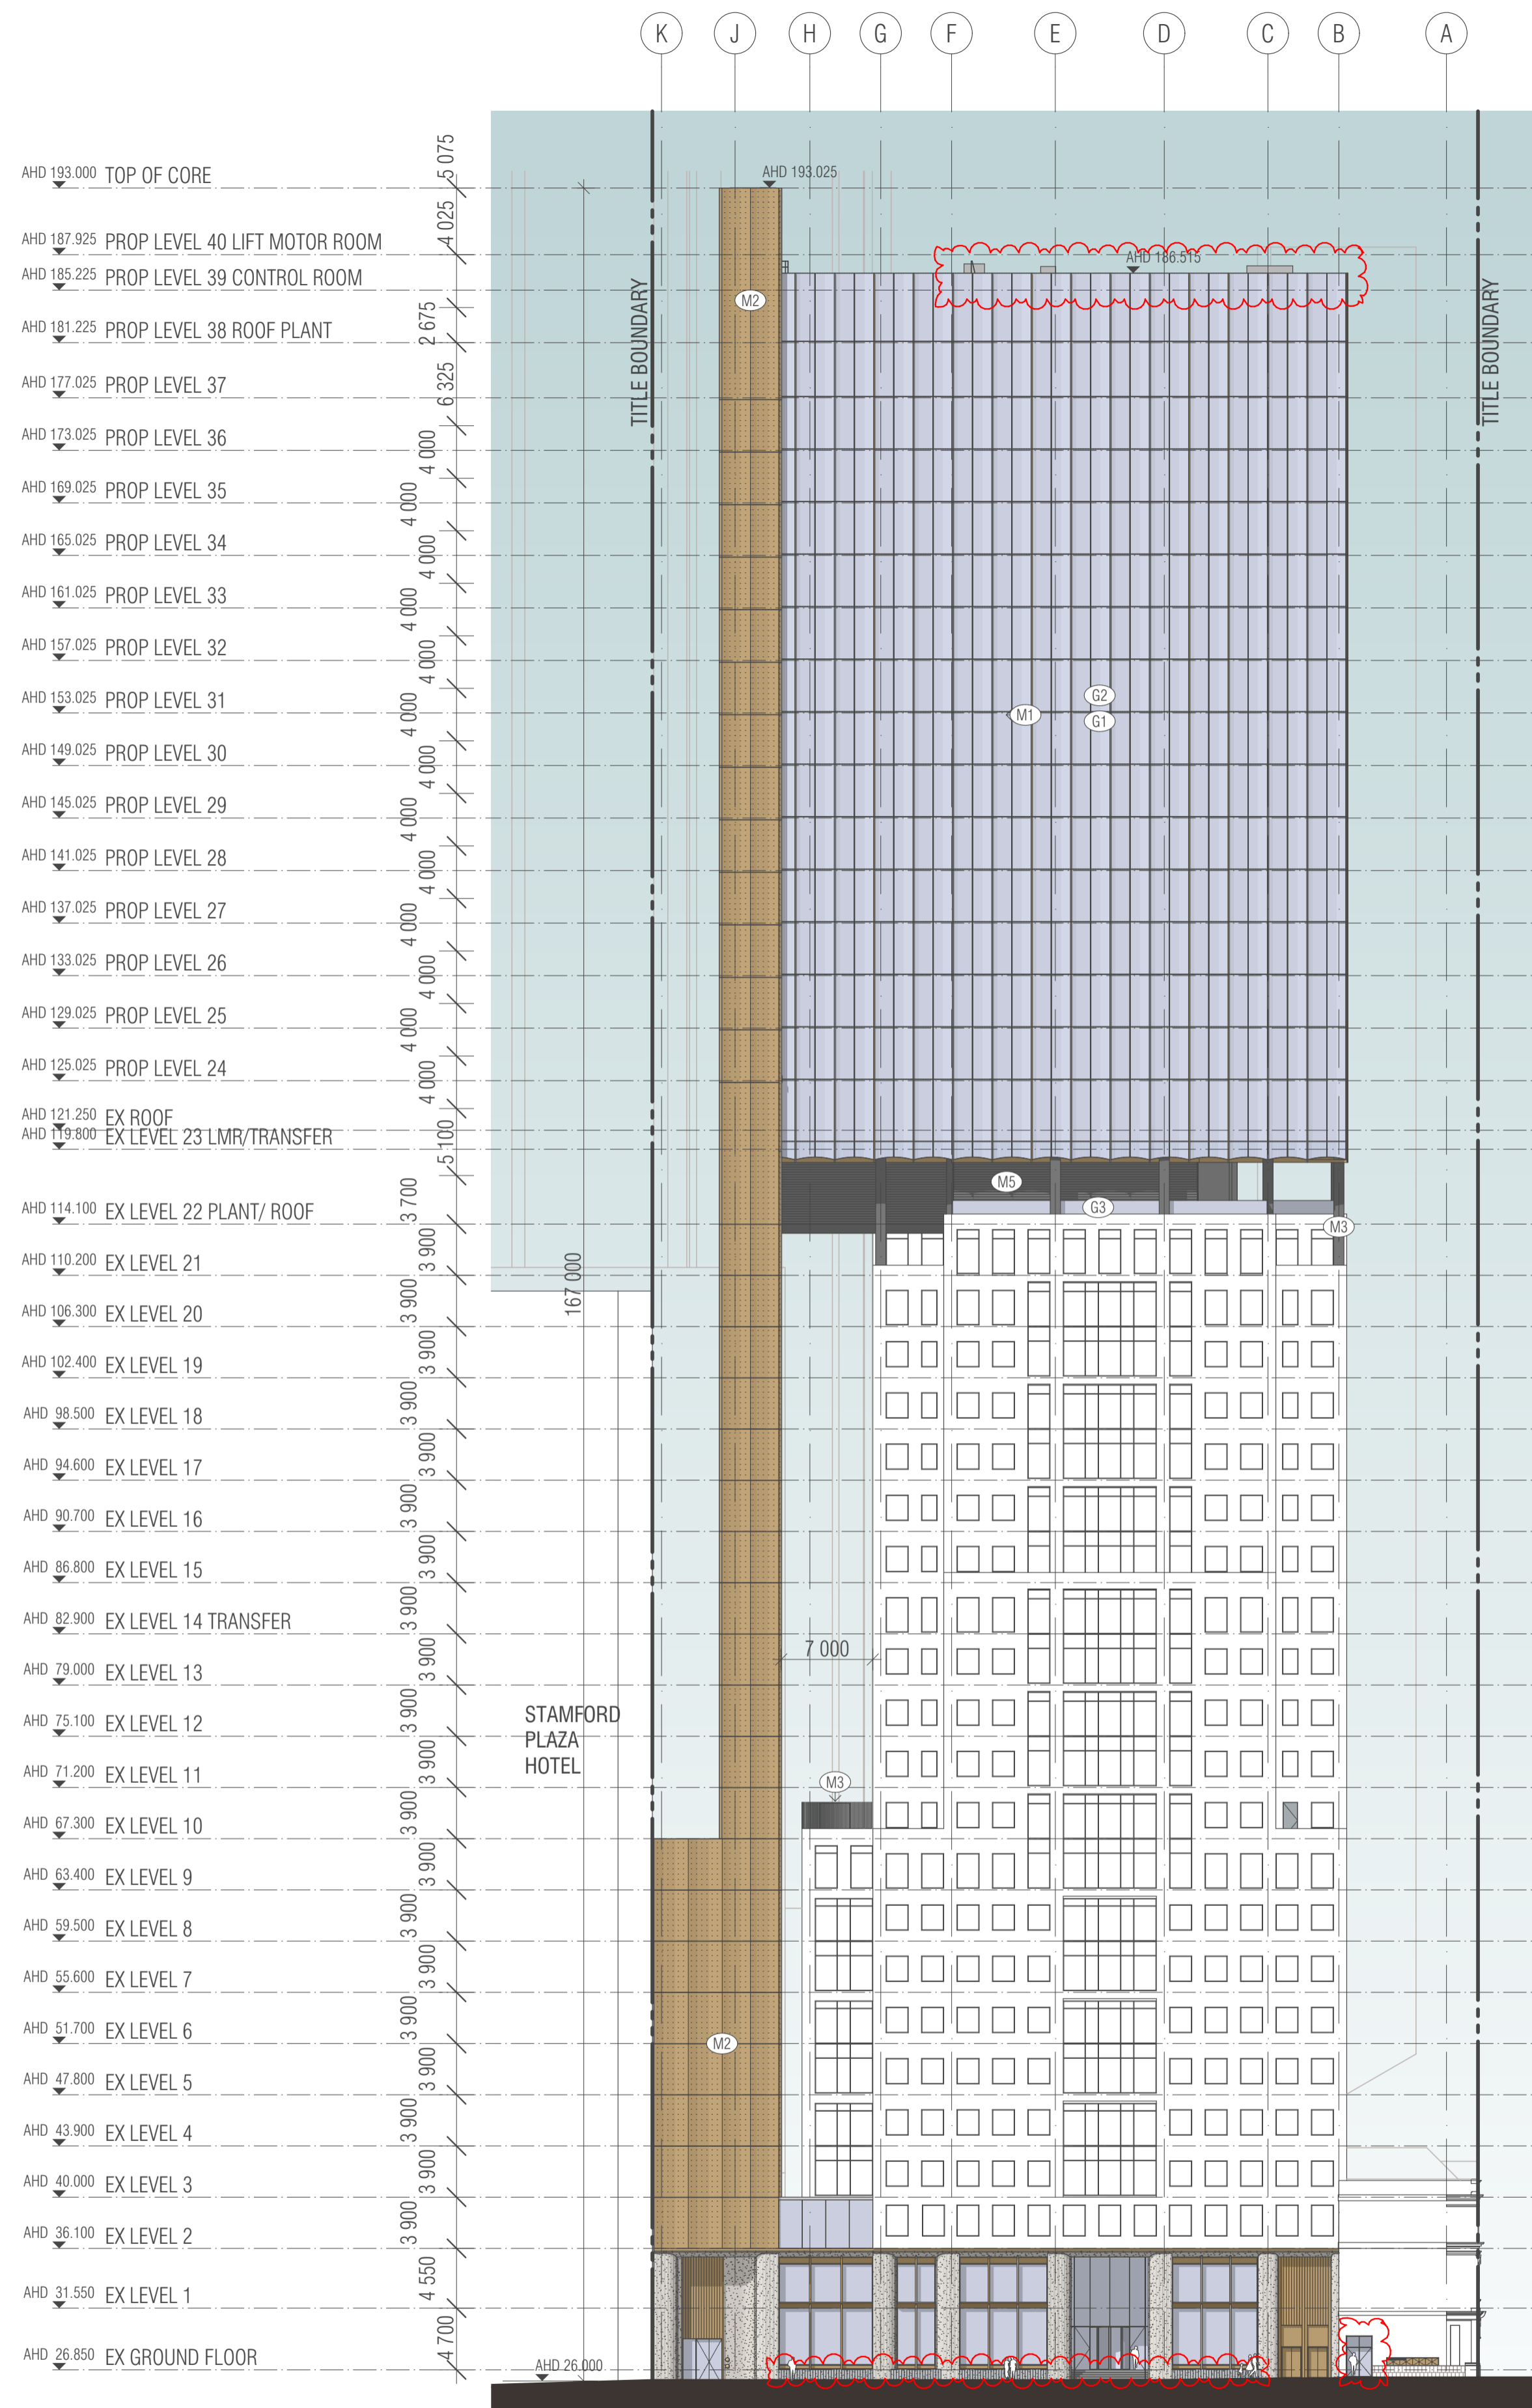

W PROPOSED WEST ELEVATION  
SCALE 1:375@A1

KEY PLAN

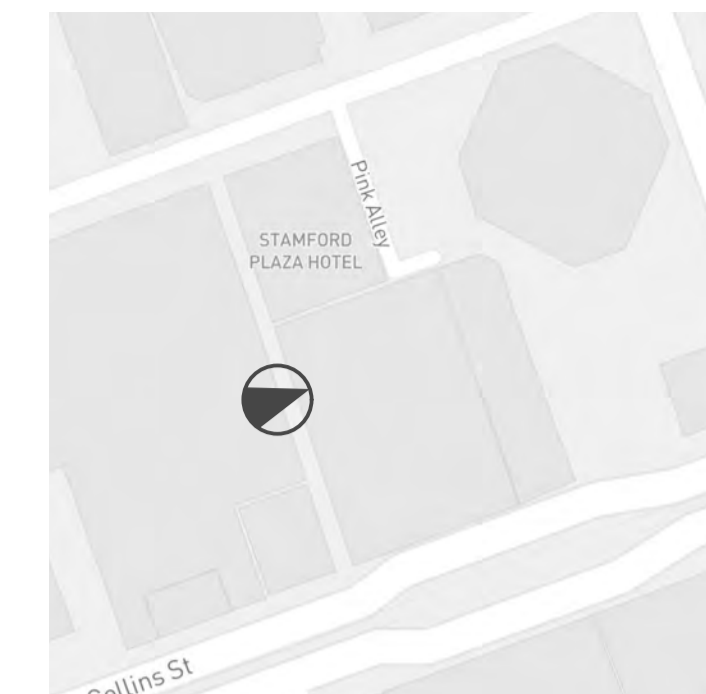

ELEVATIONS LEGEND

- G1 GLASS - SILVER GREY
- G2 GLASS - SILVER GREY SPANDREL
- G3 GLASS - CLEAR
- M1 METAL CLADDING - COPPER COLOUR
- M2 METAL CLADDING - COPPER COLOUR RAINSCREEN
- M3 METAL CLADDING - CHARCOAL COLOUR
- M4 METAL CLADDING - CHARCOAL PERFORATED
- M5 METAL LOUVRES - CHARCOAL COLOUR
- C1 POLISHED CONCRETE LOOK FINISH (OFF WHITE)
- C2 CONCRETE - GREY
- S1 BLUESTONE LOOK
- P1 HERITAGE FACADE PAINT COLOR

CHANGES HIGHLIGHTED IN COLOUR TO EXISTING & PROPOSED ELEVATIONS

BIMcloud: FK BIMCLOUD - BIMcloud\18155 90 Collins Street Melbourne\00 MODEL\00-CD\BIM MODEL\18155 General

REVISION	DESCRIPTION	DATE	BY
01	TOWN PLANNING ISSUE 01	16.12.2021	WTK
02	TOWN PLANNING SUBMISSION 02	10.06.2022	WTK
03	TOWN PLANNING SUBMISSION 03	15.07.2022	WTK

REVISION

QUALITY ASSURANCE (FK IS A CERTIFIED COMPANY TO ISO 9001:2015)

THIS PROJECT IS SUBJECT TO THE FK QUALITY ASSURANCE SYSTEM

- SCHEMATIC DESIGN REVIEW FOR THIS PROJECT IS YET TO BE COMPLETED.
- DESIGN DEVELOPMENT REVIEW FOR THIS PROJECT IS YET TO BE COMPLETED.
- TENDER DOCUMENTATION REVIEW FOR THIS PROJECT IS YET TO BE COMPLETED.
- CONSTRUCTION DOCUMENTATION REVIEW FOR THIS DRAWING IS YET TO BE COMPLETED.

IF THIS DRAWING IS STAMPED UNCONTROLLED COPY THEN IT IS TO BE CONSIDERED A DRAFT. SUBJECT TO REVISION WITHOUT NOTICE

NOTES

THIS DRAWING IS COPYRIGHT AND SHALL REMAIN THE PROPERTY OF FENDER KATSALIDIS (AUST) PTY LTD. CHECK AND VERIFY ALL DIMENSIONS ON SITE PRIOR TO COMMENCING WORK. DRAWING TO BE READ IN CONJUNCTION WITH ALL OTHER CONTRACT DOCUMENTS. DO NOT SCALE DRAWINGS. USE FIGURED DIMENSIONS ONLY. SEEK CLARIFICATION OF INCONSISTENCIES / CONFLICTS.

DRAWN	DATE	CHECKED	PLOT DATE	JOB NO.	SCALE
WTK	15.07.2022	JV	21.07.2022	18155	AS SHOWN@A1

PROJECT

90 COLLINS REDEVELOPMENT  
90 COLLINS STREET  
MELBOURNE VIC 3000

DRAWING TITLE
PROPOSED WEST ELEVATION




**FENDER KATSALIDIS**  
WWW.FKAUSTRALIA.COM  
2 RIVERSIDE QUAY, SOUTH BANK  
VICTORIA 3006 AUSTRALIA  
TELEPHONE: +61 3 8696 3888  
FENDER KATSALIDIS (AUST) PTY LTD ACN 092 943 032

ISSUE PURPOSE
TOWN PLANNING




REV.	DRAWING NO.
02	TP401



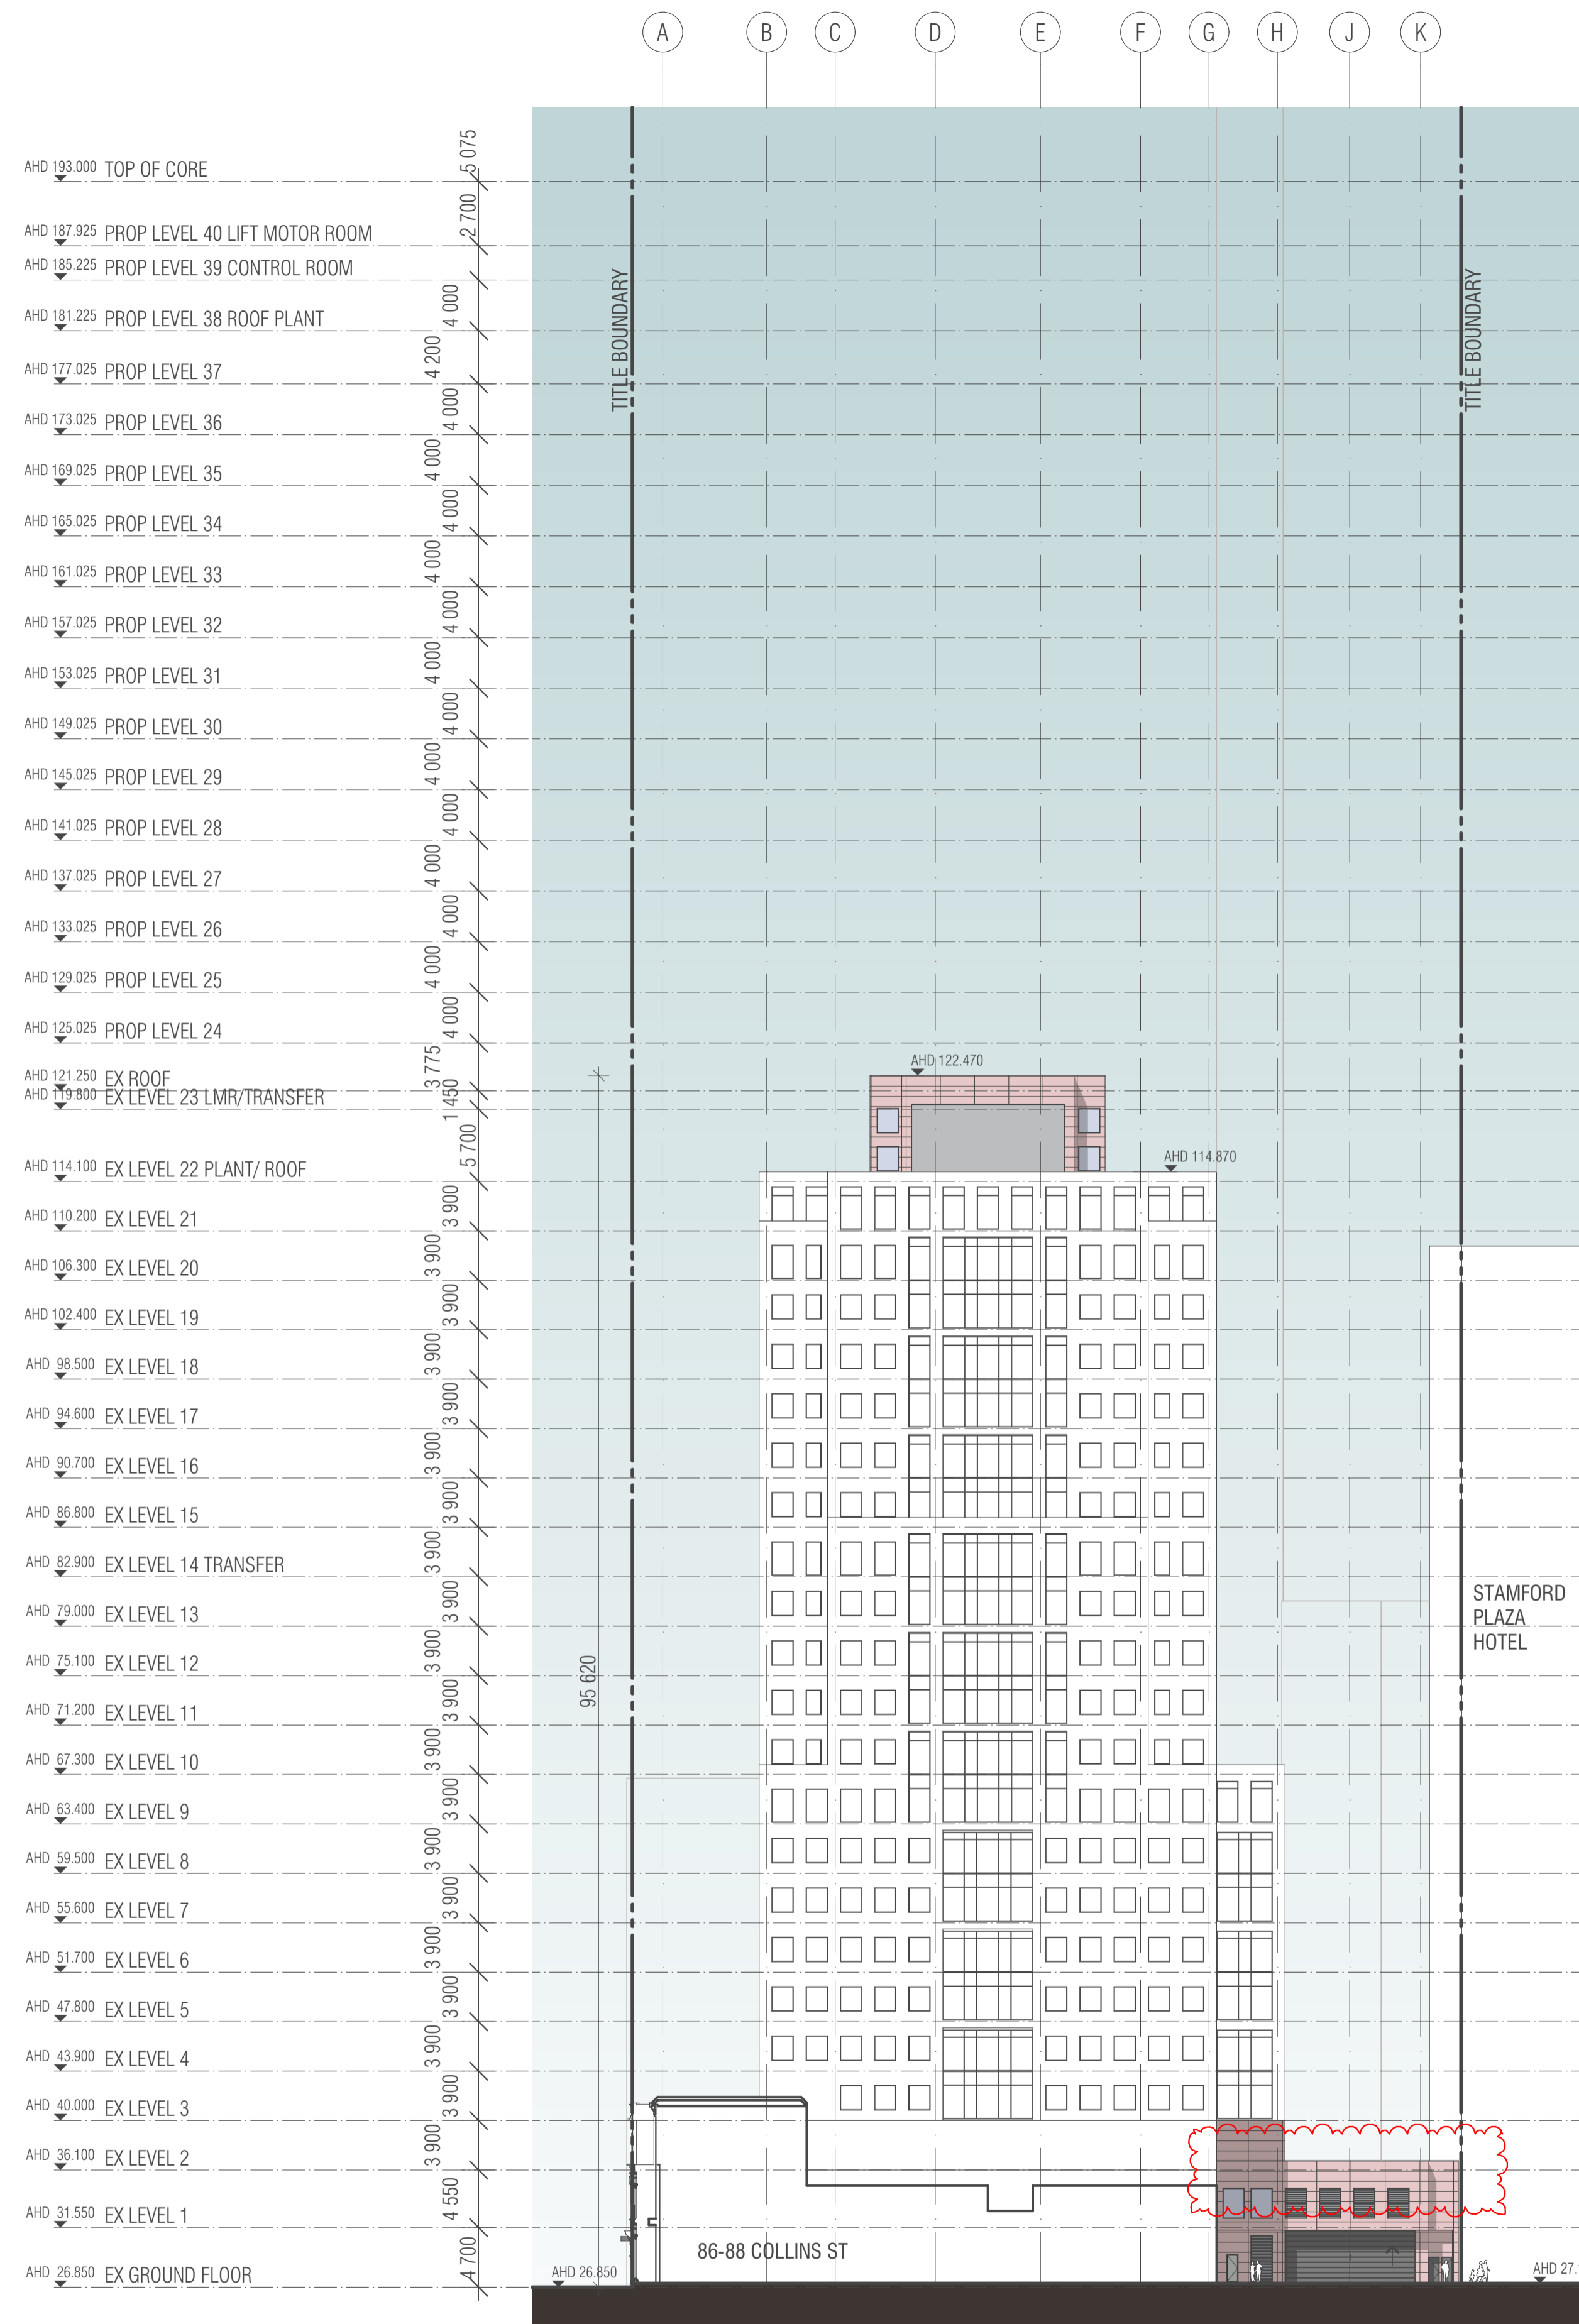


**E** EXISTING EAST ELEVATION  
SCALE 1:375@A1

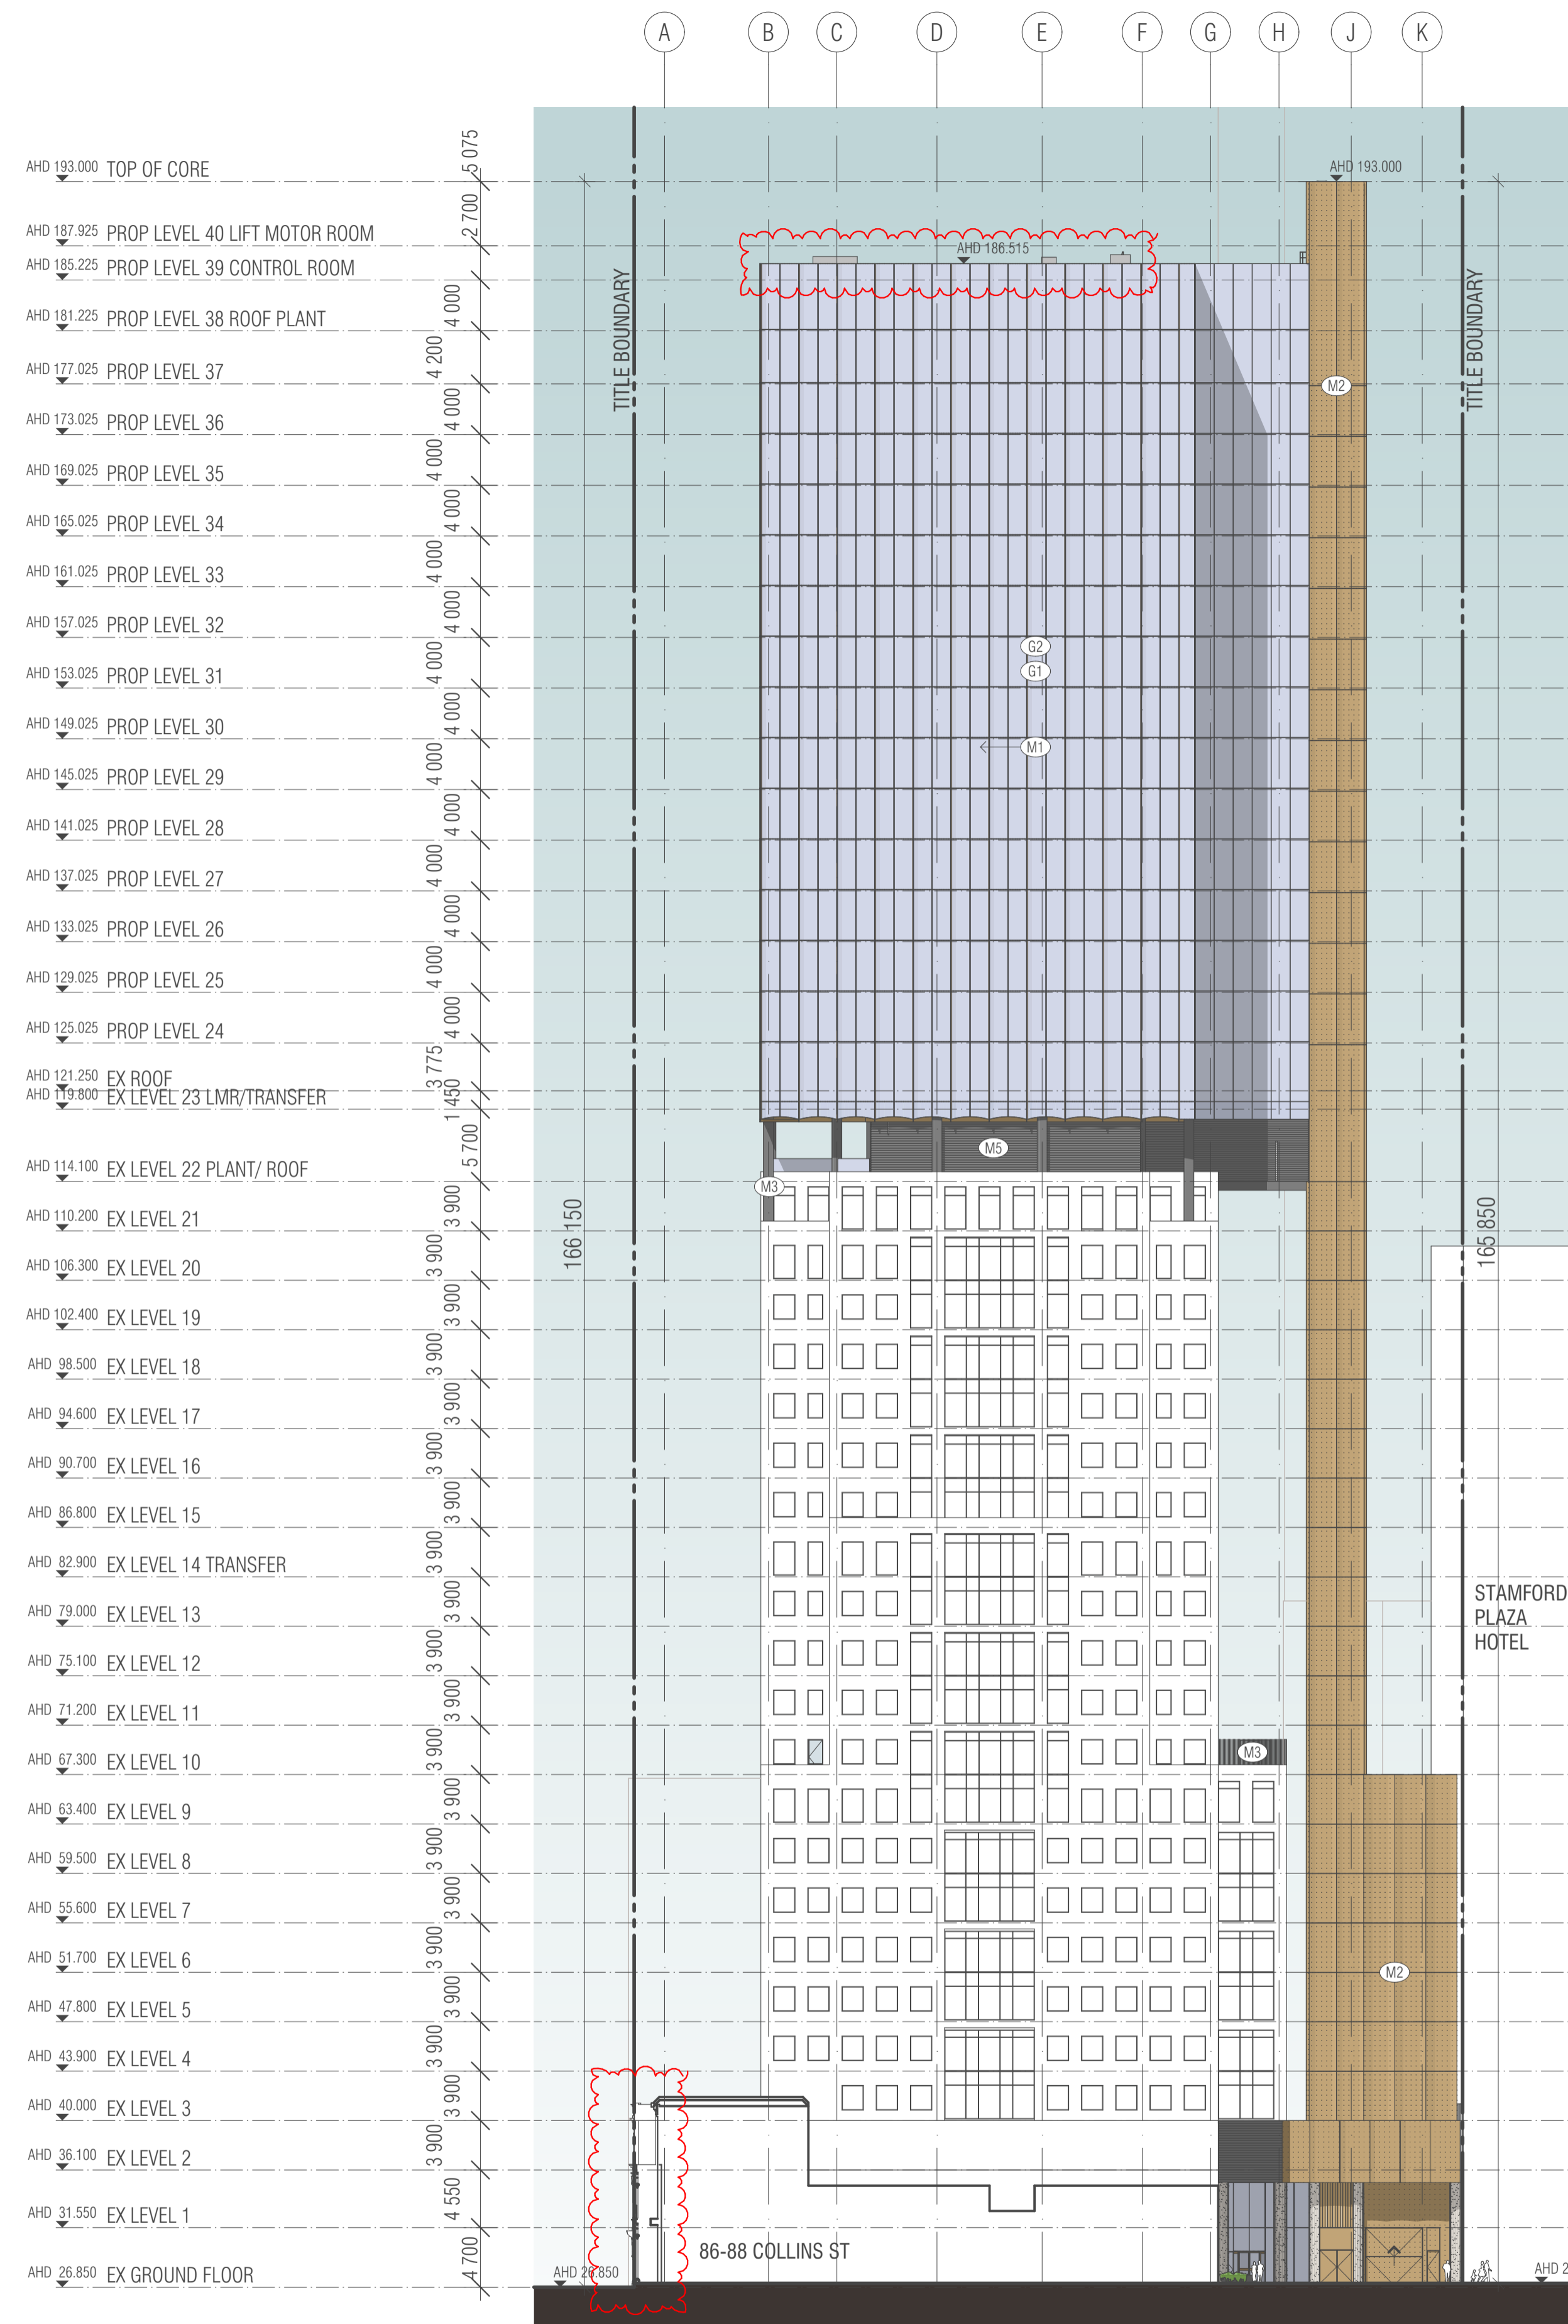

**E** PROPOSED EAST ELEVATION  
SCALE 1:375@A1

→ KEY PLAN

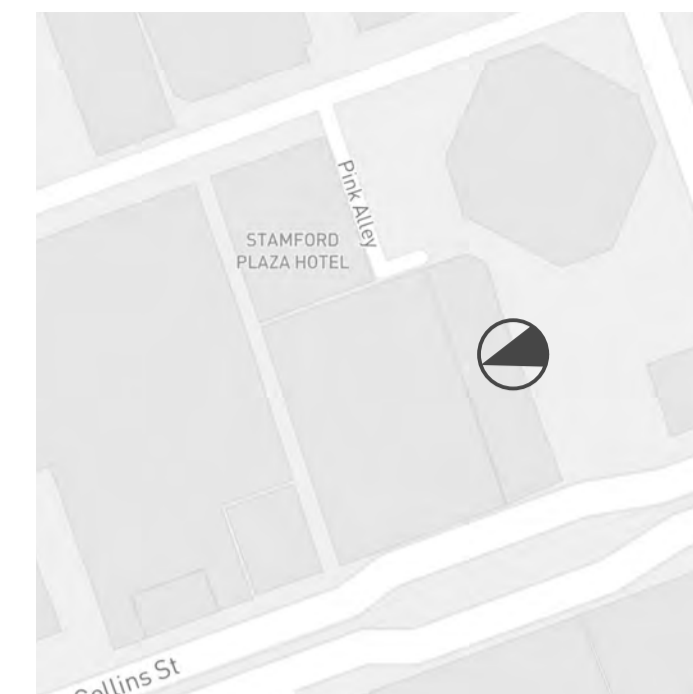

→ ELEVATIONS LEGEND

- G1 GLASS - SILVER GREY
- G2 GLASS - SILVER GREY SPANDREL
- G3 GLASS - CLEAR
- M1 METAL CLADDING - COPPER COLOUR
- M2 METAL CLADDING - COPPER COLOUR RAINSCREEN
- M3 METAL CLADDING - CHARCOAL COLOUR
- M4 METAL CLADDING - CHARCOAL PERFORATED
- M5 METAL LOUVRES - CHARCOAL COLOUR
- C1 POLISHED CONCRETE LOOK FINISH (OFF WHITE)
- C2 CONCRETE - GREY
- S1 BLUESTONE LOOK
- P1 HERITAGE FACADE PAINT COLOR

→ CHANGES HIGHLIGHTED IN COLOUR TO EXISTING & PROPOSED ELEVATIONS

BIMcloud: FK BIMCLOUD - BIMcloud\18155 90 Collins Street Melbourne\00 MODEL\00 - CD\BIM MODEL\18155 General

REVISION	DESCRIPTION	DATE
01	TOWN PLANNING ISSUE 01	16.12.2021
02	TOWN PLANNING SUBMISSION 02	10.06.2022
03	TOWN PLANNING SUBMISSION 03	15.07.2022

REVISION	DESCRIPTION	DATE
01	TOWN PLANNING ISSUE 01	16.12.2021
02	TOWN PLANNING SUBMISSION 02	10.06.2022
03	TOWN PLANNING SUBMISSION 03	15.07.2022

**QUALITY ASSURANCE** (FK IS A CERTIFIED COMPANY TO ISO 9001:2015)  
THIS PROJECT IS SUBJECT TO THE FK QUALITY ASSURANCE SYSTEM

- SCHEMATIC DESIGN REVIEW FOR THIS PROJECT IS YET TO BE COMPLETED.
- DESIGN DEVELOPMENT REVIEW FOR THIS PROJECT IS YET TO BE COMPLETED.
- TENDER DOCUMENTATION REVIEW FOR THIS PROJECT IS YET TO BE COMPLETED.
- CONSTRUCTION DOCUMENTATION REVIEW FOR THIS DRAWING IS YET TO BE COMPLETED.

IF THIS DRAWING IS STAMPED UNCONTROLLED COPY THEN IT IS TO BE CONSIDERED A DRAFT. SUBJECT TO REVISION WITHOUT NOTICE

**NOTES**  
THIS DRAWING IS COPYRIGHT AND SHALL REMAIN THE PROPERTY OF FENDER KATSAIDIS (AUST) PTY LTD  
CHECK AND VERIFY ALL DIMENSIONS ON SITE PRIOR TO COMMENCING WORK. DRAWING TO BE READ IN CONJUNCTION WITH ALL OTHER CONTRACT DOCUMENTS. DO NOT SCALE DRAWINGS. USE FIGURED DIMENSIONS ONLY. SEEK CLARIFICATION OF INCONSISTENCIES / CONFLICTS.

DRAWN	DATE	CHECKED	PLOT DATE	JOB NO.	SCALE
WTK	15.07.2022	JV	21.07.2022	18155	AS SHOWN@A1

**PROJECT**  
90 COLLINS REDEVELOPMENT  
90 COLLINS STREET  
MELBOURNE VIC 3000



**FENDER KATSAIDIS**  
WWW.FKAUSTRALIA.COM  
2 RIVERSIDE QUAY, SOUTH BANK  
VICTORIA 3006 AUSTRALIA  
TELEPHONE: +61 3 8696 3888  
FENDER KATSAIDIS (AUST) PTY LTD ACN 092 943 032




**ISSUE PURPOSE**  
TOWN PLANNING

**REV.** 02  
**DRAWING NO.** TP402




KEY PLAN

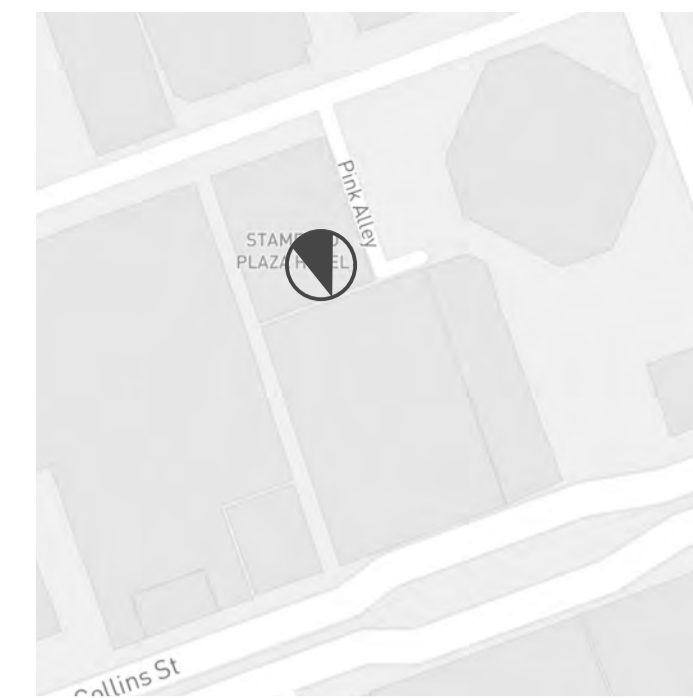


ELEVATIONS LEGEND

- G1 GLASS - SILVER GREY
- G2 GLASS - SILVER GREY SPANDREL
- G3 GLASS - CLEAR
- M1 METAL CLADDING - COPPER COLOUR
- M2 METAL CLADDING - COPPER COLOUR RAINSCREEN
- M3 METAL CLADDING - CHARCOAL COLOUR
- M4 METAL CLADDING - CHARCOAL PERFORATED
- M5 METAL LOUVRES - CHARCOAL COLOUR
- C1 POLISHED CONCRETE LOOK FINISH (OFF WHITE)
- C2 CONCRETE - GREY
- S1 BLUESTONE LOOK
- P1 HERITAGE FACADE PAINT COLOR

CHANGES HIGHLIGHTED IN COLOUR TO EXISTING & PROPOSED ELEVATIONS

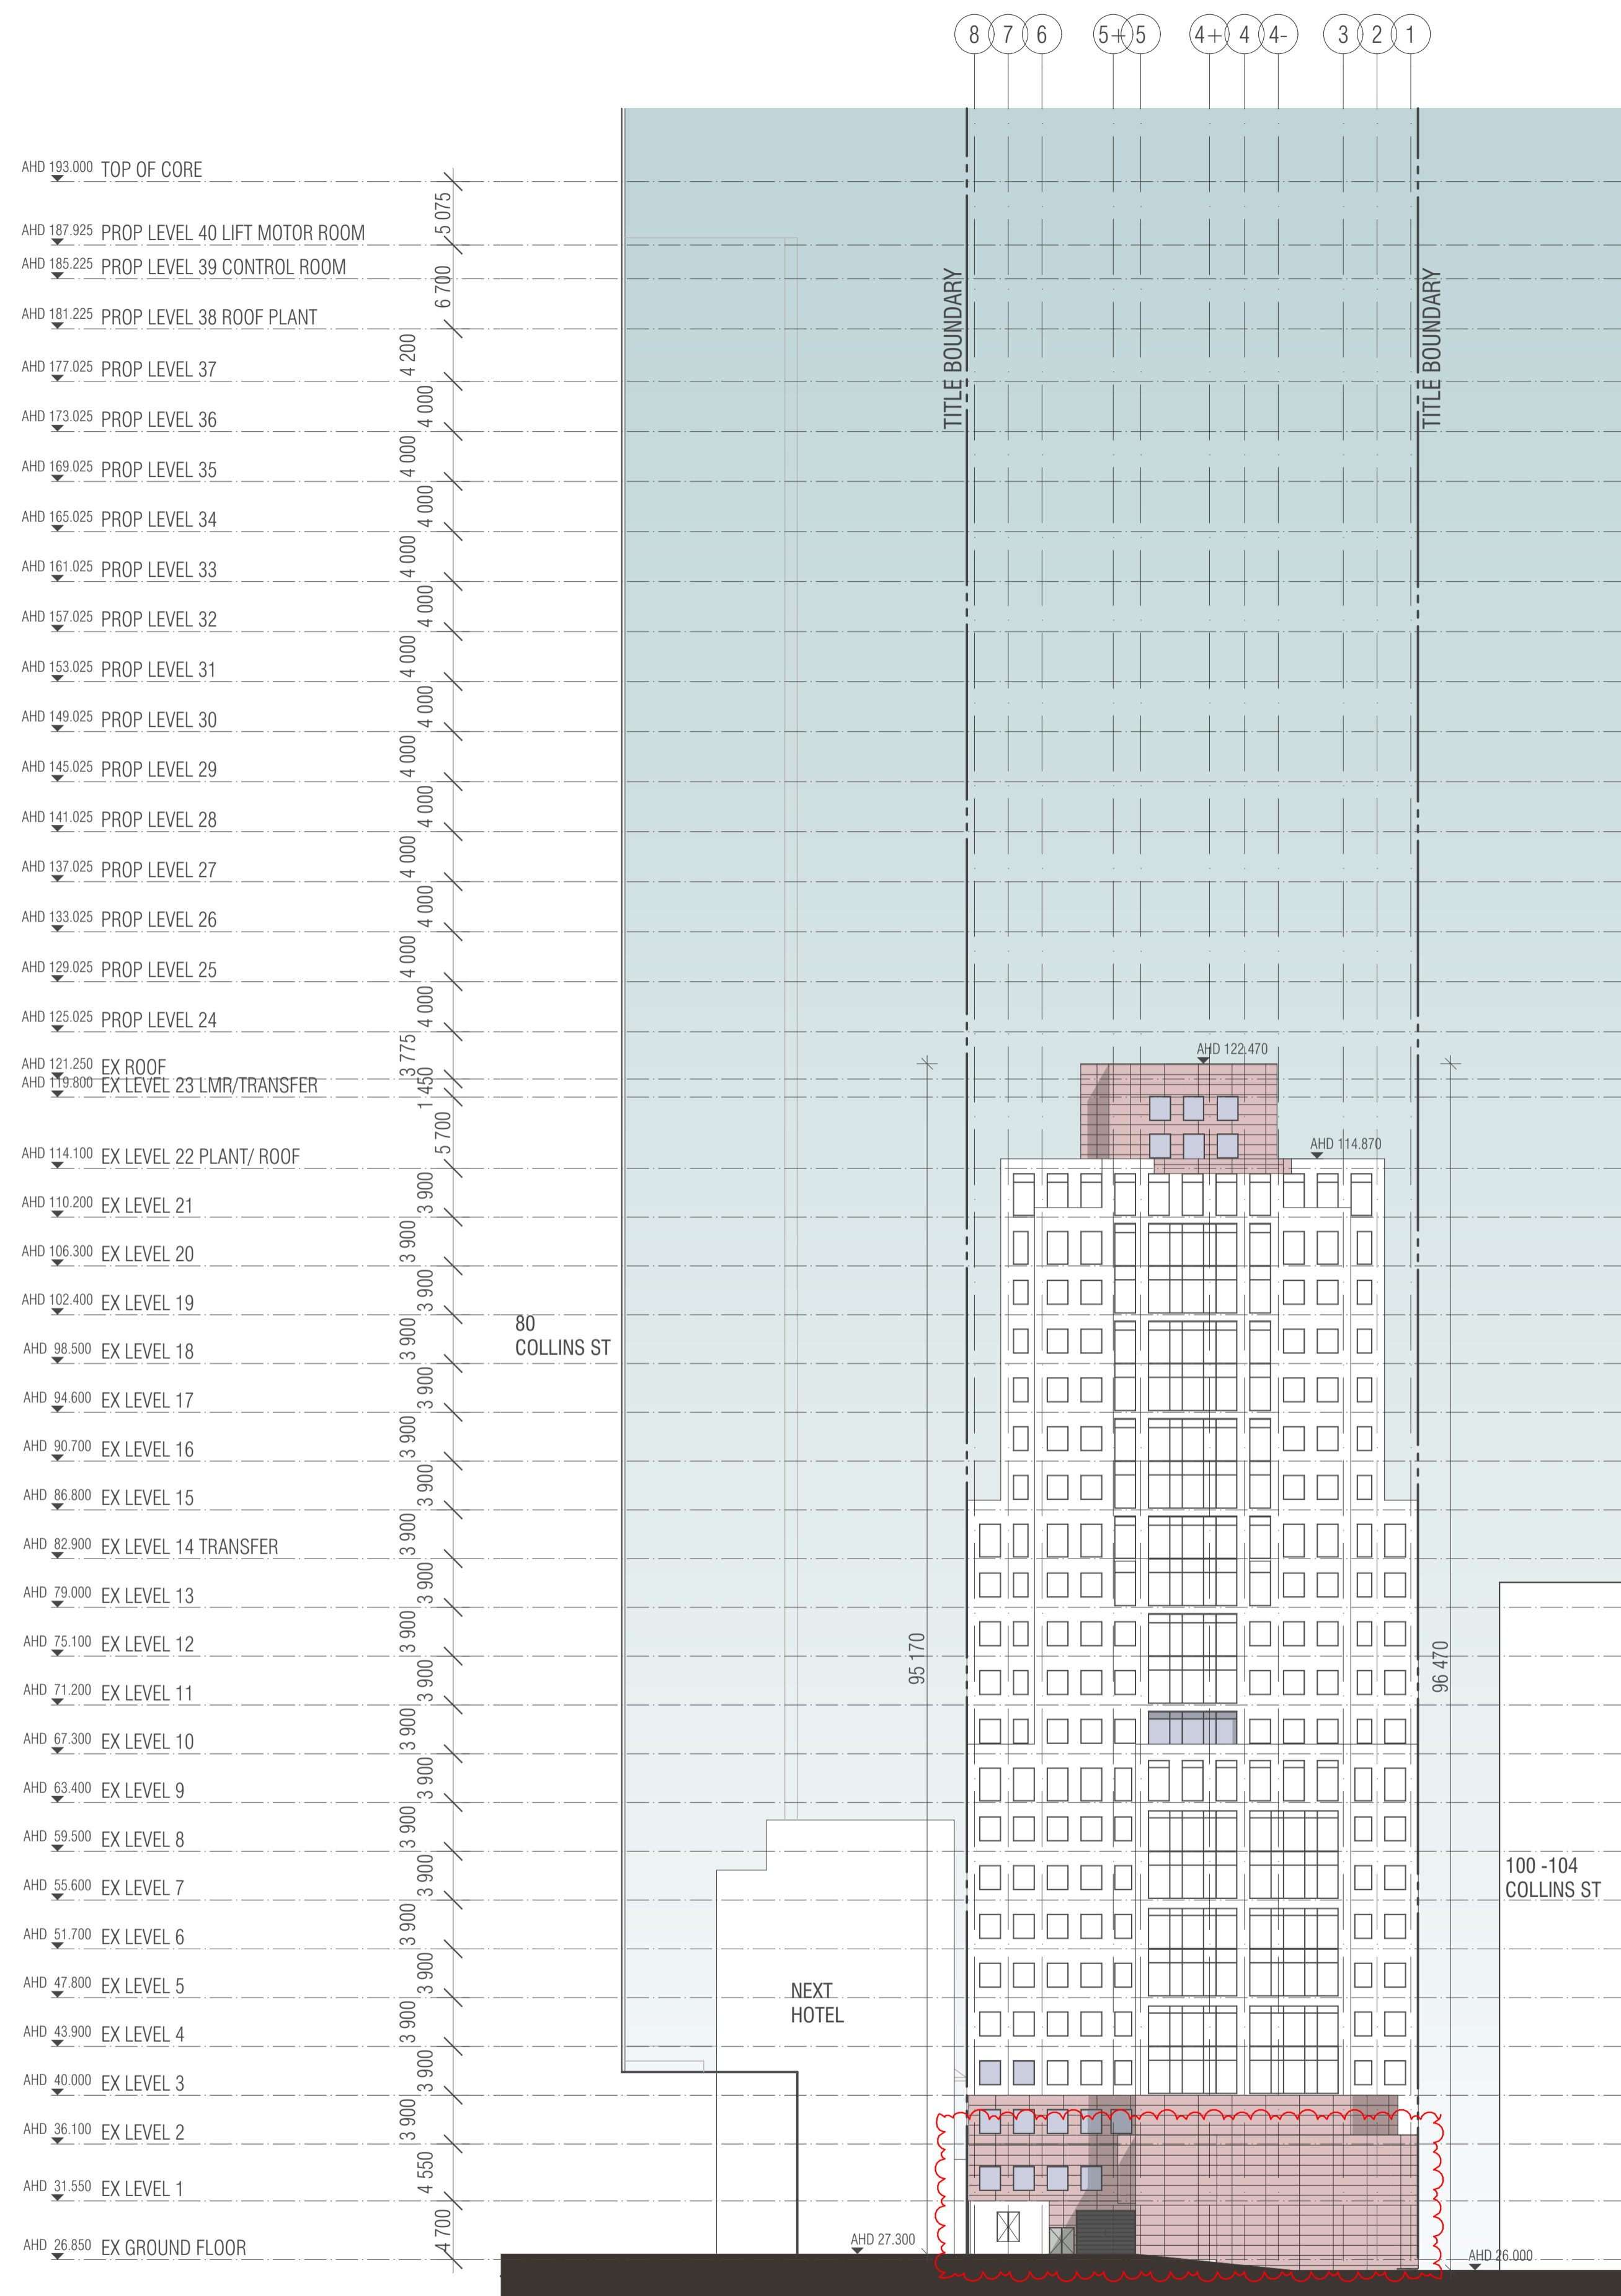

EXISTING NORTH ELEVATION  
SCALE 1:375@A1

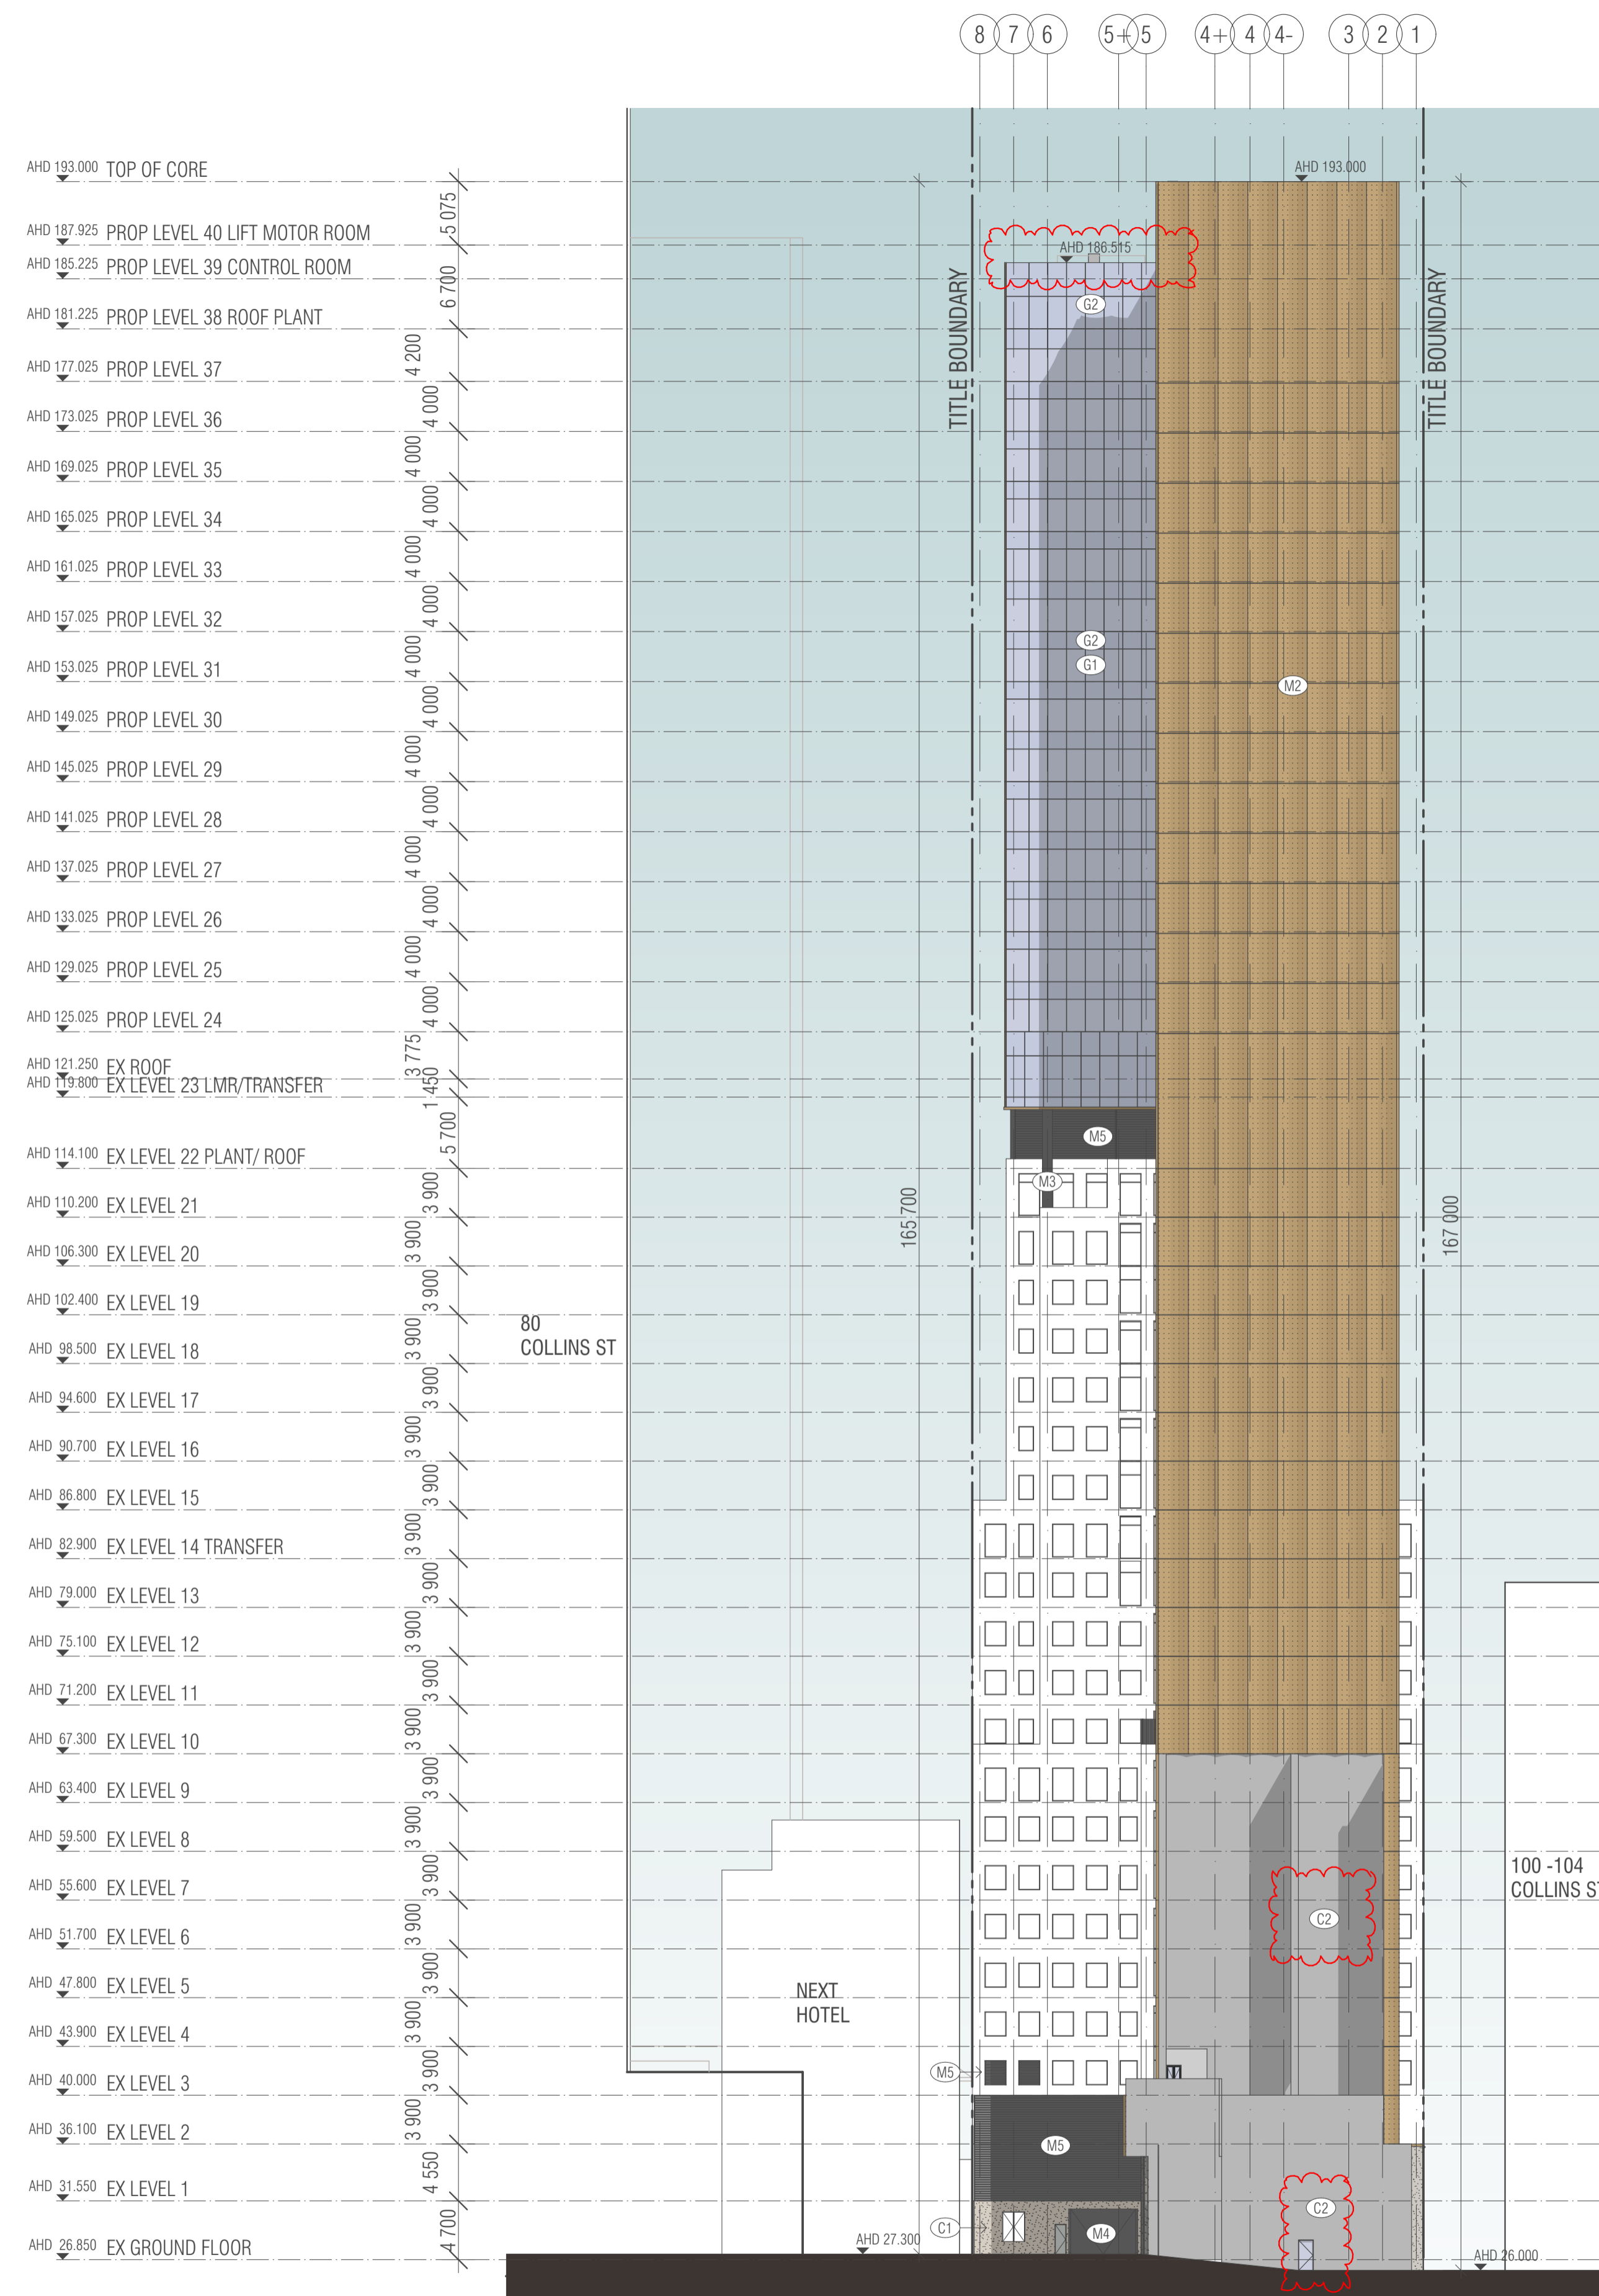

PROPOSED NORTH ELEVATION  
SCALE 1:375@A1

BIMcloud: FK BIMCLOUD - BIMcloud\18155 90 Collins Street Melbourne\00 MODEL\00-CD\BIM MODEL\18155 General

REVISION	DESCRIPTION	DATE
01	TOWN PLANNING ISSUE 01	16.12.2021
02	TOWN PLANNING SUBMISSION 02	10.06.2022
03	TOWN PLANNING SUBMISSION 03	15.07.2022

REVISION	DESCRIPTION	DATE
01	TOWN PLANNING ISSUE 01	16.12.2021
02	TOWN PLANNING SUBMISSION 02	10.06.2022
03	TOWN PLANNING SUBMISSION 03	15.07.2022

**QUALITY ASSURANCE** (FK IS A CERTIFIED COMPANY TO ISO 9001:2015)  
THIS PROJECT IS SUBJECT TO THE FK QUALITY ASSURANCE SYSTEM

- SCHEMATIC DESIGN REVIEW FOR THIS PROJECT IS YET TO BE COMPLETED.
- DESIGN DEVELOPMENT REVIEW FOR THIS PROJECT IS YET TO BE COMPLETED.
- TENDER DOCUMENTATION REVIEW FOR THIS PROJECT IS YET TO BE COMPLETED.
- CONSTRUCTION DOCUMENTATION REVIEW FOR THIS DRAWING IS YET TO BE COMPLETED.

IF THIS DRAWING IS STAMPED UNCONTROLLED COPY THEN IT IS TO BE CONSIDERED A DRAFT. SUBJECT TO REVISION WITHOUT NOTICE

**NOTES**  
THIS DRAWING IS COPYRIGHT AND SHALL REMAIN THE PROPERTY OF FENDER KATSALIDIS (AUST) PTY LTD  
CHECK AND VERIFY ALL DIMENSIONS ON SITE PRIOR TO COMMENCING WORK. DRAWING TO BE READ IN CONJUNCTION WITH ALL OTHER CONTRACT DOCUMENTS. DO NOT SCALE DRAWINGS. USE FIGURED DIMENSIONS ONLY. SEEK CLARIFICATION OF INCONSISTENCIES / CONFLICTS.

DRAWN	DATE	CHECKED	PLOT DATE	JOB NO.	SCALE
WTK	15.07.2022	JV	21.07.2022	18155	AS SHOWN@A1

**PROJECT**  
90 COLLINS REDEVELOPMENT  
90 COLLINS STREET  
MELBOURNE VIC 3000



**FENDER KATSALIDIS**  
WWW.FKAUSTRALIA.COM  
2 RIVERSIDE QUAY, SOUTH BANK  
VICTORIA 3006 AUSTRALIA  
TELEPHONE: +61 3 8696 3888  
FENDER KATSALIDIS (AUST) PTY LTD ACN 092 943 032





**ISSUE PURPOSE**  
TOWN PLANNING

**REV.** 02  
**DRAWING NO.** TP403



KEY PLAN

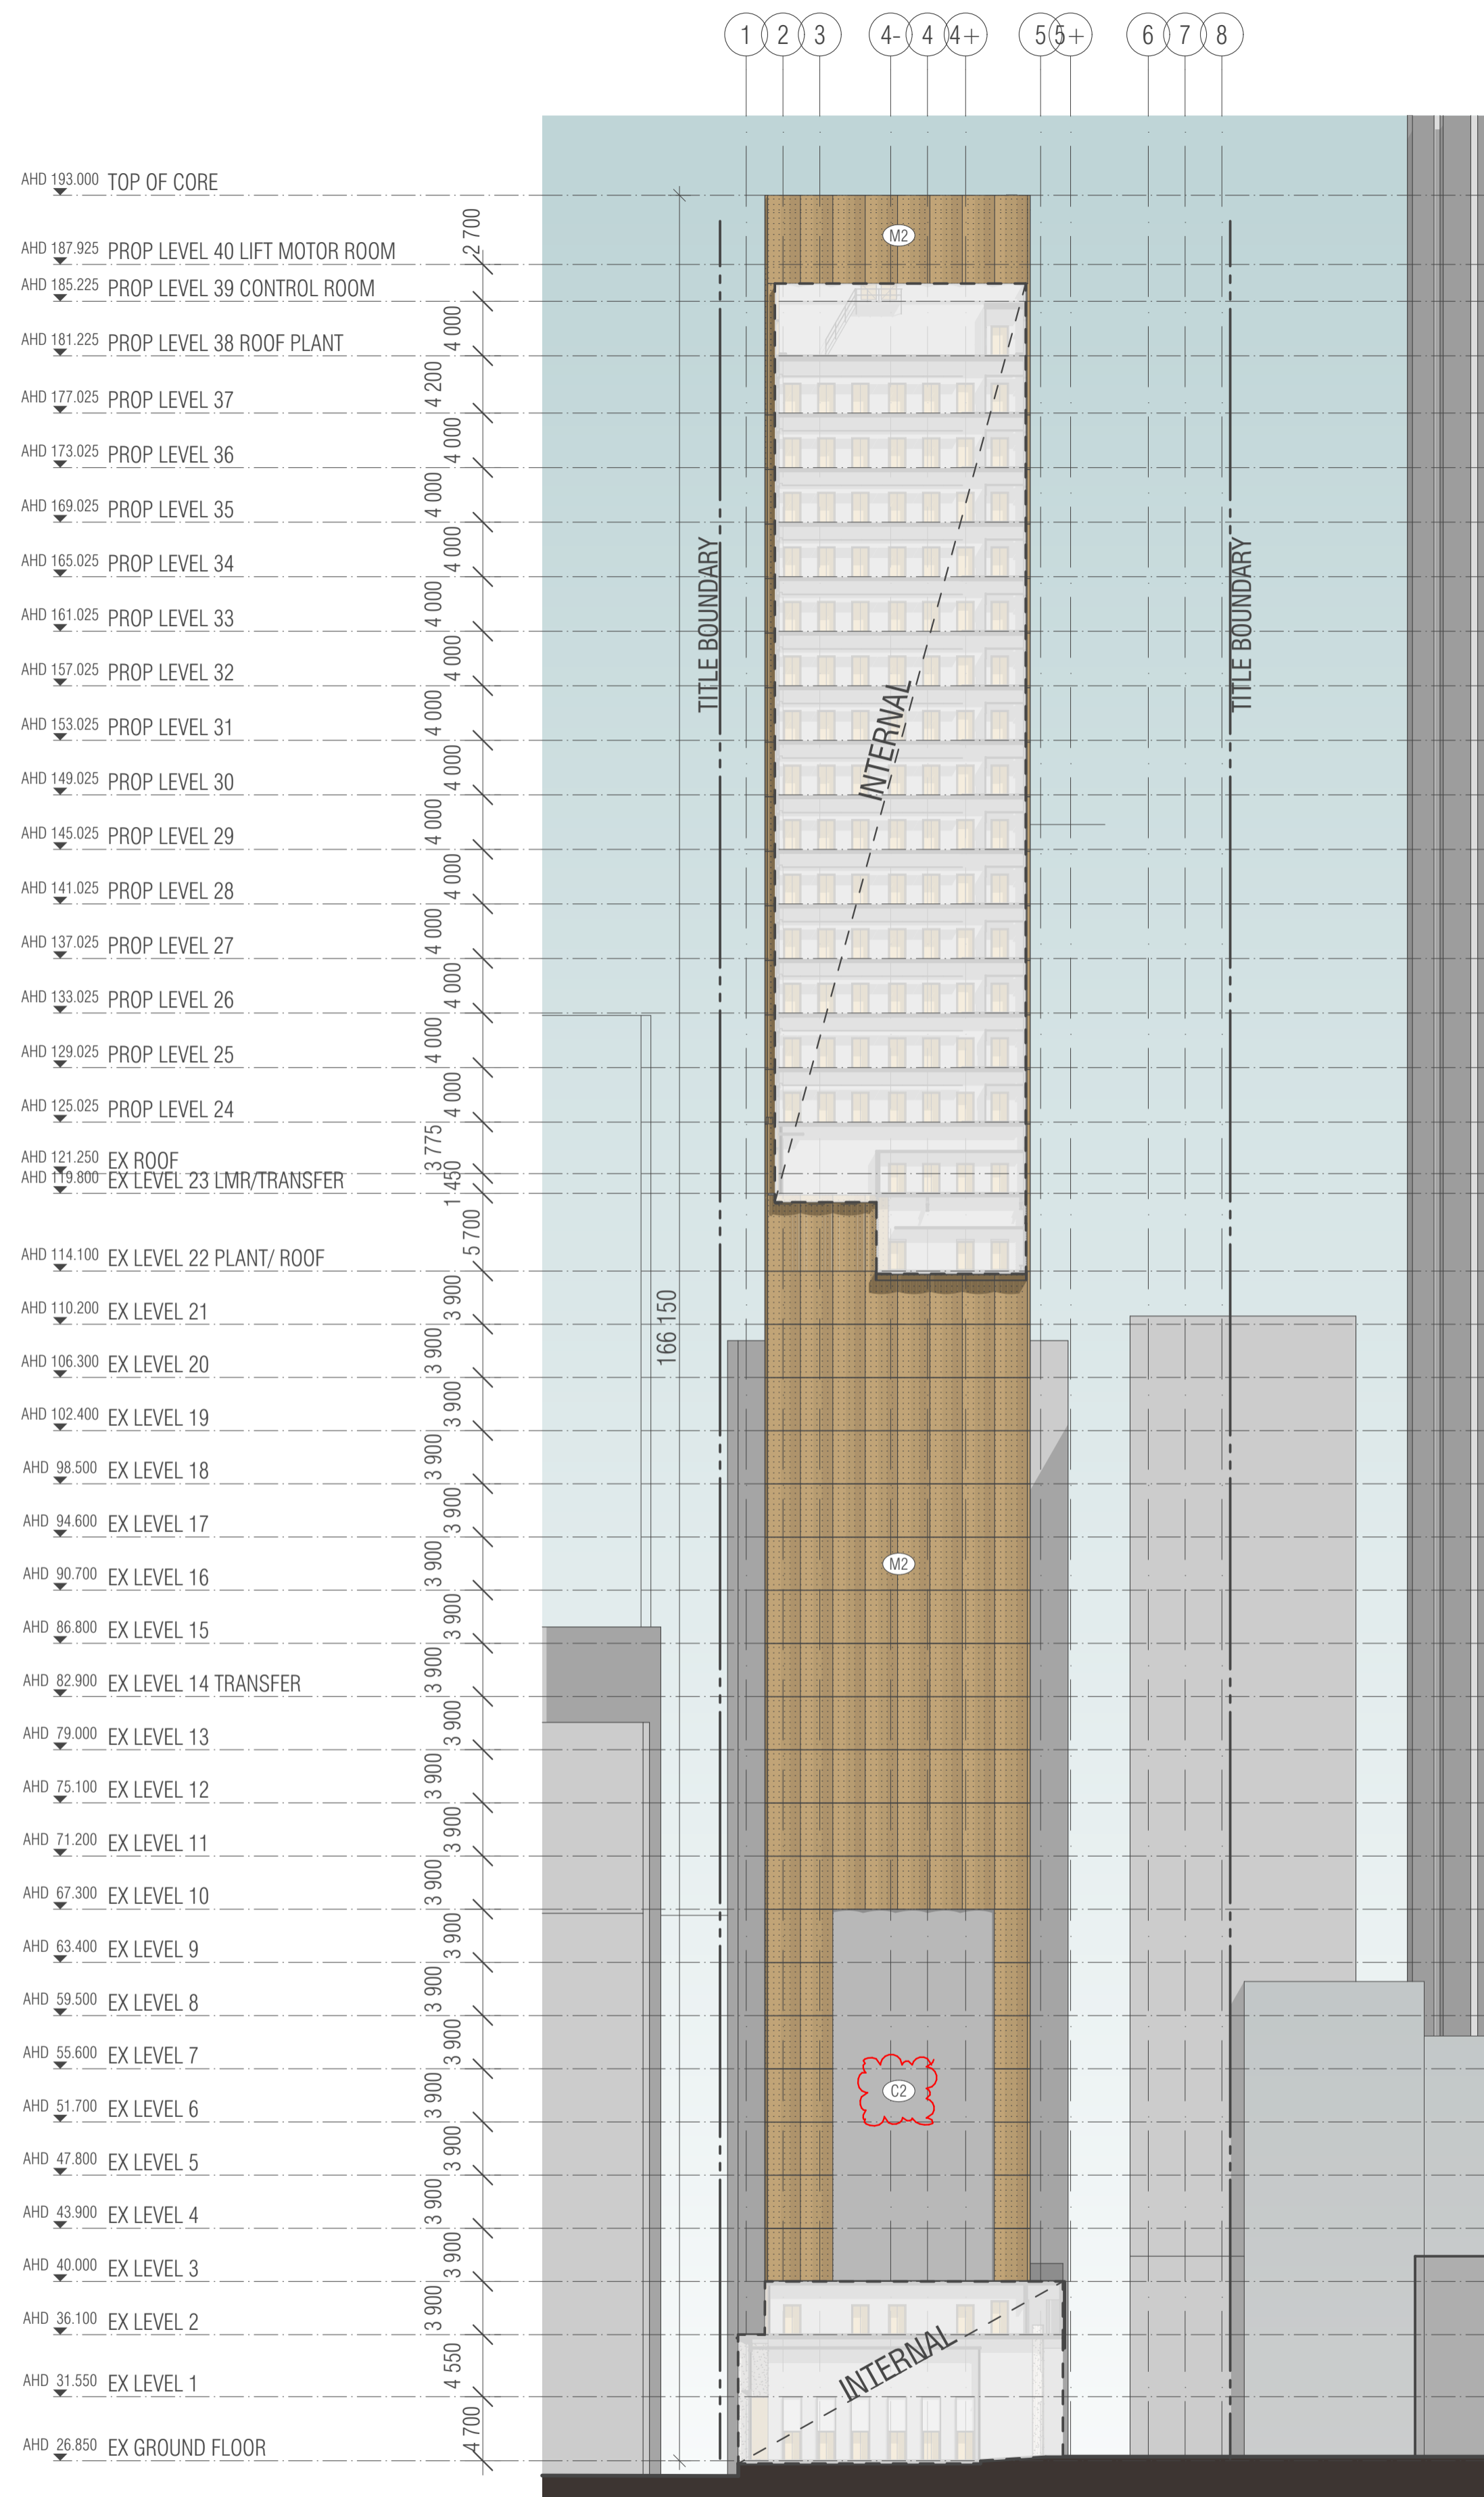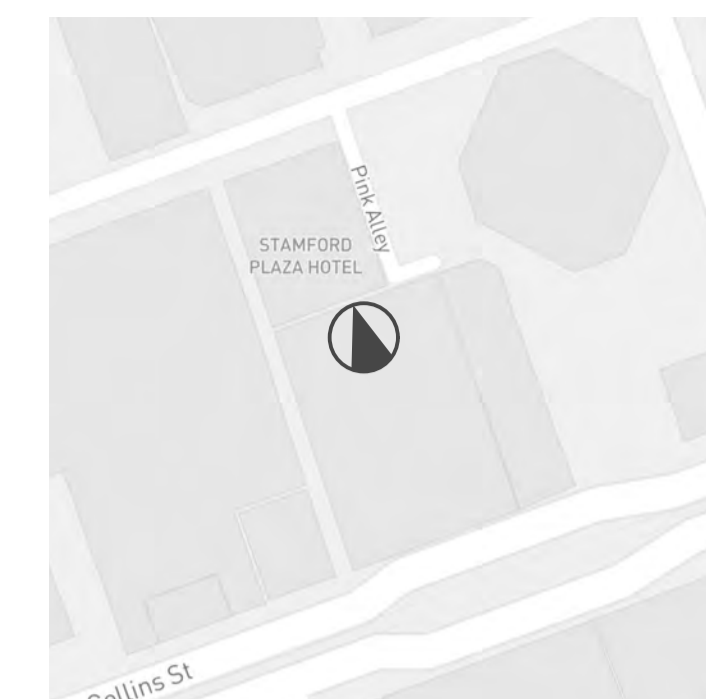

CS CORE SOUTH ELEVATION  
SCALE 1:375@A1

ELEVATIONS LEGEND

- G1 GLASS - SILVER GREY
- G2 GLASS - SILVER GREY SPANDREL
- G3 GLASS - CLEAR
- M1 METAL CLADDING - COPPER COLOUR
- M2 METAL CLADDING - COPPER COLOUR RAINSCREEN
- M3 METAL CLADDING - CHARCOAL COLOUR
- M4 METAL CLADDING - CHARCOAL PERFORATED
- M5 METAL LOUVRES - CHARCOAL COLOUR
- C1 POLISHED CONCRETE LOOK FINISH (OFF WHITE)
- C2 CONCRETE - GREY
- S1 BLUESTONE LOOK
- P1 HERITAGE FACADE PAINT COLOR

CHANGES HIGHLIGHTED IN COLOUR TO EXISTING & PROPOSED ELEVATIONS

BIMcloud: FK BIMCLOUD - BIMcloud\18155 90 Collins Street Melbourne\00 MODEL\00-CD\BIM MODEL\18155 General

REVISION		REVISION	
-	TOWN PLANNING ISSUE 01	WTK	16.12.2021
01	TOWN PLANNING SUBMISSION 02	WTK	10.06.2022
> 02	TOWN PLANNING SUBMISSION 03	WTK	15.07.2022

**QUALITY ASSURANCE** (FK IS A CERTIFIED COMPANY TO ISO 9001:2015)  
THIS PROJECT IS SUBJECT TO THE FK QUALITY ASSURANCE SYSTEM

- SCHEMATIC DESIGN REVIEW FOR THIS PROJECT IS YET TO BE COMPLETED.
- DESIGN DEVELOPMENT REVIEW FOR THIS PROJECT IS YET TO BE COMPLETED.
- TENDER DOCUMENTATION REVIEW FOR THIS PROJECT IS YET TO BE COMPLETED.
- CONSTRUCTION DOCUMENTATION REVIEW FOR THIS DRAWING IS YET TO BE COMPLETED.

IF THIS DRAWING IS STAMPED UNCONTROLLED COPY THEN IT IS TO BE CONSIDERED A DRAFT. SUBJECT TO REVISION WITHOUT NOTICE


**NOTES**  
THIS DRAWING IS COPYRIGHT AND SHALL REMAIN THE PROPERTY OF FENDER KATSALIDIS (AUST) PTY LTD. CHECK AND VERIFY ALL DIMENSIONS ON SITE PRIOR TO COMMENCING WORK. DRAWING TO BE READ IN CONJUNCTION WITH ALL OTHER CONTRACT DOCUMENTS. DO NOT SCALE DRAWINGS. USE FIGURED DIMENSIONS ONLY. SEEK CLARIFICATION OF INCONSISTENCIES / CONFLICTS.

DRAWN	DATE	CHECKED	PLOT DATE	JOB NO.	SCALE
WTK	15.07.2022	JV	21.07.2022	18155	1:100@A1

**PROJECT**  
90 COLLINS REDEVELOPMENT  
90 COLLINS STREET  
MELBOURNE VIC 3000



**FENDER KATSALIDIS**  
WWW.FKAUSTRALIA.COM  
2 RIVERSIDE QUAY, SOUTH BANK  
VICTORIA 3006 AUSTRALIA  
TELEPHONE: +61 3 8696 3888  
FENDER KATSALIDIS (AUST) PTY LTD ACN 092 943 032

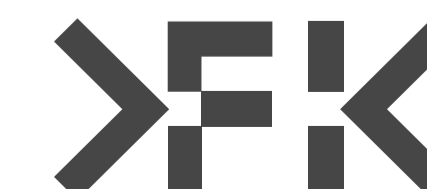


**DRAWING TITLE**  
PROPOSED SOUTH CORE ELEVATION

**ISSUE PURPOSE**  
TOWN PLANNING

**REV.** 02  
**DRAWING NO.** TP404




→ KEY PLAN

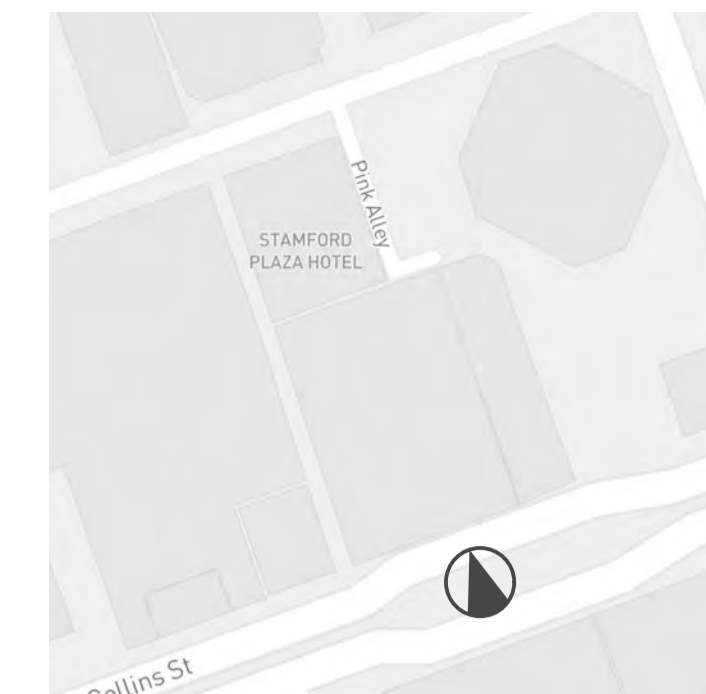

→ ELEVATIONS LEGEND

- G1 GLASS - SILVER GREY
- G2 GLASS - SILVER GREY SPANDREL
- G3 GLASS - CLEAR
- M1 METAL CLADDING - COPPER COLOUR
- M2 METAL CLADDING - COPPER COLOUR RAINSCREEN
- M3 METAL CLADDING - CHARCOAL COLOUR
- M4 METAL CLADDING - CHARCOAL PERFORATED
- M5 METAL LOUVRES - CHARCOAL COLOUR
- C1 POLISHED CONCRETE LOOK FINISH (OFF WHITE)
- C2 CONCRETE - GREY
- S1 BLUESTONE LOOK
- P1 HERITAGE FACADE PAINT COLOR

→ CHANGES HIGHLIGHTED IN COLOUR TO EXISTING & PROPOSED ELEVATIONS

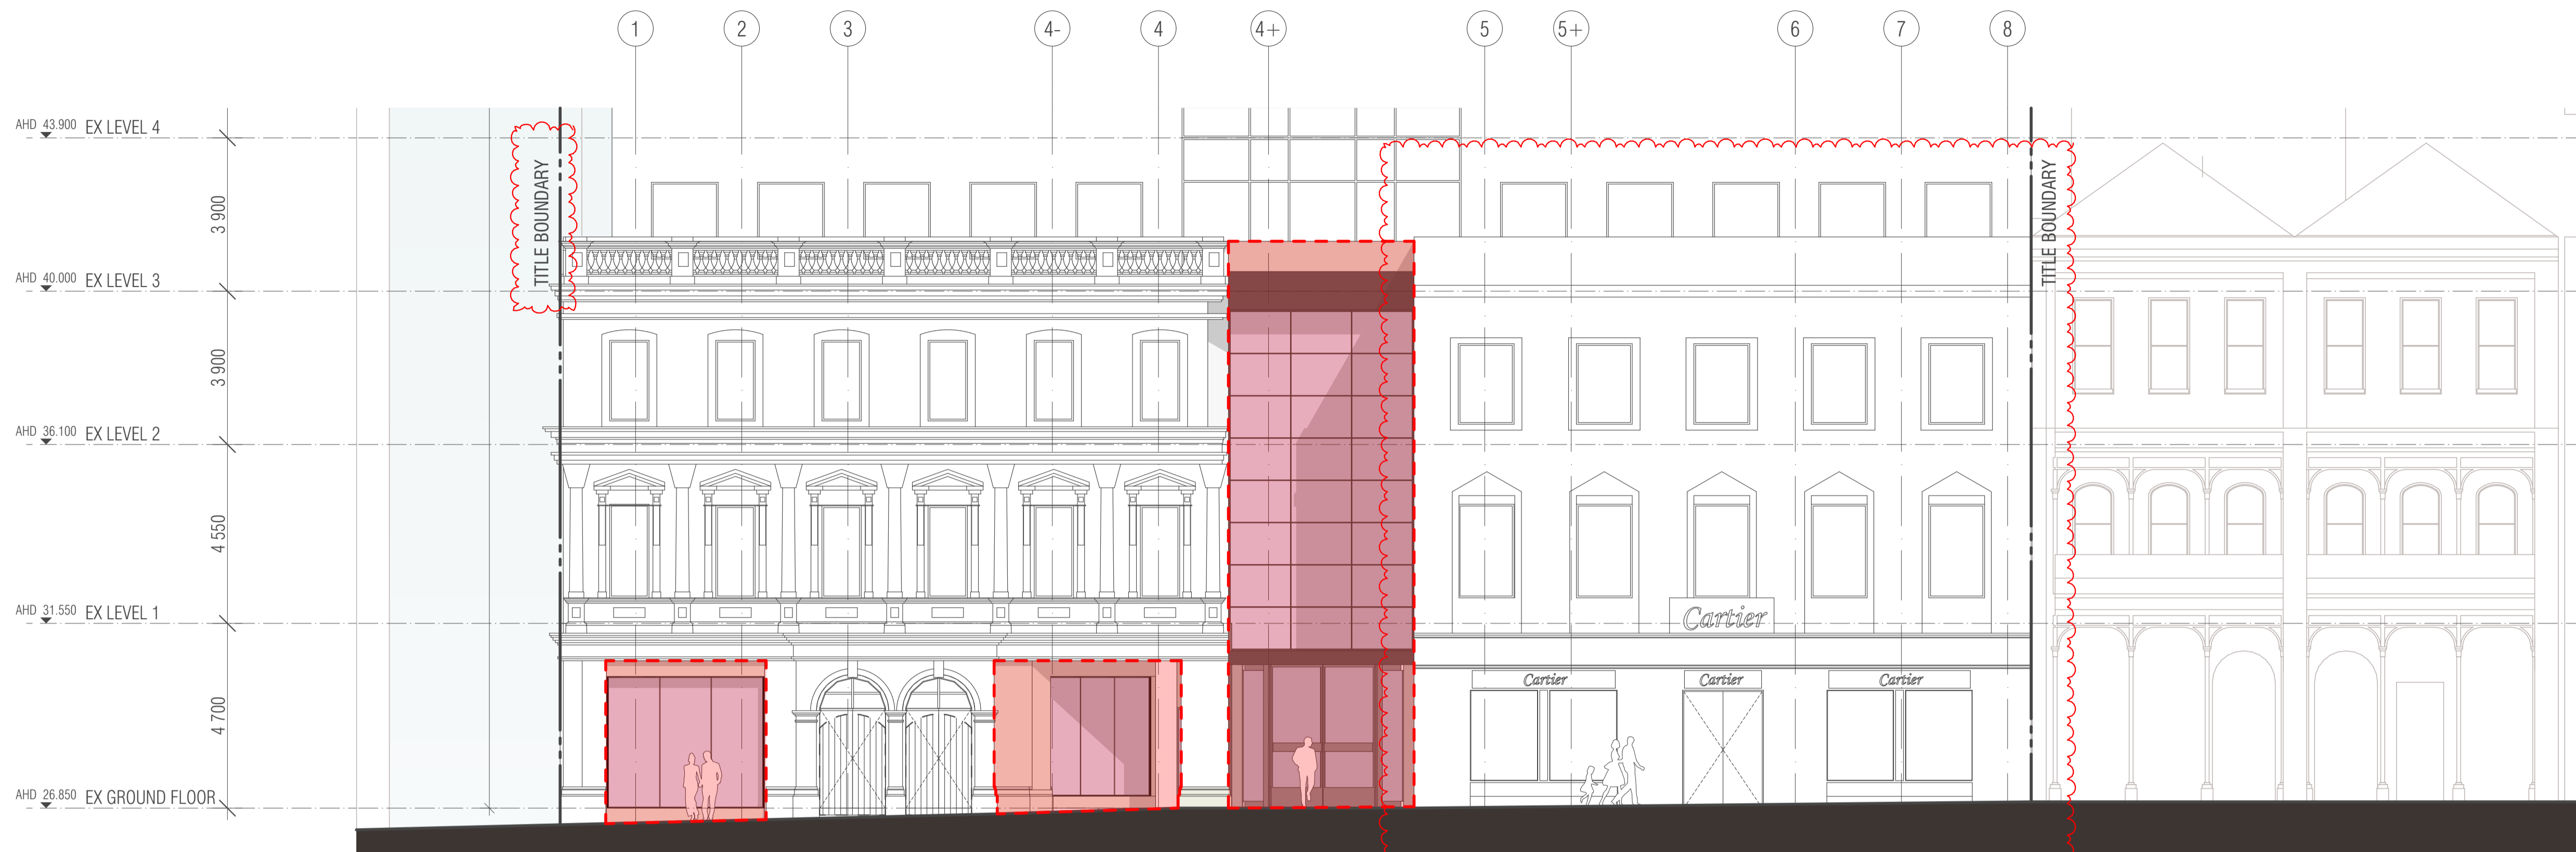

EXISTING SOUTH PODIUM ELEVATION  
SCALE 1:100@A1



PROPOSED SOUTH PODIUM ELEVATION  
SCALE 1:100@A1

BIMcloud: FK BIMCLOUD - BIMcloud\18155 90 Collins Street Melbourne\00 MODEL\00-CD\BIM MODEL\18155 General

REVISION	REVISION	DATE
01	TOWN PLANNING ISSUE 01	16.12.2021
02	TOWN PLANNING SUBMISSION 02	10.06.2022
03	TOWN PLANNING SUBMISSION 03	15.07.2022

**QUALITY ASSURANCE** (FK IS A CERTIFIED COMPANY TO ISO 9001:2015)  
THIS PROJECT IS SUBJECT TO THE FK QUALITY ASSURANCE SYSTEM

- SCHEMATIC DESIGN REVIEW FOR THIS PROJECT IS YET TO BE COMPLETED.
- DESIGN DEVELOPMENT REVIEW FOR THIS PROJECT IS YET TO BE COMPLETED.
- TENDER DOCUMENTATION REVIEW FOR THIS PROJECT IS YET TO BE COMPLETED.
- CONSTRUCTION DOCUMENTATION REVIEW FOR THIS DRAWING IS YET TO BE COMPLETED.

IF THIS DRAWING IS STAMPED UNCONTROLLED COPY THEN IT IS TO BE CONSIDERED A DRAFT. SUBJECT TO REVISION WITHOUT NOTICE

**NOTES**  
THIS DRAWING IS COPYRIGHT AND SHALL REMAIN THE PROPERTY OF FENDER KATSALIDIS (AUST) PTY LTD  
CHECK AND VERIFY ALL DIMENSIONS ON SITE PRIOR TO COMMENCING WORK. DRAWING TO BE READ IN CONJUNCTION WITH ALL OTHER CONTRACT DOCUMENTS. DO NOT SCALE DRAWINGS. USE FIGURED DIMENSIONS ONLY. SEEK CLARIFICATION OF INCONSISTENCIES / CONFLICTS.

DRAWN	DATE	CHECKED	PLOT DATE	JOB NO.	SCALE
WTK	15.07.2022	JV	21.07.2022	18155	1:100@A1

**PROJECT**  
90 COLLINS REDEVELOPMENT  
90 COLLINS STREET  
MELBOURNE VIC 3000

**DRAWING TITLE**  
PROPOSED SOUTH PODIUM ELEVATION




**FENDER KATSALIDIS**  
WWW.FKAUSTRALIA.COM  
2 RIVERSIDE QUAY, SOUTHBANK  
VICTORIA 3006 AUSTRALIA  
TELEPHONE: +61 3 8696 3888  
FENDER KATSALIDIS (AUST) PTY LTD ACN 092 943 032

**ISSUE PURPOSE**  
TOWN PLANNING



**REV.** 02  
**DRAWING NO.** TP405


KEY PLAN

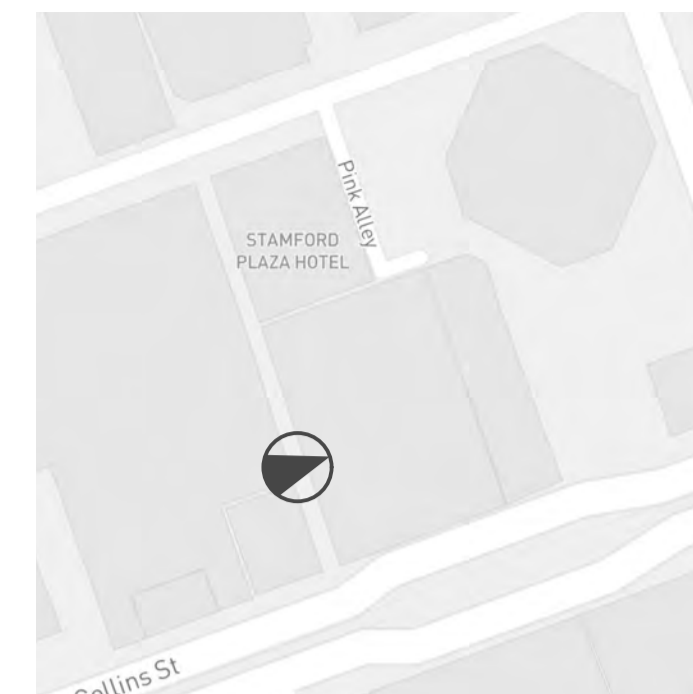

ELEVATIONS LEGEND

- G1 GLASS - SILVER GREY
- G2 GLASS - SILVER GREY SPANDREL
- G3 GLASS - CLEAR
- M1 METAL CLADDING - COPPER COLOUR
- M2 METAL CLADDING - COPPER COLOUR RAINSCREEN
- M3 METAL CLADDING - CHARCOAL COLOUR
- M4 METAL CLADDING - CHARCOAL PERFORATED
- M5 METAL LOUVRES - CHARCOAL COLOUR
- C1 POLISHED CONCRETE LOOK FINISH (OFF WHITE)
- C2 CONCRETE - GREY
- S1 BLUESTONE LOOK
- P1 HERITAGE FACADE PAINT COLOR

CHANGES HIGHLIGHTED IN COLOUR TO EXISTING & PROPOSED ELEVATIONS

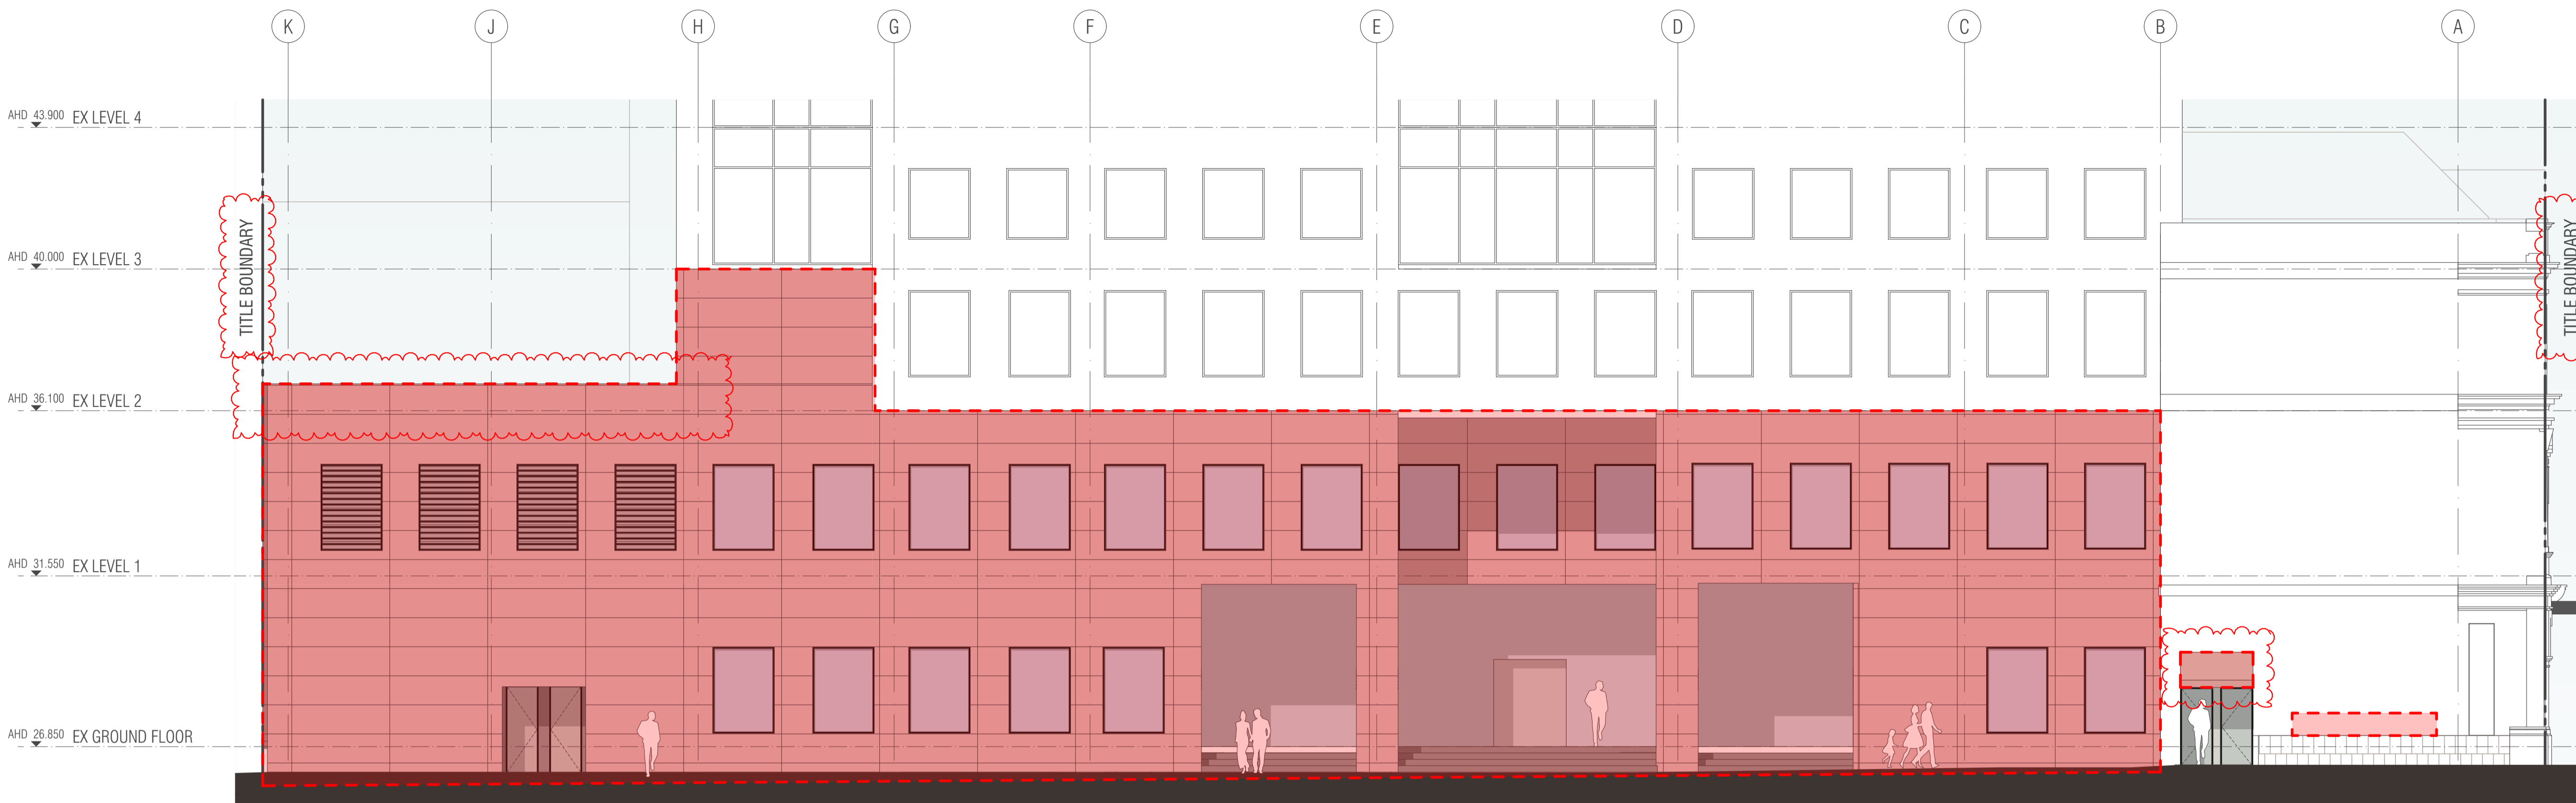

EXISTING WEST PODIUM ELEVATION  
SCALE 1:100@A1



PROPOSED WEST PODIUM ELEVATION  
SCALE 1:100@A1

WEST ELEVATION BOOSTER CUPBOARD  
SCALE 1:50@A1

BIMcloud: FK BIMCLOUD - BIMcloud\18155 90 Collins Street Melbourne\00 MODEL\00-CD\BIM MODEL\18155 General

REVISION	DATE	BY
01	16.12.2021	WTK
02	10.06.2022	WTK
03	15.07.2022	WTK

REVISION

QUALITY ASSURANCE (FK IS A CERTIFIED COMPANY TO ISO 9001:2015)

- THIS PROJECT IS SUBJECT TO THE FK QUALITY ASSURANCE SYSTEM
- SCHEMATIC DESIGN REVIEW FOR THIS PROJECT IS YET TO BE COMPLETED.
  - DESIGN DEVELOPMENT REVIEW FOR THIS PROJECT IS YET TO BE COMPLETED.
  - TENDER DOCUMENTATION REVIEW FOR THIS PROJECT IS YET TO BE COMPLETED.
  - CONSTRUCTION DOCUMENTATION REVIEW FOR THIS DRAWING IS YET TO BE COMPLETED.
- IF THIS DRAWING IS STAMPED UNCONTROLLED COPY THEN IT IS TO BE CONSIDERED A DRAFT. SUBJECT TO REVISION WITHOUT NOTICE

NOTES

THIS DRAWING IS COPYRIGHT AND SHALL REMAIN THE PROPERTY OF FENDER KATSALIDIS (AUST) PTY LTD. CHECK AND VERIFY ALL DIMENSIONS ON SITE PRIOR TO COMMENCING WORK. DRAWING TO BE READ IN CONJUNCTION WITH ALL OTHER CONTRACT DOCUMENTS. DO NOT SCALE DRAWINGS. USE FIGURED DIMENSIONS ONLY. SEEK CLARIFICATION OF INCONSISTENCIES / CONFLICTS.

DRAWN	DATE	CHECKED	PLOT DATE	JOB NO.	SCALE
WTK	15.07.2022	JV	21.07.2022	18155	1:100@A1

PROJECT  
90 COLLINS REDEVELOPMENT  
90 COLLINS STREET  
MELBOURNE VIC 3000

DRAWING TITLE  
PROPOSED WEST PODIUM ELEVATION



FENDER KATSALIDIS  
WWW.FKAUSTRALIA.COM  
2 RIVERSIDE QUAY, SOUTH BANK  
VICTORIA 3006 AUSTRALIA  
TELEPHONE: +61 3 8696 3888  
FENDER KATSALIDIS (AUST) PTY LTD ACN 092 943 032


ISSUE PURPOSE  
TOWN PLANNING



REV. 02  
DRAWING NO. TP406




KEY PLAN

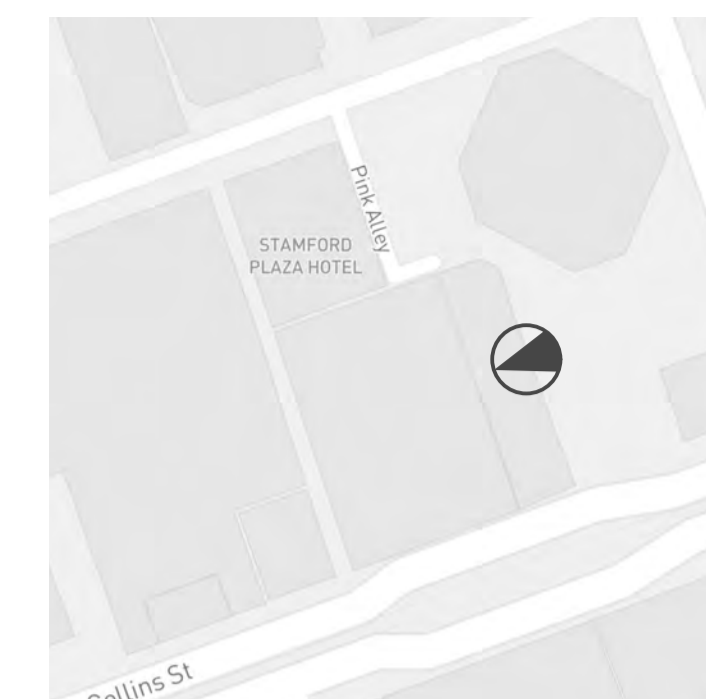


ELEVATIONS LEGEND

- G1 GLASS - SILVER GREY
- G2 GLASS - SILVER GREY SPANDREL
- G3 GLASS - CLEAR
- M1 METAL CLADDING - COPPER COLOUR
- M2 METAL CLADDING - COPPER COLOUR RAINSCREEN
- M3 METAL CLADDING - CHARCOAL COLOUR
- M4 METAL CLADDING - CHARCOAL PERFORATED
- M5 METAL LOUVRES - CHARCOAL COLOUR
- C1 POLISHED CONCRETE LOOK FINISH (OFF WHITE)
- C2 CONCRETE - GREY
- S1 BLUESTONE LOOK
- P1 HERITAGE FACADE PAINT COLOR

CHANGES HIGHLIGHTED IN COLOUR TO EXISTING & PROPOSED ELEVATIONS

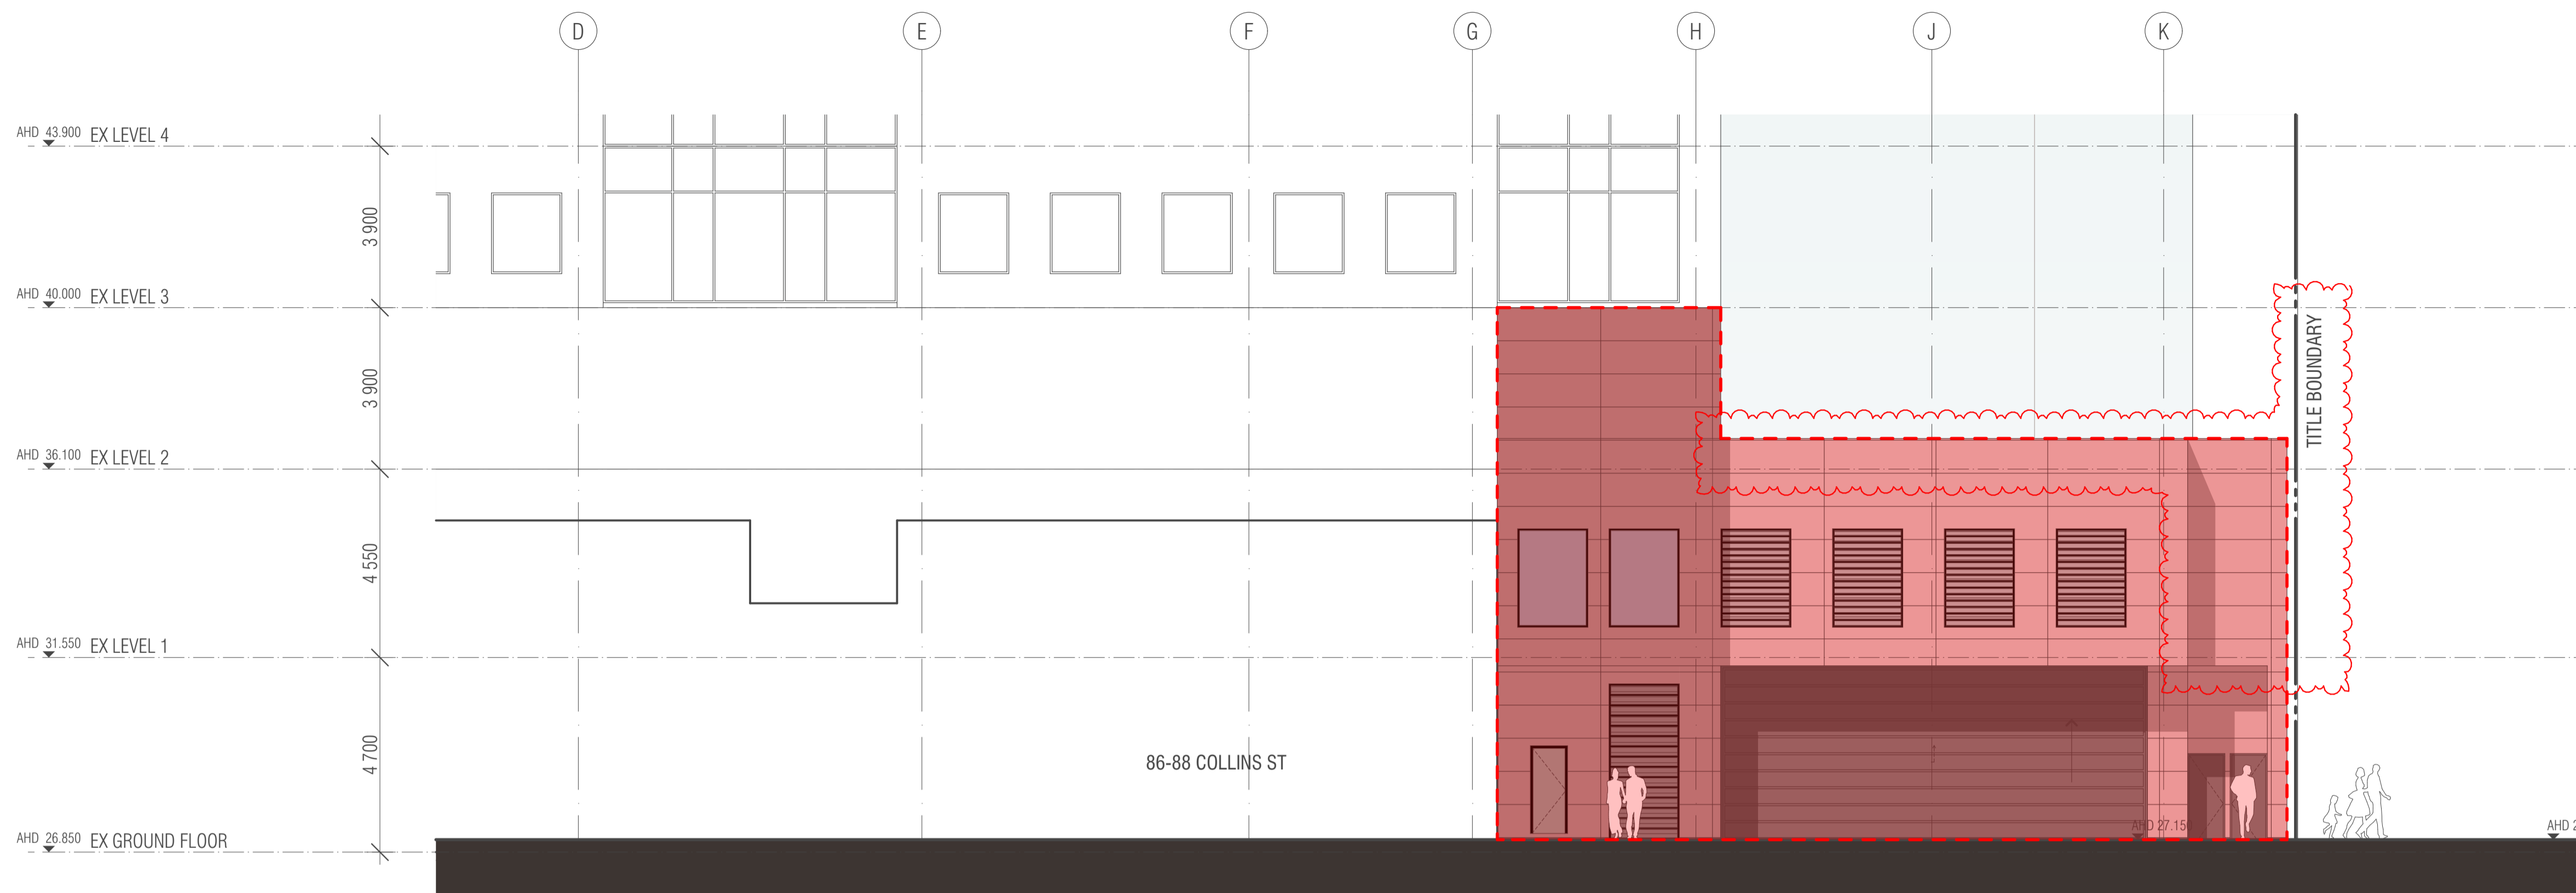

**E** EXISTING EAST PODIUM ELEVATION  
SCALE 1:100@A1

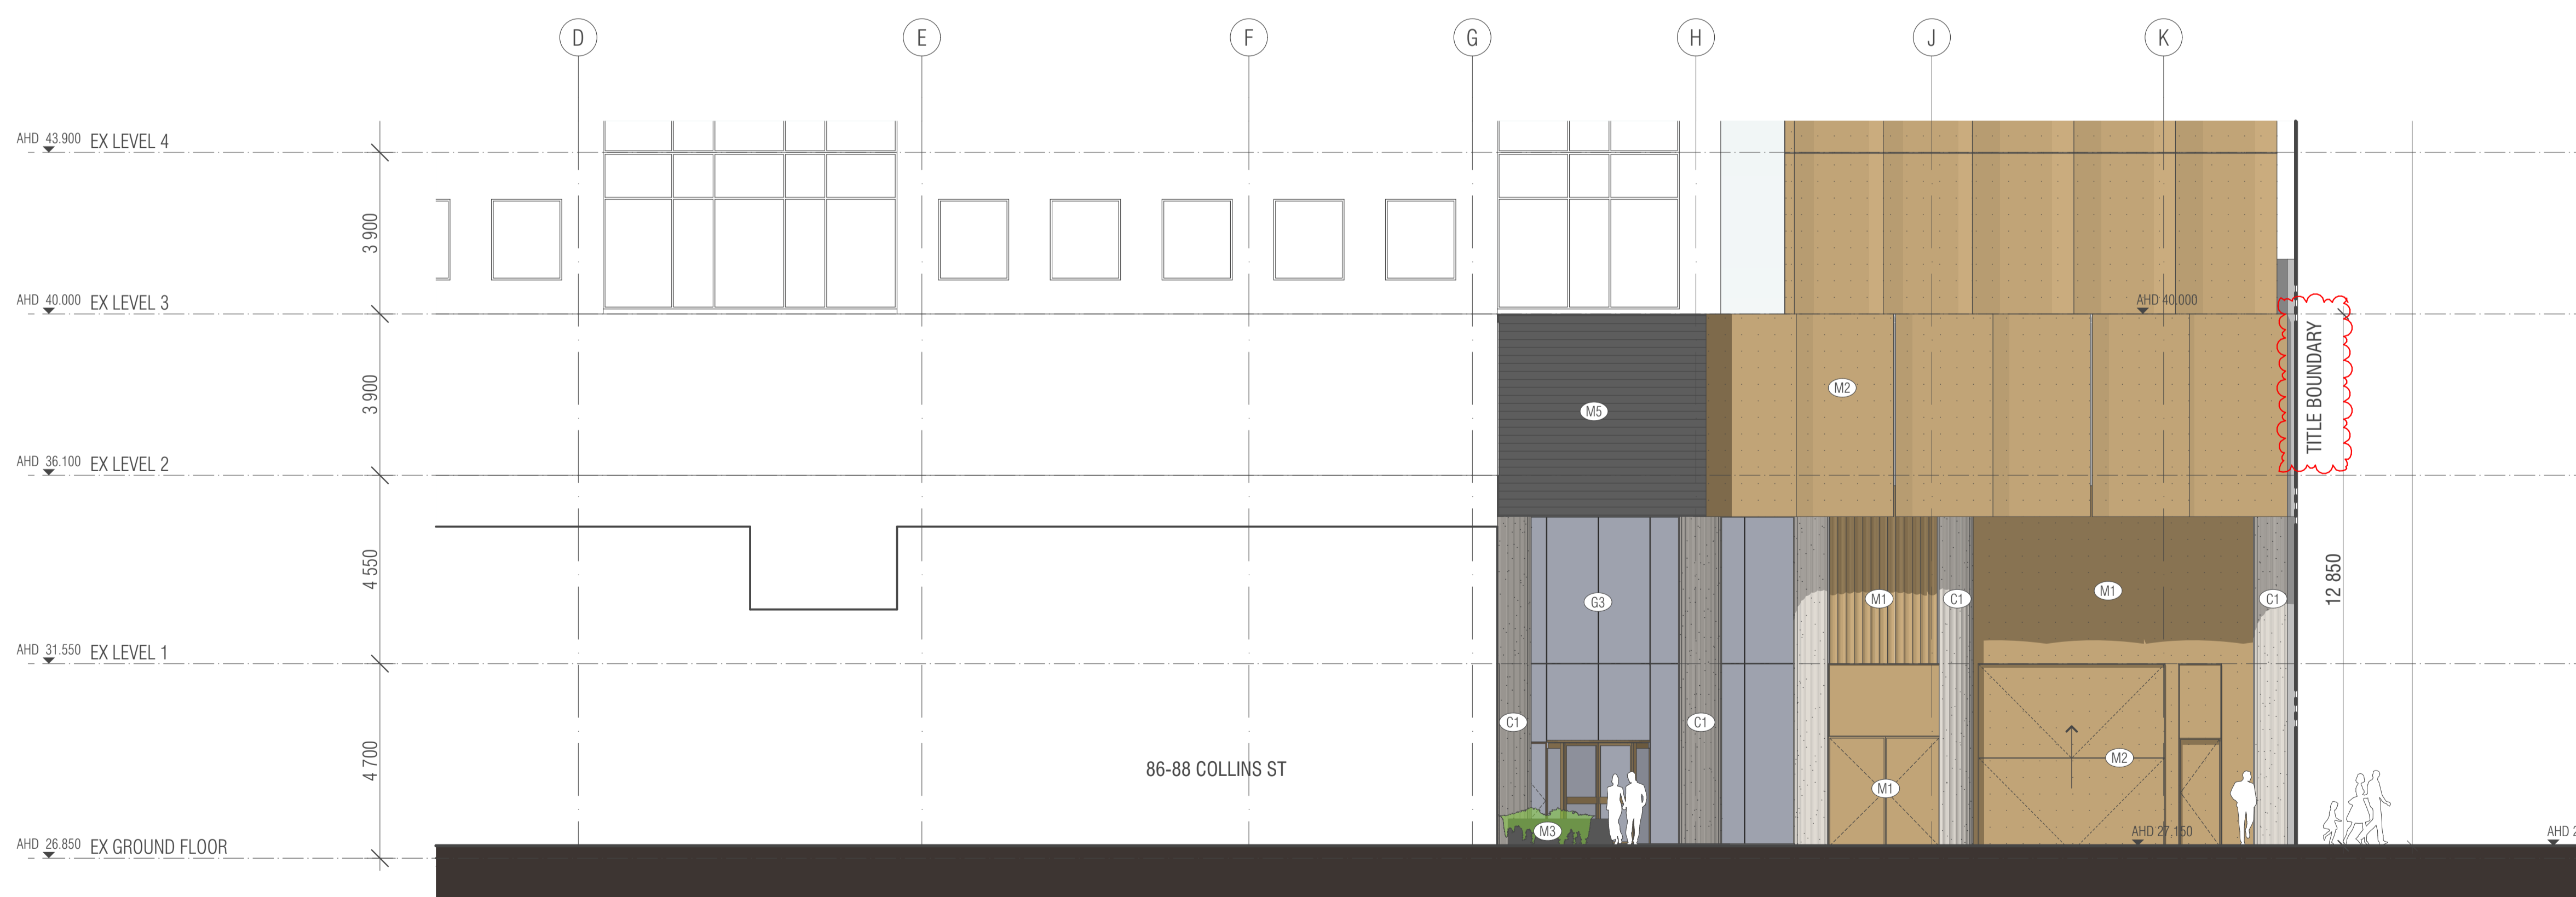

**E** PROPOSED EAST PODIUM ELEVATION  
SCALE 1:100@A1

BIMcloud: FK BIMCLOUD - BIMcloud\18155 90 Collins Street Melbourne\00 MODEL\00-CD\BIM MODEL\18155 General

REVISION	DESCRIPTION	DATE	BY
01	TOWN PLANNING ISSUE 01	16.12.2021	WTK
02	TOWN PLANNING SUBMISSION 02	10.06.2022	WTK
03	TOWN PLANNING SUBMISSION 03	15.07.2022	WTK

**QUALITY ASSURANCE** (FK IS A CERTIFIED COMPANY TO ISO 9001:2015)  
THIS PROJECT IS SUBJECT TO THE FK QUALITY ASSURANCE SYSTEM

- SCHEMATIC DESIGN REVIEW FOR THIS PROJECT IS YET TO BE COMPLETED.
- DESIGN DEVELOPMENT REVIEW FOR THIS PROJECT IS YET TO BE COMPLETED.
- TENDER DOCUMENTATION REVIEW FOR THIS PROJECT IS YET TO BE COMPLETED.
- CONSTRUCTION DOCUMENTATION REVIEW FOR THIS DRAWING IS YET TO BE COMPLETED.

IF THIS DRAWING IS STAMPED UNCONTROLLED COPY THEN IT IS TO BE CONSIDERED A DRAFT. SUBJECT TO REVISION WITHOUT NOTICE


**NOTES**  
THIS DRAWING IS COPYRIGHT AND SHALL REMAIN THE PROPERTY OF FENDER KATSALIDIS (AUST) PTY LTD  
CHECK AND VERIFY ALL DIMENSIONS ON SITE PRIOR TO COMMENCING WORK. DRAWING TO BE READ IN CONJUNCTION WITH ALL OTHER CONTRACT DOCUMENTS. DO NOT SCALE DRAWINGS. USE FIGURED DIMENSIONS ONLY. SEEK CLARIFICATION OF INCONSISTENCIES / CONFLICTS.

DRAWN	DATE	CHECKED	PLOT DATE	JOB NO.	SCALE
WTK	15.07.2022	JV	21.07.2022	18155	1:100@A1

**PROJECT**  
90 COLLINS REDEVELOPMENT  
90 COLLINS STREET  
MELBOURNE VIC 3000



**FENDER KATSALIDIS**  
WWW.FKAUSTRALIA.COM  
2 RIVERSIDE QUAY, SOUTH BANK  
VICTORIA 3006 AUSTRALIA  
TELEPHONE: +61 3 8696 3888  
FENDER KATSALIDIS (AUST) PTY LTD ACN 092 943 032

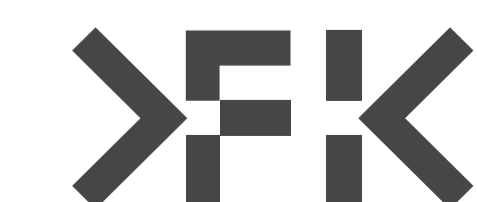


**ISSUE PURPOSE**  
TOWN PLANNING


**REV.** 02  
**DRAWING NO.** TP407



CHANGES HIGHLIGHTED IN COLOUR TO PROPOSED SECTIONS

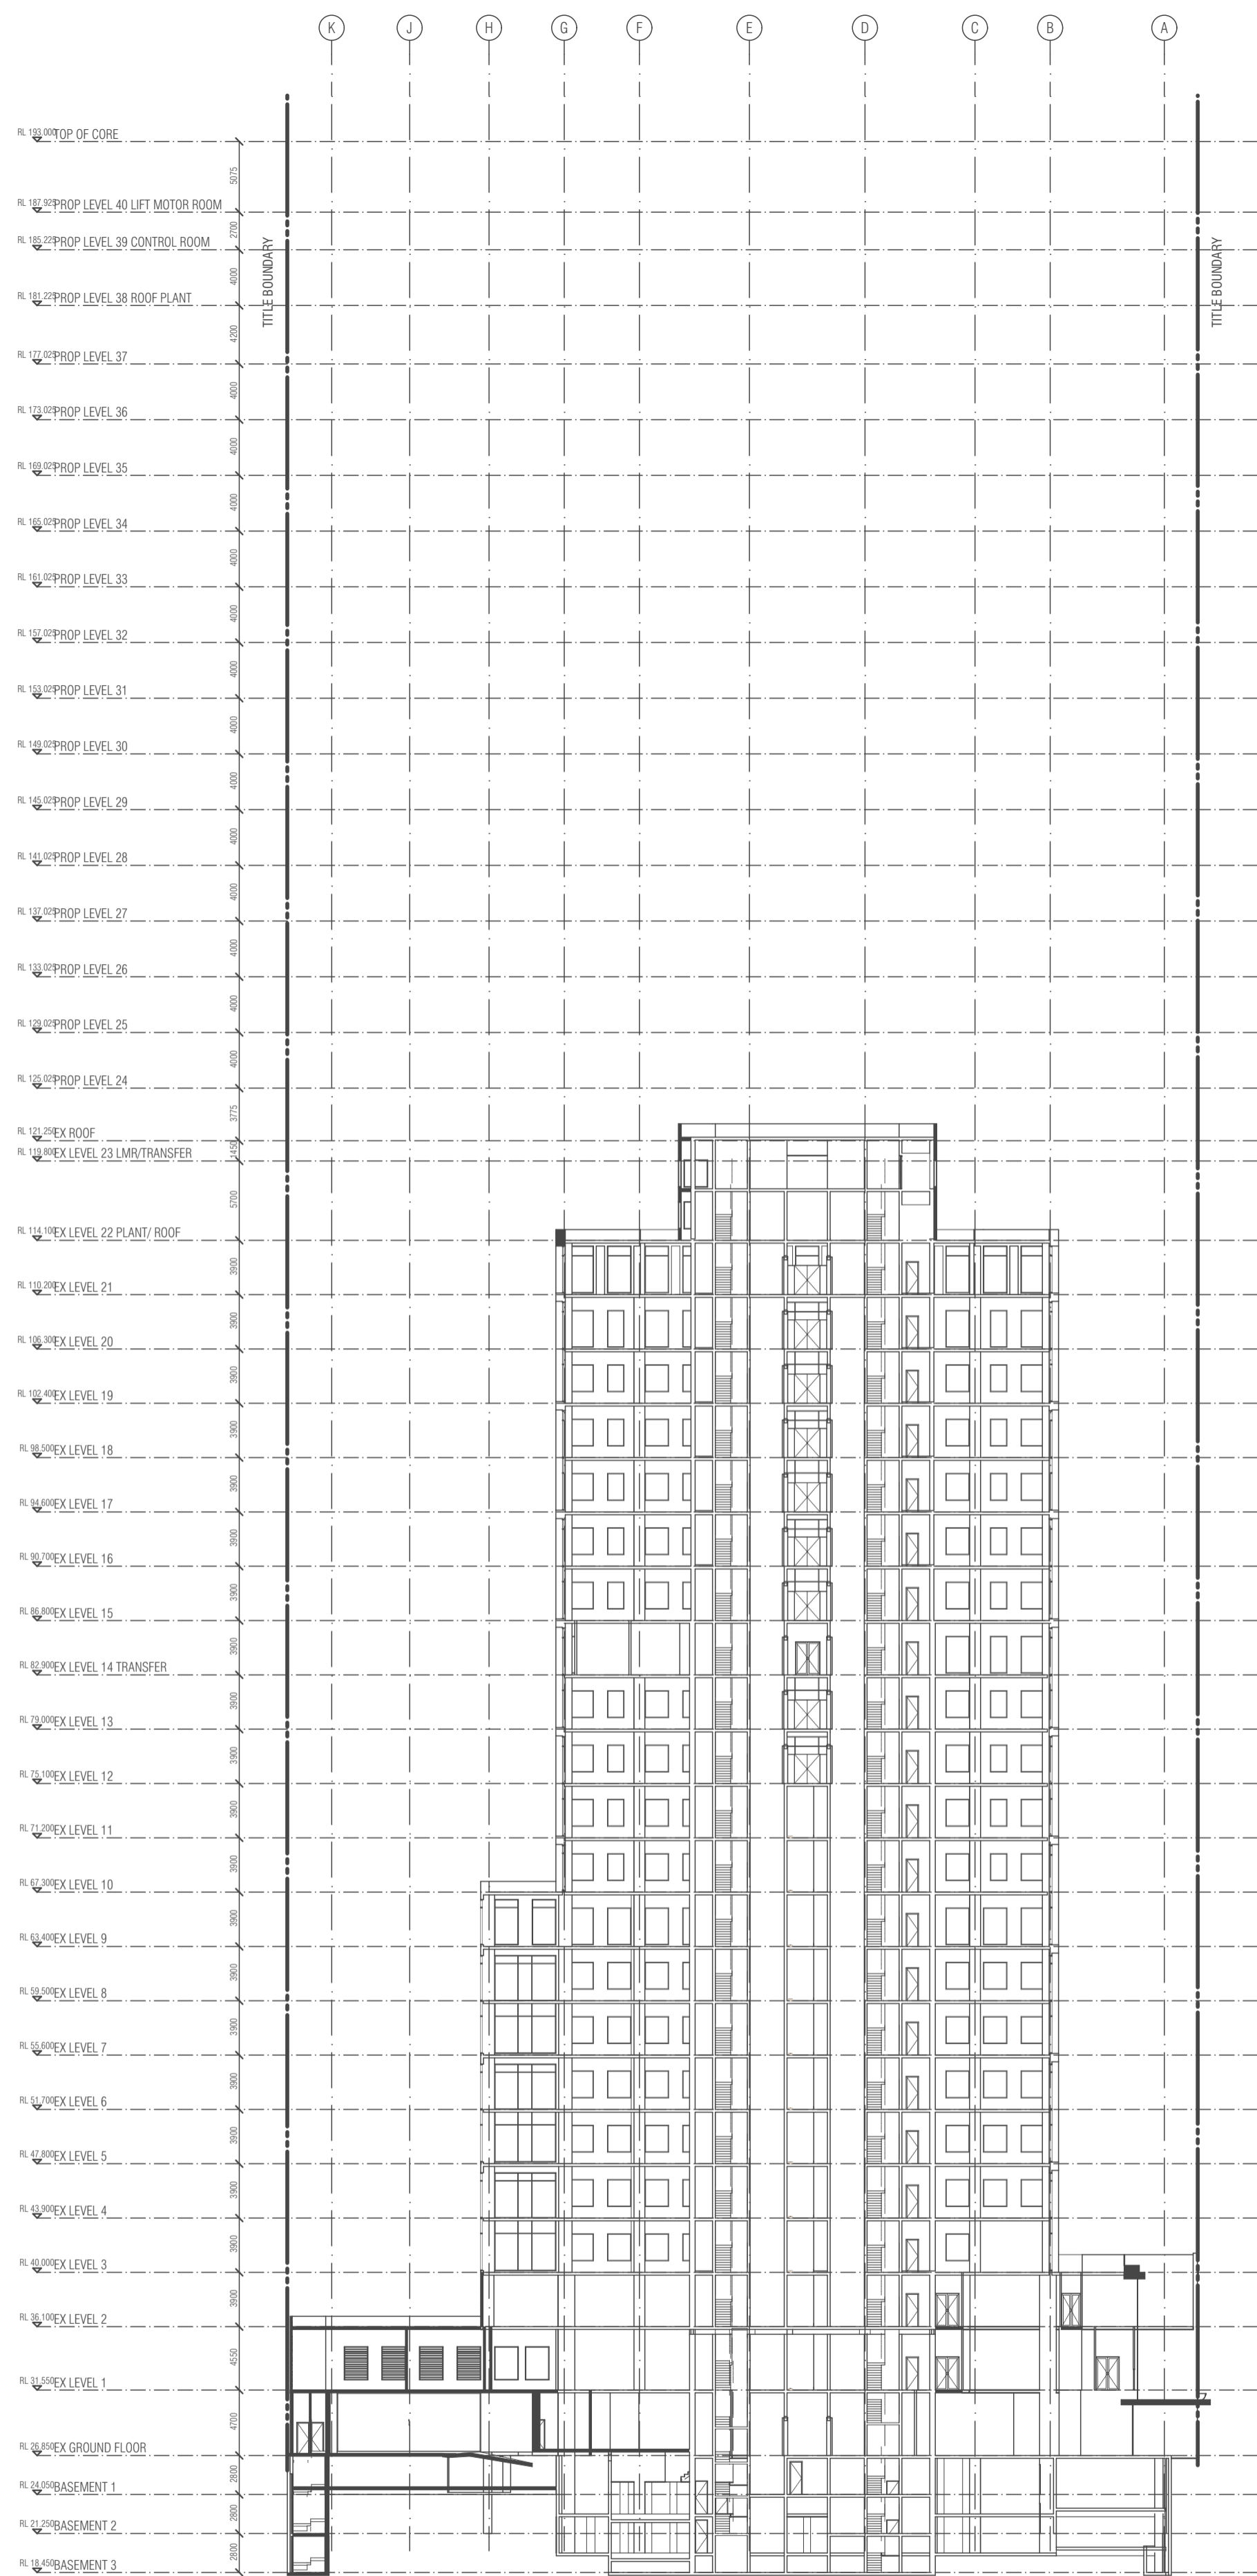

TP-A SECTION A EXISTING  
SCALE 1:375@A1

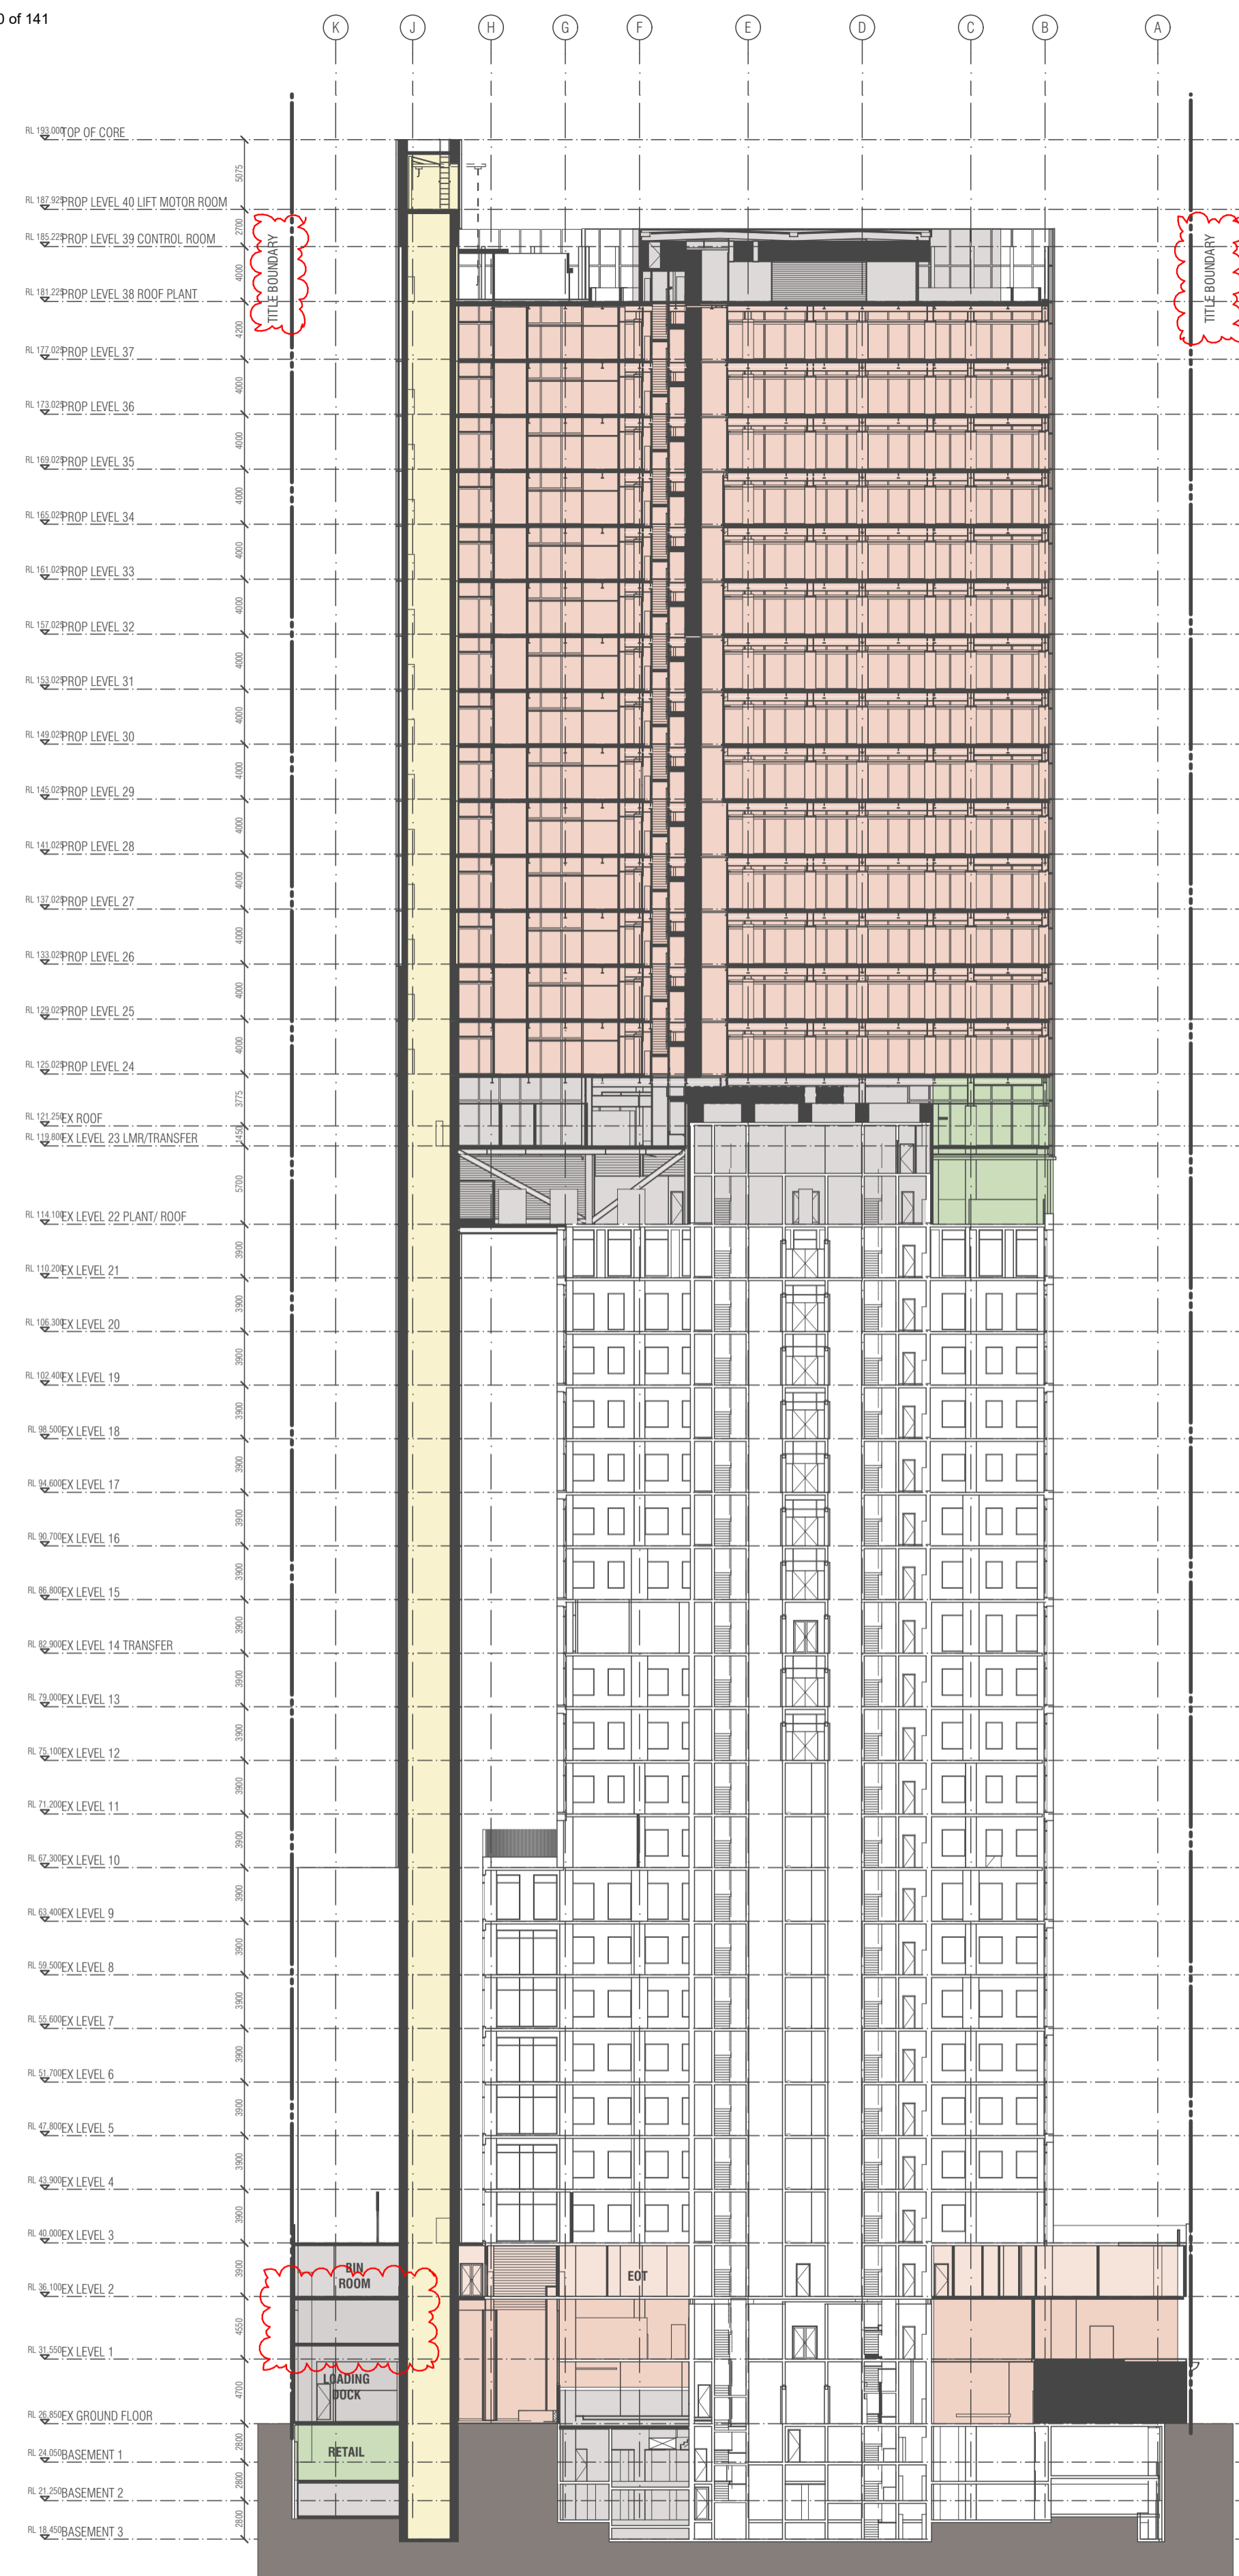

TP-A SECTION A  
SCALE 1:375@A1

BIMcloud: FK BIMCLOUD - BIMcloud18155 90 Collins Street Melbourne/00 MODEL/00 - CD/BIM MODEL/18155 General

REVISION	DESCRIPTION	DATE	BY
01	TOWN PLANNING ISSUE 01	16.12.2021	WTK
02	TOWN PLANNING SUBMISSION 02	10.06.2022	WTK
03	TOWN PLANNING SUBMISSION 03	15.07.2022	WTK

**QUALITY ASSURANCE** (FK IS A CERTIFIED COMPANY TO ISO 9001:2015)  
THIS PROJECT IS SUBJECT TO THE FK QUALITY ASSURANCE SYSTEM

- SCHEMATIC DESIGN REVIEW FOR THIS PROJECT IS YET TO BE COMPLETED.
- DESIGN DEVELOPMENT REVIEW FOR THIS PROJECT IS YET TO BE COMPLETED.
- TENDER DOCUMENTATION REVIEW FOR THIS PROJECT IS YET TO BE COMPLETED.
- CONSTRUCTION DOCUMENTATION REVIEW FOR THIS PROJECT IS YET TO BE COMPLETED.

IF THIS DRAWING IS STAMPED UNCONTROLLED COPY THEN IT IS TO BE CONSIDERED A DRAFT. SUBJECT TO REVISION WITHOUT NOTICE

**NOTES**  
THIS DRAWING IS COPYRIGHT AND SHALL REMAIN THE PROPERTY OF FENDER KATSALIDIS (AUST) PTY LTD  
CHECK AND VERIFY ALL DIMENSIONS ON SITE PRIOR TO COMMENCING WORK. DRAWING TO BE READ IN CONJUNCTION WITH ALL OTHER CONTRACT DOCUMENTS. DO NOT SCALE DRAWINGS. USE FIGURED DIMENSIONS ONLY. SEEK CLARIFICATION OF INCONSISTENCIES / CONFLICTS.


DRAWN	DATE	CHECKED	PLOT DATE	JOB NO.	SCALE	DRAWING TITLE
WTK	15.07.2022	JV	21.07.2022	18155	AS SHOWN@A1	SECTION A

**PROJECT**  
90 COLLINS REDEVELOPMENT  
90 COLLINS STREET  
MELBOURNE VIC 3000




**FENDER KATSALIDIS**  
WWW.FKAUSTRALIA.COM  
2 RIVERSIDE QUAY, SOUTH BANK  
VICTORIA 3006 AUSTRALIA  
TELEPHONE: +61 3 8696 3888  
FENDER KATSALIDIS (AUST) PTY LTD ACN 092 943 032

**ISSUE PURPOSE**  
TOWN PLANNING

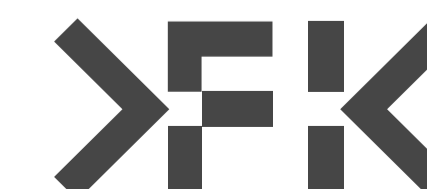


**REV.** 02  
**DRAWING NO.** TP500



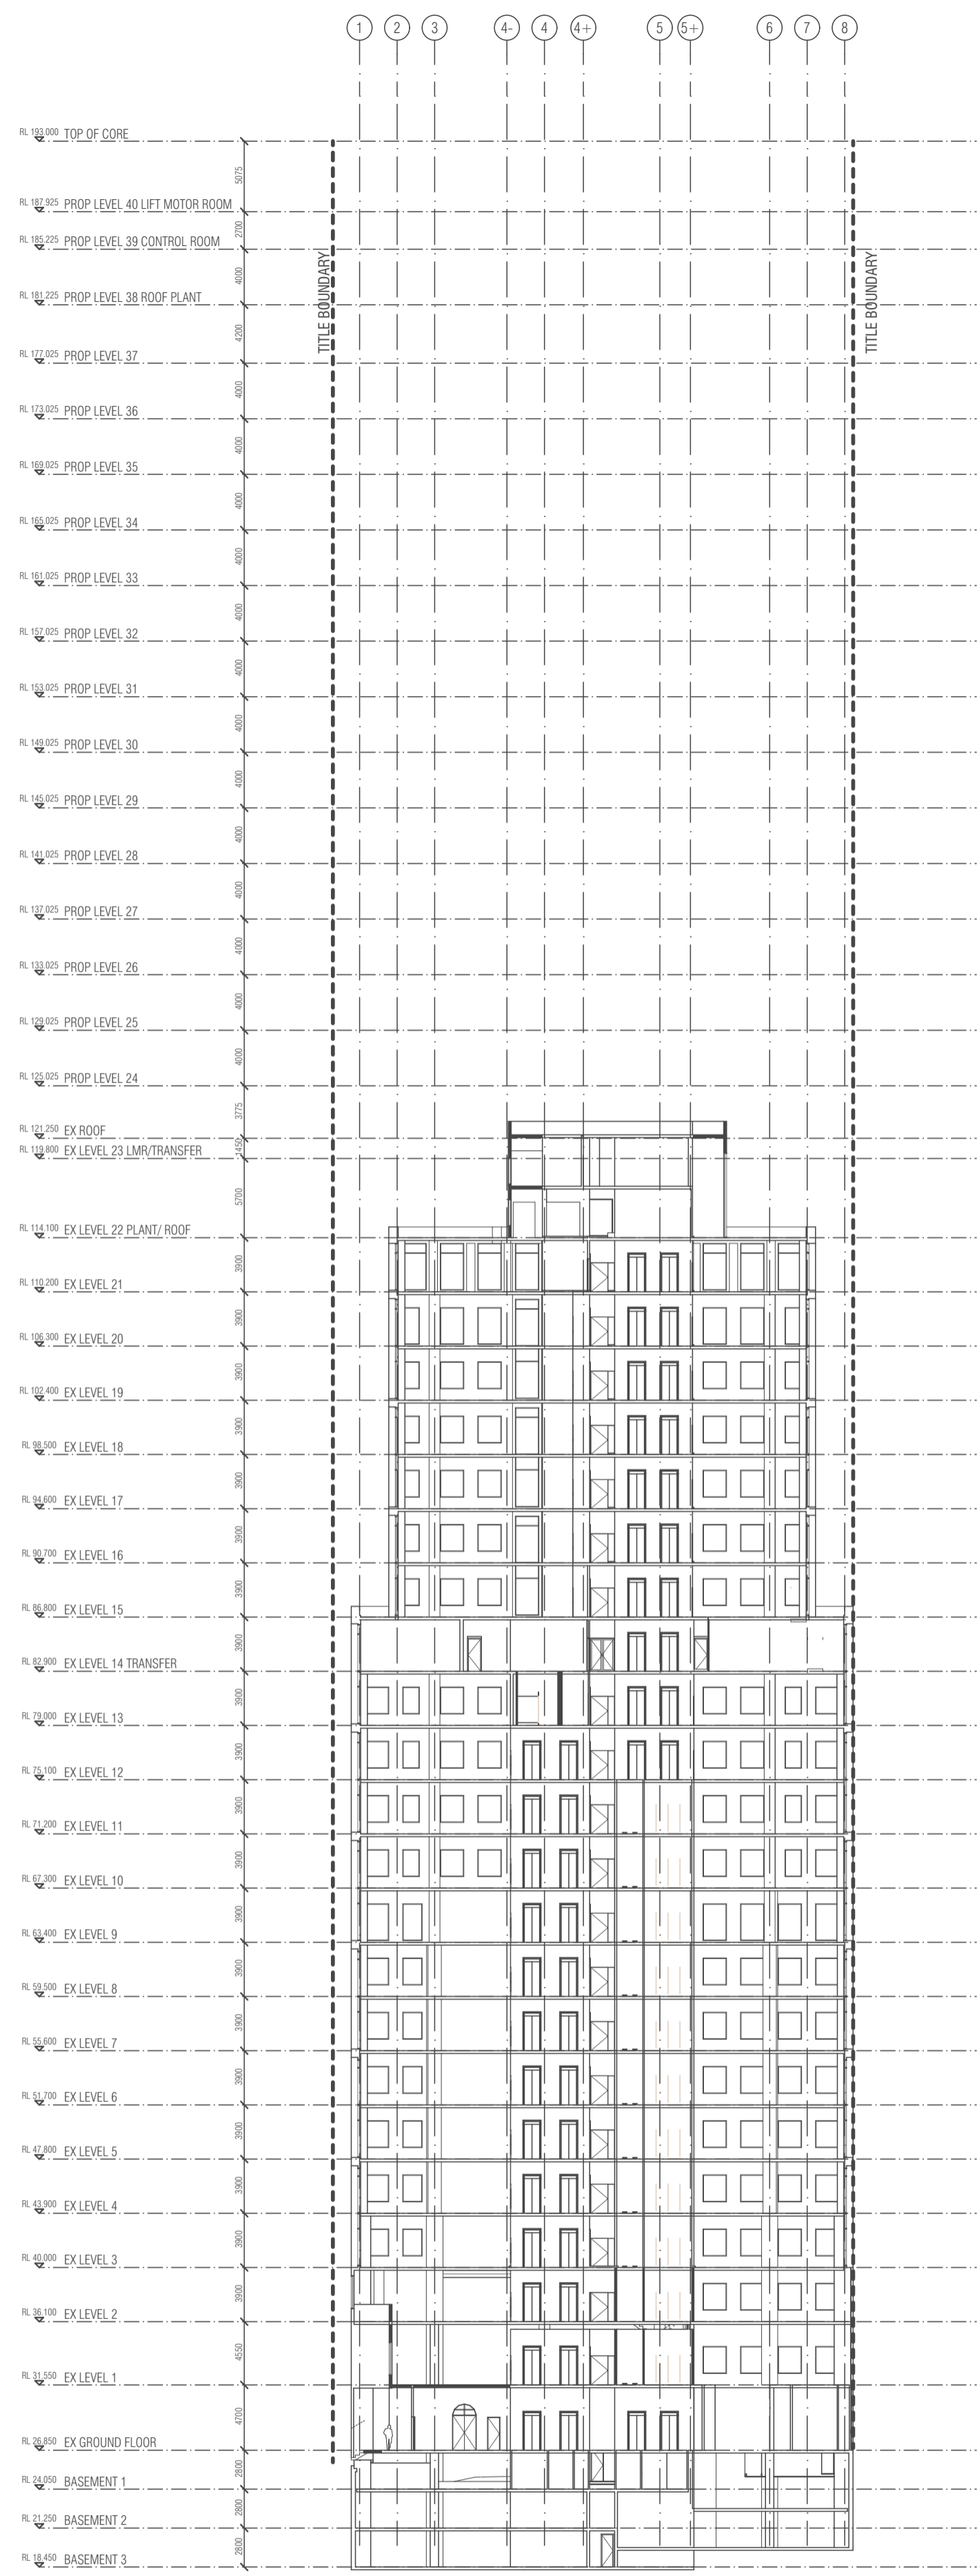

TP-B SECTION B EXISTING  
SCALE 1:375@A1

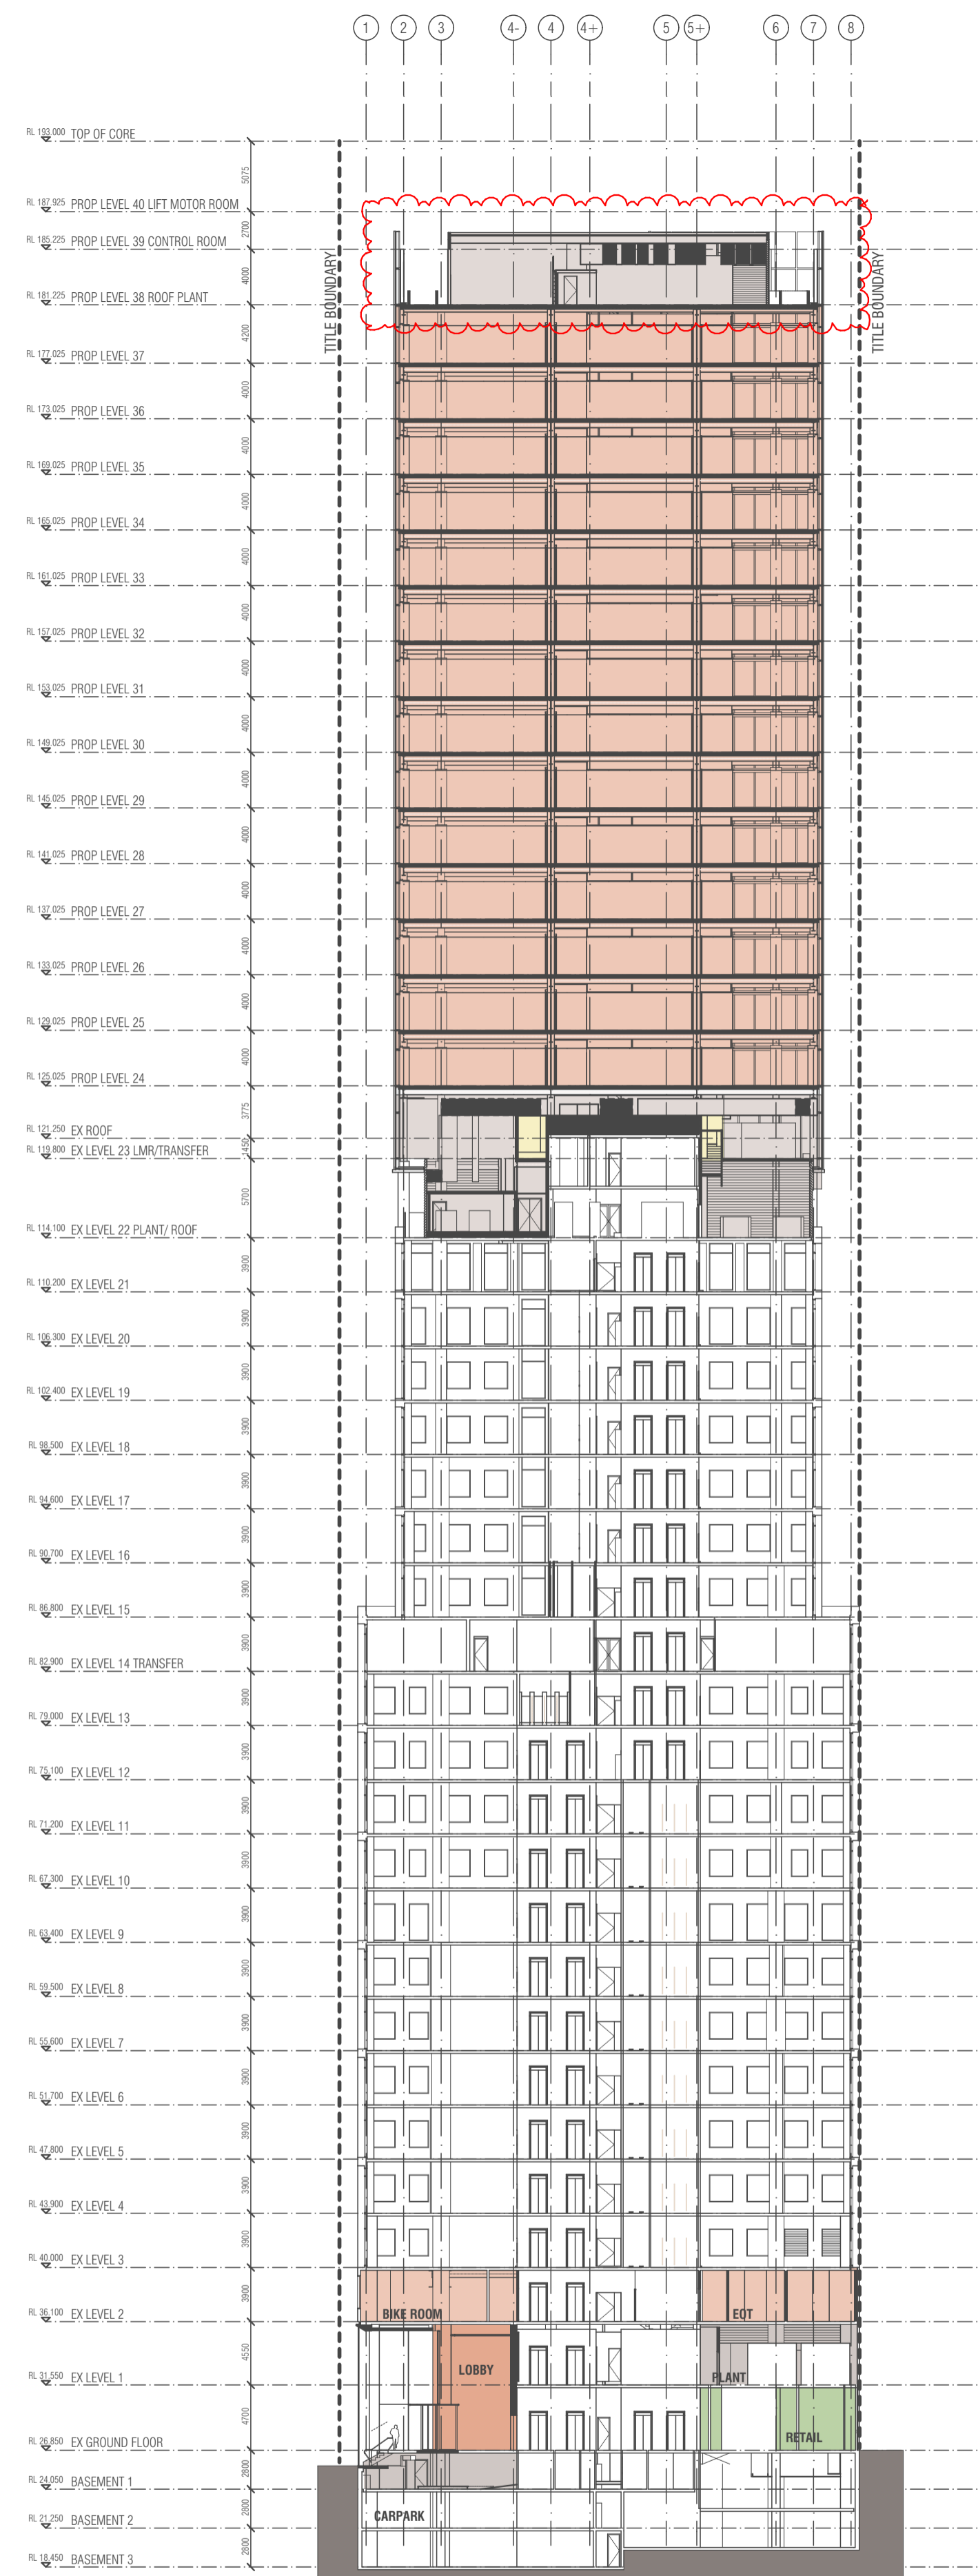

TP-B SECTION B  
SCALE 1:375@A1

KEY PLAN



CHANGES HIGHLIGHTED IN COLOUR TO PROPOSED SECTIONS

BIMcloud: FKBMCLCLOUD - BIMcloud\18155 90 Collins Street Melbourne\00 MODEL\00-CD\BIM MODEL\18155 General

REVISION	DESCRIPTION	DATE
01	TOWN PLANNING ISSUE 01	16.12.2021
02	TOWN PLANNING SUBMISSION 02	10.06.2022
03	TOWN PLANNING SUBMISSION 03	15.07.2022

**QUALITY ASSURANCE** (FK IS A CERTIFIED COMPANY TO ISO 9001:2015)  
THIS PROJECT IS SUBJECT TO THE FK QUALITY ASSURANCE SYSTEM

- SCHEMATIC DESIGN REVIEW FOR THIS PROJECT IS YET TO BE COMPLETED.
- DESIGN DEVELOPMENT REVIEW FOR THIS PROJECT IS YET TO BE COMPLETED.
- TENDER DOCUMENTATION REVIEW FOR THIS PROJECT IS YET TO BE COMPLETED.
- CONSTRUCTION DOCUMENTATION REVIEW FOR THIS DRAWING IS YET TO BE COMPLETED.

IF THIS DRAWING IS STAMPED UNCONTROLLED COPY THEN IT IS TO BE CONSIDERED A DRAFT. SUBJECT TO REVISION WITHOUT NOTICE

**NOTES**  
THIS DRAWING IS COPYRIGHT AND SHALL REMAIN THE PROPERTY OF FENDER KATSALIDIS (AUST) PTY LTD  
CHECK AND VERIFY ALL DIMENSIONS ON SITE PRIOR TO COMMENCING WORK. DRAWING TO BE READ IN CONJUNCTION WITH ALL OTHER CONTRACT DOCUMENTS. DO NOT SCALE DRAWINGS. USE FIGURED DIMENSIONS ONLY. SEEK CLARIFICATION OF INCONSISTENCIES / CONFLICTS.

DRAWN	DATE	CHECKED	PLOT DATE	JOB NO.	SCALE	DRAWING TITLE
WTK	15.07.2022	JV	21.07.2022	18155	AS SHOWN@A1	SECTION B

**PROJECT**  
90 COLLINS REDEVELOPMENT  
90 COLLINS STREET  
MELBOURNE VIC 3000



**FENDER KATSALIDIS**  
WWW.FKAUSTRALIA.COM  
2 RIVERSIDE QUAY, SOUTH BANK  
VICTORIA 3006 AUSTRALIA  
TELEPHONE: +61 3 8696 3888  
FENDER KATSALIDIS (AUST) PTY LTD ACN 092 943 032



ISSUE PURPOSE	REV.	DRAWING NO.
TOWN PLANNING	02	TP501





**COLLINS STREET**

BIMcloud: FBIMCLOUD - BIMcloud\18155 90 Collins Street Melbourne\00 MODEL\00 - CD\BIM MODEL\18155 General

REVISION		DATE
01	TOWN PLANNING ISSUE 01	16.12.2021
02	TOWN PLANNING SUBMISSION 02	10.06.2022
03	TOWN PLANNING SUBMISSION 03	15.07.2022

REVISION		DATE
01	TOWN PLANNING ISSUE 01	16.12.2021
02	TOWN PLANNING SUBMISSION 02	10.06.2022
03	TOWN PLANNING SUBMISSION 03	15.07.2022

**QUALITY ASSURANCE** (FK IS A CERTIFIED COMPANY TO ISO 9001:2015)  
 THIS PROJECT IS SUBJECT TO THE FK QUALITY ASSURANCE SYSTEM

- SCHEMATIC DESIGN REVIEW FOR THIS PROJECT IS YET TO BE COMPLETED.
- DESIGN DEVELOPMENT REVIEW FOR THIS PROJECT IS YET TO BE COMPLETED.
- TENDER DOCUMENTATION REVIEW FOR THIS PROJECT IS YET TO BE COMPLETED.
- CONSTRUCTION DOCUMENTATION REVIEW FOR THIS DRAWING IS YET TO BE COMPLETED.

IF THIS DRAWING IS STAMPED UNCONTROLLED COPY THEN IT IS TO BE CONSIDERED A DRAFT. SUBJECT TO REVISION WITHOUT NOTICE

**NOTES**  
 THIS DRAWING IS COPYRIGHT AND SHALL REMAIN THE PROPERTY OF FENDER KATSALIDIS (AUST) PTY LTD  
 CHECK AND VERIFY ALL DIMENSIONS ON SITE PRIOR TO COMMENCING WORK. DRAWING TO BE READ  
 IN CONJUNCTION WITH ALL OTHER CONTRACT DOCUMENTS. DO NOT SCALE DRAWINGS. USE FIGURED  
 DIMENSIONS ONLY. SEEK CLARIFICATION OF INCONSISTENCIES / CONFLICTS.

DRAWN	DATE	CHECKED	PLOT DATE	JOB NO.	SCALE
WTK	15.07.2022	JV	21.07.2022	18155	N.T.S.@A1


**PROJECT**  
 90 COLLINS REDEVELOPMENT  
 90 COLLINS STREET  
 MELBOURNE VIC 3000

**DRAWING TITLE**  
 3D VIEWS 01



**FENDER KATSALIDIS**  
 WWW.FKAUSTRALIA.COM  
 2 RIVERSIDE QUAY, SOUTH BANK  
 VICTORIA 3006 AUSTRALIA  
 TELEPHONE: +61 3 8696 3888  
 FENDER KATSALIDIS (AUST) PTY LTD ACN 092 943 032

**ISSUE PURPOSE**  
 TOWN PLANNING

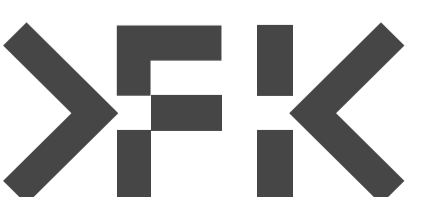

**REV.** 02  
**DRAWING NO.** TP600





\* INDICATIVE LANDSCAPE.  
TO BE DESIGNED IN CONJUNCTION WITH THE CITY OF MELBOURNE

ALFRED PLACE

BIMcloud: FK BIMCLOUD - BIMcloud\18155 90 Collins Street Melbourne\00 MODEL\00 - CD\BIM MODEL\18155 General

REVISION		WTK	16.12.2021
-	TOWN PLANNING ISSUE 01		
01	TOWN PLANNING SUBMISSION 02	WTK	10.06.2022
> 02	TOWN PLANNING SUBMISSION 03	WTK	15.07.2022

REVISION

**QUALITY ASSURANCE** (FK IS A CERTIFIED COMPANY TO ISO 9001:2015)  
THIS PROJECT IS SUBJECT TO THE FK QUALITY ASSURANCE SYSTEM

- SCHEMATIC DESIGN REVIEW FOR THIS PROJECT IS YET TO BE COMPLETED.
- DESIGN DEVELOPMENT REVIEW FOR THIS PROJECT IS YET TO BE COMPLETED.
- TENDER DOCUMENTATION REVIEW FOR THIS PROJECT IS YET TO BE COMPLETED.
- CONSTRUCTION DOCUMENTATION REVIEW FOR THIS DRAWING IS YET TO BE COMPLETED.

IF THIS DRAWING IS STAMPED UNCONTROLLED COPY THEN IT IS TO BE CONSIDERED A DRAFT. SUBJECT TO REVISION WITHOUT NOTICE


**NOTES**  
THIS DRAWING IS COPYRIGHT AND SHALL REMAIN THE PROPERTY OF FENDER KATSALIDIS (AUST) PTY LTD  
CHECK AND VERIFY ALL DIMENSIONS ON SITE PRIOR TO COMMENCING WORK. DRAWING TO BE READ IN CONJUNCTION WITH ALL OTHER CONTRACT DOCUMENTS. DO NOT SCALE DRAWINGS. USE FIGURED DIMENSIONS ONLY. SEEK CLARIFICATION OF INCONSISTENCIES / CONFLICTS.

DRAWN	DATE	CHECKED	PLOT DATE	JOB NO.	SCALE
WTK	15.07.2022	JV	21.07.2022	18155	N.T.S.@A1

**PROJECT**  
90 COLLINS REDEVELOPMENT  
90 COLLINS STREET  
MELBOURNE VIC 3000



**FENDER KATSALIDIS**  
WWW.FKAUSTRALIA.COM  
2 RIVERSIDE QUAY, SOUTH BANK  
VICTORIA 3006 AUSTRALIA  
TELEPHONE: +61 3 8696 3888  
FENDER KATSALIDIS (AUST) PTY LTD ACN 092 943 032

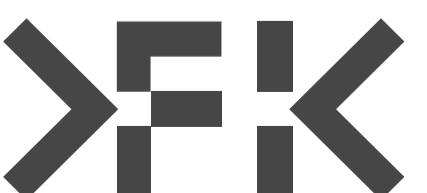

**ISSUE PURPOSE**  
TOWN PLANNING

**REV.** 02  
**DRAWING NO.** TP601





CORNER COLLINS & RUSSELL STREET

BIMcloud: FK BIMCLOUD - BIMcloud\18155 90 Collins Street Melbourne\00 MODEL\00-CD\BIM MODEL\18155 General

REVISION		WTK	16.12.2021
-	TOWN PLANNING ISSUE 01		
> 01	TOWN PLANNING SUBMISSION 02	WTK	10.06.2022

**REVISION**

**QUALITY ASSURANCE** (FK IS A CERTIFIED COMPANY TO ISO 9001:2015)  
 THIS PROJECT IS SUBJECT TO THE FK QUALITY ASSURANCE SYSTEM

- SCHEMATIC DESIGN REVIEW FOR THIS PROJECT IS YET TO BE COMPLETED.
- DESIGN DEVELOPMENT REVIEW FOR THIS PROJECT IS YET TO BE COMPLETED.
- TENDER DOCUMENTATION REVIEW FOR THIS PROJECT IS YET TO BE COMPLETED.
- CONSTRUCTION DOCUMENTATION REVIEW FOR THIS DRAWING IS YET TO BE COMPLETED.

IF THIS DRAWING IS STAMPED UNCONTROLLED COPY THEN IT IS TO BE CONSIDERED A DRAFT. SUBJECT TO REVISION WITHOUT NOTICE


**NOTES**  
 THIS DRAWING IS COPYRIGHT AND SHALL REMAIN THE PROPERTY OF FENDER KATSALIDIS (AUST) PTY LTD  
 CHECK AND VERIFY ALL DIMENSIONS ON SITE PRIOR TO COMMENCING WORK. DRAWING TO BE READ IN CONJUNCTION WITH ALL OTHER CONTRACT DOCUMENTS. DO NOT SCALE DRAWINGS. USE FIGURED DIMENSIONS ONLY. SEEK CLARIFICATION OF INCONSISTENCIES / CONFLICTS.

DRAWN	DATE	CHECKED	PLOT DATE	JOB NO.	SCALE
WTK	10.06.2022	JV	21.07.2022	18155	N.T.S.@A1

**PROJECT**  
 90 COLLINS REDEVELOPMENT  
 90 COLLINS STREET  
 MELBOURNE VIC 3000



**FENDER KATSALIDIS**  
 WWW.FKAUSTRALIA.COM  
 2 RIVERSIDE QUAY, SOUTH BANK  
 VICTORIA 3006 AUSTRALIA  
 TELEPHONE: +61 3 8696 3888  
 FENDER KATSALIDIS (AUST) PTY LTD ACN 092 943 032

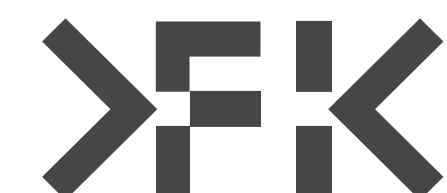

**ISSUE PURPOSE**  
 TOWN PLANNING

**REV.** 01  
**DRAWING NO.** TP602





### COLLINS STREET

BIMcloud: FK BIMCLOUD - BIMcloud\18155 90 Collins Street Melbourne\00 MODEL\00 - CD\BIM MODEL\18155 General

REVISION		DATE
-	TOWN PLANNING ISSUE 01	16.12.2021
> 01	TOWN PLANNING SUBMISSION 02	10.06.2022

#### REVISION

#### QUALITY ASSURANCE (FK IS A CERTIFIED COMPANY TO ISO 9001:2015)

THIS PROJECT IS SUBJECT TO THE FK QUALITY ASSURANCE SYSTEM

- SCHEMATIC DESIGN REVIEW FOR THIS PROJECT IS YET TO BE COMPLETED.
- DESIGN DEVELOPMENT REVIEW FOR THIS PROJECT IS YET TO BE COMPLETED.
- TENDER DOCUMENTATION REVIEW FOR THIS PROJECT IS YET TO BE COMPLETED.
- CONSTRUCTION DOCUMENTATION REVIEW FOR THIS DRAWING IS YET TO BE COMPLETED.

IF THIS DRAWING IS STAMPED UNCONTROLLED COPY THEN IT IS TO BE CONSIDERED A DRAFT. SUBJECT TO REVISION WITHOUT NOTICE

#### NOTES

THIS DRAWING IS COPYRIGHT AND SHALL REMAIN THE PROPERTY OF FENDER KATSALIDIS (AUST) PTY LTD. CHECK AND VERIFY ALL DIMENSIONS ON SITE PRIOR TO COMMENCING WORK. DRAWING TO BE READ IN CONJUNCTION WITH ALL OTHER CONTRACT DOCUMENTS. DO NOT SCALE DRAWINGS. USE FIGURED DIMENSIONS ONLY. SEEK CLARIFICATION OF INCONSISTENCIES / CONFLICTS.

DRAWN	DATE	CHECKED	PLOT DATE	JOB NO.	SCALE
WTK	10.06.2022	JV	21.07.2022	18155	N.T.S.@A1

#### PROJECT

90 COLLINS REDEVELOPMENT  
90 COLLINS STREET  
MELBOURNE VIC 3000

DRAWING TITLE  
3D VIEWS 04



**FENDER KATSALIDIS**  
WWW.FKAUSTRALIA.COM  
2 RIVERSIDE QUAY, SOUTH BANK  
VICTORIA 3006 AUSTRALIA  
TELEPHONE: +61 3 8696 3888  
FENDER KATSALIDIS (AUST) PTY LTD ACN 092 943 032

ISSUE PURPOSE  
TOWN PLANNING



REV. 01  
DRAWING NO. TP603





CORNER COLLINS & EXHIBITION STREET

REVISION		DATE
-	TOWN PLANNING ISSUE 01	16.12.2021
> 01	TOWN PLANNING SUBMISSION 02	10.06.2022

REVISION

QUALITY ASSURANCE (FK IS A CERTIFIED COMPANY TO ISO 9001:2015)

THIS PROJECT IS SUBJECT TO THE FK QUALITY ASSURANCE SYSTEM

- SCHEMATIC DESIGN REVIEW FOR THIS PROJECT IS YET TO BE COMPLETED.
- DESIGN DEVELOPMENT REVIEW FOR THIS PROJECT IS YET TO BE COMPLETED.
- TENDER DOCUMENTATION REVIEW FOR THIS PROJECT IS YET TO BE COMPLETED.
- CONSTRUCTION DOCUMENTATION REVIEW FOR THIS DRAWING IS YET TO BE COMPLETED.

IF THIS DRAWING IS STAMPED UNCONTROLLED COPY THEN IT IS TO BE CONSIDERED A DRAFT. SUBJECT TO REVISION WITHOUT NOTICE

NOTES

THIS DRAWING IS COPYRIGHT AND SHALL REMAIN THE PROPERTY OF FENDER KATSALIDIS (AUST) PTY LTD. CHECK AND VERIFY ALL DIMENSIONS ON SITE PRIOR TO COMMENCING WORK. DRAWING TO BE READ IN CONJUNCTION WITH ALL OTHER CONTRACT DOCUMENTS. DO NOT SCALE DRAWINGS. USE FIGURED DIMENSIONS ONLY. SEEK CLARIFICATION OF INCONSISTENCIES / CONFLICTS.

DRAWN	DATE	CHECKED	PLOT DATE	JOB NO.	SCALE
WTK	10.06.2022	JV	21.07.2022	18155	N.T.S.@A1

PROJECT

90 COLLINS REDEVELOPMENT  
90 COLLINS STREET  
MELBOURNE VIC 3000

DRAWING TITLE
3D VIEWS 05



FENDER KATSALIDIS

WWW.FKAUSTRALIA.COM  
2 RIVERSIDE QUAY, SOUTHBANK  
VICTORIA 3006 AUSTRALIA  
TELEPHONE: +61 3 8696 3888  
FENDER KATSALIDIS (AUST) PTY LTD ACN 092 943 032

ISSUE PURPOSE
TOWN PLANNING



REV.	DRAWING NO.
01	TP604





**VIEW FROM SOUTHBANK**

BIMcloud: FK BIMCLOUD - BIMcloud\18155 90 Collins Street Melbourne\00 MODEL\00-CD\BIM MODEL\18155 General

REVISION	DESCRIPTION	DATE
-	TOWN PLANNING ISSUE 01	WTK 16.12.2021
> 01	TOWN PLANNING SUBMISSION 02	WTK 10.06.2022

REVISION	DESCRIPTION	DATE
-	TOWN PLANNING ISSUE 01	WTK 16.12.2021
> 01	TOWN PLANNING SUBMISSION 02	WTK 10.06.2022

**QUALITY ASSURANCE** (FK IS A CERTIFIED COMPANY TO ISO 9001:2015)  
 THIS PROJECT IS SUBJECT TO THE FK QUALITY ASSURANCE SYSTEM

- SCHEMATIC DESIGN REVIEW FOR THIS PROJECT IS YET TO BE COMPLETED.
- DESIGN DEVELOPMENT REVIEW FOR THIS PROJECT IS YET TO BE COMPLETED.
- TENDER DOCUMENTATION REVIEW FOR THIS PROJECT IS YET TO BE COMPLETED.
- CONSTRUCTION DOCUMENTATION REVIEW FOR THIS DRAWING IS YET TO BE COMPLETED.

IF THIS DRAWING IS STAMPED UNCONTROLLED COPY THEN IT IS TO BE CONSIDERED A DRAFT. SUBJECT TO REVISION WITHOUT NOTICE

**NOTES**  
 THIS DRAWING IS COPYRIGHT AND SHALL REMAIN THE PROPERTY OF FENDER KATSALIDIS (AUST) PTY LTD  
 CHECK AND VERIFY ALL DIMENSIONS ON SITE PRIOR TO COMMENCING WORK. DRAWING TO BE READ IN CONJUNCTION WITH ALL OTHER CONTRACT DOCUMENTS. DO NOT SCALE DRAWINGS. USE FIGURED DIMENSIONS ONLY. SEEK CLARIFICATION OF INCONSISTENCIES / CONFLICTS.

DRAWN	DATE	CHECKED	PLOT DATE	JOB NO.	SCALE
WTK	10.06.2022	JV	21.07.2022	18155	N.T.S.@A1


**PROJECT**  
 90 COLLINS REDEVELOPMENT  
 90 COLLINS STREET  
 MELBOURNE VIC 3000

**DRAWING TITLE**  
 3D VIEWS 06



**FENDER KATSALIDIS**  
 WWW.FKAUSTRALIA.COM  
 2 RIVERSIDE QUAY, SOUTHBANK  
 VICTORIA 3006 AUSTRALIA  
 TELEPHONE: +61 3 8696 3888  
 FENDER KATSALIDIS (AUST) PTY LTD ACN 092 943 032

**ISSUE PURPOSE**  
 TOWN PLANNING

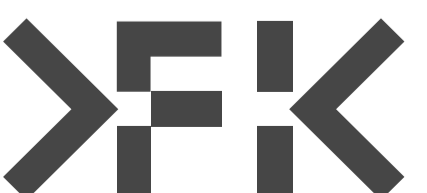

**REV.** 01  
**DRAWING NO.** TP605